


UNDERPASS SIGN No. 1  
(WESTVIEW DRIVE OVERPASS EASTBOUND)

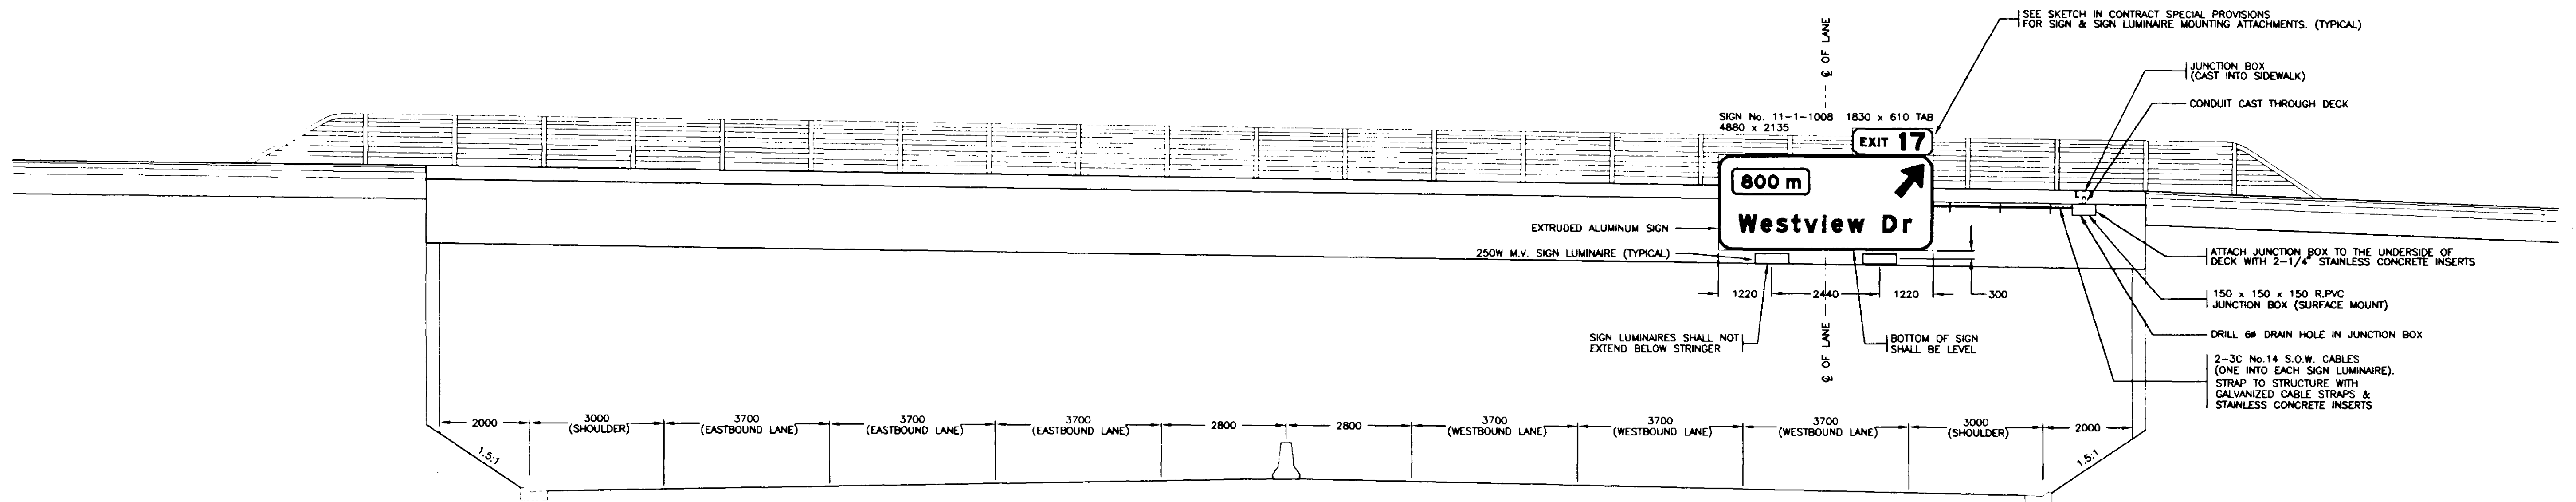

UNDERPASS SIGN No. 4  
(LONSDALE AVENUE OVERPASS WESTBOUND)

ELEVATIONS  
1:75

# LEGEND

<p>PROPOSED CONCRETE BASE WITH FUTURE LUMINAIRE POLE</p> <p>CONCRETE BASE AND JUNCTION BOX</p> <p>JUNCTION BOX - No. DENOTES TYPE</p> <p>LUMINAIRE POLE (SINGLE) "F" DENOTES FRANGIBLE BASE "B" DENOTES BREAKAWAY BASE</p> <p>DOUBLE LUMINAIRE POLE</p> <p>POST TOP MOUNTED LUMINAIRE</p> <p>TRAFFIC SIGNAL POLE WITH DAVIT AND SIDE OF POLE MOUNTED HEADS</p> <p>COMBINATION LUMINAIRE/DAVIT MOUNTED TRAFFIC SIGNAL POLE</p> <p>POST TOP MOUNTED SIGNAL</p>	<p>EXISTING CONCRETE BASE WITH PROPOSED LUMINAIRE POLE</p> <p>CITY OR DISTRICT OF NORTH VANCOUVER LUMINAIRE POLE</p> <p>DAVIT MOUNTED ILLUMINATED SIGN POLE WITH AMBER FLASHERS</p> <p>COMBINATION LUMINAIRE/DAVIT MOUNTED ILLUMINATED SIGN WITH AMBER FLASHERS</p> <p>DAVIT MOUNTED SIGN (NON-ILLUMINATED)</p> <p>DAVIT MOUNTED ILLUMINATED SIGN POLE</p> <p>COMBINATION LUMINAIRE/DAVIT MOUNTED NON-ILLUMINATED SIGN POLE</p> <p>BREAKAWAY SIGN (NON-ILLUMINATED)</p> <p>ILLUMINATED BREAKAWAY SIGN</p>	<p>PEC PHOTO ELECTRIC CELL</p> <p>RPVC RIGID P.V.C. CONDUIT</p> <p>R.M.C. RIGID METALLIC CONDUIT</p> <p>F.M.C. FLEXIBLE METALLIC CONDUIT (LIQUID TIGHT)</p> <p>OVERHEAD FLASHING BEACON</p> <p>POST MOUNTED FLASHER</p> <p>BACKGUY</p> <p>POWER POLE</p> <p>TELEPHONE POLE</p> <p>POWER/TELEPHONE POLE</p>	<p>TEST SWITCH</p> <p>BREAKER</p> <p>NEUTRAL BAR</p> <p>VEHICLE DETECTOR LOOP</p> <p>A,B,A1,A2,ETC. SIGNAL HEAD VEHICLE PHASE</p> <p>PA,PB,PA1,PB2,ETC. SIGNAL HEAD PEDESTRIAN PHASE</p> <p>ppb PEDESTRIAN PUSHBUTTON</p> <p>U/G UTILITY</p> <p>"G" DENOTES GAS</p> <p>"S" DENOTES STORM DRAINS/SEWERS</p> <p>"W" DENOTES WATER</p> <p>"E" DENOTES ELECTRIC</p> <p>"UT" DENOTES TELEPHONE</p> <p>"SAN" DENOTES SANITARY SEWER</p>	<p>RAISED CURB</p> <p>PROPERTY LINE</p> <p>EDGE OF GRAVEL SHOULDER</p> <p>EDGE OF PAVEMENT</p> <p>PAINT LINE</p> <p>PROPOSED UNDERGROUND CONDUIT</p> <p>EXISTING UNDERGROUND CONDUIT</p> <p>FENCE</p> <p>CORRUGATED METAL PIPE (CULVERT)</p> <p>RETAINING WALL</p> <p>SOUND WALL</p> <p>CONCRETE ROADSIDE OR MEDIAN BARRIER</p>
--	---	--	---	---

<b>WALTER &amp; SCI Construction</b> (Canada) Ltd.		<b>SCI</b>	
<b>SHAFLIK ENGINEERING LTD.</b> ELECTRICAL CONSULTANTS 202-8525 BAXTER PLACE, BURNABY, BC V5A 4V7 TEL: 604-421-4125 FAX: 604-421-8344			
ELECTRICAL DESIGN APPROVED DATE DESIGNED D.S.M. DATE NOV/95 SCALE AS NOTED VOLTAGE 120/240 HWY. DISTRICT HOWE SOUND CHECKED D.J.W. DATE 95-12-20			
REV	DATE	DESCRIPTION	CONST
A	97-07-29	RECORD DRAWING	D.J.W. A.J.
B	97-11-26	RECORD DRAWING REVISED	
REVISIONS			

<b>Province of British Columbia</b> MINISTRY OF TRANSPORTATION AND HIGHWAYS WESTVIEW INTERCHANGE DESIGN BUILD			
<b>SIGNALS, LIGHTING AND DIRECTIONAL SIGNING INSTALLATION</b> HOWE SOUND DISTRICT - HIGHWAY No.1 UPPER LEVELS HIGHWAY / WESTVIEW DRIVE INTERCHANGE NORTH VANCOUVER SIGN ELEVATIONS			
Ministry of Transportation and Highways South Coast Regional Office 7818 - 6th Street Burnaby, BC V3N 4N8		PREPARED UNDER THE DIRECTION OF ORIGINAL SIGNED BY D. J. WONG CONSULTANT DATE 96-02-14 PROJECT No. 06838 SHEET 22 OF 22 REG. 1 TE-95094-22	
ACCEPTED FOR CONSTRUCTION ORIGINAL SIGNED BY A. JACK OC/QA MANAGER DATE 96-02-16 DRAWING No.			

CANCEL PRINTS BEARING PREVIOUS LETTER