




SERVICE No. 1
LUMINAIRE POLE AT STA. 110+00

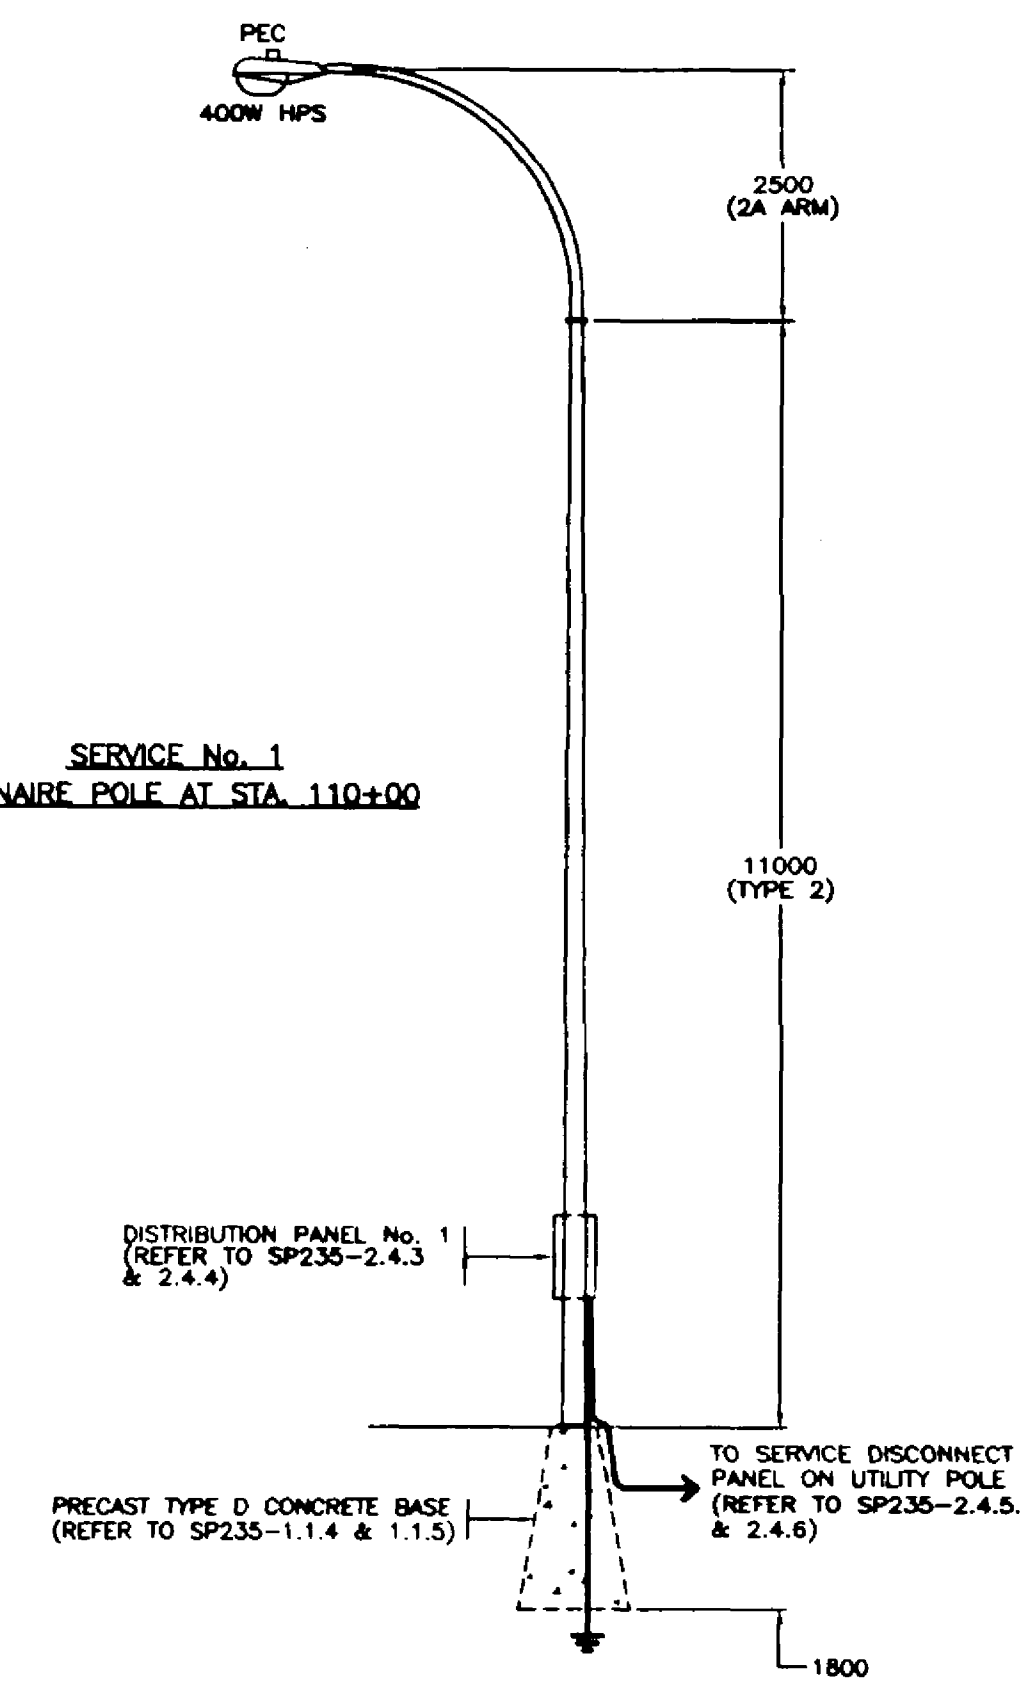


SERVICE No. 3
LUMINAIRE POLE AT STA. 118+65

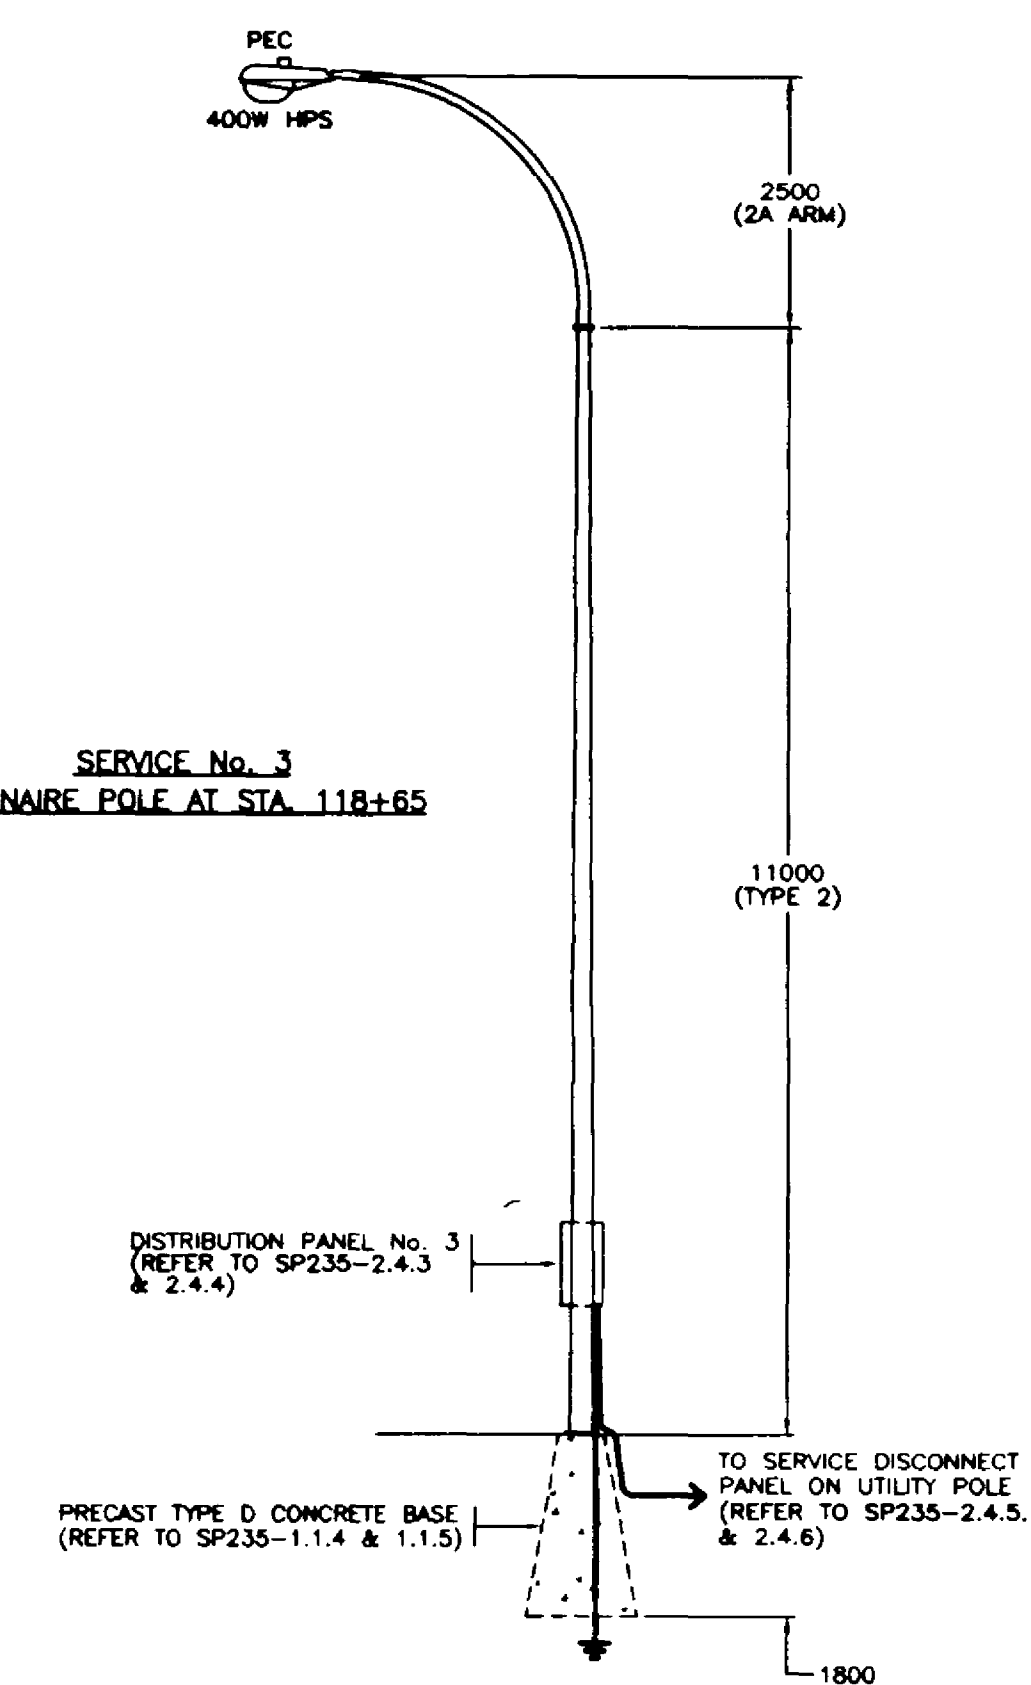

ELEVATIONS
1:75

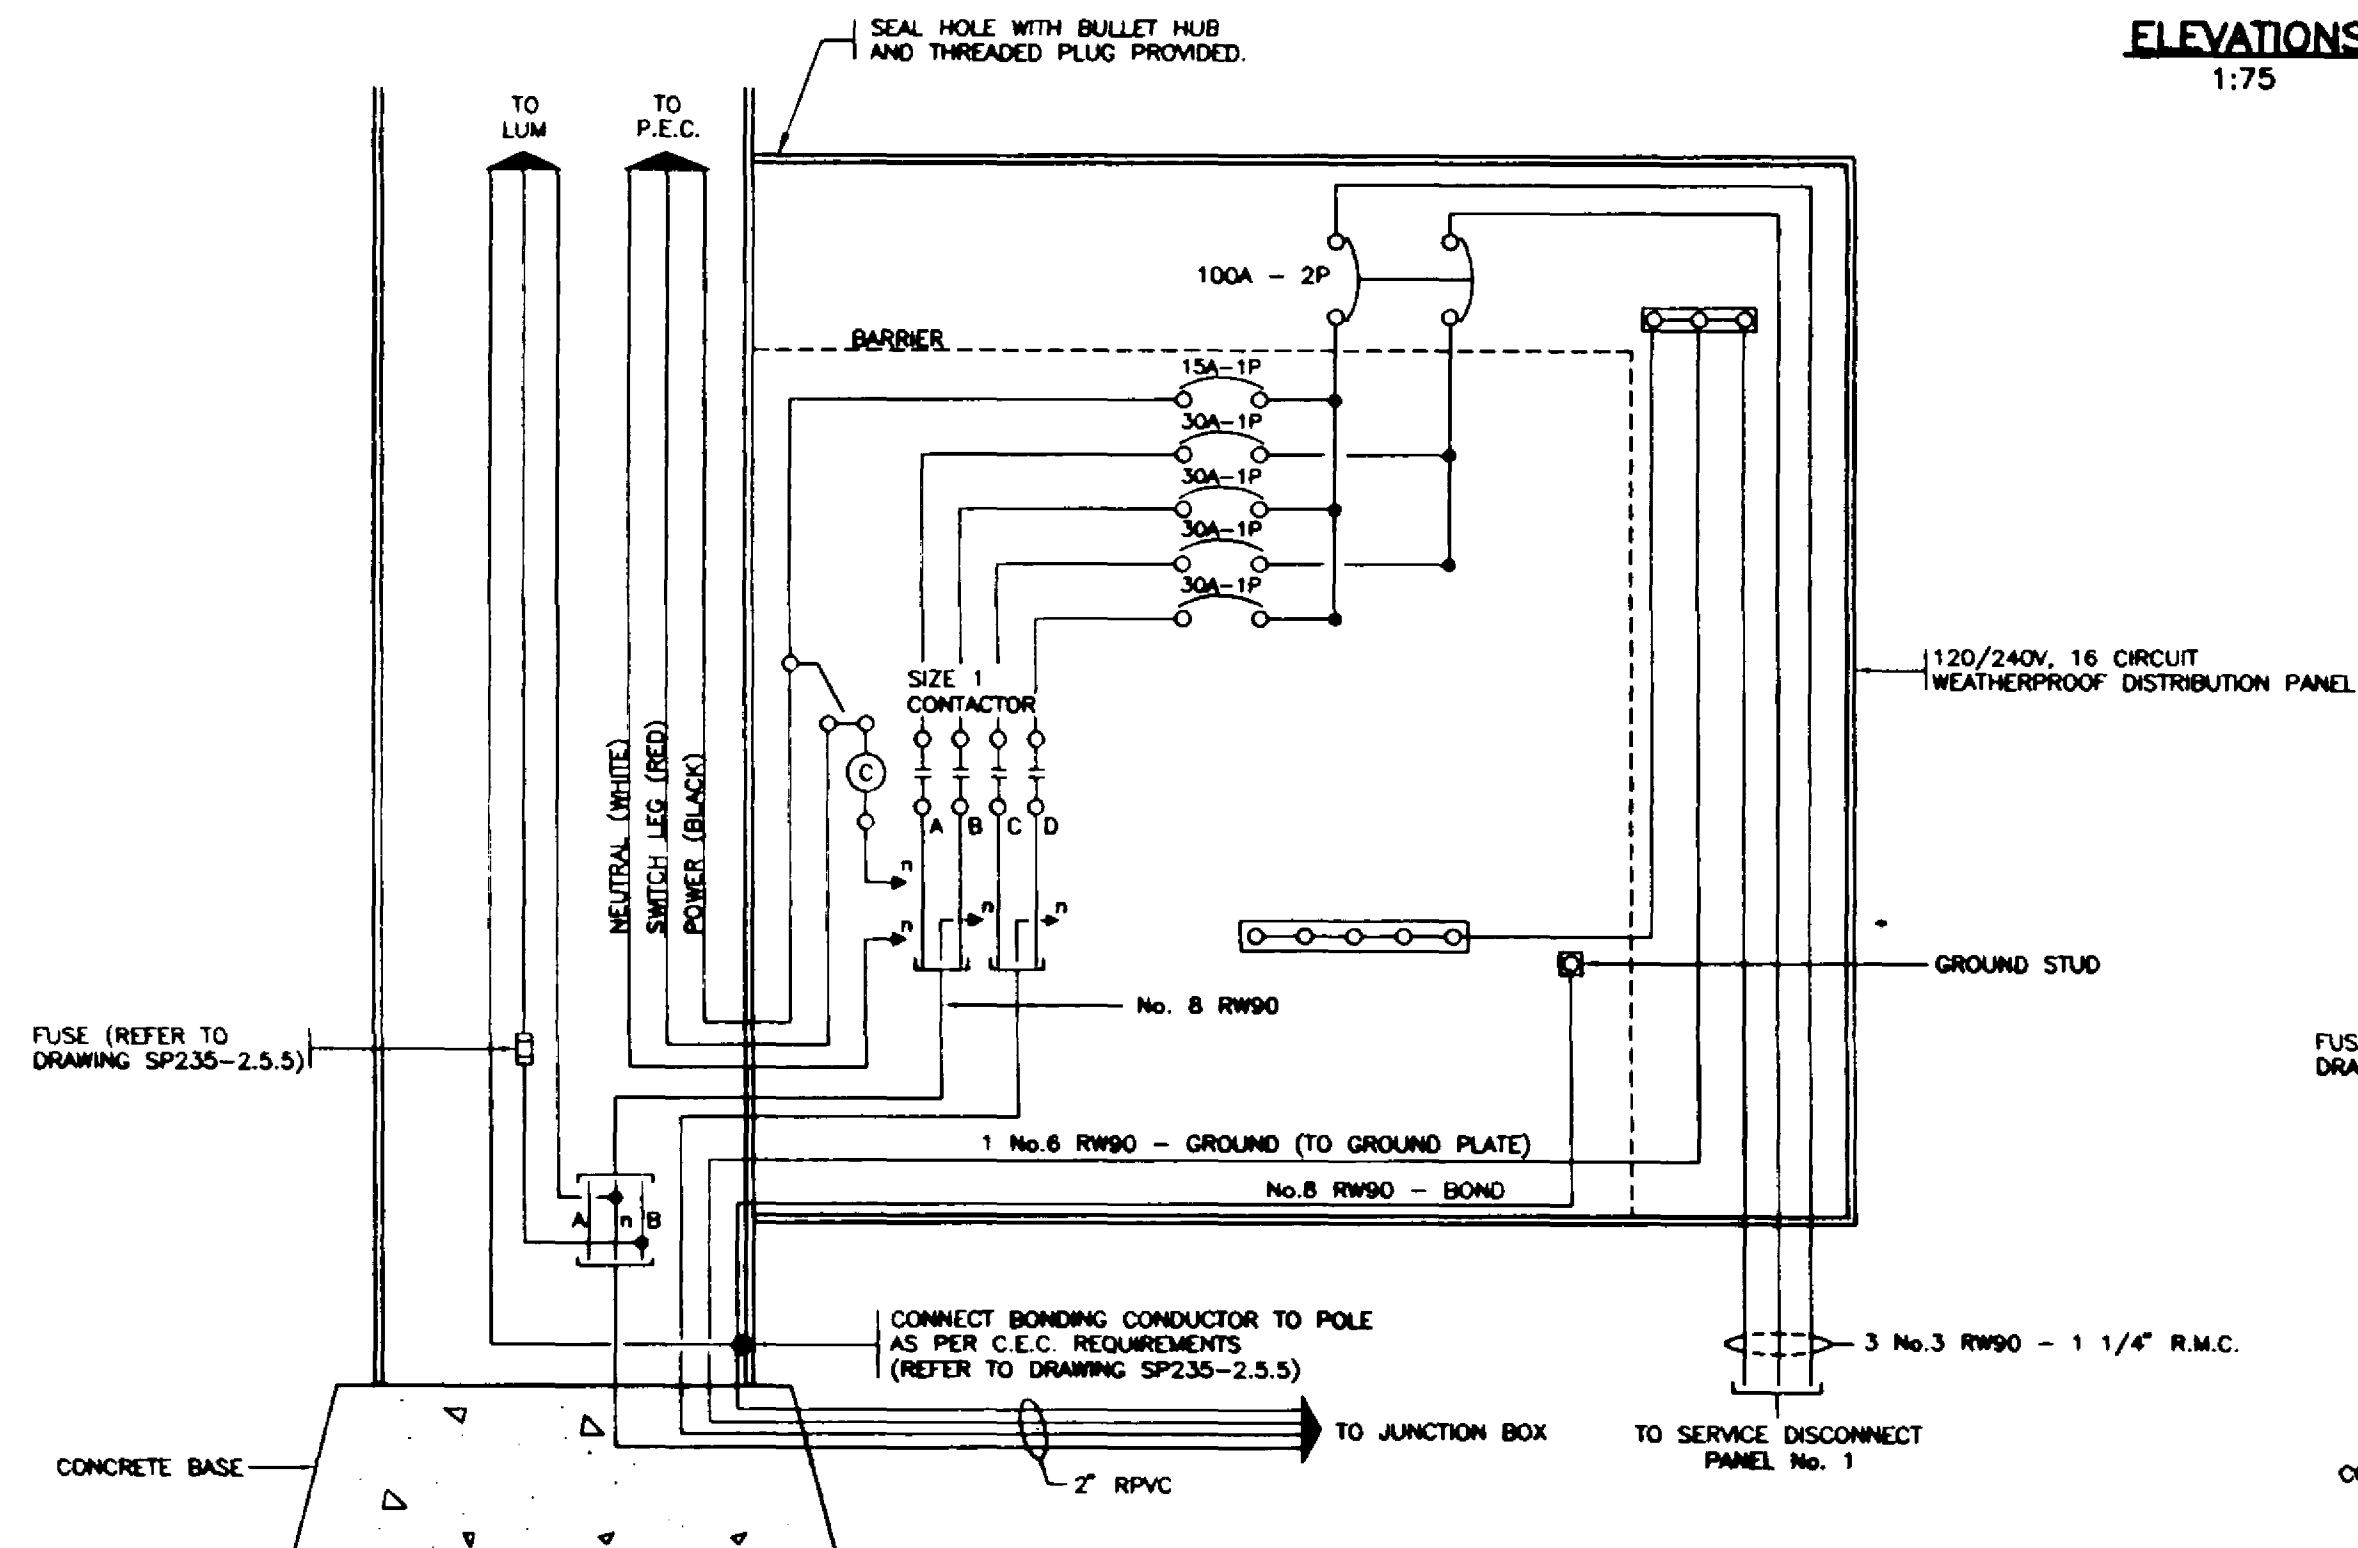

WIRING DIAGRAM - DISTRIBUTION PANEL No. 1
N.T.S.

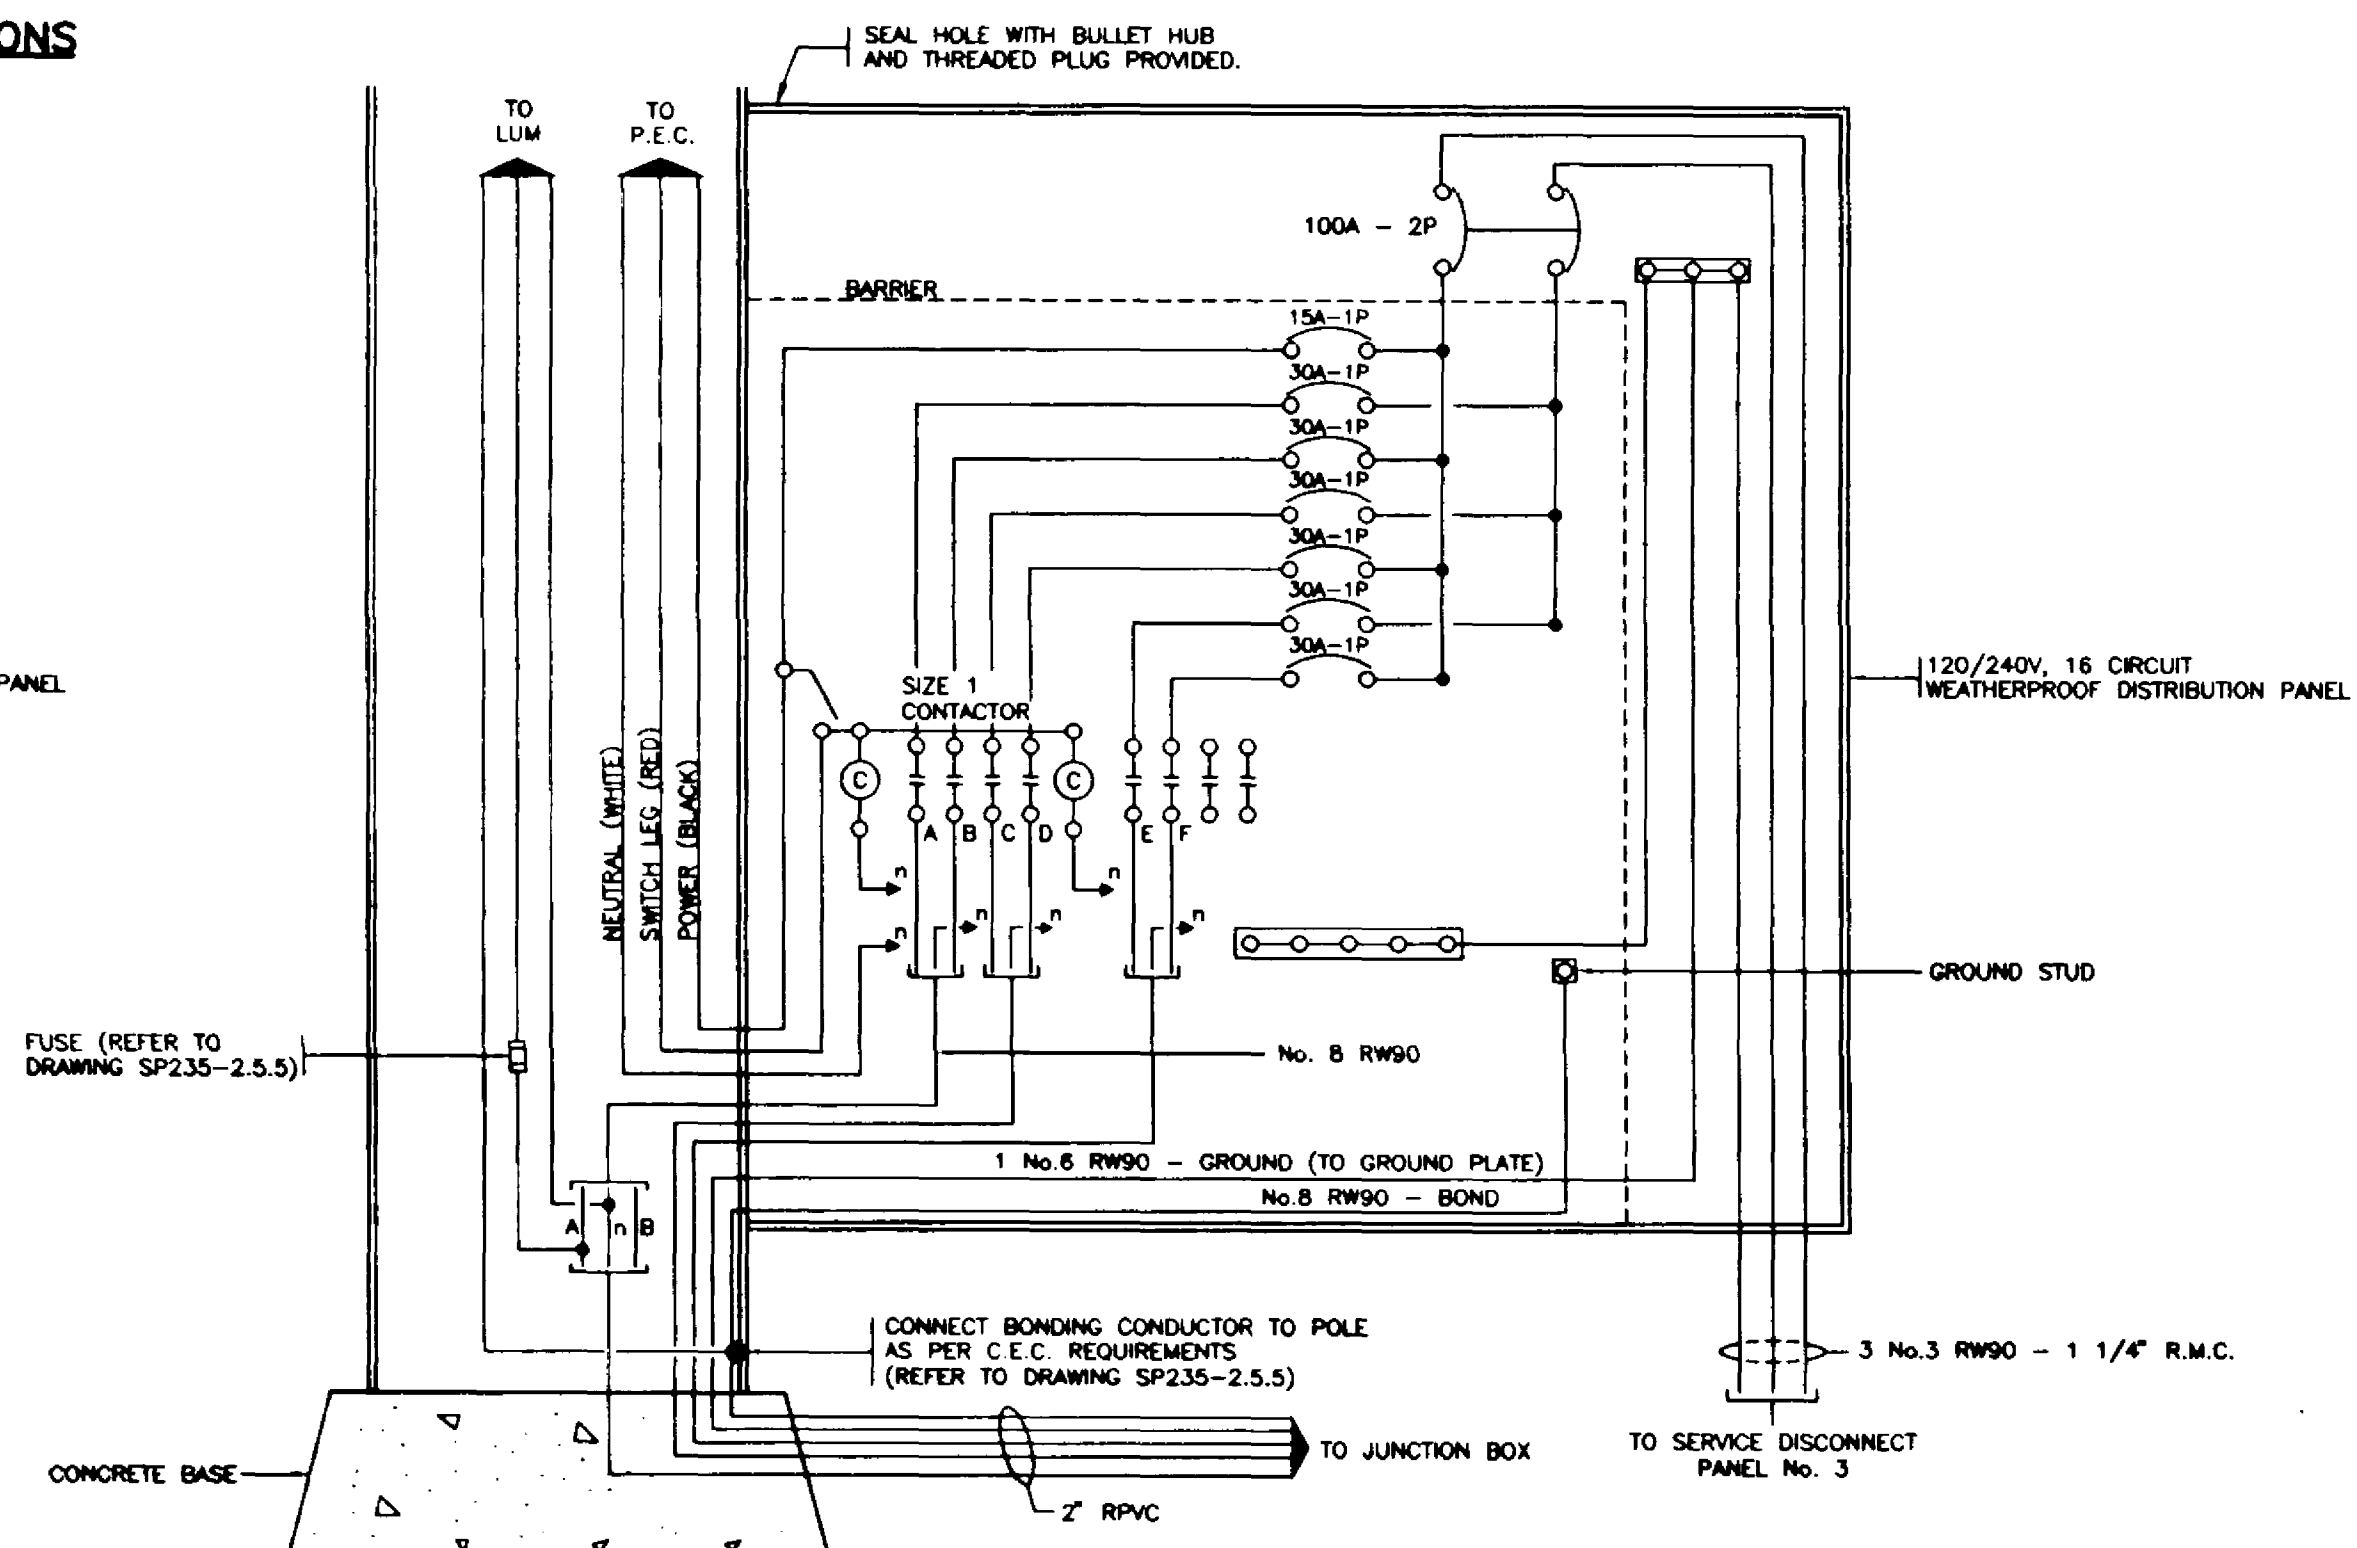

WIRING DIAGRAM - DISTRIBUTION PANEL No. 3
N.T.S.

LEGEND					
	PROPOSED CONCRETE BASE WITH FUTURE LUMINAIRE POLE		EXISTING CONCRETE BASE WITH PROPOSED LUMINAIRE POLE		PEC
	CONCRETE BASE AND JUNCTION BOX		CITY OR DISTRICT OF NORTH VANCOUVER LUMINAIRE POLE		RPVC
	JUNCTION BOX - No. DENOTES TYPE		COMBINATION LUMINAIRE/DAVIT MOUNTED ILLUMINATED SIGN POLE WITH AMBER FLASHERS		R.M.C.
	LUMINAIRE POLE (SINGLE)		COMBINATION LUMINAIRE/DAVIT MOUNTED ILLUMINATED SIGN WITH AMBER FLASHERS		F.M.C.
	DOUBLE LUMINAIRE POLE		DAVIT MOUNTED SIGN (NON-ILLUMINATED)		OVERHEAD FLASHING BEACON
	POST TOP MOUNTED LUMINAIRE		DAVIT MOUNTED ILLUMINATED SIGN POLE		POST MOUNTED FLASHER
	TRAFFIC SIGNAL POLE WITH DAVIT AND SIDE OF POLE MOUNTED HEADS		COMBINATION LUMINAIRE/DAVIT MOUNTED NON-ILLUMINATED SIGN POLE		BACKGUY
	COMBINATION LUMINAIRE/DAVIT MOUNTED TRAFFIC SIGNAL POLE		BREAKAWAY SIGN (NON-ILLUMINATED)		POWER POLE
	POST TOP MOUNTED SIGNAL		ILLUMINATED BREAKAWAY SIGN		TELEPHONE POLE
					POWER/TELEPHONE POLE

	TEST SWITCH		RAISED CURB
	BREAKER		PROPERTY LINE
	NEUTRAL BAR		EDGE OF GRAVEL SHOULDER
	VEHICLE DETECTOR LOOP		EDGE OF PAVEMENT
	SIGNAL HEAD VEHICLE PHASE		PAINT LINE
	SIGNAL HEAD PEDESTRIAN PHASE		PROPOSED UNDERGROUND CONDUIT
	PEDESTRIAN PUSHBUTTON		EXISTING UNDERGROUND CONDUIT
	U/G UTILITY		FENCE
	GAS		CORRUGATED METAL PIPE (CULVERT)
	STORM DRAINS/SEWERS		RETAINING WALL
	WATER		SOUND WALL
	ELECTRIC		CONCRETE ROADSIDE OR MEDIAN BARRIER
	TELEPHONE		
	SANITARY SEWER		

WALTER & SCI Construction
(Canada) Ltd.

SHAFLIK ENGINEERING LTD.
ELECTRICAL CONSULTANTS
202-8525 BAXTER PLACE, BURNABY, BC V5A 4V7 TEL: 604-421-4125 FAX: 604-421-8344

DESIGNED	DATE	DESIGNED	DATE
SCALE	AS NOTED	VOLTAGE	120/240
HWY.	DISTRICT HOWE SOUND	CHECKED	DATE
REV	DATE	DESCRIPTION	CONST
A	97-07-29	RECORD DRAWING	

REVISIONS	

Province of British Columbia
MINISTRY OF TRANSPORTATION AND HIGHWAYS
WESTVIEW INTERCHANGE DESIGN BUILD

SIGNALS, LIGHTING AND DIRECTIONAL SIGNING INSTALLATION
HOWE SOUND DISTRICT - HIGHWAY No.1
UPPER LEVELS HIGHWAY / WESTVIEW DRIVE INTERCHANGE
NORTH VANCOUVER

WIRING DIAGRAMS - ELEVATIONS

Ministry of Transportation and Highways	PREPARED UNDER THE DIRECTION OF	ACCEPTED FOR CONSTRUCTION
South Coast Regional Office	ORIGINAL SIGNED BY	ORIGINAL SIGNED BY
7818 - 6th Street	D. J. WONG	A. JACK
Burnaby, BC	CONSULTANT	QC/QA MANAGER
V3N 4N8	DATE	DATE
	96-02-14	96-02-16

SHEET	16	OF	22	PROJECT No.	06838	REG.	1	DRAWING No.	TE-95094-16
-------	----	----	----	-------------	-------	------	---	-------------	-------------

CANCEL PRINTS BEARING PREVIOUS LETTER