




150W LUMINAIRE POLE MOUNTED
BETWEEN SOUND WALL AND CRB ON 200 & 400 RAMPS

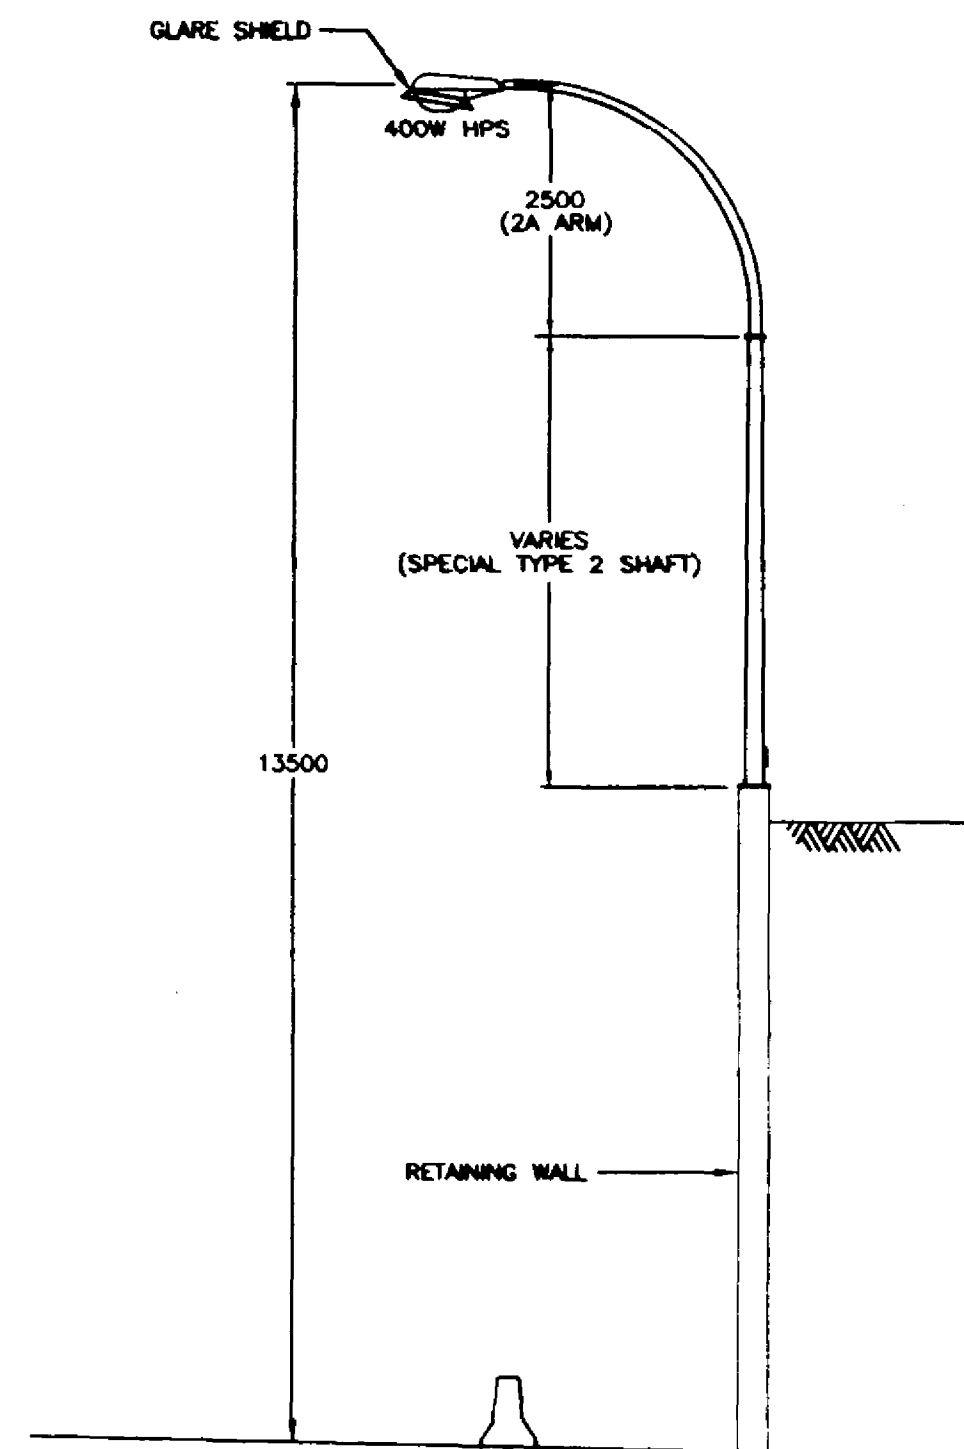


400W LUMINAIRE POLE MOUNTED ON
RETAINING WALL ON ROUTE 1
STA. 106+63

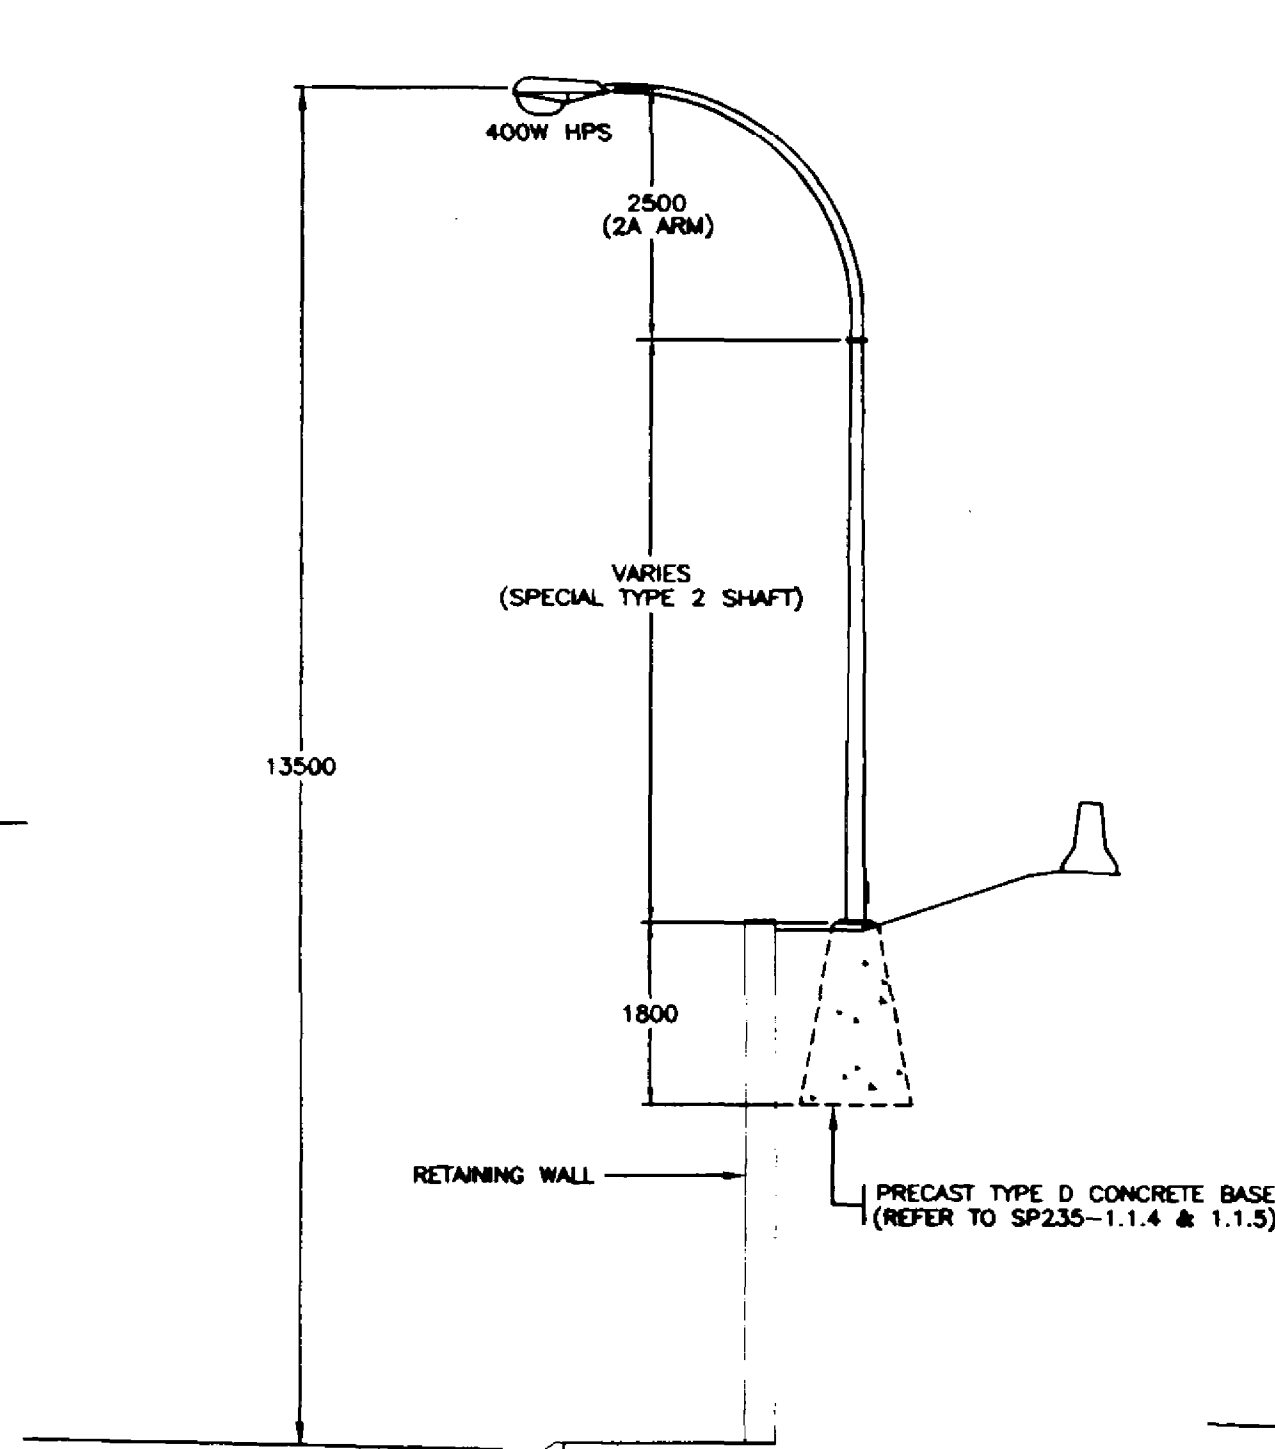

400W LUMINAIRE POLE BEHIND
RETAINING WALL ON ROUTE 1
STA. 113+86, 114+43 & 115+13

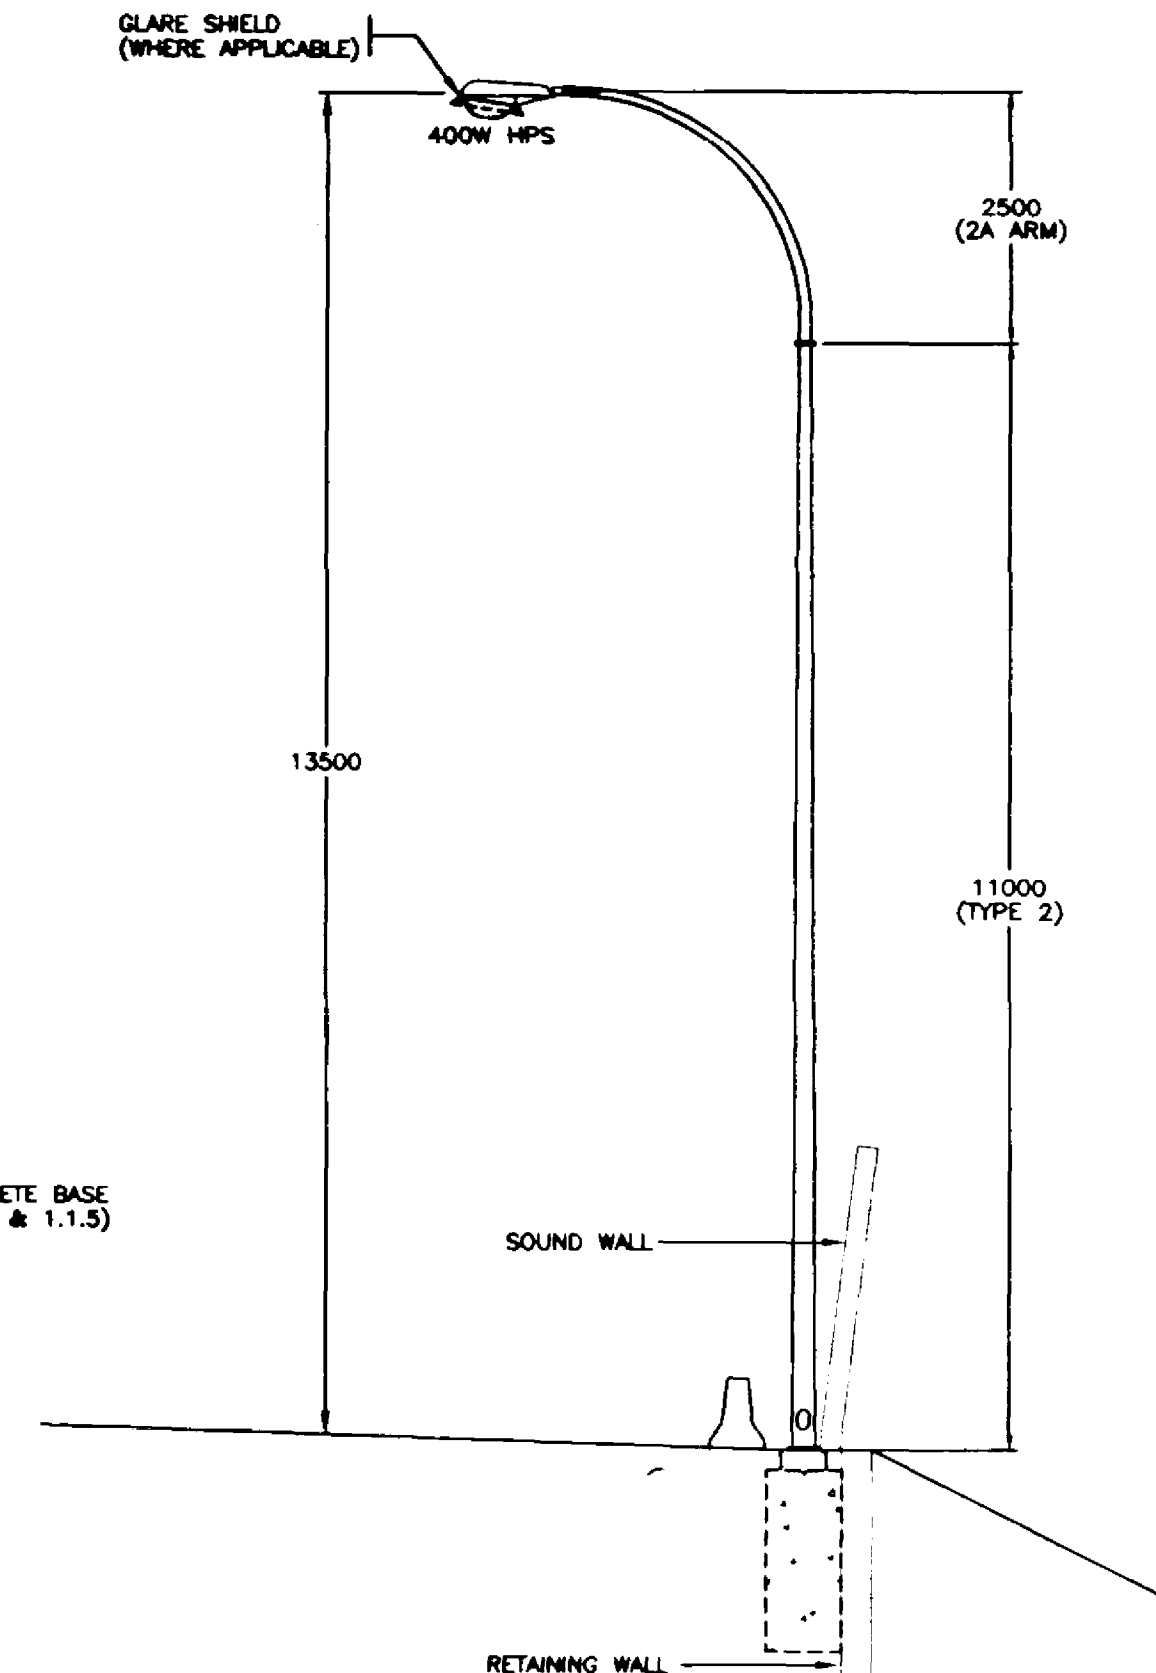

400W LUMINAIRE POLE MOUNTED BETWEEN SOUND WALL AND CRB
ON ROUTE 1 (EASTBOUND) EAST OF WESTVIEW DRIVE

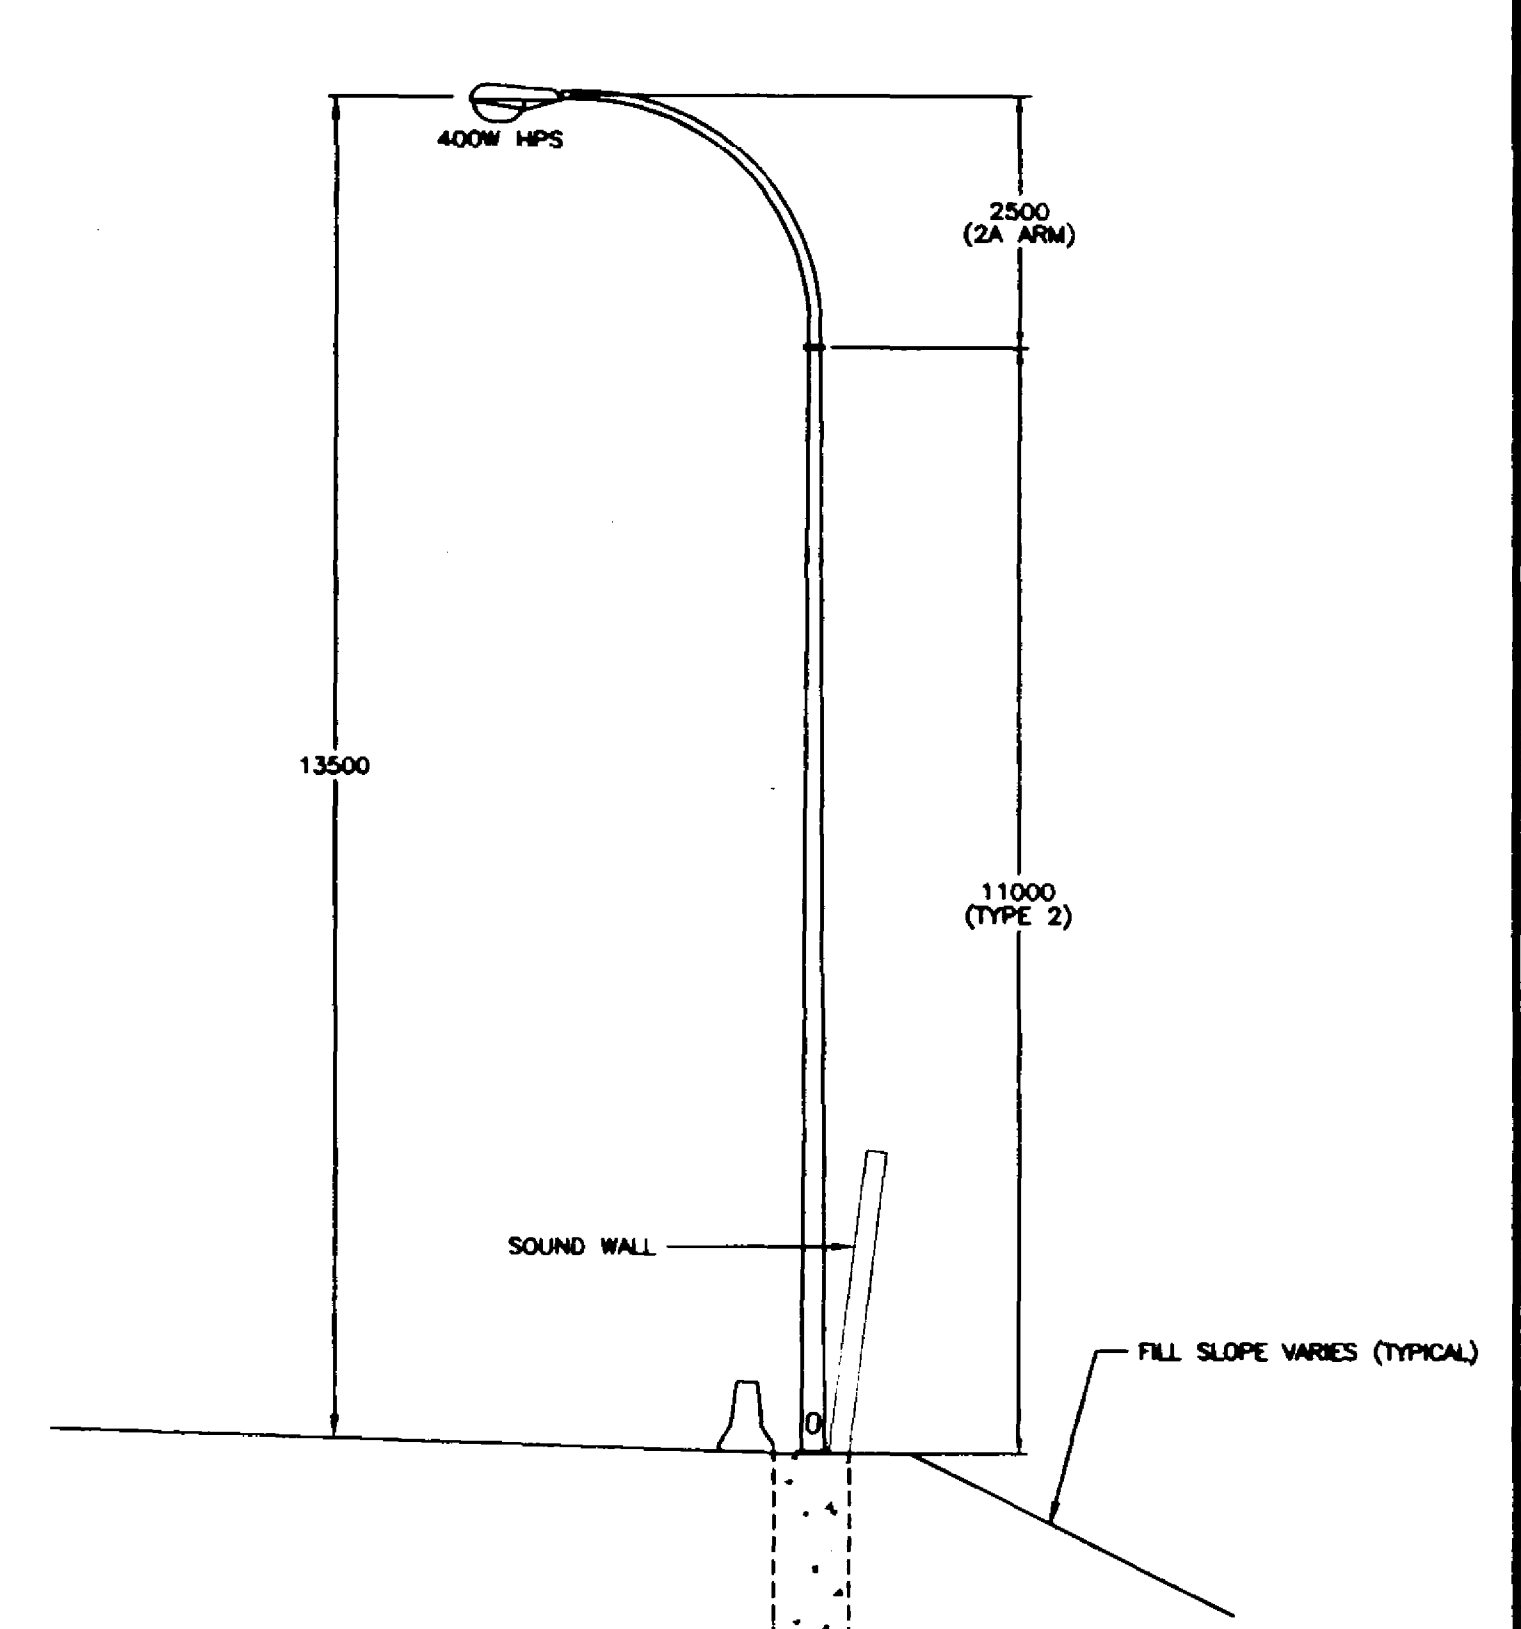

LUMINAIRE POLE MOUNTED BETWEEN SOUND WALL AND CRB
ON ROUTE 1 (WESTBOUND) EAST OF WESTVIEW DRIVE
STA. 116+88 to 119+88

ELEVATIONS 1:75

LEGEND

<p>PROPOSED CONCRETE BASE WITH FUTURE LUMINAIRE POLE</p> <p>CONCRETE BASE AND JUNCTION BOX</p> <p>JUNCTION BOX - No. DENOTES TYPE</p> <p>LUMINAIRE POLE (SINGLE) "F" DENOTES FRANGIBLE BASE "B" DENOTES BREAKAWAY BASE</p> <p>DOUBLE LUMINAIRE POLE</p> <p>POST TOP MOUNTED LUMINAIRE</p> <p>TRAFFIC SIGNAL POLE WITH DAVIT AND SIDE OF POLE MOUNTED HEADS</p> <p>COMBINATION LUMINAIRE/DAVIT MOUNTED TRAFFIC SIGNAL POLE</p> <p>POST TOP MOUNTED SIGNAL</p>	<p>EXISTING CONCRETE BASE WITH PROPOSED LUMINAIRE POLE</p> <p>CITY OR DISTRICT OF NORTH VANCOUVER LUMINAIRE POLE</p> <p>DAVIT MOUNTED ILLUMINATED SIGN POLE WITH AMBER FLASHERS</p> <p>COMBINATION LUMINAIRE/DAVIT MOUNTED ILLUMINATED SIGN WITH AMBER FLASHERS</p> <p>DAVIT MOUNTED SIGN (NON-ILLUMINATED)</p> <p>DAVIT MOUNTED ILLUMINATED SIGN POLE</p> <p>COMBINATION LUMINAIRE/DAVIT MOUNTED NON-ILLUMINATED SIGN POLE</p> <p>BREAKAWAY SIGN (NON-ILLUMINATED)</p> <p>ILLUMINATED BREAKAWAY SIGN</p>	<p>PEC</p> <p>PHOTO ELECTRIC CELL</p> <p>RPVC</p> <p>RIGID P.V.C. CONDUIT</p> <p>R.M.C.</p> <p>RIGID METALLIC CONDUIT</p> <p>F.M.C.</p> <p>FLEXIBLE METALLIC CONDUIT (LIQUID TIGHT)</p> <p>OVERHEAD FLASHING BEACON</p> <p>POST MOUNTED FLASHER</p> <p>BACKGUY</p> <p>POWER POLE</p> <p>TELEPHONE POLE</p> <p>POWER/TELEPHONE POLE</p>	<p>TEST SWITCH</p> <p>BREAKER</p> <p>NEUTRAL BAR</p> <p>VEHICLE DETECTOR LOOP</p> <p>A,B,A1,A2,ETC. SIGNAL HEAD VEHICLE PHASE</p> <p>PAPB,PA1,PB2,ETC. SIGNAL HEAD PEDESTRIAN PHASE</p> <p>PPB PEDESTRIAN PUSHBUTTON</p> <p>U/G UTILITY</p> <p>"C" DENOTES GAS</p> <p>"S" DENOTES STORM DRAINS/SEWERS</p> <p>"W" DENOTES WATER</p> <p>"UE" DENOTES ELECTRIC</p> <p>"UT" DENOTES TELEPHONE</p> <p>"SAN" DENOTES SANITARY SEWER</p>	<p>RAISED CURB</p> <p>PROPERTY LINE</p> <p>EDGE OF GRAVEL SHOULDER</p> <p>EDGE OF PAVEMENT</p> <p>PAINT LINE</p> <p>PROPOSED UNDERGROUND CONDUIT</p> <p>EXISTING UNDERGROUND CONDUIT</p> <p>FENCE</p> <p>CORRUGATED METAL PIPE (CULVERT)</p> <p>RETAINING WALL</p> <p>SOUND WALL</p> <p>CONCRETE ROADSIDE OR MEDIAN BARRIER</p>
--	---	--	---	---

WALTER & SCI Construction (Canada) Ltd.				
SHAFLIK ENGINEERING LTD. ELECTRICAL CONSULTANTS 202-8525 BAXTER PLACE, BURNABY, BC V5A 4V7 TEL: 604-421-4125 FAX: 604-421-8344				
ELECTRICAL DESIGN APPROVED _____ DATE _____ DESIGNED _____ D.S.M. DATE NOV95 SCALE AS NOTED VOLTAGE 120/240 HWY. DISTRICT HOWE SOUND CHECKED _____ D.J.W. DATE 98-12-20				
REV	DATE	DESCRIPTION	CONST	QA/QC
A	97-07-28	RECORD DRAWING		
REVISIONS				

REFER TO SHEET 1 FOR NOTES

Province of British Columbia MINISTRY OF TRANSPORTATION AND HIGHWAYS WESTVIEW INTERCHANGE DESIGN BUILD	
SIGNALS, LIGHTING AND DIRECTIONAL SIGNING INSTALLATION HOWE SOUND DISTRICT - HIGHWAY No.1 UPPER LEVELS HIGHWAY / WESTVIEW DRIVE INTERCHANGE NORTH VANCOUVER	
LUMINAIRE POLE ELEVATIONS	
Ministry of Transportation and Highways South Coast Regional Office 7818 - 6th Street Burnaby, BC V3N 4N6	PREPARED UNDER THE DIRECTION OF ORIGINAL SIGNED BY D. J. WONG CONSULTANT DATE 98-02-14 PROJECT No. 06838 SHEET 15 OF 22
ACCEPTED FOR CONSTRUCTION ORIGINAL SIGNED BY A. JACK QC/QA MANAGER DATE 98-02-16 DRAWING No. TE-95094-15	1

CANCEL PRINTS BEARING PREVIOUS LETTER