


LOCATION MAP
N.T.S.

PROVINCE OF BRITISH COLUMBIA
MINISTRY OF TRANSPORTATION AND HIGHWAYS
PROJECT No. 06838

SIGNALS, LIGHTING AND DIRECTIONAL SIGNING INSTALLATION
HOWE SOUND DISTRICT - HIGHWAY No.1
UPPER LEVELS HIGHWAY / WESTVIEW DRIVE INTERCHANGE
NORTH VANCOUVER

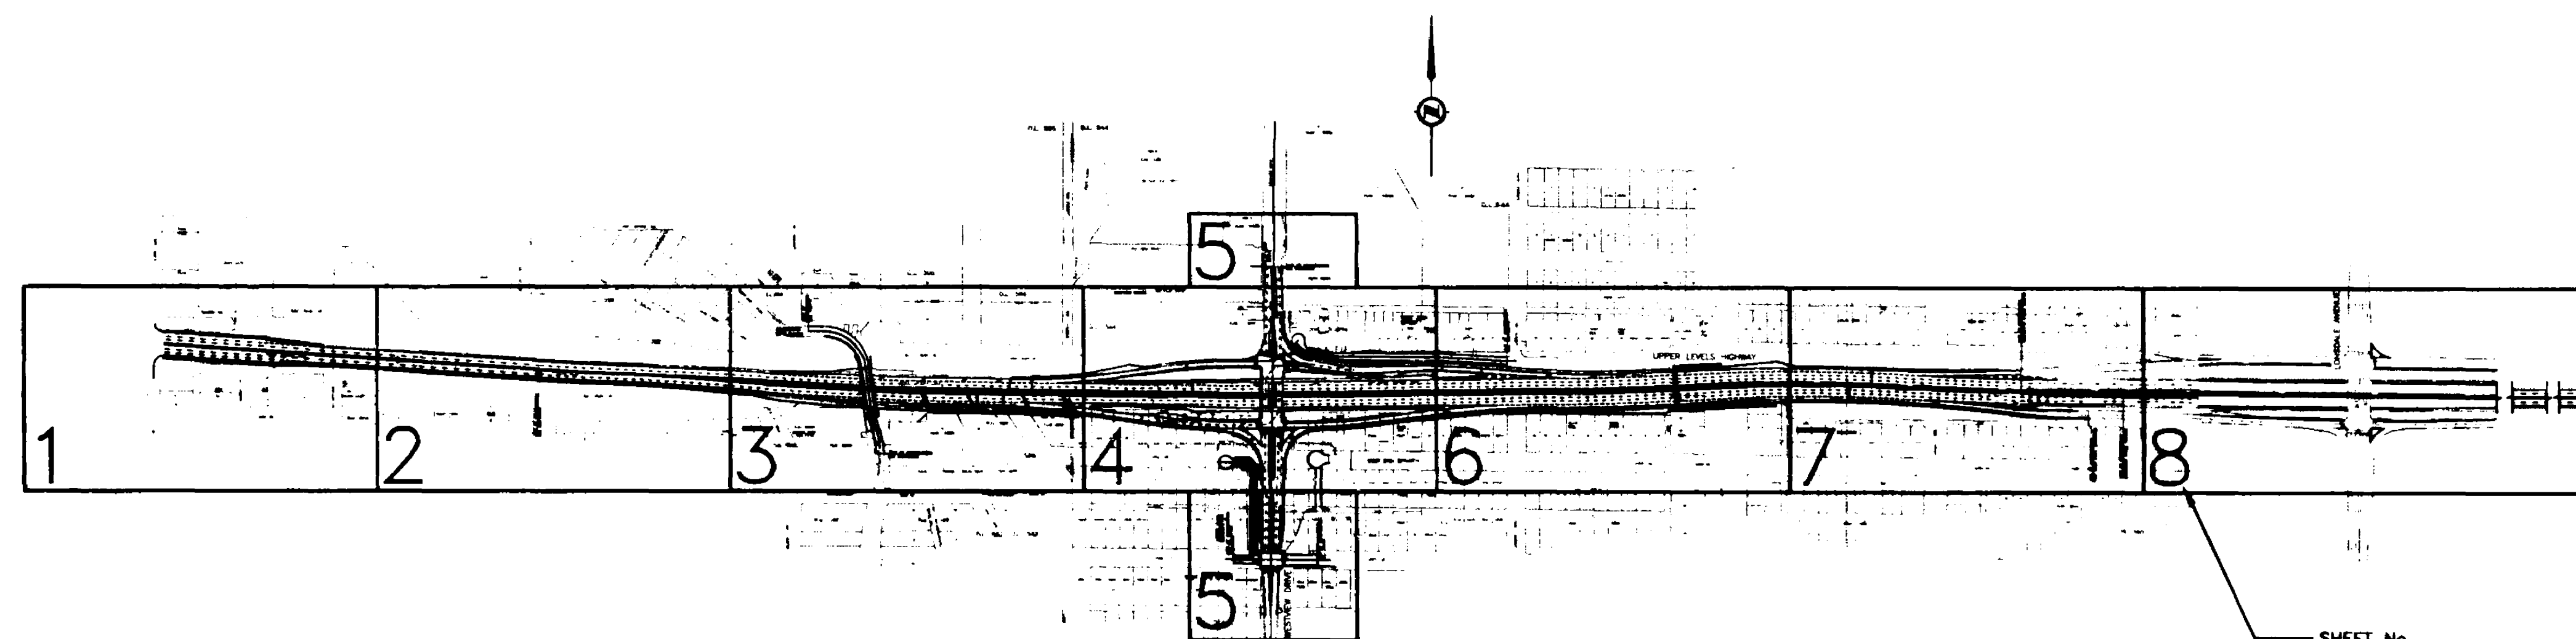

SITE PLAN
1:5000

DRAWING INDEX	
DWG. No.	DESCRIPTION
TE-95094-0	KEY PLAN - DRAWING INDEX
TE-95094-1	SITE PLAN - NOTES - ILLUMINATION LEVELS
TE-95094-2	SITE PLAN
TE-95094-3	SITE PLAN
TE-95094-4	SITE PLAN
TE-95094-5	SITE PLAN - DETAILS
TE-95094-6	SITE PLAN
TE-95094-7	SITE PLAN
TE-95094-8	SITE PLAN
TE-95094-9	SITE PLAN ENLARGEMENT - WESTVIEW DRIVE
TE-95094-10	WIRING DIAGRAM - SIGNAL DISPLAY - DETAILS
TE-95094-11	ELEVATIONS
TE-95094-12	SITE PLAN ENLARGEMENT (WESTVIEW DR. AT 23rd ST.)
TE-95094-13	WIRING DIAGRAM - ELEVATIONS - DETAILS
TE-95094-14	LUMINAIRE POLE ELEVATIONS
TE-95094-15	LUMINAIRE POLE ELEVATIONS
TE-95094-16	WIRING DIAGRAMS - ELEVATIONS
TE-95094-17	SIGN ELEVATIONS
TE-95094-18	SIGN ELEVATIONS
TE-95094-19	SIGN ELEVATIONS
TE-95094-20	TYPE H POLE SPREAD FOOTING DETAILS
TE-95094-21	SIGN ELEVATIONS
TE-95094-22	SIGN ELEVATIONS

LEGEND

	PROPOSED CONCRETE BASE WITH FUTURE LUMINAIRE POLE		EXISTING CONCRETE BASE WITH PROPOSED LUMINAIRE POLE		PEC PHOTO ELECTRIC CELL		TEST SWITCH
	CONCRETE BASE AND JUNCTION BOX		CITY OR DISTRICT OF NORTH VANCOUVER LUMINAIRE POLE		R.P.V.C. RIGID P.V.C. CONDUIT		BREAKER
	JUNCTION BOX - No. DENOTES TYPE		DAVIT MOUNTED ILLUMINATED SIGN POLE WITH AMBER FLASHERS		R.M.C. RIGID METALLIC CONDUIT		NEUTRAL BAR
	LUMINAIRE POLE (SINGLE)		COMBINATION LUMINAIRE/DAVIT MOUNTED ILLUMINATED SIGN WITH AMBER FLASHERS		F.M.C. FLEXIBLE METALLIC CONDUIT (LIQUID TIGHT)		VEHICLE DETECTOR LOOP
	DOUBLE LUMINAIRE POLE		DAVIT MOUNTED SIGN (NON-ILLUMINATED)		O.F.B. OVERHEAD FLASHING BEACON		A,B,A2,A2,ETC. SIGNAL HEAD VEHICLE PHASE
	POST TOP MOUNTED LUMINAIRE		DAVIT MOUNTED ILLUMINATED SIGN POLE		P.M.F. POST MOUNTED FLASHER		P.A,P.B,PA1,PB2,ETC. SIGNAL HEAD PEDESTRIAN PHASE
	TRAFFIC SIGNAL POLE WITH DAVIT AND SIDE OF POLE MOUNTED HEADS		COMBINATION LUMINAIRE/DAVIT MOUNTED NON-ILLUMINATED SIGN POLE		B.G. BACKGUY		P.P.B. PEDESTRIAN PUSHBUTTON
	COMBINATION LUMINAIRE/DAVIT MOUNTED TRAFFIC SIGNAL POLE		BREAKAWAY SIGN (NON-ILLUMINATED)		P.P. POWER POLE		U/G UTILITY
	POST TOP MOUNTED SIGNAL		ILLUMINATED BREAKAWAY SIGN		T.P. TELEPHONE POLE		"G" DENOTES GAS
					P.T.P. POWER/TELEPHONE POLE		"S" DENOTES STORM DRAINS/SEWERS
							"W" DENOTES WATER
							"E" DENOTES ELECTRIC
							"T" DENOTES TELEPHONE
							"S" DENOTES SANITARY SEWER

	WALTER & SCI Construction (Canada) Ltd.	
SHAFLIK ENGINEERING LTD.		
ELECTRICAL CONSULTANTS		
202-8525 BAXTER PLACE, BURNABY, BC V5A 4V7 TEL: 604-421-4125 FAX: 604-421-8344		
ELECTRICAL DESIGN APPROVED _____ DATE _____ DESIGNED _____ D.S.M. DATE NOV95		
SCALE AS NOTED VOLTAGE 120/240		
HWY. DISTRICT HOWE SOUND CHECKED _____ D.J.W. DATE 95-12-20		
REV	DATE	DESCRIPTION
A	97-07-28	RECORD DRAWING
REVISIONS		

		Province of British Columbia MINISTRY OF TRANSPORTATION AND HIGHWAYS WESTVIEW INTERCHANGE DESIGN BUILD	
SIGNALS, LIGHTING AND DIRECTIONAL SIGNING INSTALLATION HOWE SOUND DISTRICT - HIGHWAY No.1 UPPER LEVELS HIGHWAY / WESTVIEW DRIVE INTERCHANGE NORTH VANCOUVER			
KEY PLAN - DRAWING INDEX			
Ministry of Transportation and Highways South Coast Regional Office 7818 - 8th Street Burnaby, BC V5N 4M0		PREPARED UNDER THE DIRECTION OF ORIGINAL SIGNED BY D. J. WONG CONSULTANT DATE 95-02-14	
SHEET No. SHEET 0 OF 22		PROJECT No. 06838	
REVISIONS		DRAWING No. TE-95094-0	

CANCEL PRINTS BEARING PREVIOUS LETTER