




SIGN POLE No. 1
(TYPE H POLE SIGN STRUCTURE)
STA. 103+57 (UPPER LEVELS)

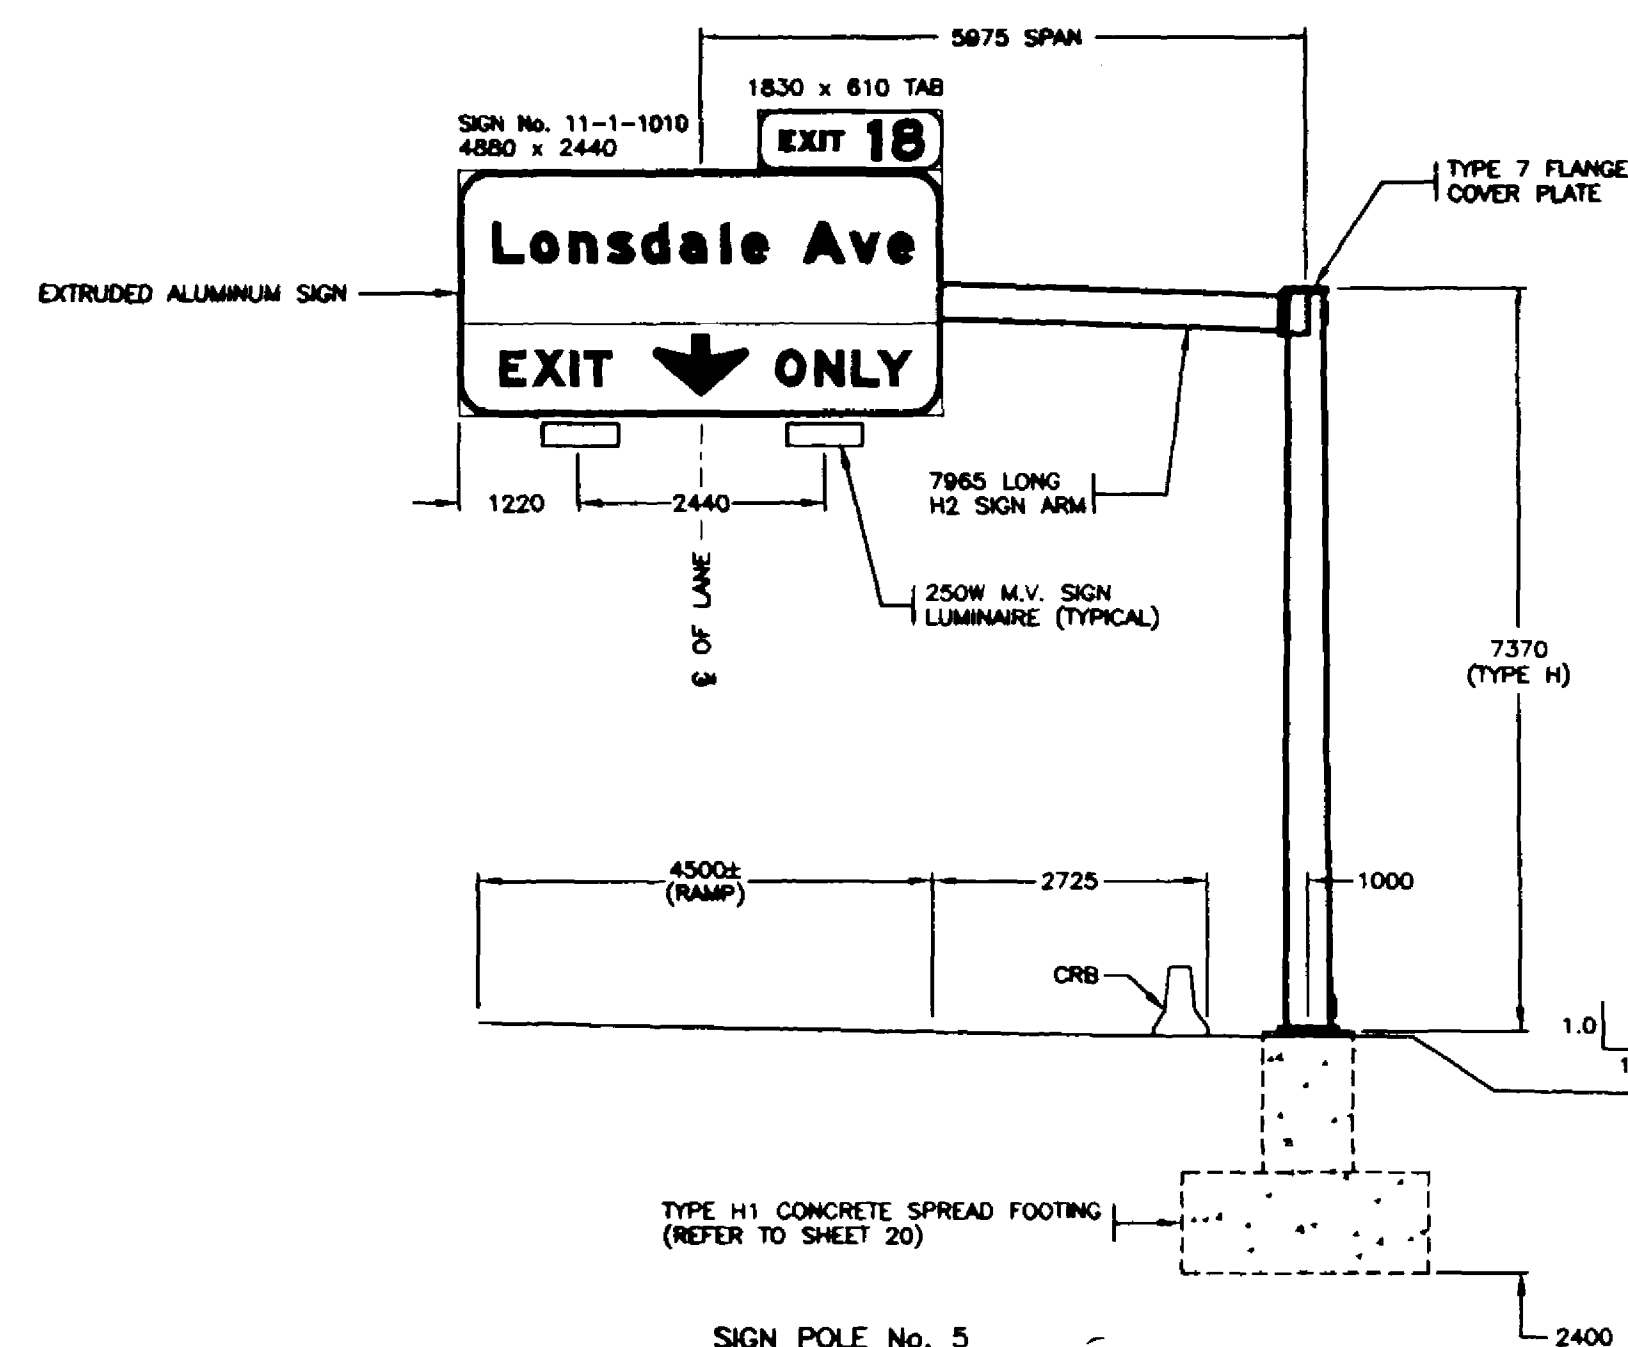

SIGN POLE No. 5
(TYPE H POLE SIGN STRUCTURE)
STA. 121+08 (UPPER LEVELS)

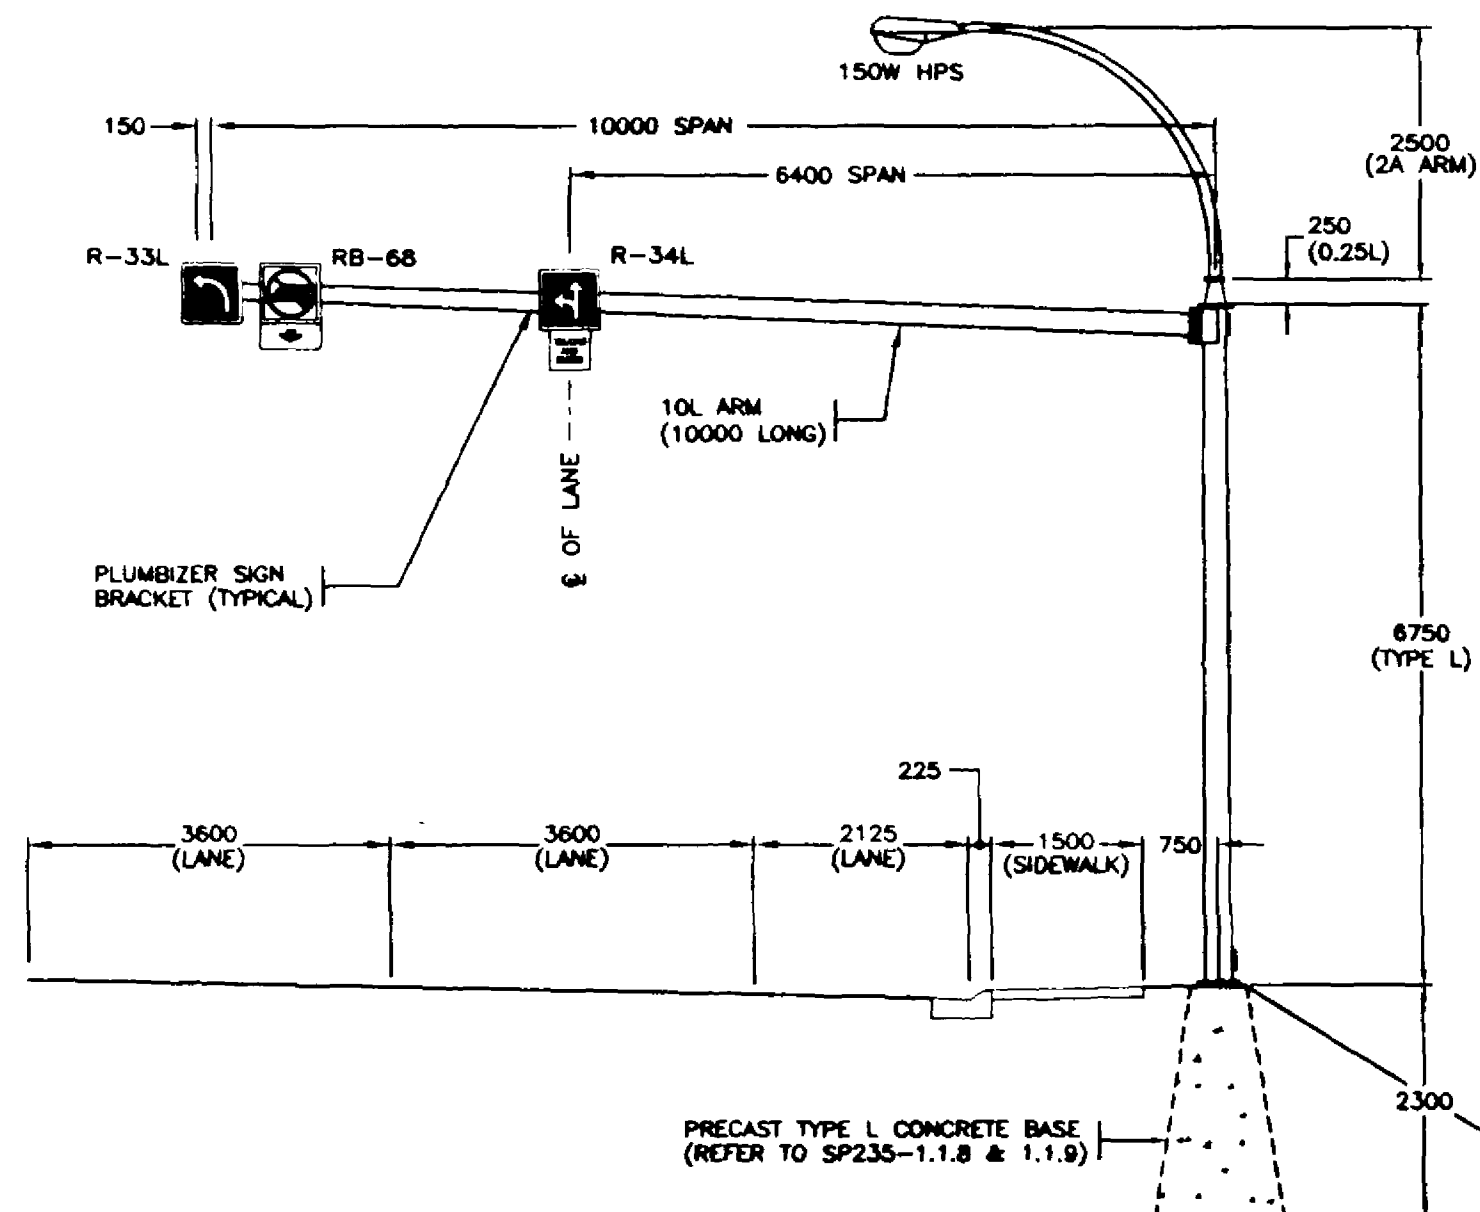

LANE DESIGNATION SIGN POLE No. 1
STA. 32+36 (300 RAMP)

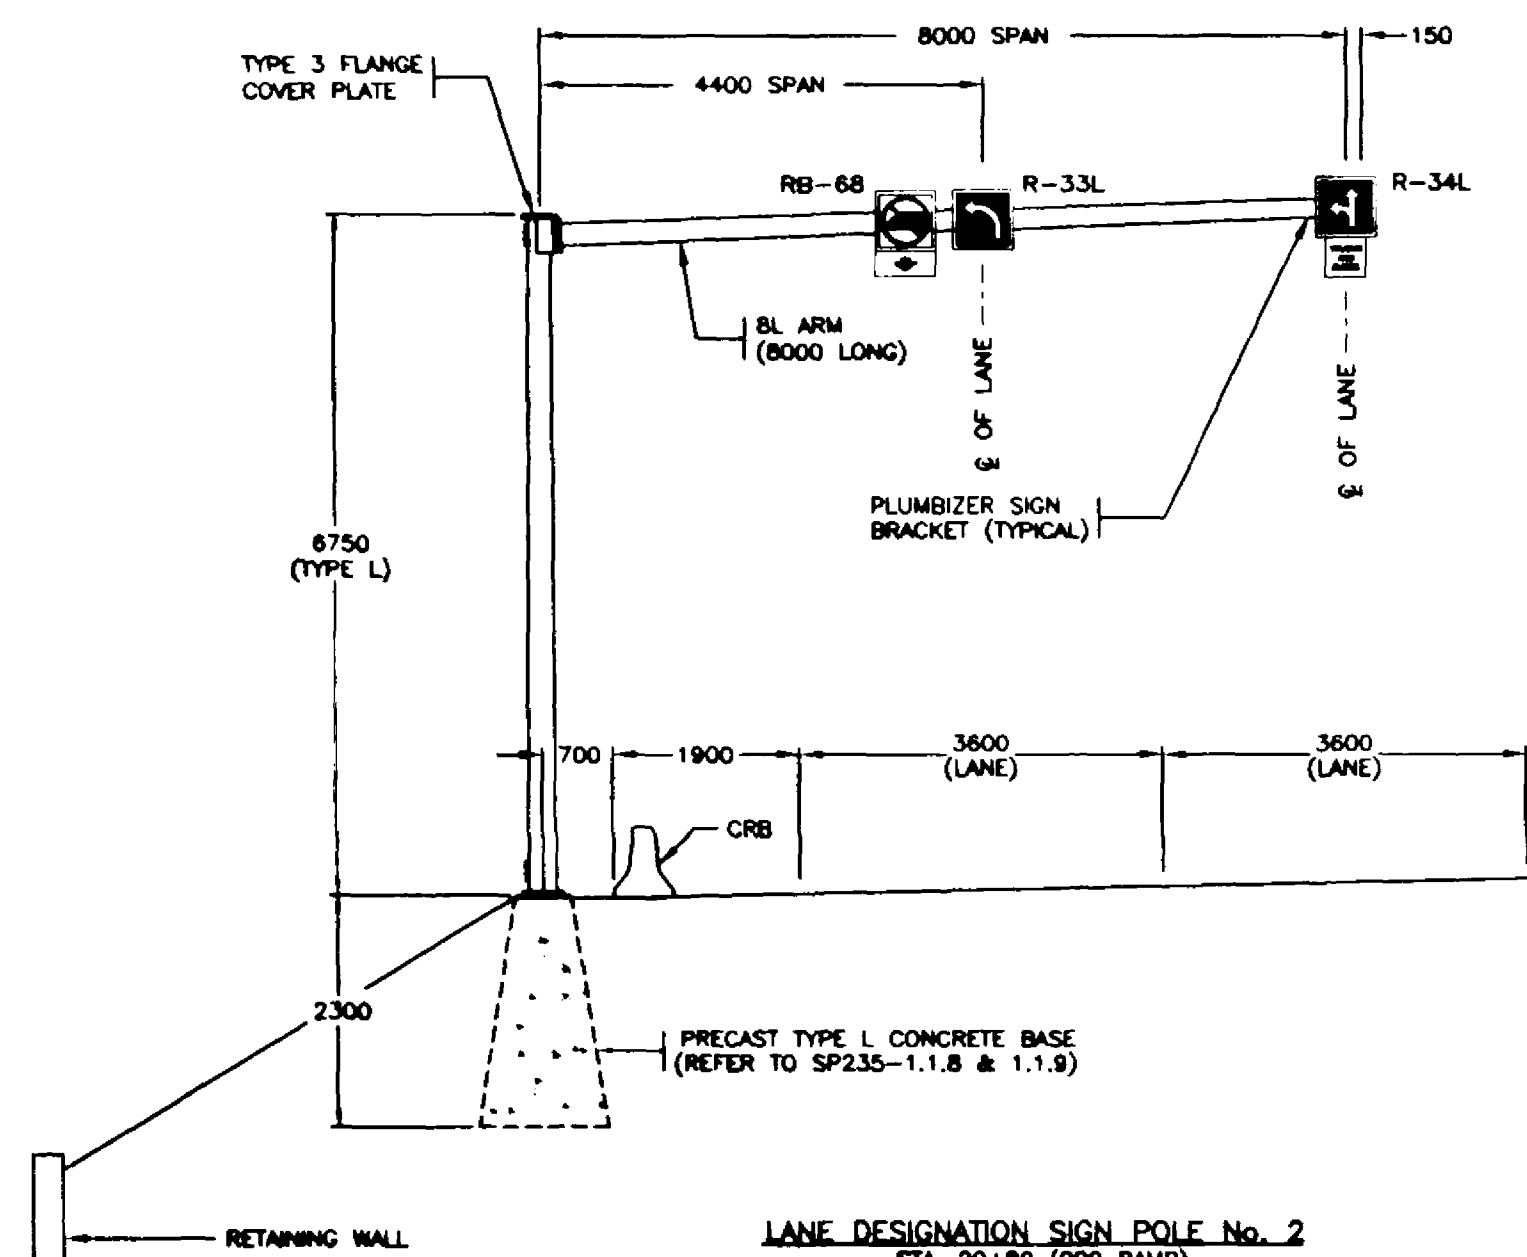

LANE DESIGNATION SIGN POLE No. 2
STA. 20+80 (200 RAMP)

ELEVATIONS 1:75

LEGEND			
<ul style="list-style-type: none"> PROPOSED CONCRETE BASE WITH FUTURE LUMINAIRE POLE CONCRETE BASE AND JUNCTION BOX JUNCTION BOX - No. DENOTES TYPE LUMINAIRE POLE (SINGLE) DOUBLE LUMINAIRE POLE POST TOP MOUNTED LUMINAIRE TRAFFIC SIGNAL POLE WITH DAVIT AND SIDE OF POLE MOUNTED HEADS COMBINATION LUMINAIRE/DAVIT MOUNTED TRAFFIC SIGNAL POLE POST TOP MOUNTED SIGNAL 	<ul style="list-style-type: none"> EXISTING CONCRETE BASE WITH PROPOSED LUMINAIRE POLE CITY OR DISTRICT OF NORTH VANCOUVER LUMINAIRE POLE DAVIT MOUNTED ILLUMINATED SIGN POLE WITH AMBER FLASHERS COMBINATION LUMINAIRE/DAVIT MOUNTED ILLUMINATED SIGN WITH AMBER FLASHERS DAVIT MOUNTED SIGN (NON-ILLUMINATED) DAVIT MOUNTED ILLUMINATED SIGN POLE COMBINATION LUMINAIRE/DAVIT MOUNTED NON-ILLUMINATED SIGN POLE BREAKAWAY SIGN (NON-ILLUMINATED) ILLUMINATED BREAKAWAY SIGN 	<ul style="list-style-type: none"> PROPOSED CONCRETE BASE WITH PROPOSED LUMINAIRE POLE PEC PHOTO ELECTRIC CELL RPVC RIGID P.V.C. CONDUIT R.M.C. RIGID METALLIC CONDUIT F.M.C. FLEXIBLE METALLIC CONDUIT (LIQUID TIGHT) OVERHEAD FLASHING BEACON POST MOUNTED FLASHER BACKGUY POWER POLE TELEPHONE POLE POWER/TELEPHONE POLE 	<ul style="list-style-type: none"> TEST SWITCH BREAKER NEUTRAL BAR VEHICLE DETECTOR LOOP SIGNAL HEAD VEHICLE PHASE SIGNAL HEAD PEDESTRIAN PHASE PEDESTRIAN PUSHBUTTON U/G UTILITY 'G' DENOTES GAS 'S' DENOTES STORM DRAINS/SEWERS 'W' DENOTES WATER 'E' DENOTES ELECTRIC 'UT' DENOTES TELEPHONE 'SAN' DENOTES SANITARY SEWER

WALTER & SCI Construction (Canada) Ltd.

202-8525 BAXTER PLACE, BURNABY, BC V5A 4V7 TEL: 804-421-4125 FAX: 804-421-8344

SHAFLIK ENGINEERING LTD.

ELECTRICAL CONSULTANTS

202-8525 BAXTER PLACE, BURNABY, BC V5A 4V7 TEL: 804-421-4125 FAX: 804-421-8344

REV	DATE	DESCRIPTION	CONS	QC/QA
A	98-02-28	SIGN POLES 3 & 4 DELETED	D.S.M.	A.J.
B	98-06-14	SIGN POLE No.1 REVISED	D.S.M.	A.J.
C	97-07-28	RECORD DRAWING	D.J.W.	A.J.
D	97-11-28	RECORD DRAWING REVISED	D.J.W.	A.J.

REVISIONS

Province of British Columbia
MINISTRY OF TRANSPORTATION AND HIGHWAYS
WESTVIEW INTERCHANGE DESIGN BUILD

REFER TO SHEET 1 FOR NOTES

SIGNALS, LIGHTING AND DIRECTIONAL SIGNING INSTALLATION
HOWE SOUND DISTRICT - HIGHWAY No.1
UPPER LEVELS HIGHWAY / WESTVIEW DRIVE INTERCHANGE
NORTH VANCOUVER

SIGN ELEVATIONS

PREPARED UNDER THE DIRECTION OF	ACCEPTED FOR CONSTRUCTION
ORIGINAL SIGNED BY D. J. WONG CONSULTANT	ORIGINAL SIGNED BY A. JACK QC/QA MANAGER
DATE 98-02-14	DATE 98-02-16

SHEET No. 17 OF 22 PROJECT No. 06838 REG. 1 DRAWING No. TE-95094-17 D

CANCEL PRINTS BEARING PREVIOUS LETTER