


FOR MINISTRY USE ONLY
REFER TO DRAWING TE-89037-7
(FINAL STAGE ELECTRICAL)
FOR CONTINUATION OF LIGHTING

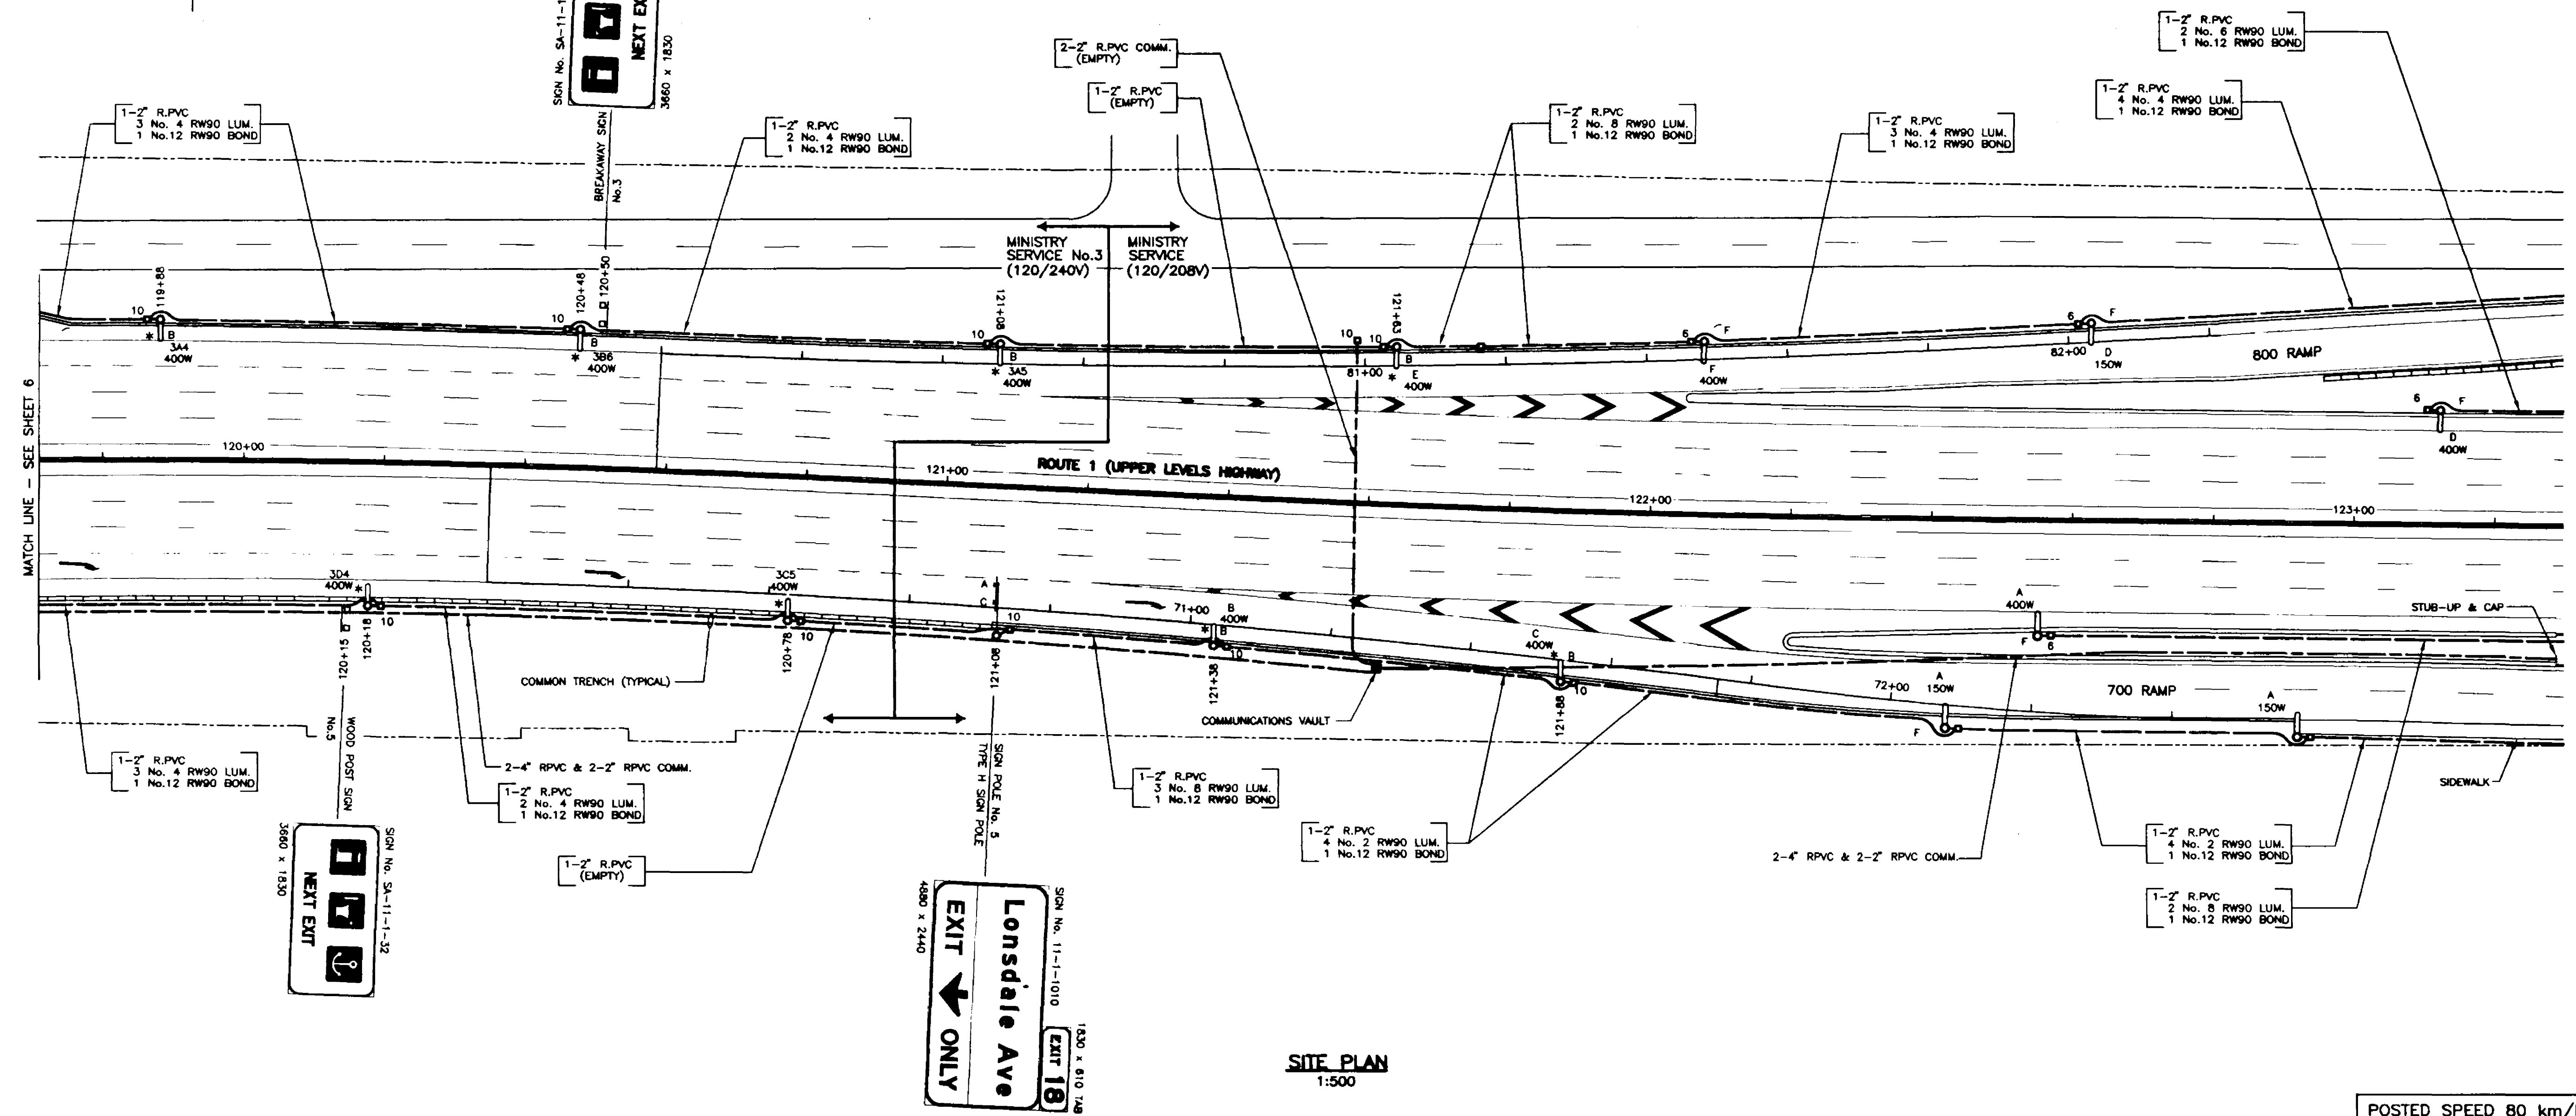

SITE PLAN
1:500

FOR MINISTRY USE ONLY
THIS DRAWING SUPERSEDES DRAWINGS
TE-89037-6 & 7 (FINAL STAGE ELECTRICAL)

FOR DETAILS OF CONDUITS, JUNCTION BOXES,
POLE BASES, ETC. CAST IN CONCRETE STRUCTURES
REFER TO PBK STRUCTURE DRAWINGS FOR DETAILS

POSTED SPEED 80 km/h

REFER TO SHEET 1 FOR NOTES

REFER TO SHEET 14 AND 15
FOR POLE ELEVATIONS

REFER TO SHEET 17 FOR
SIGN POLE ELEVATIONS

REFER TO SHEET 19 FOR
WOOD POST SIGN ELEVATIONS

LEGEND			
	PROPOSED CONCRETE BASE WITH PROPOSED LUMINAIRE POLE		EXISTING CONCRETE BASE WITH PROPOSED LUMINAIRE POLE
	CONCRETE BASE AND JUNCTION BOX		CITY OR DISTRICT OF NORTH VANCOUVER LUMINAIRE POLE
	JUNCTION BOX - NO. DENOTES TYPE		DAVIT MOUNTED ILLUMINATED SIGN POLE WITH AMBER FLASHERS
	LUMINAIRE POLE (SINGLE)		COMBINATION LUMINAIRE/DAVIT MOUNTED ILLUMINATED SIGN WITH AMBER FLASHERS
	LUMINAIRE POLE (DOUBLE)		DAVIT MOUNTED SIGN (NON-ILLUMINATED)
	POST TOP MOUNTED LUMINAIRE		DAVIT MOUNTED ILLUMINATED SIGN POLE
	TRAFFIC SIGNAL POLE WITH DAVIT AND SIDE OF POLE MOUNTED HEADS		COMBINATION LUMINAIRE/DAVIT MOUNTED NON-ILLUMINATED SIGN POLE
	COMBINATION LUMINAIRE/DAVIT MOUNTED TRAFFIC SIGNAL POLE		BREAKAWAY SIGN (NON-ILLUMINATED)
	POST TOP MOUNTED SIGNAL		ILLUMINATED BREAKAWAY SIGN
	PEC		RIGID P.V.C. CONDUIT
	RIGID P.V.C. CONDUIT		RIGID METALLIC CONDUIT
	FLEXIBLE METALLIC CONDUIT (LIQUID TIGHT)		OVERHEAD FLASHING BEACON
	POST MOUNTED FLASHER		BACKGUY
	POWER POLE		TELEPHONE POLE
	POWER/TELEPHONE POLE		TEST SWITCH
	BREAKER		NEUTRAL BAR
	VEHICLE DETECTOR LOOP		SIGNAL HEAD VEHICLE PHASE
	SIGNAL HEAD PEDESTRIAN PHASE		PEDESTRIAN PUSHBUTTON
	U/G UTILITY		GAS
	STORM DRAINS/SEWERS		WATER
	ELECTRIC		TELEPHONE
	SANITARY SEWER		
	RAISED CURB		PROPERTY LINE
	EDGE OF GRAVEL SHOULDER		EDGE OF PAVEMENT
	PAINT LINE		PROPOSED UNDERGROUND CONDUIT
	EXISTING UNDERGROUND CONDUIT		FENCE
	CORRUGATED METAL PIPE (CULVERT)		RETAINING WALL
	SOUND WALL		CONCRETE ROADSIDE OR MEDIAN BARRIER

WALTER & SCI Construction (Canada) Ltd.

SHAFLIK ENGINEERING LTD.
ELECTRICAL CONSULTANTS
202-8525 BAXTER PLACE, BURNABY, BC V5A 4V7 TEL: 804-421-4125 FAX: 804-421-8344

DATE	DESIGNED	D.S.M.	DATE	NOV 95
SCALE	AS NOTED	VOLTAGE	120/240	
HWY.	DISTRICT HOWE SOUND	CHECKED	D.J.W.	DATE 08-12-20
REV	DATE	DESCRIPTION	CONST	QA/QC
A	97-07-28	RECORD DRAWING	D.J.W.	A.J.
B	97-11-26	RECORD DRAWING REVISED		

REVISIONS	

Province of British Columbia
MINISTRY OF TRANSPORTATION AND HIGHWAYS
WESTVIEW INTERCHANGE DESIGN BUILD

SIGNALS, LIGHTING AND DIRECTIONAL SIGNING INSTALLATION
HOWE SOUND DISTRICT - HIGHWAY No.1
UPPER LEVELS HIGHWAY / WESTVIEW DRIVE INTERCHANGE
NORTH VANCOUVER

SITE PLAN

PREPARED UNDER THE DIRECTION OF	ACCEPTED FOR CONSTRUCTION
ORIGINAL SIGNED BY D. J. WONG CONSULTANT	ORIGINAL SIGNED BY A. JACK GC/BA MANAGER
DATE 96-02-14	DATE 96-02-16
PROJECT No. 06838	DRAWING No. 1
SHEET 7 OF 22	TE-95094-7

CANCEL PRINTS BEARING PREVIOUS LETTER