
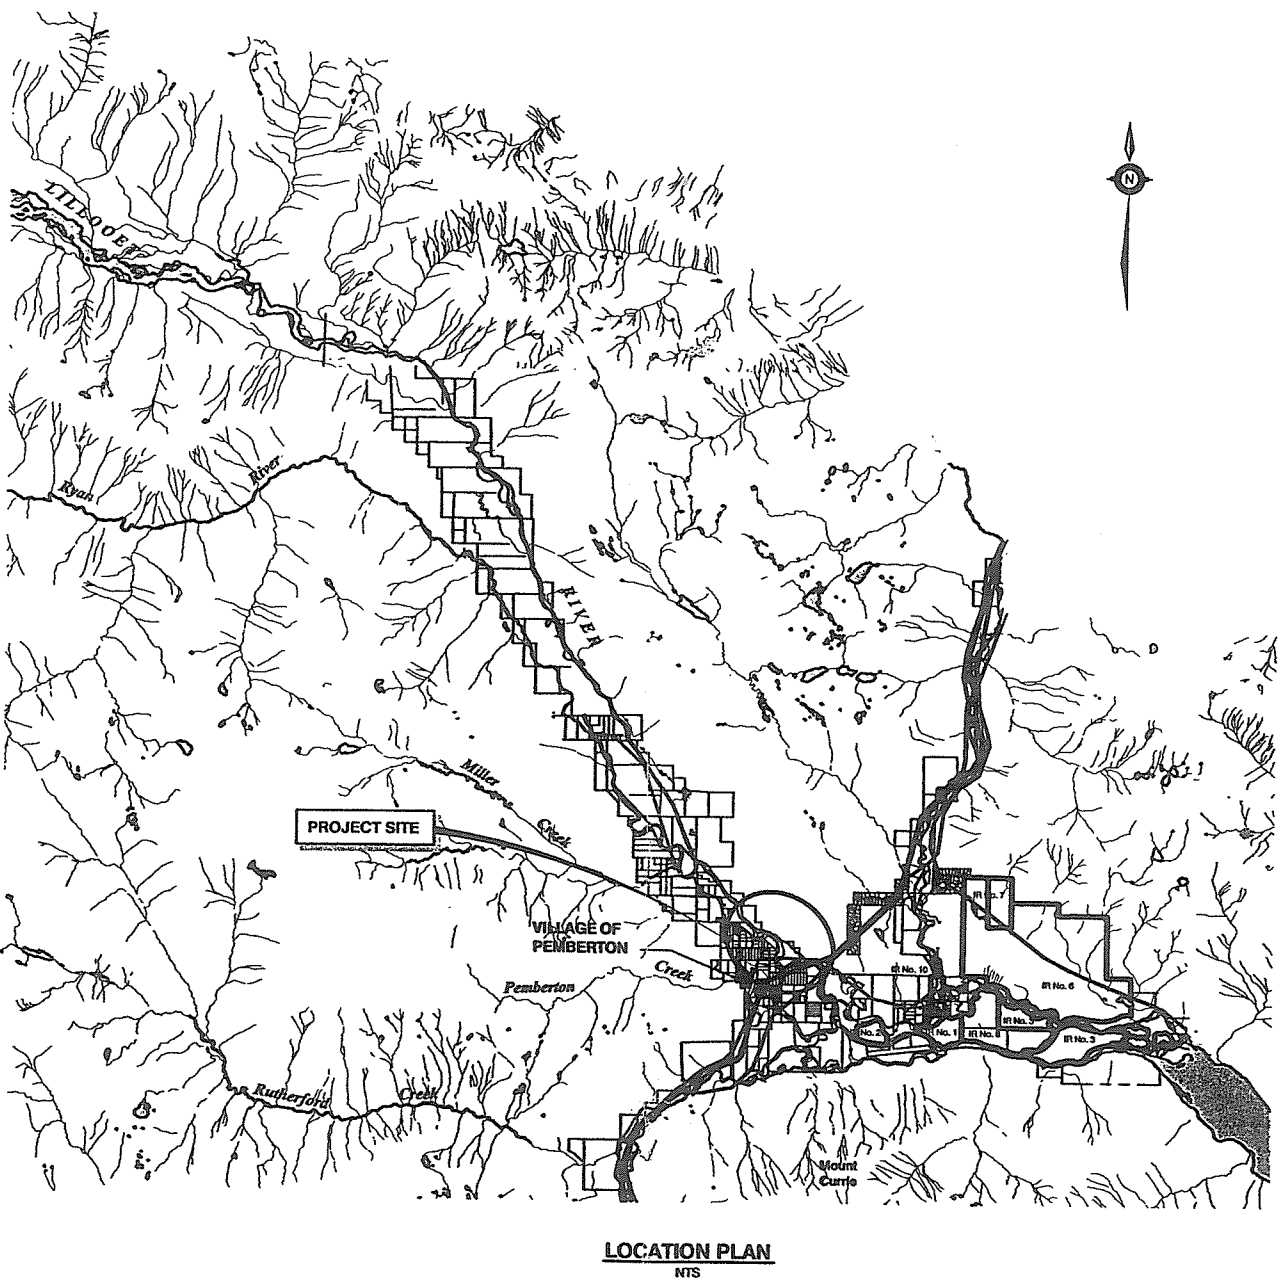


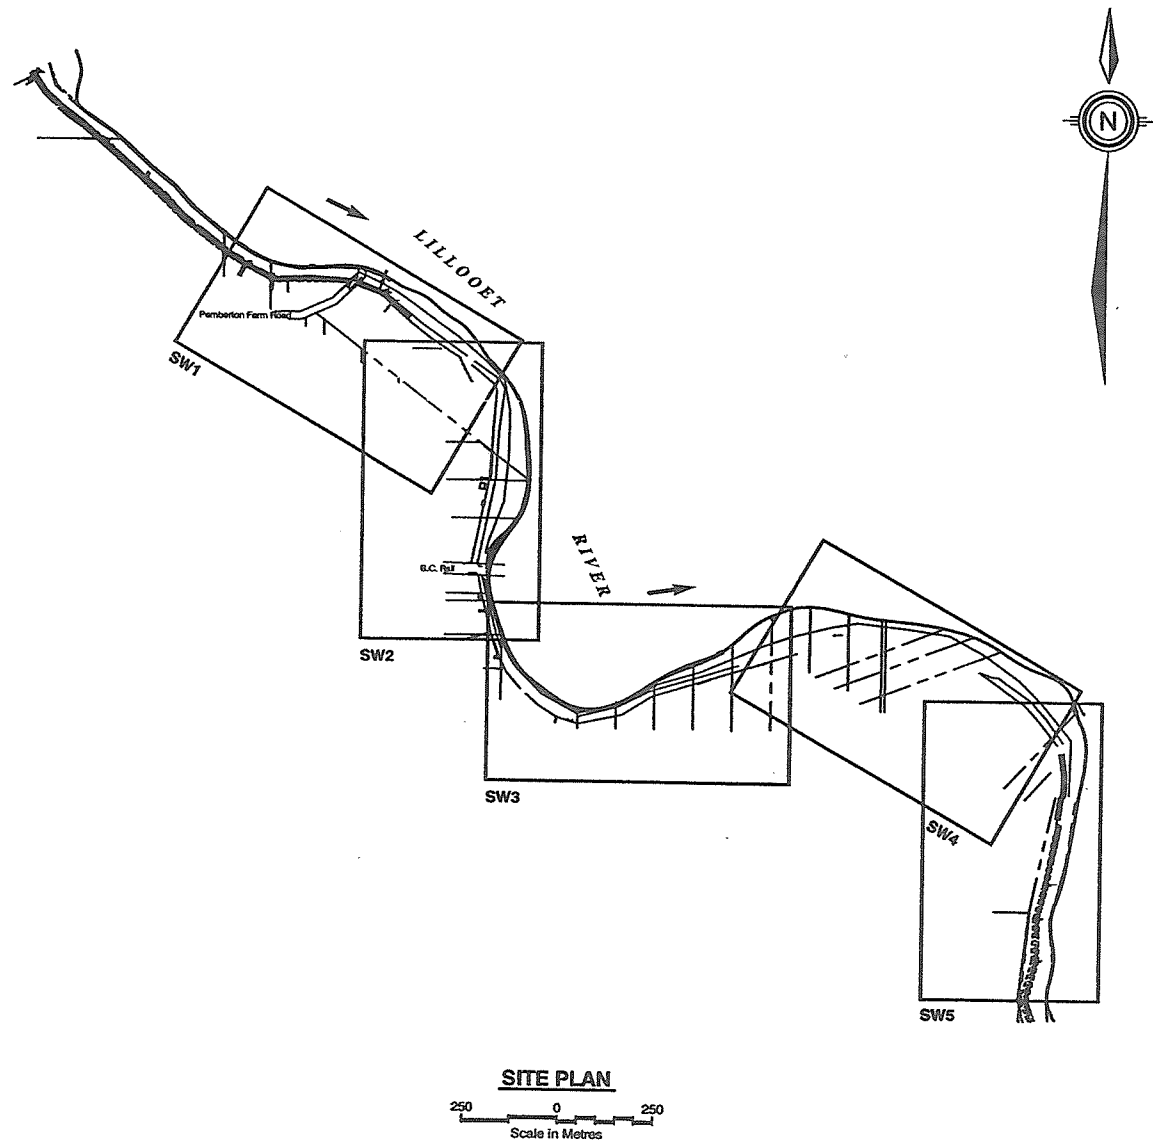

**PEMBERTON VALLEY DYKING DISTRICT
AREA 4 DYKE UPGRADING**


DRAWING LIST	
DRAWING No.	TITLE
G1	LOCATION PLAN, SITE PLAN AND DRAWING LIST
SW1	PLAN AND PROFILE 1
SW2	PLAN AND PROFILE 2
SW3	PLAN AND PROFILE 3
SW4	PLAN AND PROFILE 4
SW5	PLAN AND PROFILE 5
SW6	CROSS SECTIONS
SW7	CROSS SECTIONS

Issued for	Issue	Date	Issued By	Rev. No.	Date	Designed	Drawn	Checked	Description of Revision	Rev. No.	Date	Designed	Drawn	Checked	Description of Revision
Reference				0	Aug.19/02	JF	JL	JF							
Approvals	AD	Aug.19/02	JF												
Tender															
Permits															
Construction	CO	Aug.27/02	JF												
Record Drawings	RO	Feb.25/03													

kwl KERR WOOD LEIDAL
associates limited
CONSULTING ENGINEERS

**PEMBERTON VALLEY DYKING DISTRICT
AREA 4 DYKE UPGRADING
LOCATION PLAN, SITE PLAN, AND DRAWINGS LIST**

KWL Project No. 713-003 Scale AS SHOWN
Sheet 1 of 8 Rev. No. 0 Drawing Number
Client: Pemberton Valley Dyking District This Drawing Reduced by 50 % (x)

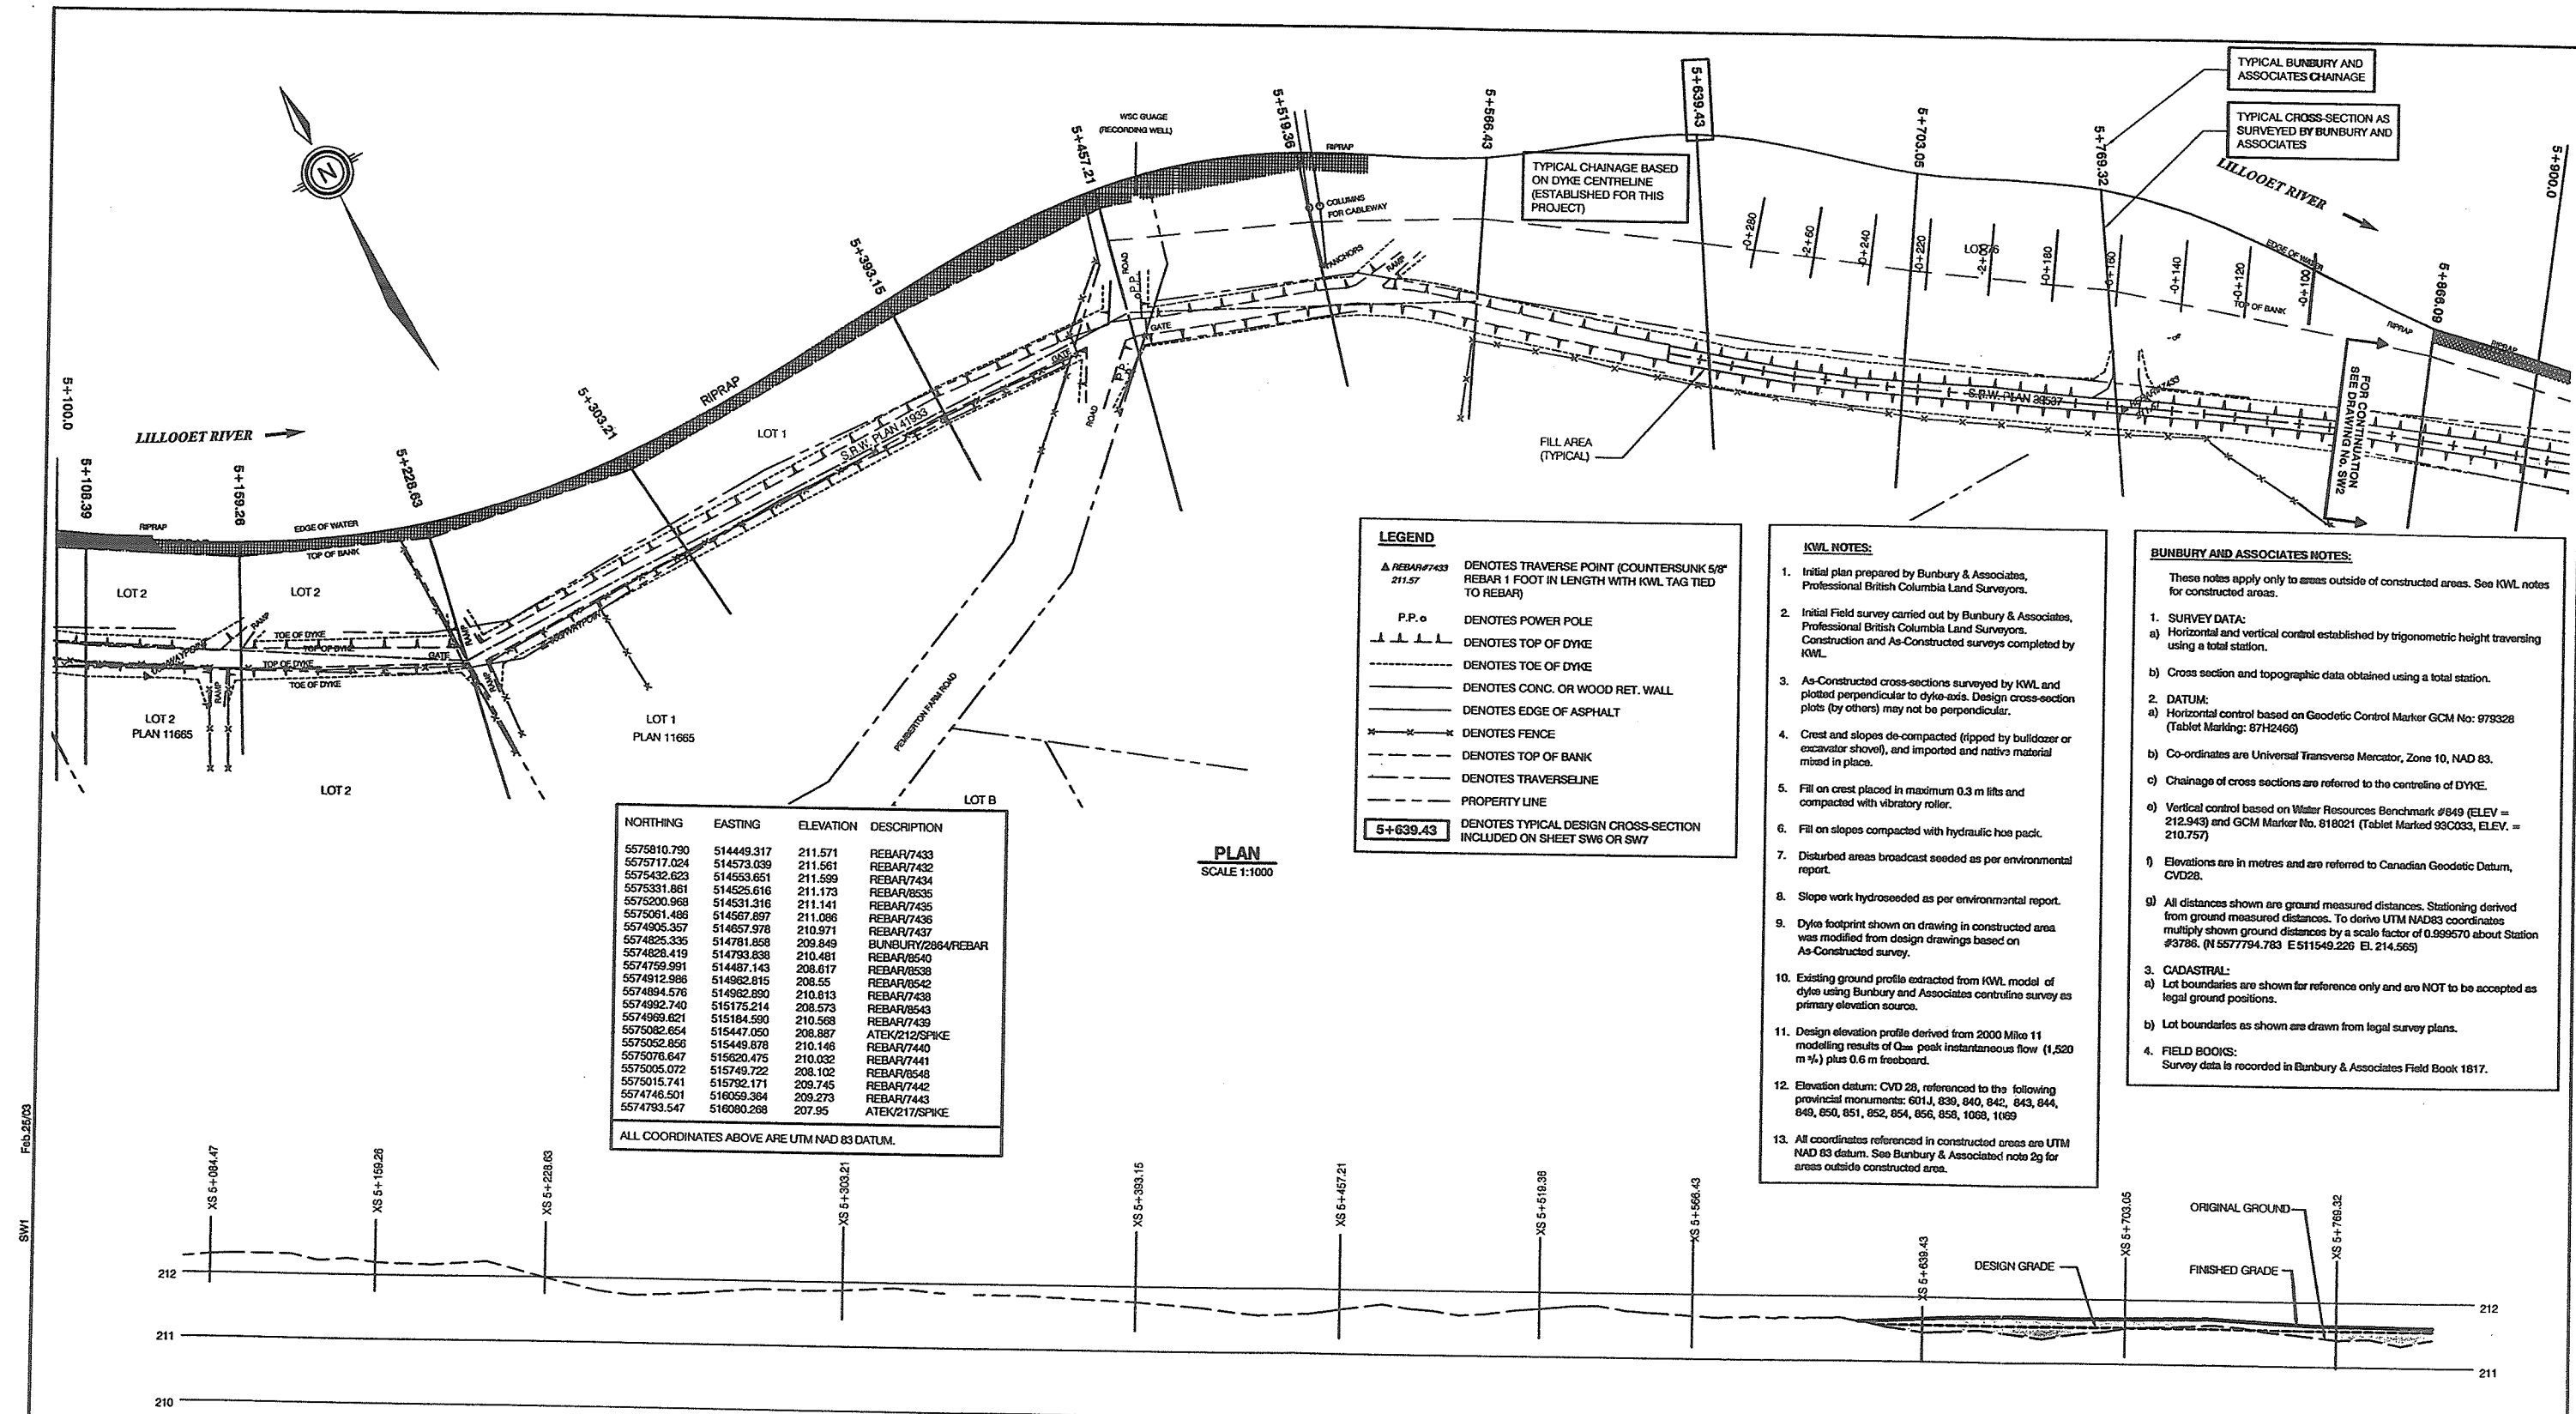

NORTHING	EASTING	ELEVATION	DESCRIPTION
5575810.790	514449.317	211.571	REBAR/7433
5575717.024	514573.039	211.561	REBAR/7432
5575432.623	514553.651	211.599	REBAR/7434
5575331.861	514525.616	211.173	REBAR/8335
5575200.968	514531.316	211.141	REBAR/7435
5575051.486	514567.897	211.086	REBAR/7436
5574905.357	514657.978	210.971	REBAR/7437
5574825.335	514781.858	209.849	BUNBURY/2864/REBAR
5574828.419	514783.838	210.481	REBAR/8540
5574759.991	514487.143	208.617	REBAR/8538
5574912.986	514962.815	208.55	REBAR/8542
5574894.576	514962.890	210.813	REBAR/7439
5574992.740	515175.214	208.573	REBAR/8543
5574969.621	515184.590	210.568	REBAR/7439
5575082.654	515447.050	208.887	ATEK/212/SPIKE
5575052.856	515449.878	210.146	REBAR/7440
5575076.647	515620.475	210.032	REBAR/7441
5575005.072	515749.722	208.102	REBAR/8548
5575015.741	515792.171	209.745	REBAR/7442
5574746.501	516059.384	209.273	REBAR/7443
5574783.547	516080.288	207.95	ATEK/217/SPIKE

ALL COORDINATES ABOVE ARE UTM NAD 83 DATUM.


713-003 Drawing No. 713-003 SW1-SW5-Red DWG
SW1
Feb. 25/03


Issued for	Issue	Date	Issued By	Rev. No.	Date	Designed	Drawn	Checked	Description of Revision	Rev. No.	Date	Designed	Drawn	Checked	Description of Revision
Reference	A0	Aug. 19/02	JF	0	Aug. 19/02	JF	JL	JF							
Approvals				0	Jan. 07/03	JF	JL								
Tender															
Permits															
Construction	CO	Aug. 27/02	JF												
Record Drawings	RO	Feb. 25/03													


kwl KERR WOOD LEIDAL
associates limited
CONSULTING ENGINEERS



**PEMBERTON VALLEY DYKING DISTRICT
AREA 4 DYKE UPGRADING
PLAN AND PROFILE 1**

KWL Project No. 713-003 Scale AS SHOWN
Sheet 2 of 8 Rev. No. 0
Client: Pemberton Valley Dyking District
This Drawing Reduced by 50 % (x)

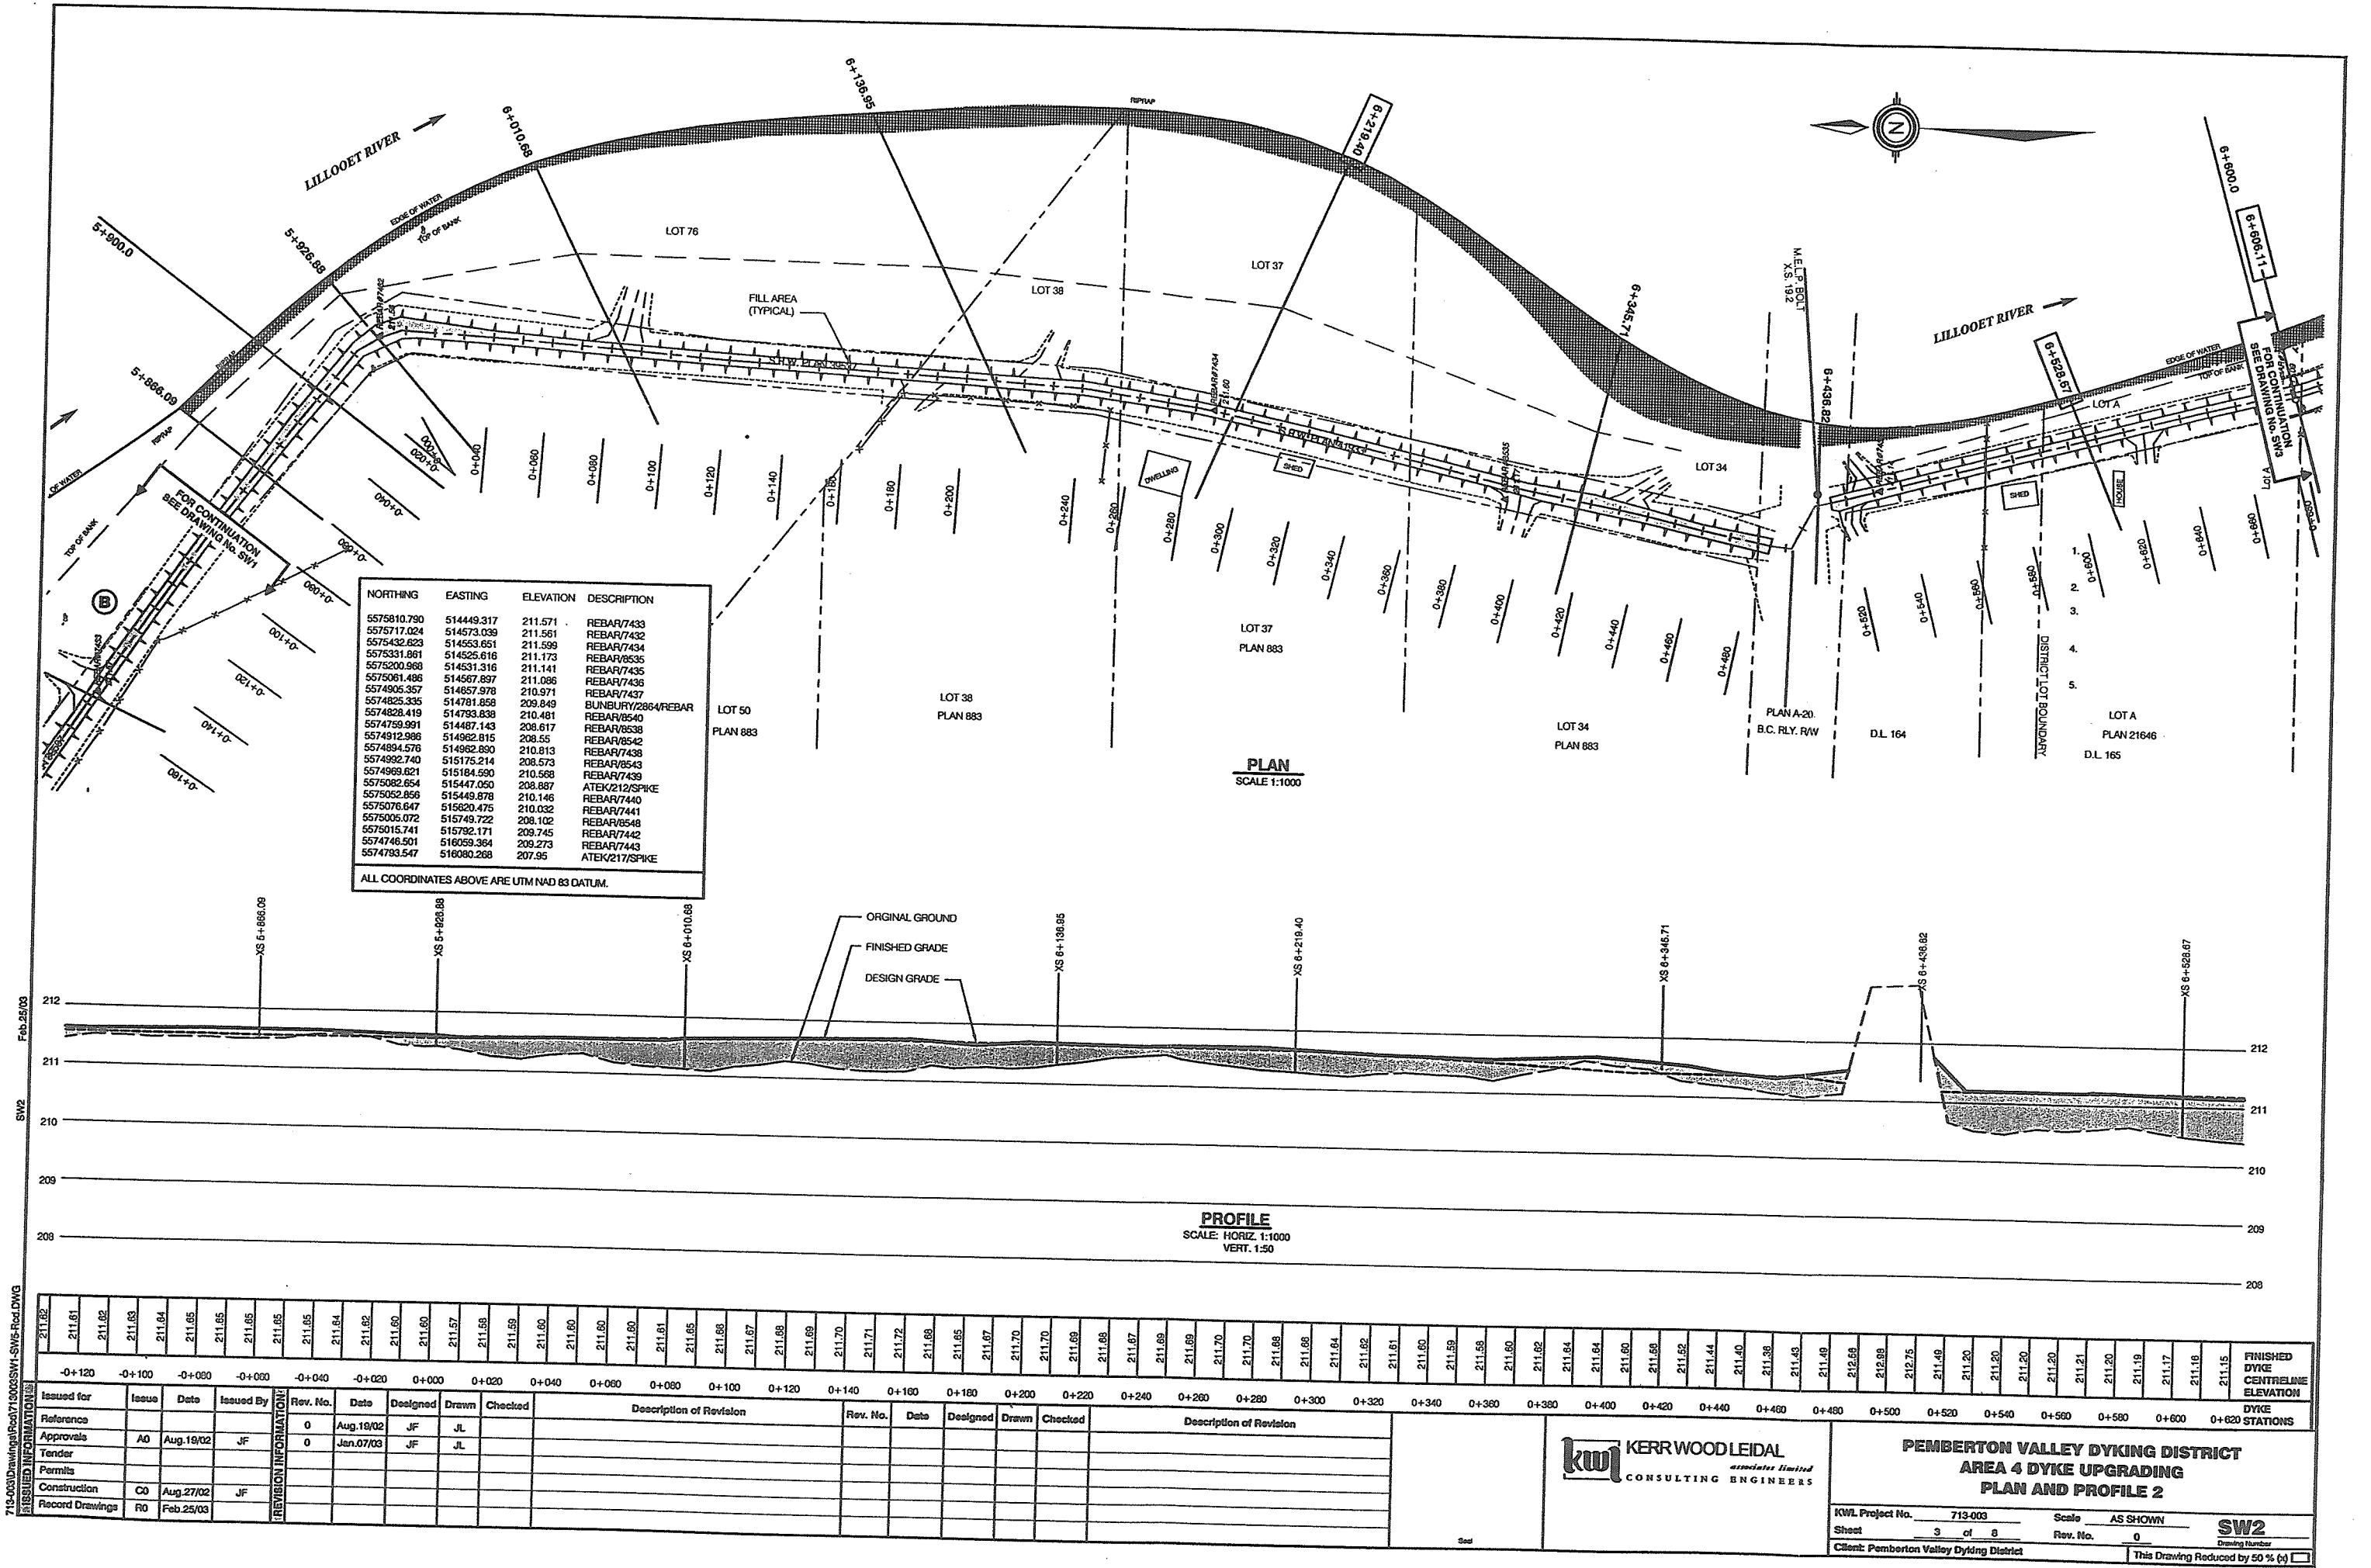

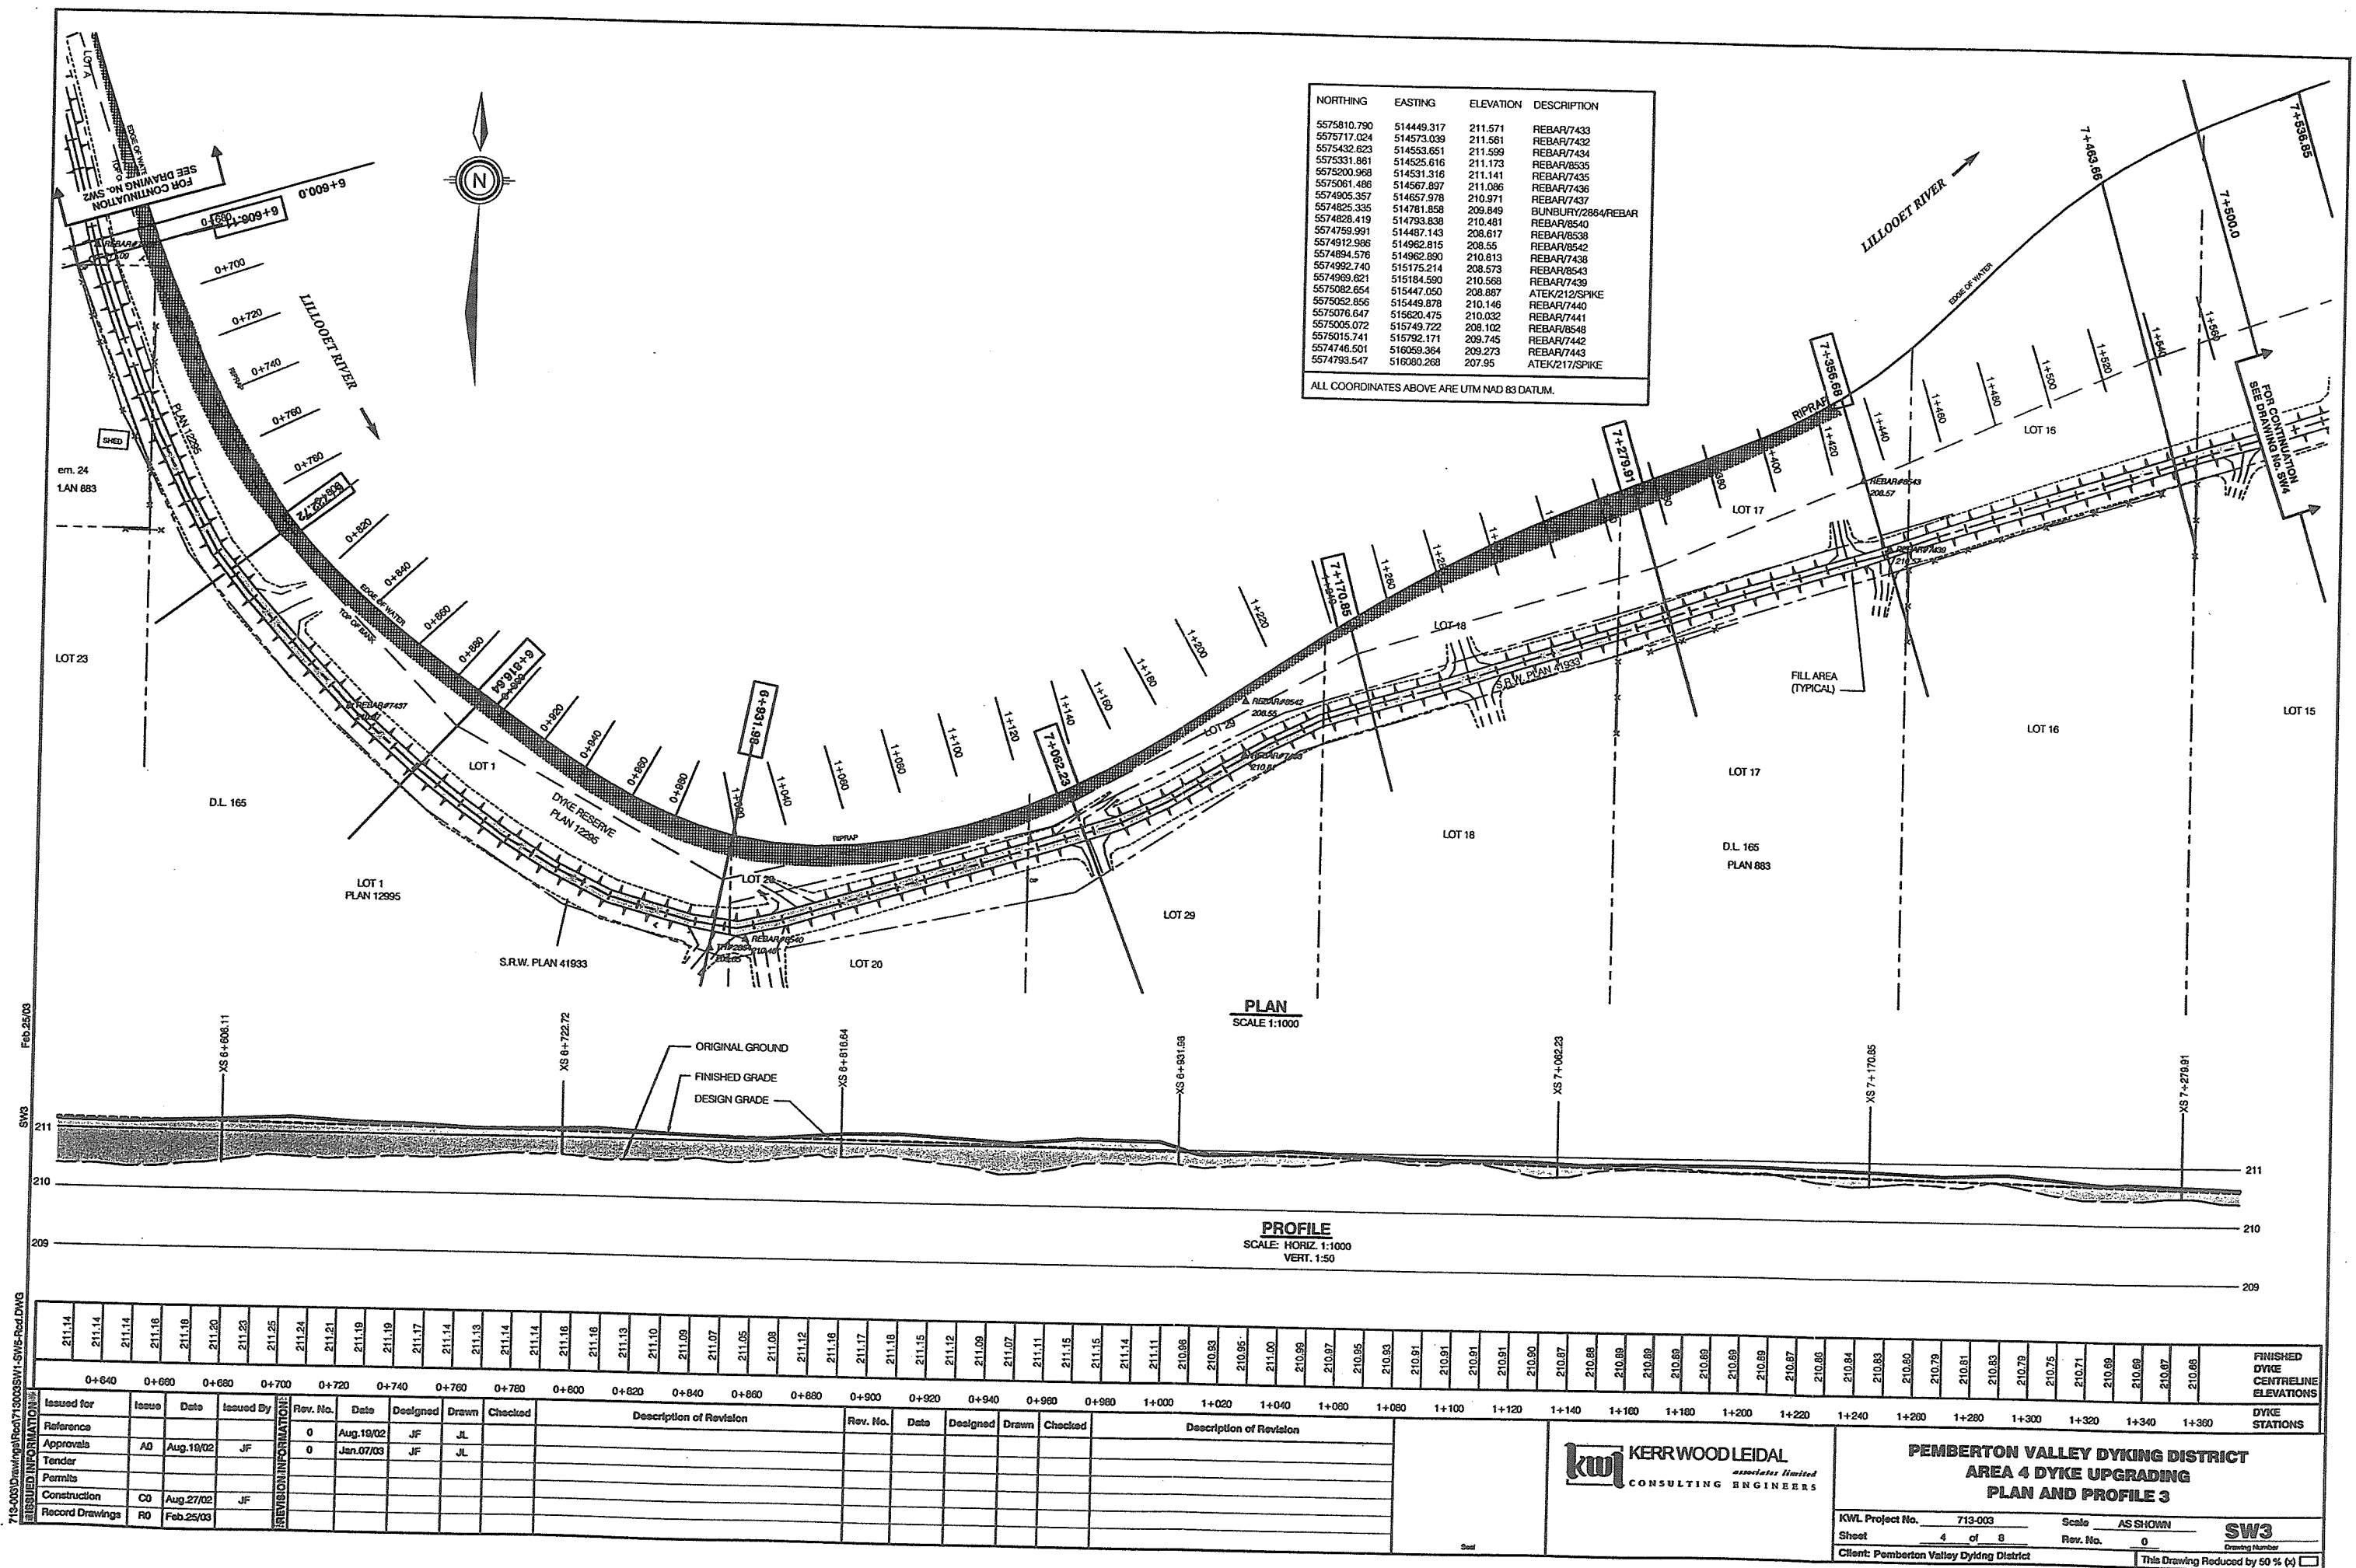

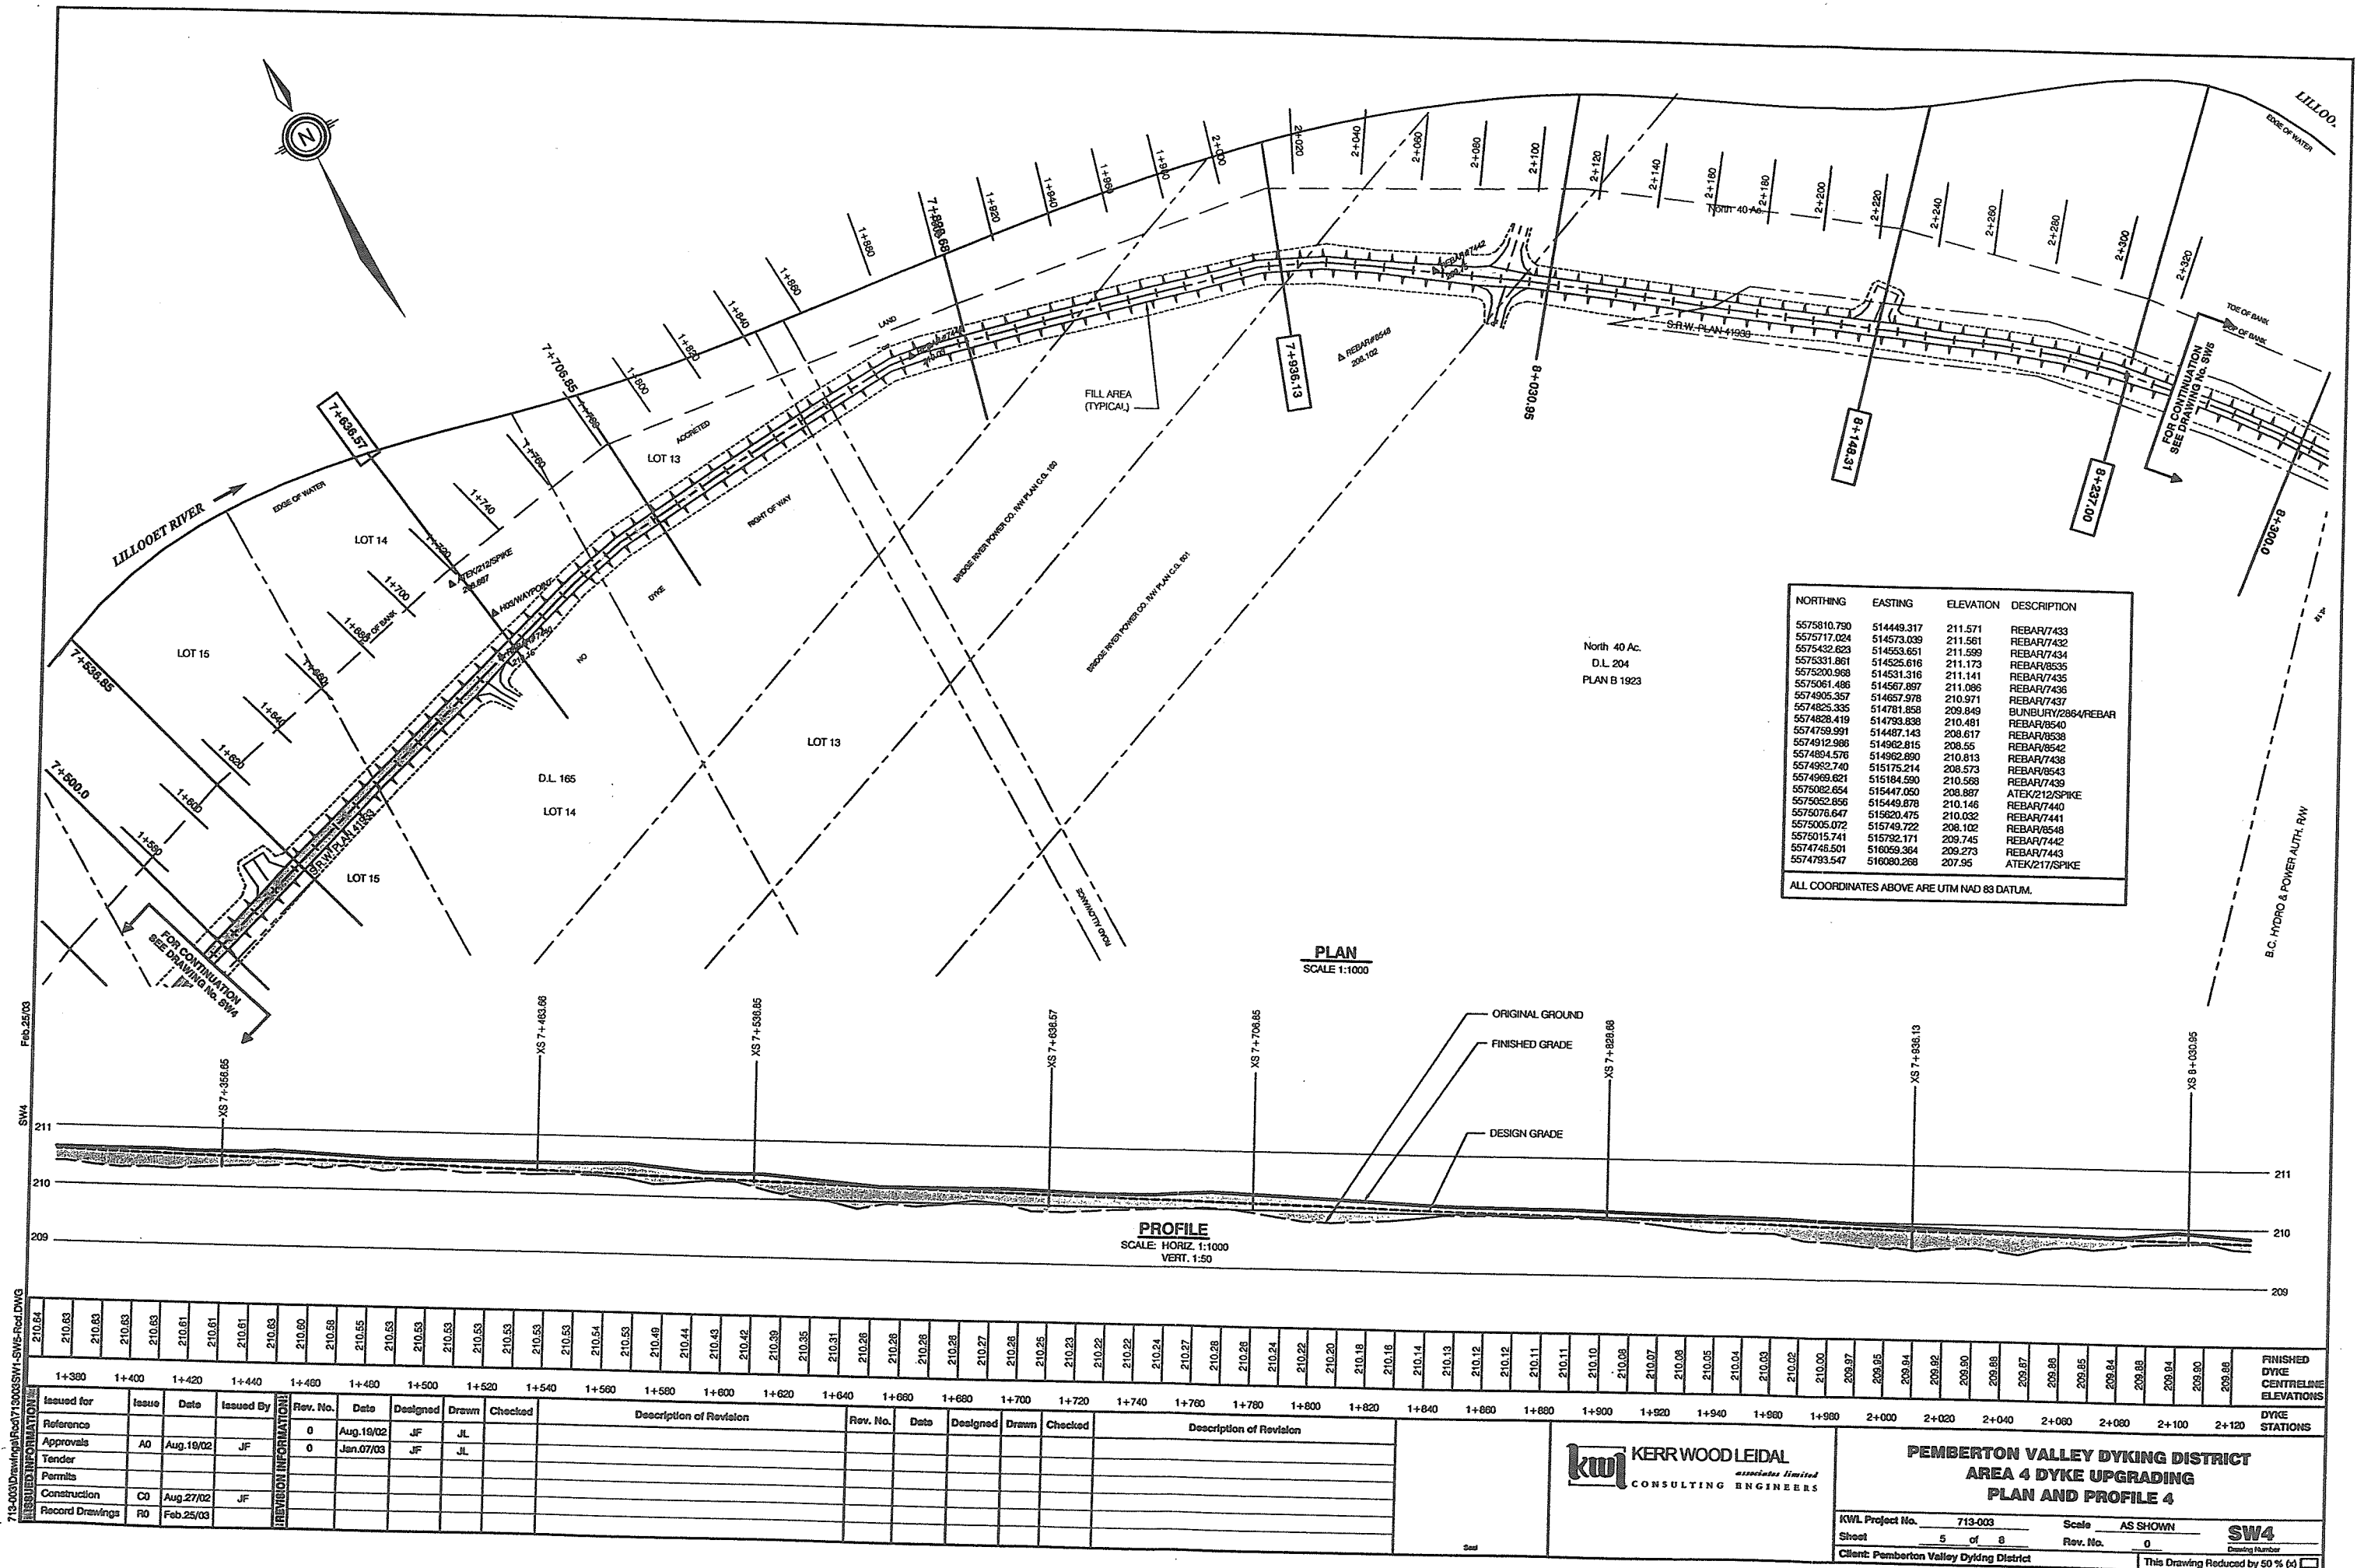

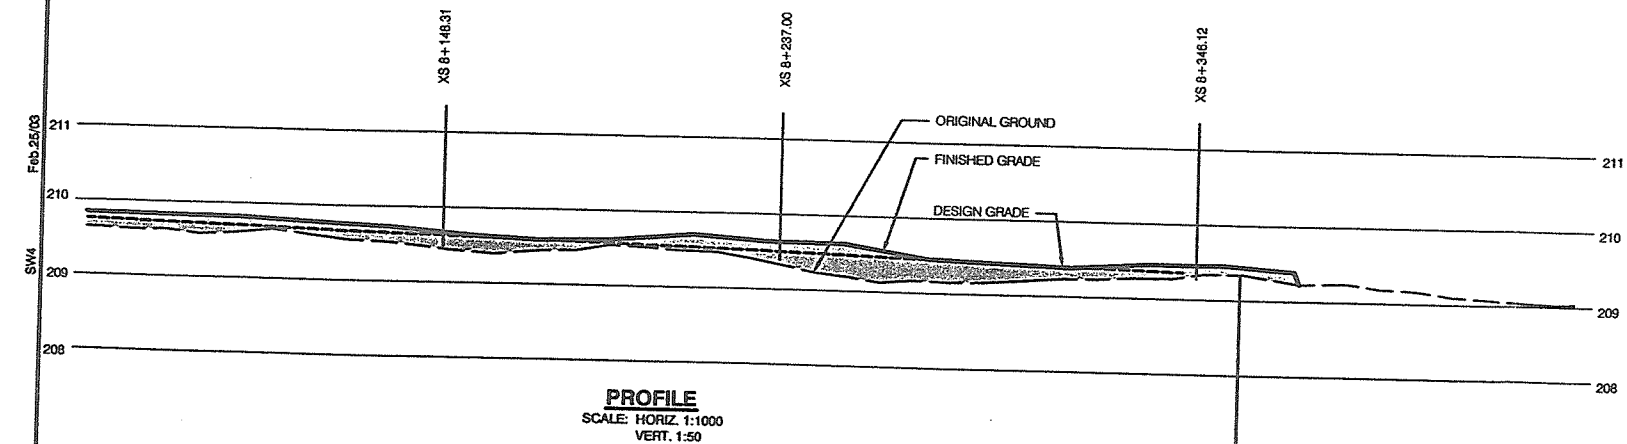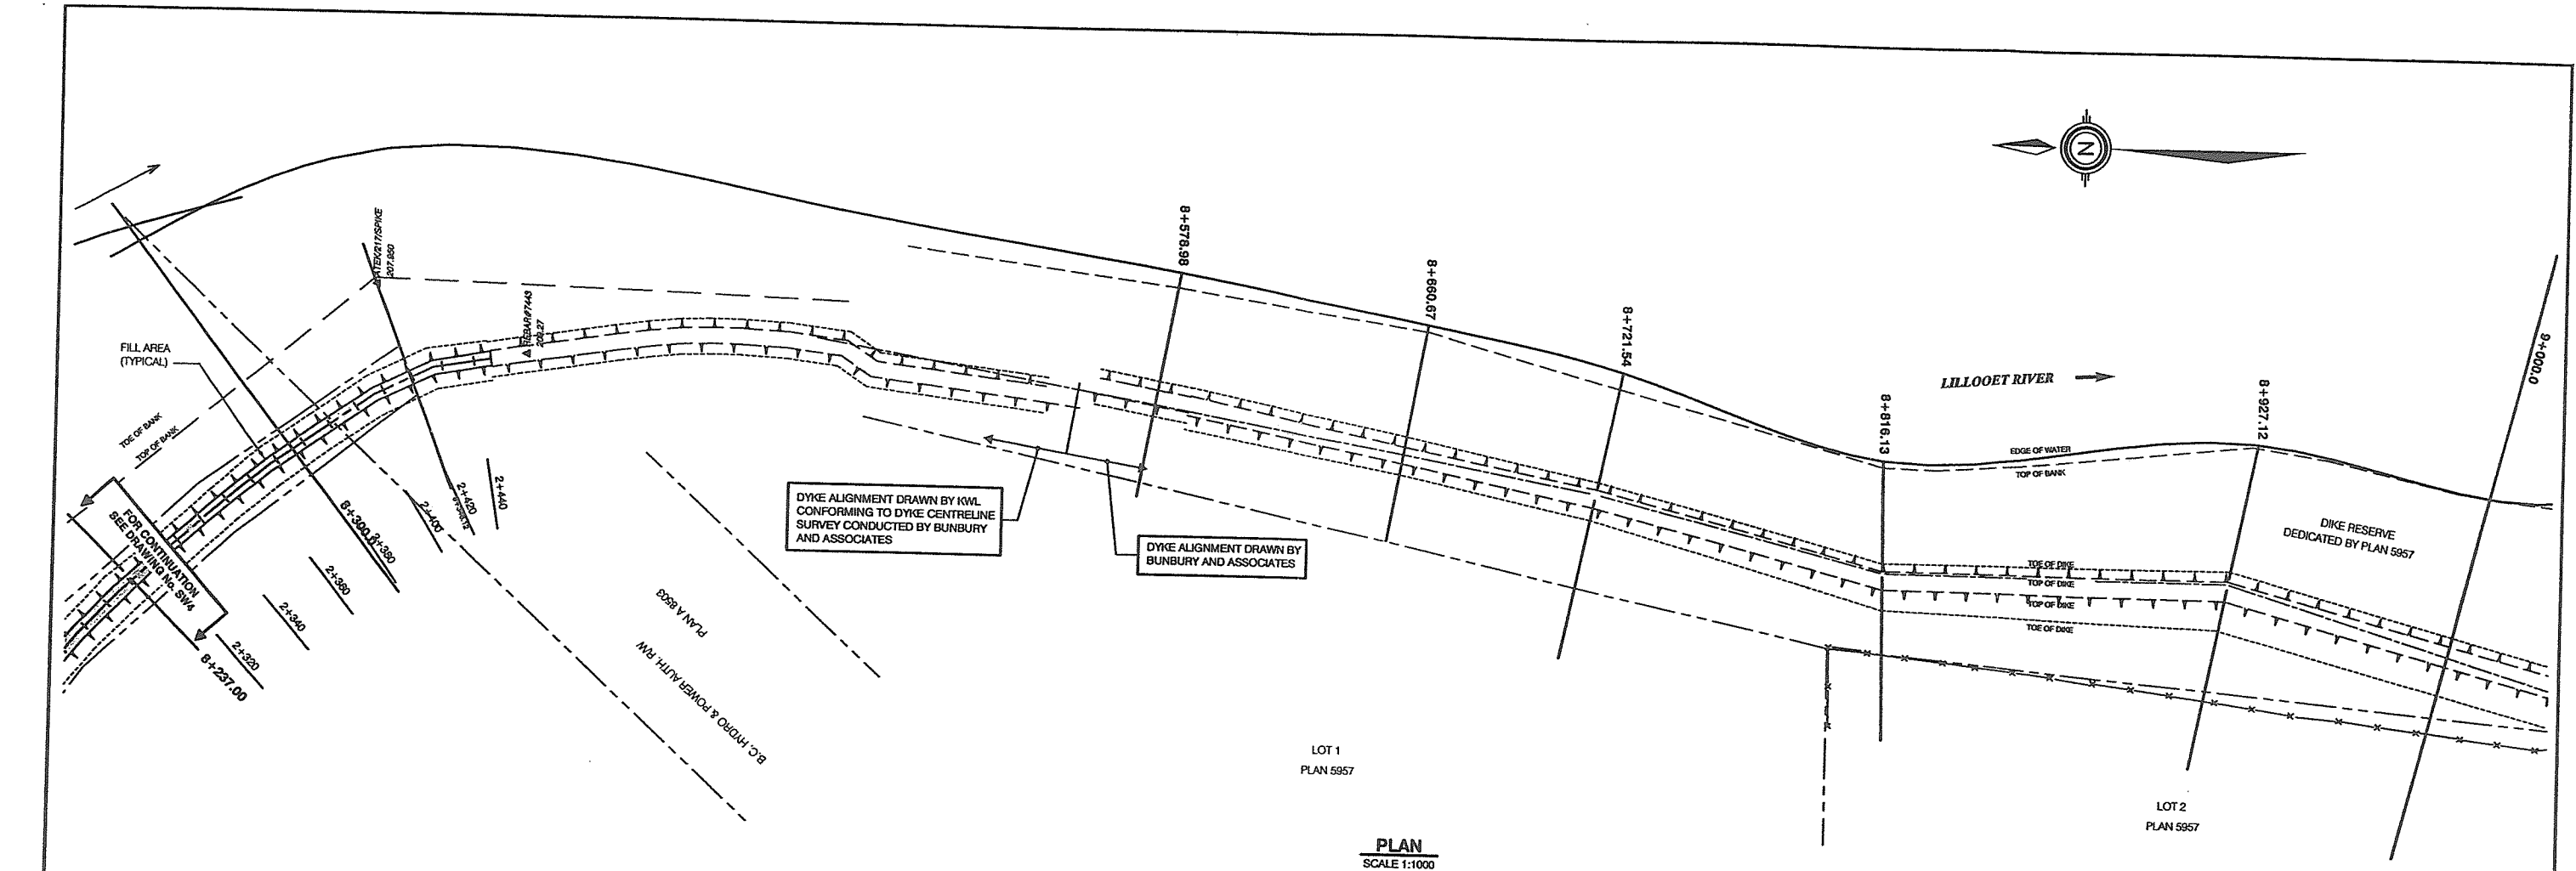

NORTHING	EASTING	ELEVATION	DESCRIPTION
5575810.790	514449.317	211.571	REBAR/7433
5575717.024	514573.039	211.561	REBAR/7432
5575432.623	514553.651	211.599	REBAR/7434
5575331.861	514525.616	211.173	REBAR/8535
5575200.988	514531.316	211.141	REBAR/7435
5575061.486	514557.897	211.086	REBAR/7436
5574905.357	514557.970	210.971	REBAR/7437
5574825.335	514781.859	209.849	BUNBURY/2884/REBAR
5574828.419	514793.838	210.481	REBAR/8540
5574759.991	514487.143	208.617	REBAR/8538
5574912.986	514962.815	208.55	REBAR/8542
5574894.576	514962.890	210.813	REBAR/7438
5574992.740	515175.214	208.573	REBAR/8543
5574989.621	515184.590	210.568	REBAR/7439
5575002.654	515447.050	208.887	ATEK/212/SPIKE
5575052.856	515449.878	210.146	REBAR/7440
5575076.647	515620.475	210.032	REBAR/7441
5575005.072	515749.722	208.102	REBAR/8548
5575015.741	515792.171	209.745	REBAR/7442
5574746.501	516059.364	209.273	REBAR/7443
5574793.547	516080.268	207.95	ATEK/217/SPIKE

ALL COORDINATES ABOVE ARE UTM NAD 83 DATUM.

713-003 Drawing Plan 5957 15068SW1-SW5-Red.DWG





209.83																	209.83																	209.82																	209.82																	209.81																	209.78																	209.77																	209.74																	209.72																	209.67																	209.63																	209.61																	209.59																	209.60																	209.63																	209.67																	209.69																	209.66																	209.63																	209.63																	209.60																	209.62																	209.45																	209.43																	209.41																	209.39																	209.39																	209.43																	209.45																	209.46																	209.45																	209.41																	209.39																	209.39																	FINISHED DYKE CENTRELINE ELEVATIONS																																																																																																																																																																																																																																																																																																																																																																																																																																																																																																																																																																																																																																																																																																																																																																																																																																																																																																																																																																																																																																																																																																																																																																																																																																																																																																																																																																																																																																																																																																																																																																																																																																																																																																																																																																																																																																																																																																																																																																																																																																																																																																																																																																																																																																																																																																																																																																																																																																																																																																																																																																																																																																																																																																																																																																																																																																																																																																																																																																																																																																																																																																																																																																																																																																																																																																																																																																																																																																																																																																																																																																																																																																																																																																																																																																																																																																																																																																																																																																																																																																																																																																																																																																																																																																																																																																																																																																																																																																																																																																																																																																																																																																																																																																																																																																																																																																																																																																																																																																																																																																																																																																																																																																																																																																																																																																																																																																																																																																																																																																																																																																																																																																																																																																																																																																																																																																																																																																																																																																																																																																																																																																																																																																																																																																																																																																																																																																																																																																																																																																																																																																																																																																																																																																																																																																																																																																																																																																																																																																																																																																																																																																																																																																																																																																																																																																																																																																																																																																																																																																																																																																																																																																																																																																																																																																																																																																																																																																																																																																																																																																																																																																																																																																																																																																																																																																																																						
2+140																	2+160																	2+180																	2+200																	2+220																	2+240																	2+260																	2+280																	2+300																	2+320																	2+340																	2+360																	2+380																	2+400																	2+420																	2+440																	DYKE STATIONS																																																																																																																																																																																																																																																																																																																																																																																																																																																																																																																																																																																																																																																																																																																																																																																																																																																																																																																																																																																																																																																																																																																																																																																																																																																																																																																																																																																																																																																																																																																																																																																																																																																																																																																																																																																																																																																																																																																																																																																																																																																																																																																																																																																																																																																																																																																																																																																																																																																																																																																																																																																																																																																																																																																																																																																																																																																																																																																																																																																																																																																																																																																																																																																																																																																																																																																																																																																																																																																																																																																																																																																																																																																																																																																																																																																																																																																																																																																																																																																																																																																																																																																																																																																																																																																																																																																																																																																																																																																																																																																																																																																																																																																																																																																																																																																																																																																																																																																																																																																																																																																																																																																																																																																																																																																																																																																																																																																																																																																																																																																																																																																																																																																																																																																																																																																																																																																																																																																																																																																																																																																																																																																																																																																																																																																																																																																																																																																																																																																																																																																																																																																																																																																																																																																																																																																																																																																																																																																																																																																																																																																																																																																																																																																																																																																																																																																																																																																																																																																																																																																																																																																																																																																																																																																																																																																																																																																																																																																																																																																																																																																																																																																																																																																																																																																																																																																																																																																																																																																																																																																																																																																																																																																								
Issued for																	Issue																	Date																	Issued By																	Rev. No.																	Date																	Designed																	Drawn																	Checked																	Description of Revision																	Rev. No.																	Date																	Designed																	Drawn																	Checked																																																																																																																																																																																																																																																																																																																																																																																																																																																																																																																																																																																																																																																																																																																																																																																																																																																																																																																																																																																																																																																																																																																																																																																																																																																																																																																																																																																																																																																																																																																																																																																																																																																																																																																																																																																																																																																																																																																																																																																																																																																																																																																																																																																																																																																																																																																																																																																																																																																																																																																																																																																																																																																																																																																																																																																																																																																																																																																																																																																																																																																																																																																																																																																																																																																																																																																																																																																																																																																																																																																																																																																																																																																																																																																																																																																																																																																																																																																																																																																																																																																																																																																																																																																																																																																																																																																																																																																																																																																																																																																																																																																																																																																																																																																																																																																																																																																																																																																																																																																																																																																																																																																																																																																																																																																																																																																																																																																																																																																																																																																																																																																																																																																																																																																																																																																																																																																																																																																																																																																																																																																																																																																																																																																																																																																																																																																																																																																																																																																																																																																																																																																																																																																																																																																																																																																																																																																																																																																																																																																																																																																																																																																																																																																																																																																																																																																																																																																																																																																																																																																																																																																																																																																																																																																																																																																																																																																																																																																																																																																																																																																																																																																																																																																																																																																																																																																																																																																																																																																																																																																																																																																																																																																																																										
Reference																																																																				0																	Aug.19/02																	JF																	JL																	JF																																																																																																																																																																																																																																																																																																																																																																																																																																																																																																																																																																																																																																																																																																																																																																																																																																																																																																																																																																																																																																																																																																																																																																																																																																																																																																																																																																																																																																																																																																																																																																																																																																																																																																																																																																																																																																																																																																																																																																																																																																																																																																																																																																																																																																																																																																																																																																																																																																																																																																																																																																																																																																																																																																																																																																																																																																																																																																																																																																																																																																																																																																																																																																																																																																																																																																																																																																																																																																																																																																																																																																																																																																																																																																																																																																																																																																																																																																																																																																																																																																																																																																																																																																																																																																																																																																																																																																																																																																																																																																																																																																																																																																																																																																																																																																																																																																																																																																																																																																																																																																																																																																																																																																																																																																																																																																																																																																																																																																																																																																																																																																																																																																																																																																																																																																																																																																																																																																																																																																																																																																																																																																																																																																																																																																																																																																																																																																																																																																																																																																																																																																																																																																																																																																																																																																																																																																																																																																																																																																																																																																																																																																																																																																																																																																																																																																																																																																																																																																																																																																																																																																																																																																																																																																																																																																																																																																																																																																																																																																																																																																																																																																																																																																																																																																																																																																																																																																																																																																																																																																																																																																																																																																																																																																																																																																																																

kwl KERR WOOD LEIDAL
associates limited
CONSULTING ENGINEERS

**PEMBERTON VALLEY DYKING DISTRICT
AREA 4 DYKE UPGRADING
PLAN AND PROFILE 5**





KWL Project No.	713-003	Scale	AS SHOWN	SW5
Sheet	6 of 8	Rev. No.	0	Drawing Number
Client: Pemberton Valley Dyking District				This Drawing Reduced by 50 % (4)

713-003 Drawing Red 713003SW6-SW7-Red.DWG
SW6
Feb. 25/03

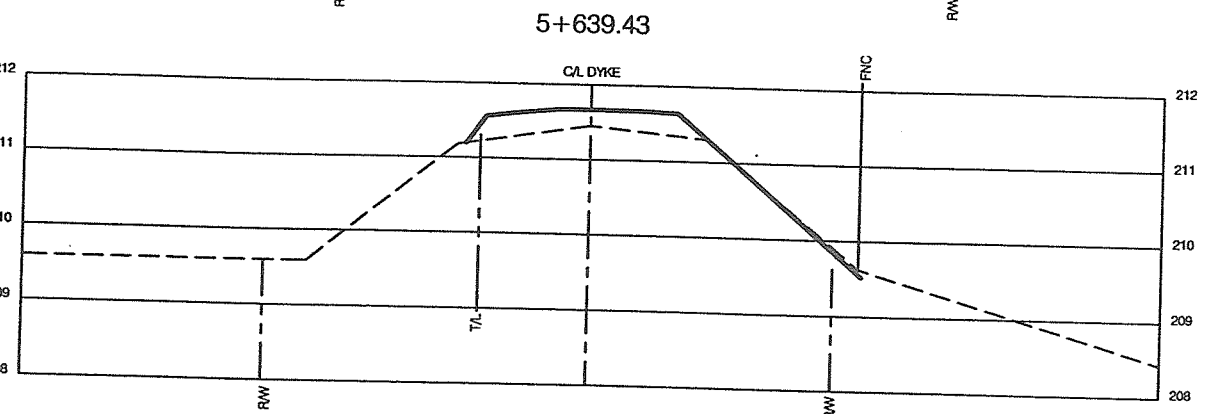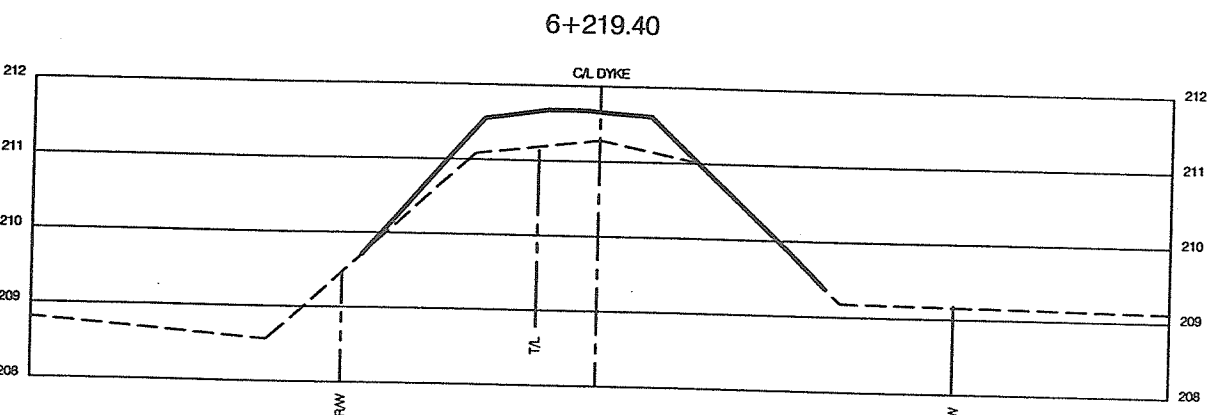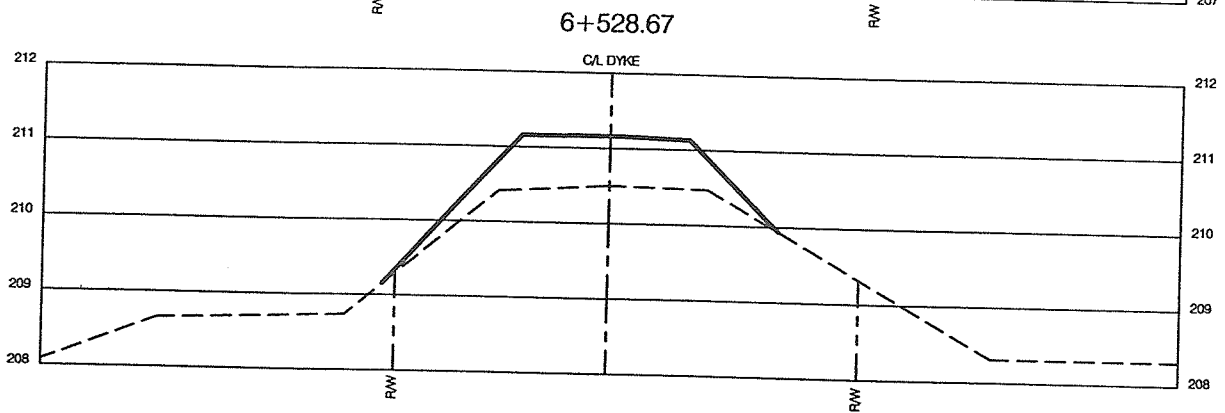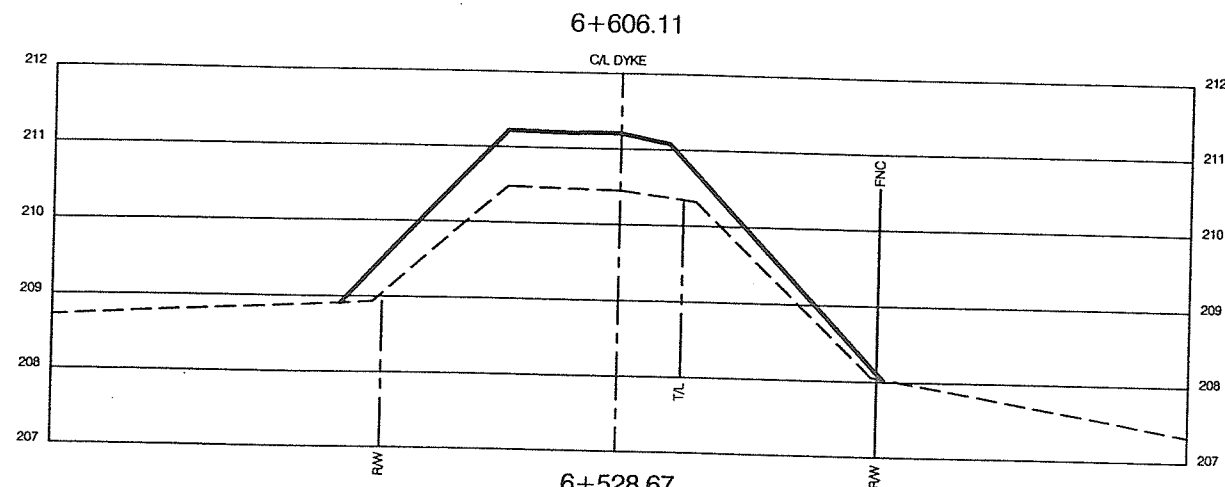

LEGEND
R/R DENOTES RIPRAP
C/L DENOTES CENTRELINE
W/L DENOTES WATERLINE
T/L DENOTES TRAVERSE LINE
P/L DENOTES PROPERTY LINE
R/W DENOTES DYKE RIGHT OF WAY
FNC DENOTES FENCE

SECTIONS LOOKING DOWNSTREAM
ELEVATIONS ARE IN METRES - GEODETIC DATUM

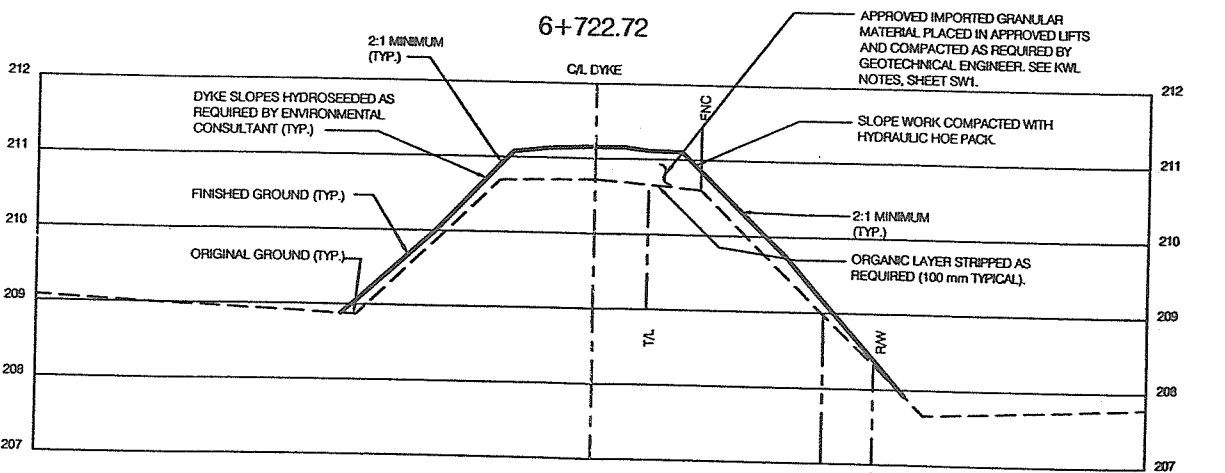
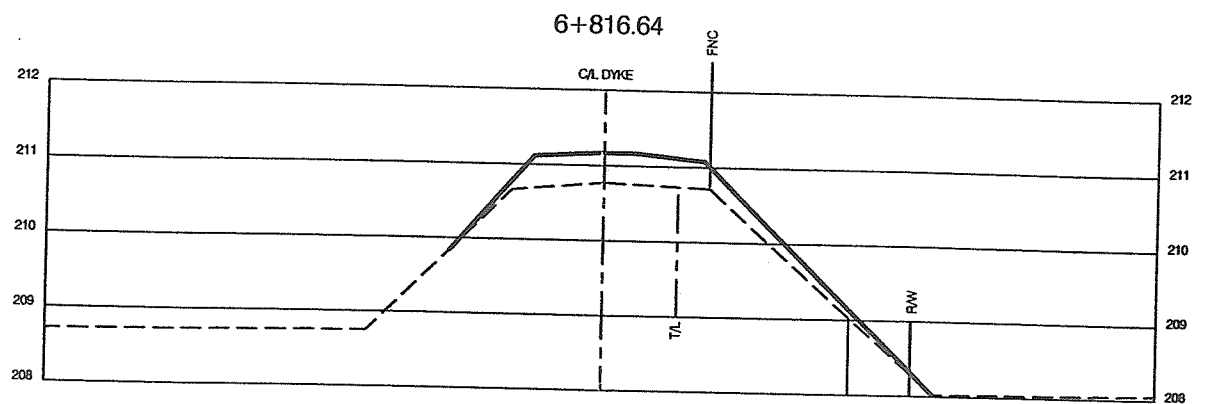
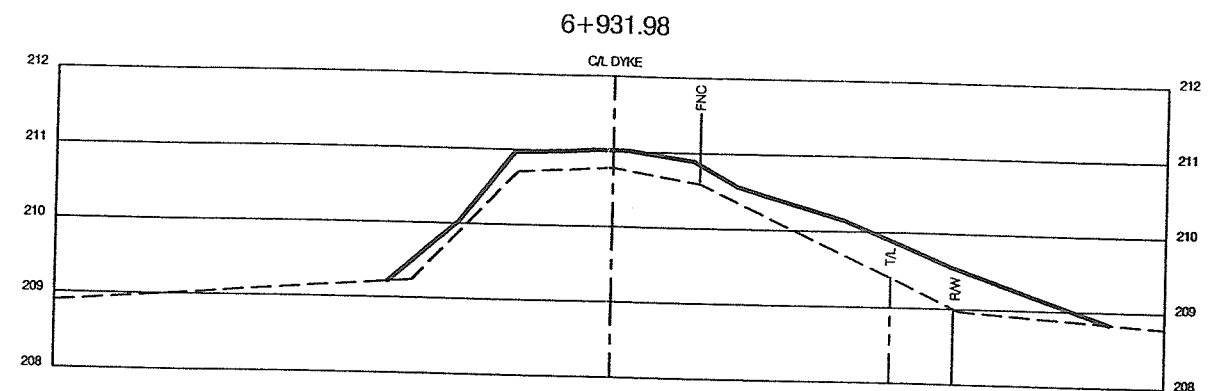
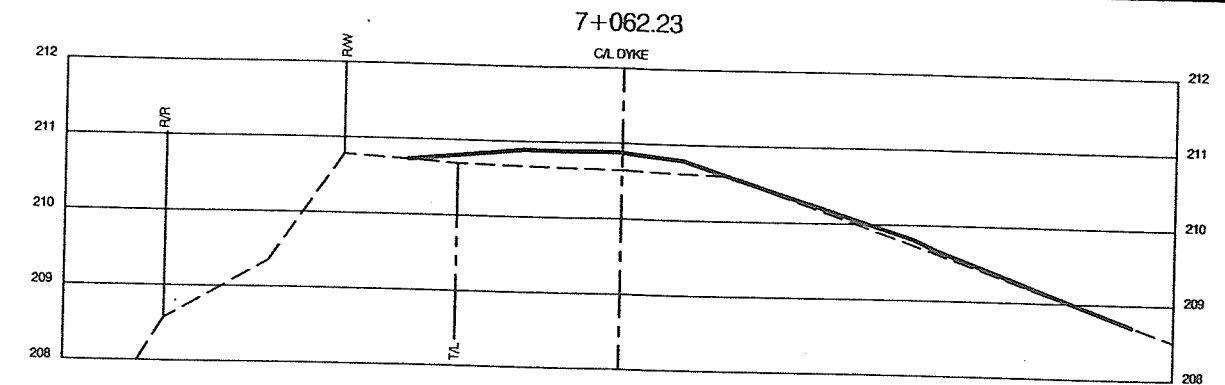


Issued for	Issue	Date	Issued By	Rev. No.	Date	Designed	Drawn	Checked	Description of Revision	Rev. No.	Date	Designed	Drawn	Checked	Description of Revision
Reference	A0	Aug.19/02	JF	0	Aug.19/02	JF	JL	JF							
Approvals															
Tender															
Permits															
Construction	C0	Aug.27/02	JF												
Record Drawings	R0	Feb.25/03													

kwl KERR WOOD LEIDAL
CONSULTING ENGINEERS




**PEMBERTON VALLEY DYKING DISTRICT
AREA 4 DYKE UPGRADING
CROSS SECTIONS**

KWL Project No. 713-003 Scale H. 1:100 V. 1:50
Sheet 7 of 8 Rev. No. 0
Client: Pemberton Valley Dyking District
SW6
This Drawing Reduced by 50 % (4)

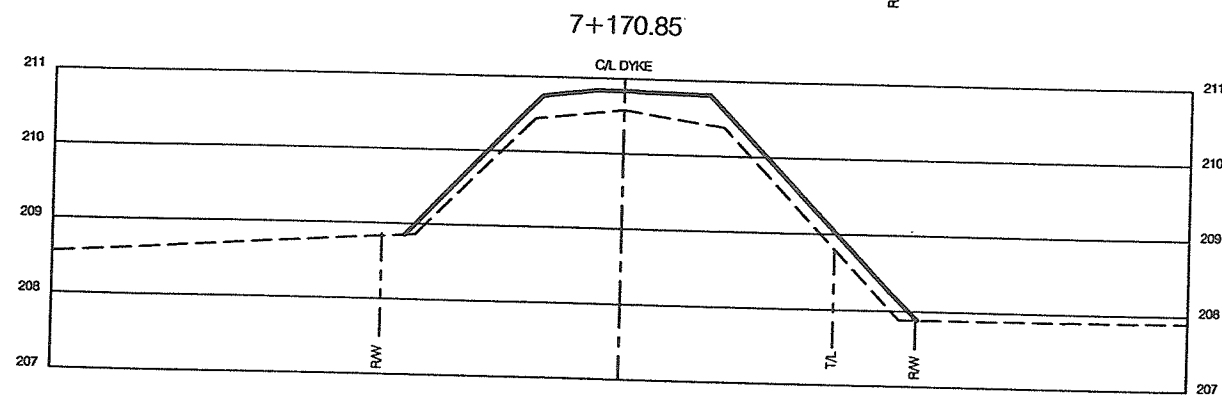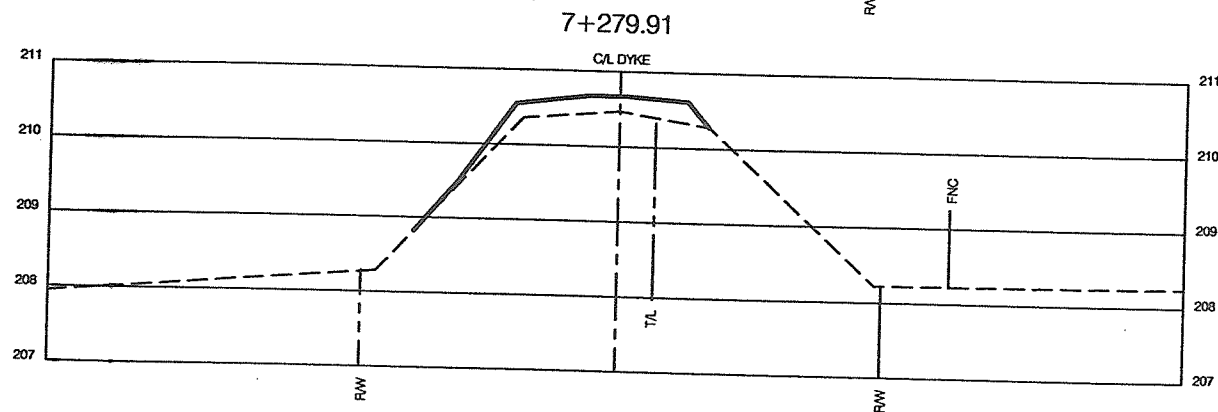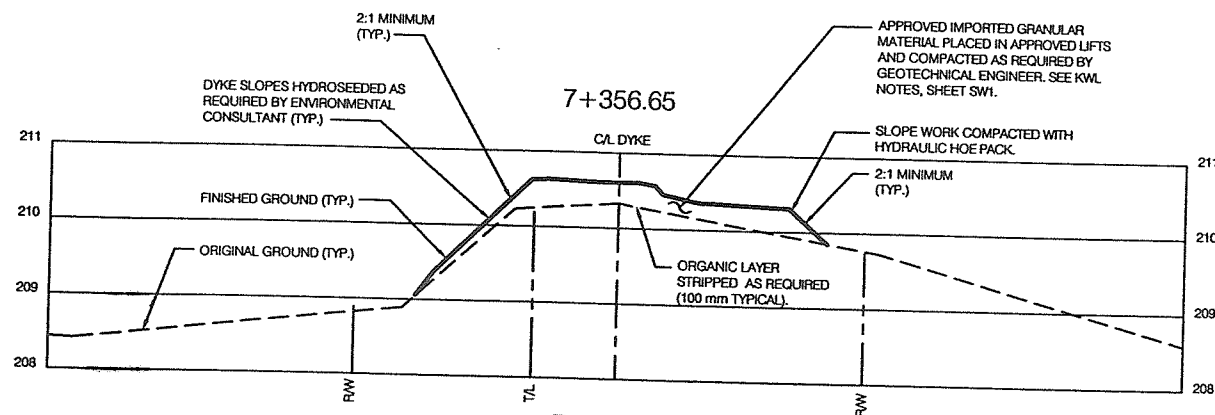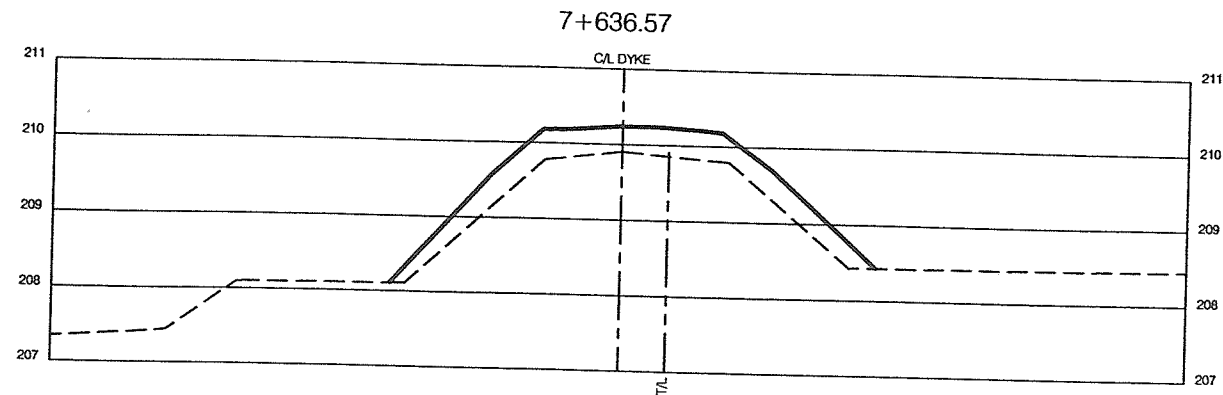

LEGEND	
R/R	DENOTES RIPRAP
C/L	DENOTES CENTRELINE
W/L	DENOTES WATERLINE
T/L	DENOTES TRAVERSE LINE
P/L	DENOTES PROPERTY LINE
R/W	DENOTES DYKE RIGHT OF WAY
FNC	DENOTES FENCE

SECTIONS LOOKING DOWNSTREAM
ELEVATIONS ARE IN METRES - GEODETIC DATUM

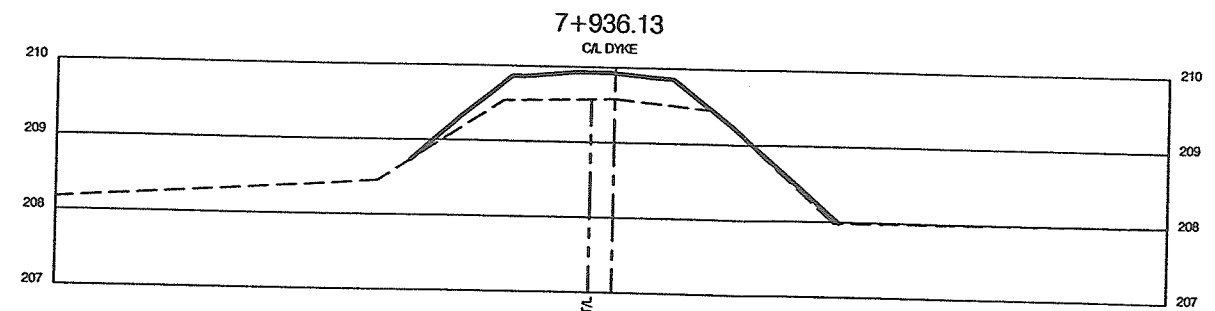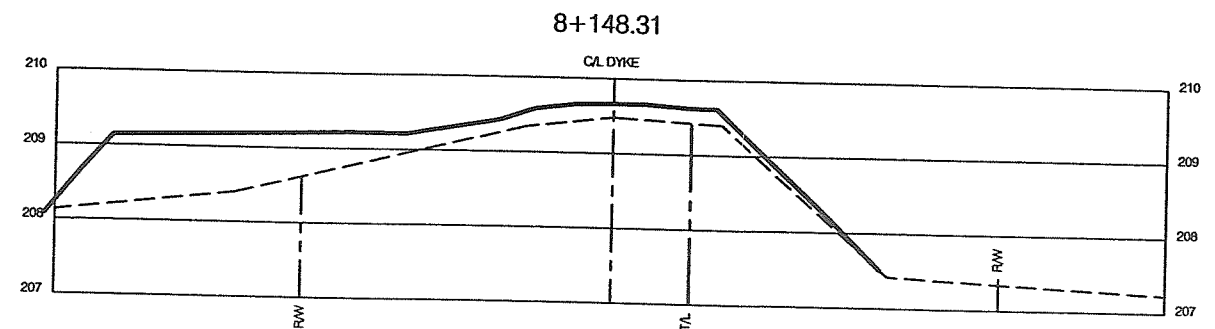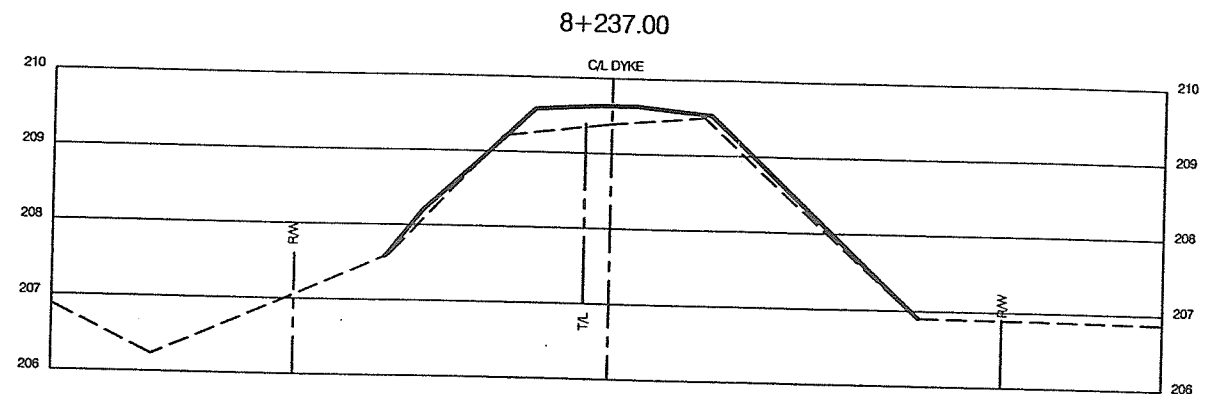

713-003 Drawings/Rev 713003SW6-SW7-Rod.DWG
SW7
Feb 25/03

Issued for	Issue	Date	Issued By	Rev. No.	Date	Designed	Drawn	Checked	Description of Revision	Rev. No.	Date	Designed	Drawn	Checked	Description of Revision
Reference				0	Aug.19/02	JF	JL	JF							
Approvals	A0	Aug.19/02	JF												
Tender															
Permits															
Construction	C0	Aug.27/02	JF												
Record Drawings	R0	Feb.25/03													

kwl KERR WOOD LEIDAL
associates limited
CONSULTING ENGINEERS

**PEMBERTON VALLEY DYKING DISTRICT
AREA 4 DYKE UPGRADING
CROSS SECTIONS**

KWL Project No. 713-003 Scale H. 1:100 V. 1:50
Sheet 8 of 8 Rev. No. 0
Client: Pemberton Valley Dyking District

SW7
Drawing Number

This Drawing Reduced by 50 % (4)