
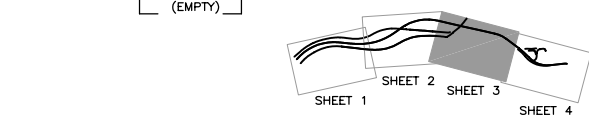


ITEM	CONDUCTOR COLOUR
LUMINAIRE CCT. A	RED
LUMINAIRE CCT. B	BLACK
LUMINAIRE CCT. C	BLUE
NEUTRAL	WHITE
GROUND/BOND	GREEN

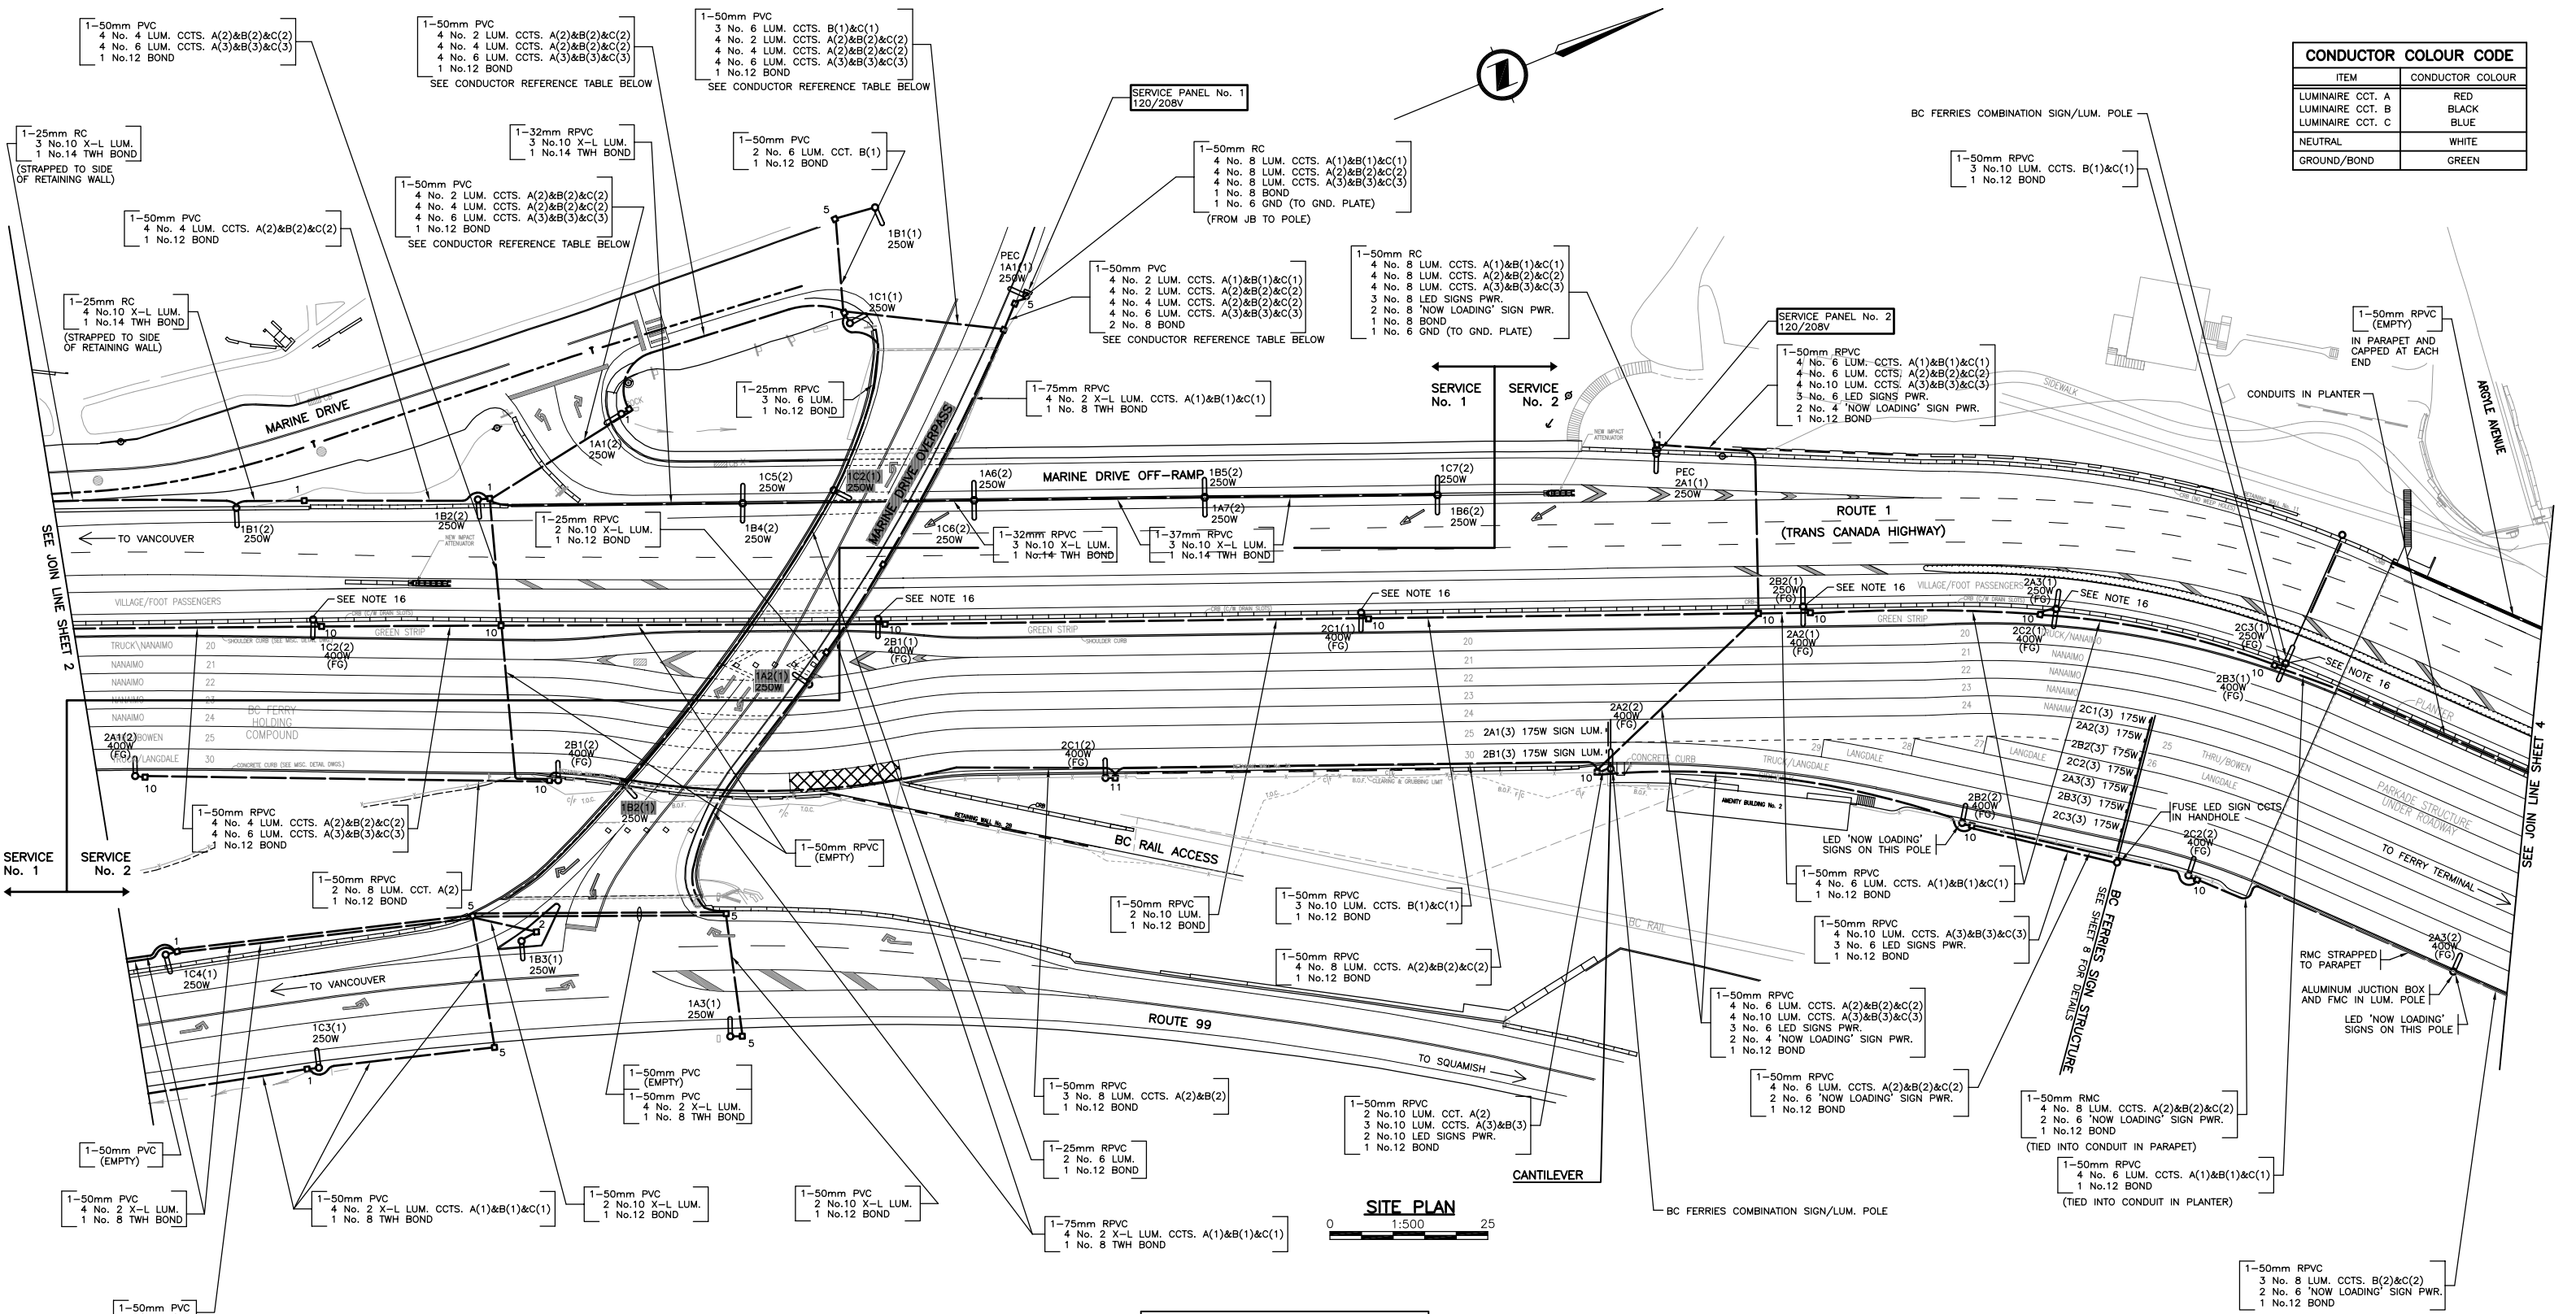

CONDUCTORS	LUMINAIRES
4 No. 2 LUM. CCTS. A(2)&B(2)&C(2)	1B2(2), 1B1(2), 1C1(2), 1A3(2), 1A4(2) & 1C4(2)
4 No. 4 LUM. CCTS. A(2)&B(2)&C(2)	1A1(2), 1B4(2), 1C5(2), 1A6(2), 1C6(2), 1B5(2), 1A7(2), 1C7(2), 1B6(2), 1C2(2), 1A2(2), 1C3(2), 1A5(2) & 1B3(2)

ROUTE 1 SOUTH BOUND 90 km/h  
ROUTE 1 NORTH BOUND 50 km/h

REFER TO SHEET 2 FOR NOTES

**FOR MINISTRY USE ONLY**  
THIS DRAWING SERIES SUPERSEDES  
DRAWING SERIES TE-00085

DO NOT USE THIS DRAWING FOR  
PAVEMENT MARKING STANDARDS

ALL DIMENSIONS ARE IN MILLIMETERS  
EXCEPT WHERE NOTED

SEE "STANDARD SPECIFICATIONS FOR HIGHWAY CONSTRUCTION"  
FOR APPLICABLE STANDARD DRAWINGS

REV	DATE	DESCRIPTION	DRAWN
AUG/01		ISSUE FOR TENDER - AUGUST 20, 2001 STAGE 3 ROADWORKS	JAF
A	OCT/01	ISSUE FOR CONSTRUCTION - OCTOBER 4, 2001 STAGE 3 ROADWORKS (POLES' 1C2(2)&2C2(2) LOCATION CHANGED)	JDM
B	APR/02	SIGN LIGHTING ADDED AT STA. 109+00 & STA. 108+92. 'NOW LOADING' SIGN PWR. ADDED TO POLES STA. 110+10.5 & 110+55. LUMINAIRE NUMBERING REVISED	JDM
C	JUL/02	'NOW LOADING' SIGNS, SIGN POLE AND WALL MOUNTED SIGN ADDED	RF
D	JAN/03	RECORD DRAWING (INFORMATION PROVIDED BY TRANS-WESTERN)	JDM

**MINISTRY OF TRANSPORTATION  
ELECTRICAL ENGINEERING CENTRE**

**HORSESHOE BAY FERRY TERMINAL IMPROVEMENT  
ROUTE 1 AT HORSESHOE BAY FERRY TERMINAL  
WEST VANCOUVER**

**KEY PLAN - SITE PLAN - COLOUR CODE**  
ELECTRICAL ENGINEER OF RECORD (FOR CURRENT REVISION)

DATE \_\_\_\_\_

SHEET NUMBER	SITE CODE	HWY DIST	REGION	DRAWING NUMBER
SHEET 3 OF 8		1	1	TE-01009-3