



- NOTES**
1. A NEW PROFILE SHALL BE RUN AT THE TIME OF CONSTRUCTION AND LOCATION & ELEVATIONS CHECKED AGAINST THIS SURVEY. PARTICULAR NOTE WILL BE TAKEN OF THE RIVER BED TO GIRDER CLEARANCE.
 2. ALL MEMBERS (EXCEPT RUNNING PLANKS) TO BE PRESSURE CREOSOTED.
 3. PRESERVATIVE TREATMENT: **HOT CREOSOTE**
 ALL CUTS AND ABRASIONS: TWO COATS
HOLES: USE PRESSURE GUN ON GIRDERS, BOTTLE BRUSH ELSEWHERE, TWO COATS.
PILE CUT OFF: TWO COATS, COVER HEADS WITH SHIP FELT. SATURATE FELT WITH CREOSOTE THEN COVER WITH AN ALUMINUM CAP NAILED TO THE SIDE OF THE PILE WITH ROOFING NAILS.
DRIFT PIPE HOLES: BOTTLE BRUSH TREATED BEFORE DRIVING OF DRIFT PIPES. AFTER DRIVING, FILL THE PIPE SEVERAL TIMES WITH CREOSOTE THEN PLUG TOP OF PIPE WITH ROOFING CEMENT.
 4. SUBSTRUCTURE
 PILE BEARING CAPACITY MINIMUM 20 TONS.
 5. BACKFILL MUST BE A FREE DRAINING GRAVEL COMPACTED IN HORIZONTAL LAYERS, 1' DEEP, FREE OF FROZEN LUMPS.
 6. DESIGN LOAD
 H 25-S20
 AASHO HIGHWAY LOAD (AXLE LOADS)





7. DATUM:
 BM 90 EL. 812.24 94' RIGHT OF L 726+32
 BM 91 EL. 800.16 70' RIGHT OF L 727+11
 8. A SEPARATE UNTREATED PILE SHALL BE DRIVEN IN A LOCATION TO BE DETERMINED IN THE FIELD. A WATER GAUGE SHALL BE PLACED THEREON.
 9. TEST HOLE LOG
 0'-10' SILTY SAND
 10'-15' SANDY GRAVEL
- REFERENCE DRAWINGS**
- 106P17-2-6 SUBSTRUCTURE DETAILS
 - 106P17-3-6 SUPERSTRUCTURE DETAILS
 - 106P17-4-6 GLULAM DETAILS
 - 106P17-5-6 SAWN TIMBERS DETAILS
 - 106P17-6-6 STEEL DETAILS
 - IV-15-6 SITE PLAN

No.	REVISION, ETC.	DATE	FILE	PROJECT
Province of British Columbia — Department of Lands, Forests, and Water Resources Forest Service, Victoria, B.C. — Engineering Services Division				
GOLD RIVER F.R. MI. 13.8 CERVUS CREEK BRIDGE				
GENERAL LAYOUT				
FILE No. 0262137	DRAWN BY: <i>[Signature]</i>	CHECKED BY: <i>[Signature]</i>	DATE: <i>[Date]</i>	DRAWING No. 106P17-1-6
PROJECT: 6967	APPROVED BY: <i>[Signature]</i>	DATE: OCTOBER 1967	SCALE: 1/4" = 1'-0"	DATE: OCTOBER 1967

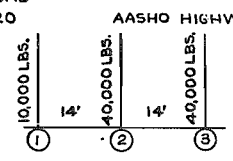

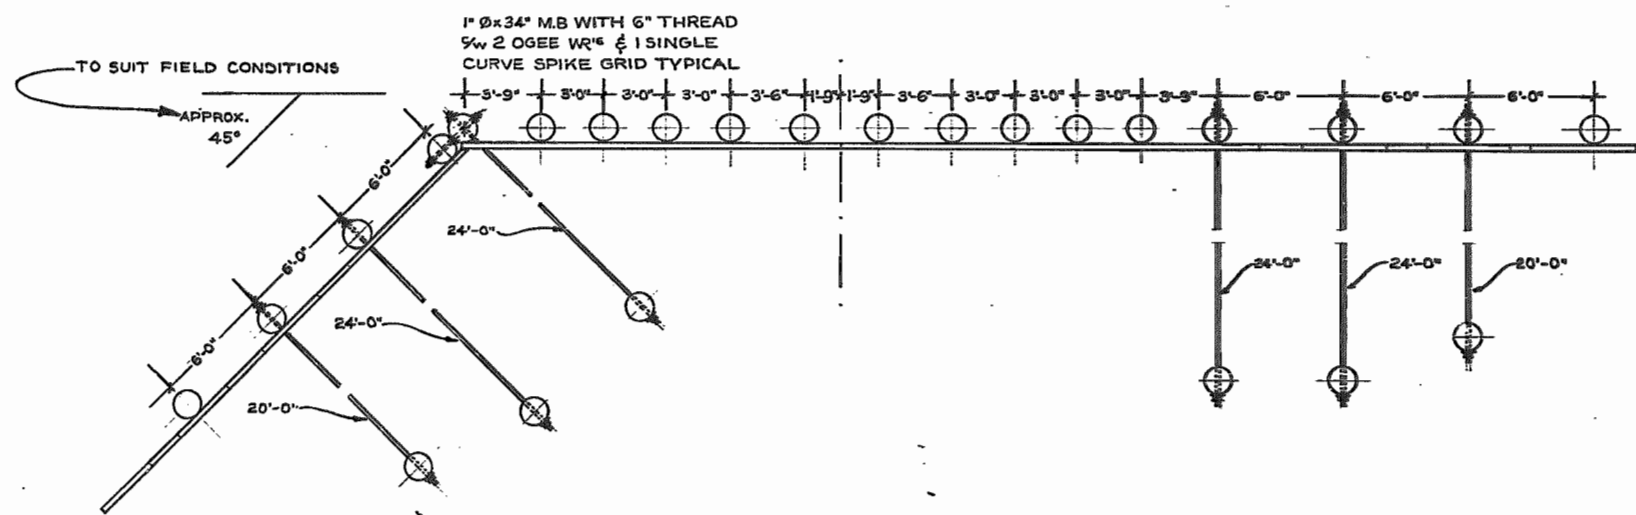


NOTE
 LOCATE THE BRIDGE TO PROVIDE A SMOOTH TRANSITION FROM THE STRAIGHT STRETCH OF CHANNEL UPSTREAM TO THE ELK RIVER.
 THE SCOUR HOLE UPSTREAM ON THE EAST BANK SHALL BE FILLED AND BOTH BANKS PROTECTED AGAINST SCOUR WITH RIP-RAP AS REQUIRED.

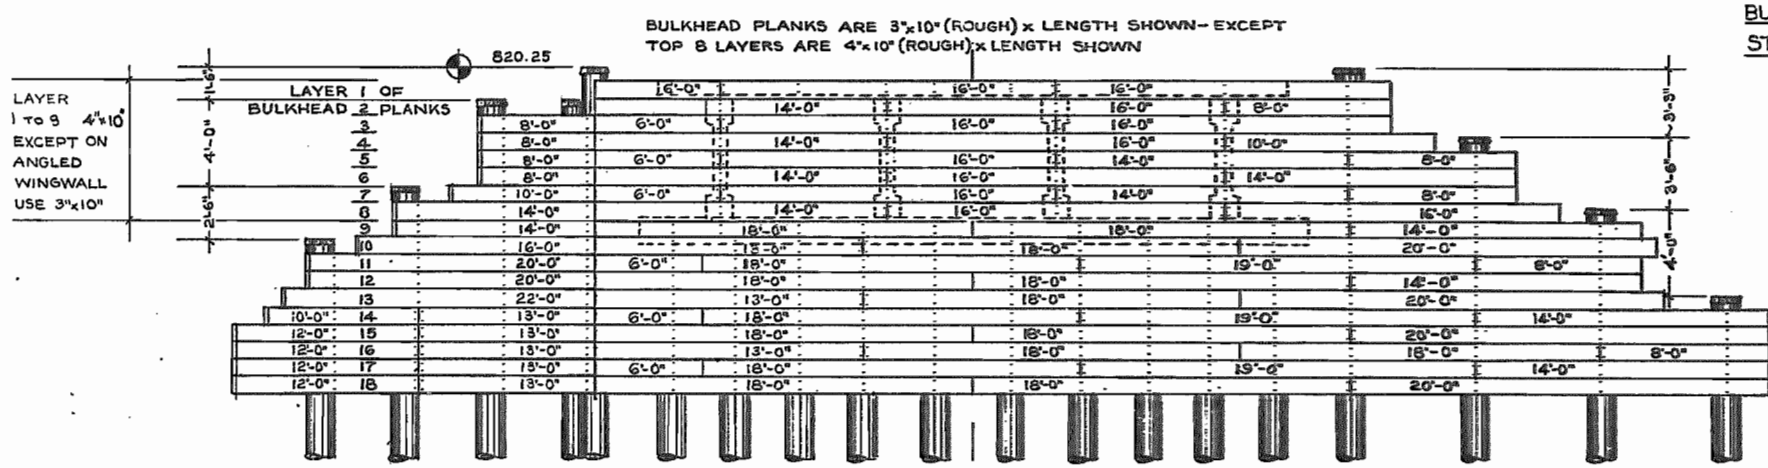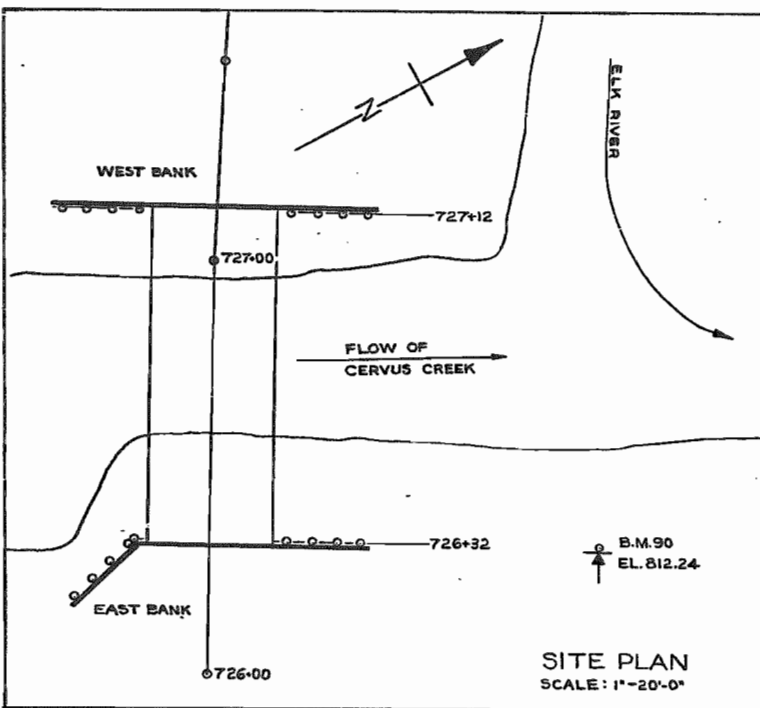

BULKHEAD WITH TWO STRAIGHT WINGWALLS

LAYER	LENGTH IN FEET
1	8 16 16
2	16 16 8
3	8 16 16
4	16 16 10
5	14 16 14 8
6	8 14 16 14
7	14 16 14 8
8	10 14 16 16
9	14 16 16 14
10	8 16 16 20
11	20 16 16 8
12	14 16 16 14
13	10 16 16 20
14	8 16 16 14
15	20 16 16 20
16	14 16 16 16 8
17	8 16 16 19 14
18	20 16 16 20

BULKHEAD WITH ANGLED WINGWALL **BULKHEAD WITH STRAIGHT WINGWALL**

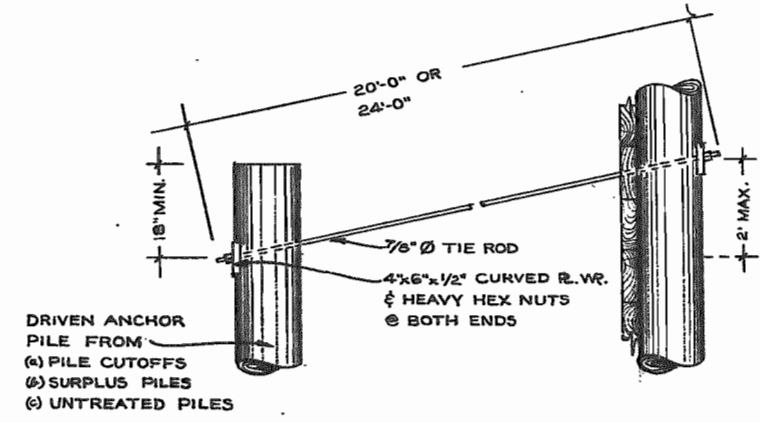


ANCHOR DETAIL




No.	REVISION, ETC.	DATE	FILE	PROJECT
Province of British Columbia — Department of Lands, Forests, and Water Resources Forest Service, Victoria, B.C. — Engineering Services Division				
GOLD RIVER FR. M.I. 13-8 CERVUS CREEK BRIDGE				
FILE No:	0262137	DRAWN BY: M. Shook	CHECKED BY: R. H. J.	DESIGNED BY: J. H.
PROJECT:	6967	APPROVED BY: R. Scrimble	DRAWING No. 106P17-2-6	
SCALE:	NOT TO SCALE	APPROVED:	DATE: OCTOBER, 1967	SHEET: 3


1"Ø x 34" MB. WITH
6" THREAD 9W
2 Ogee WR'S &
1 SINGLE CURVE
SPIKE GRID (TYPICAL)

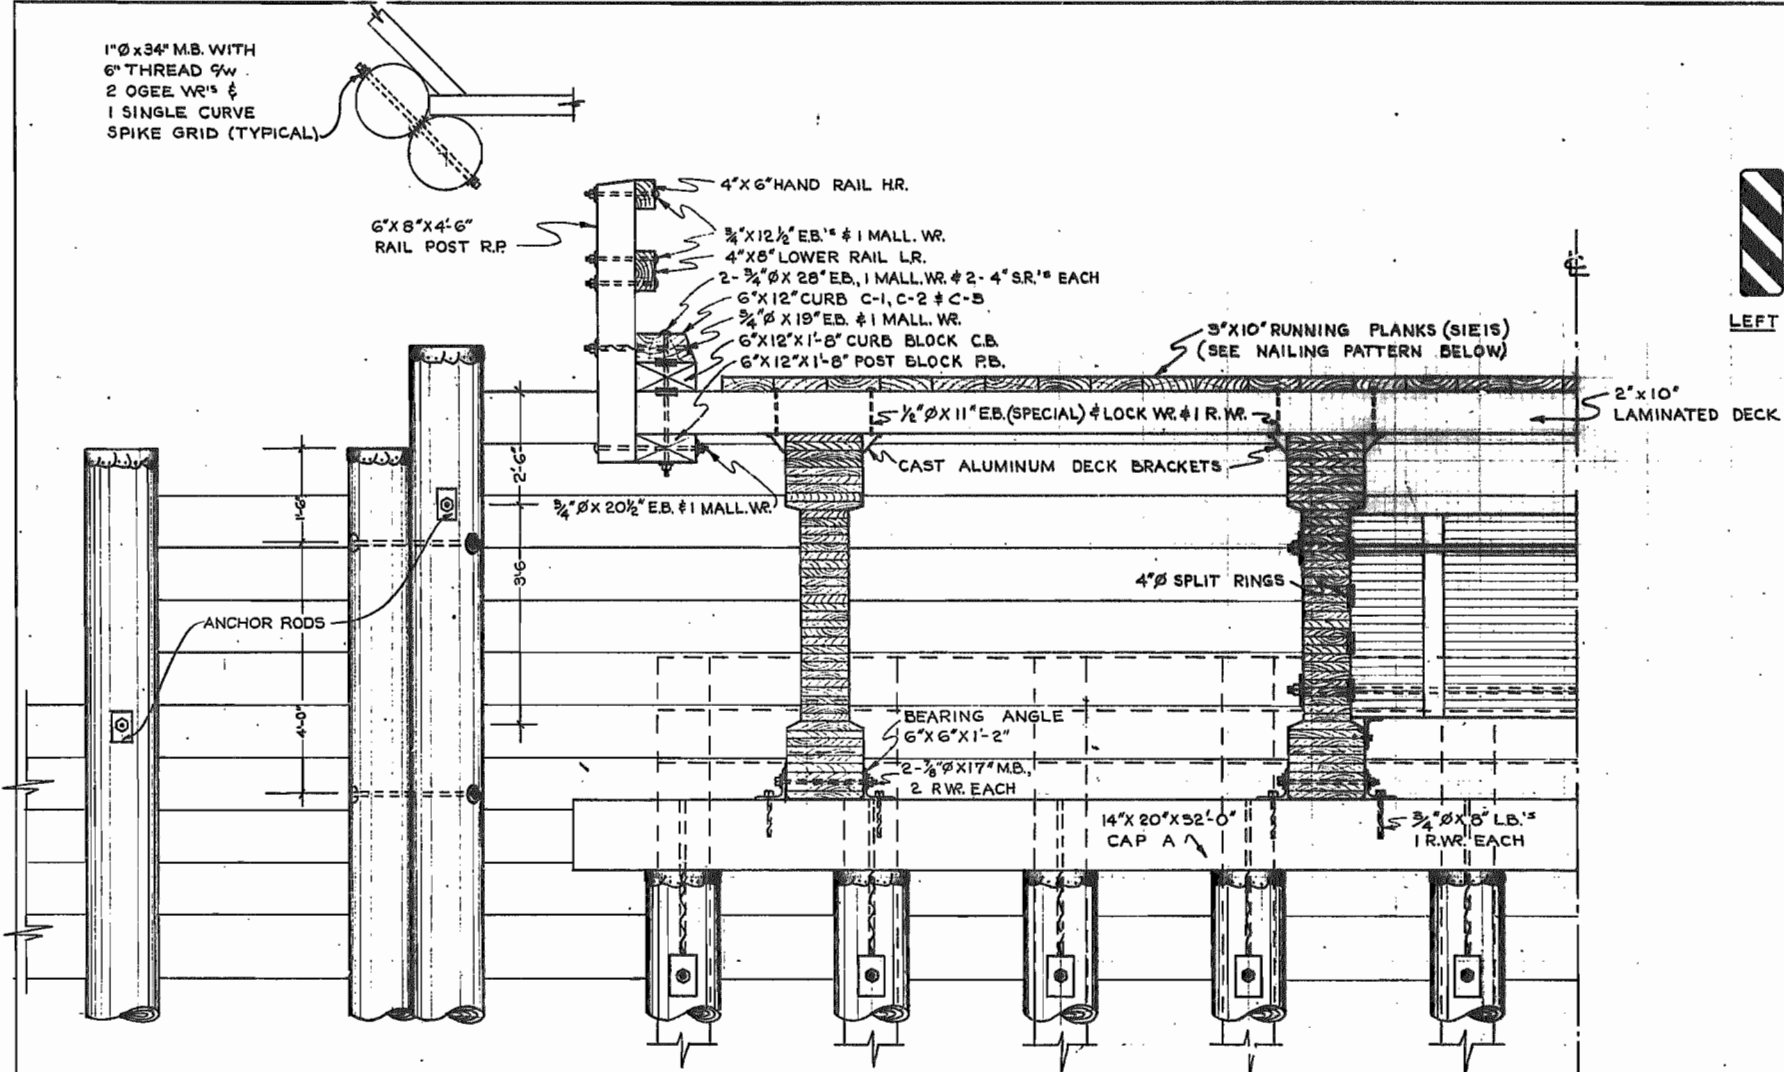



SECTION THROUGH GIRDERS

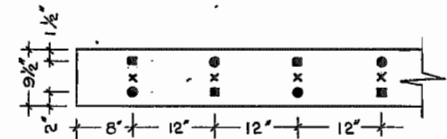

NAILING PATTERN FOR DECK LAMINATIONS
LAMINATIONS TO BE NAILED @ 12" O.C. WITH 5 1/2" COMMON NAILS
■ INDICATES NAILING OF 1", 4", 7", ETC. LAMINATIONS
● " " " 2", 5", 8", " " "
x " " " 3", 6", 9" " " "

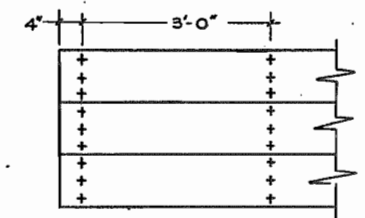

RUNNING PLANK NAILING PATTERN
USE 6" ARDOX NAILS

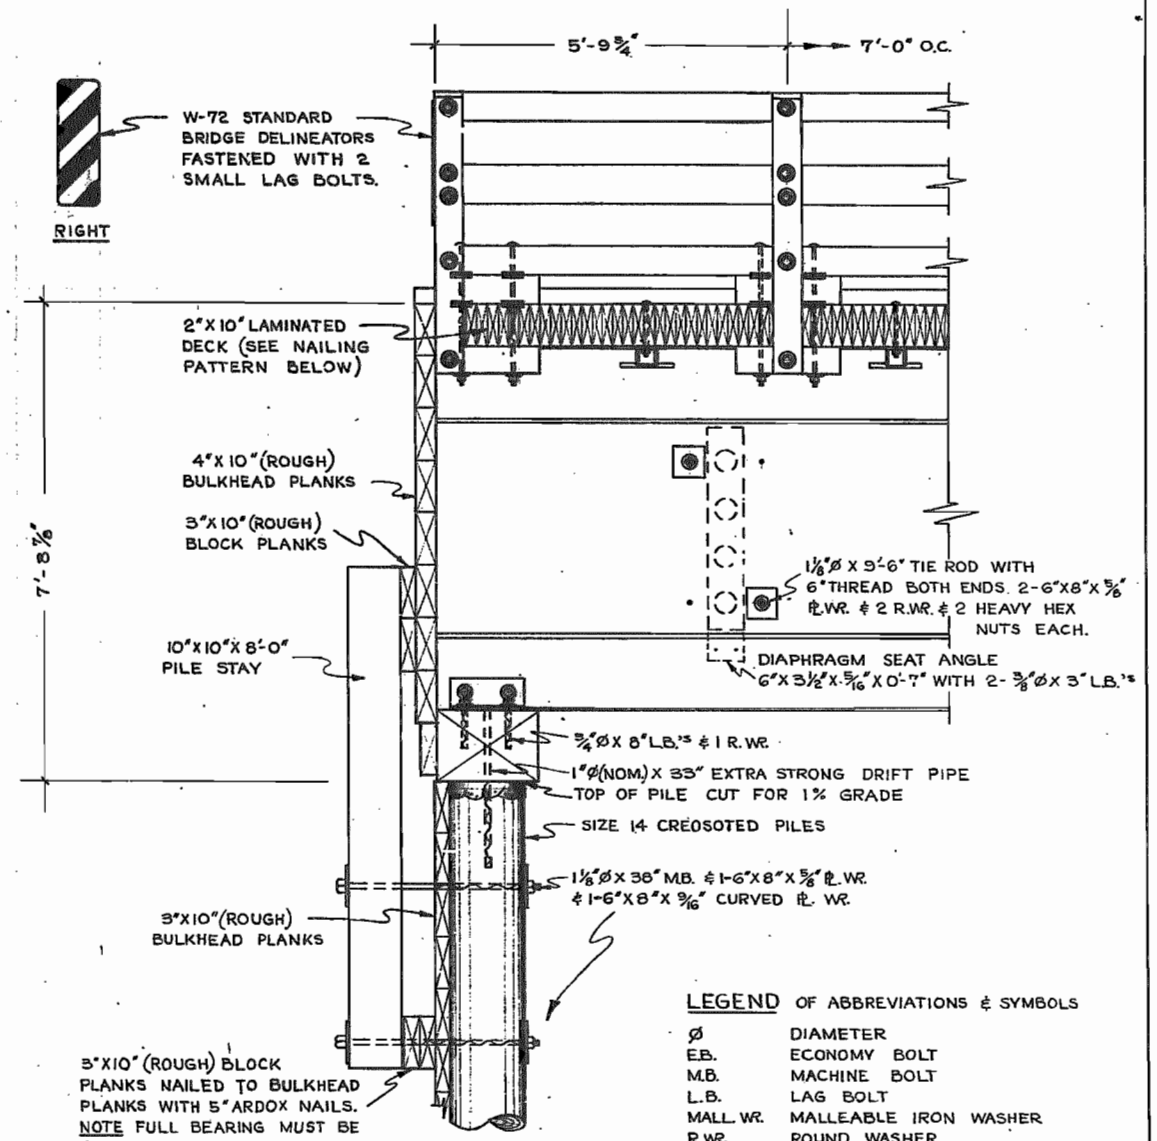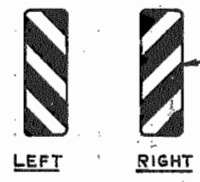

ELEVATION AT BULKHEAD








3"X10" (ROUGH) BLOCK PLANKS NAILED TO BULKHEAD PLANKS WITH 5" ARDOX NAILS. NOTE FULL BEARING MUST BE ASSURED FOR THE PILE STAY AT TOP & BOTTOM BLOCK PLANKS. CUT 10"X10" SHIM BLOCKS IF REQUIRED FROM CREOSOTED PLYWOOD.

LEGEND OF ABBREVIATIONS & SYMBOLS

Ø	DIAMETER
E.B.	ECONOMY BOLT
M.B.	MACHINE BOLT
L.B.	LAG BOLT
MALL. WR.	MALLEABLE IRON WASHER
R.W.R.	ROUND WASHER
S.R.	SPLIT RING
PL. WR.	PLATE WASHER
SIEIS	SURFACED 1 EDGE 1 SIDE
FIELD DRILLED HOLE	
O.C.	ON CENTRE



NO.	REVISION, ETC.	DATE	FILE	PROJECT
PROVINCE OF BRITISH COLUMBIA — DEPARTMENT OF LANDS AND FORESTS FOREST SERVICE, VICTORIA, B.C. — ENGINEERING SERVICES DIVISION				
GOLD RIVER F.R. MI. 13.8 CERVUS CR. BRIDGE SUPERSTRUCTURE DETAILS				
FILE NO.: 0262137	DRAWN BY: [Signature]	CHECKED BY: [Signature]	DESIGNED BY: [Signature]	DRAWING NO. 106P17-3-6
PROJECT: 6967	APPROVED: [Signature]	DATE: SEPT. 1965	SCALE: NOT TO SCALE	DATE: SEPT. 1965







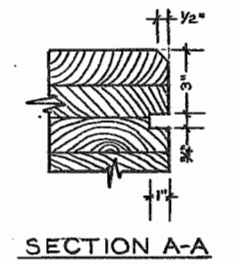
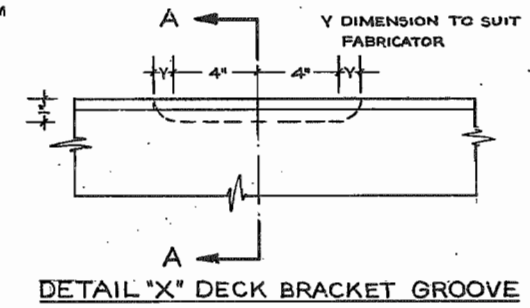
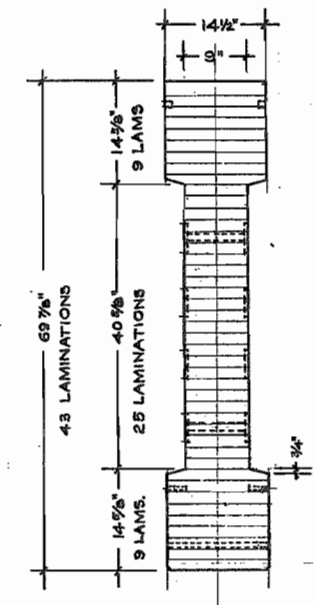
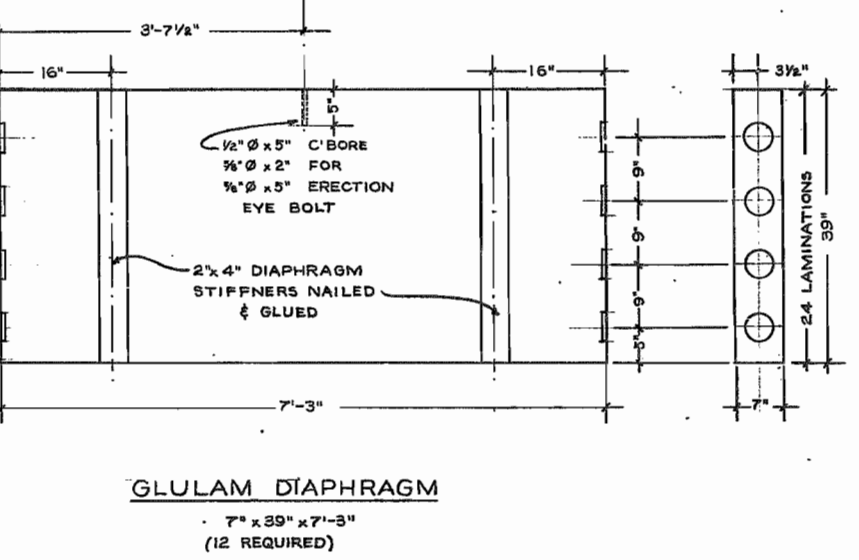
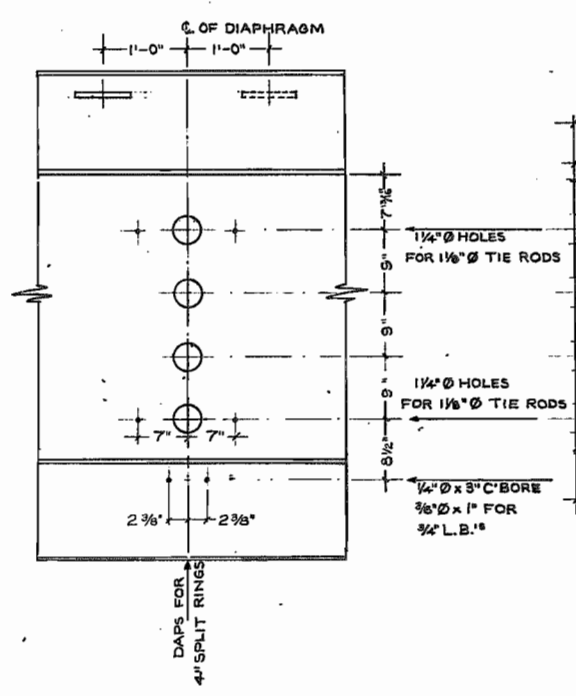
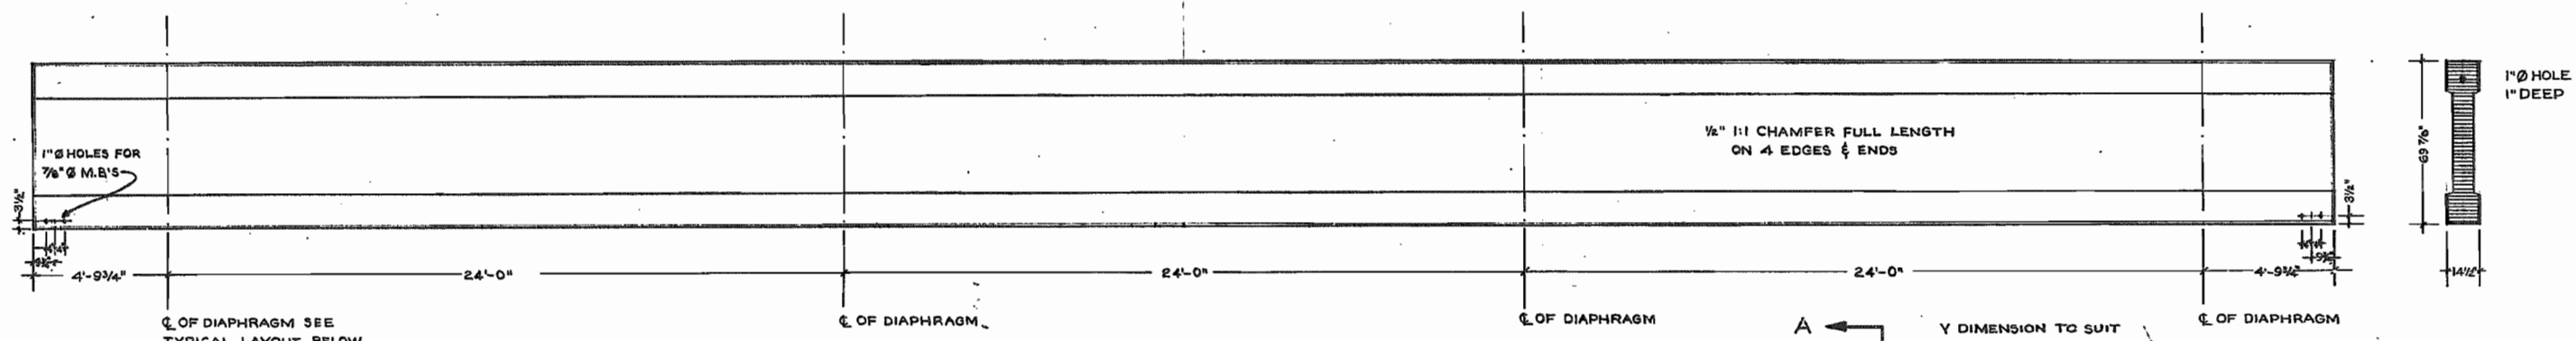
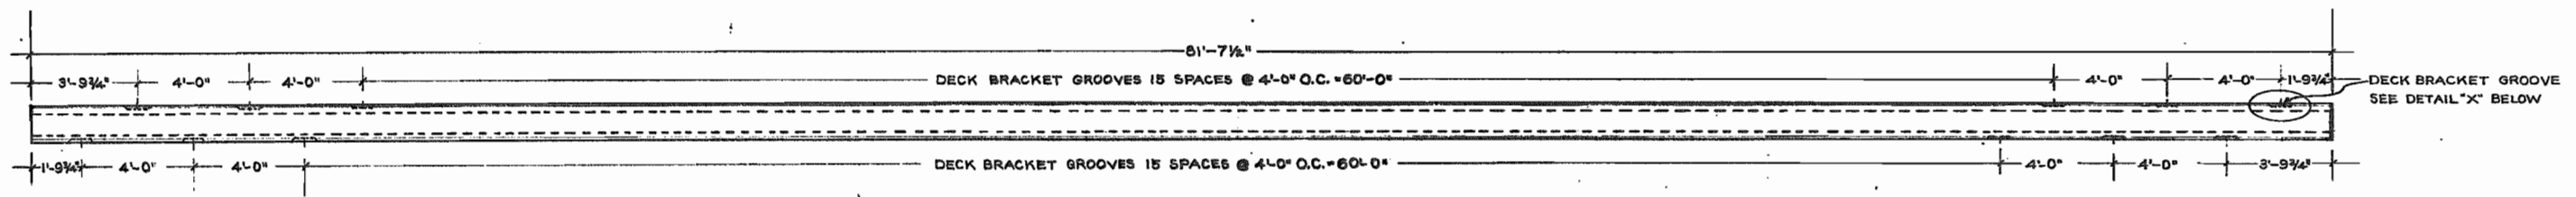


- GENERAL NOTES**
1. MARK MATCHING ENDS OF GIRDERS WITH 1" HOLE 1" DEEP.
 2. ALL DIMENSIONS FOR HOLES ARE TYPICAL.
 3. LAYUP SHALL BE IN ACCORDANCE WITH C.S.A. 0122-1959 STRESS GRADE 24 F.
 4. PROVIDE A PARABOLIC CAMBER ON GIRDERS WITH A CENTER ORDINATE OF 2 1/2".
 5. GIRDERS TO BE INTERCHANGEABLE END FOR END & IN POSITION.




NO.	REVISION, ETC.	DATE	FILE	PROJECT
PROVINCE OF BRITISH COLUMBIA - DEPARTMENT OF LANDS AND FORESTS FOREST SERVICE, VICTORIA, B.C. - ENGINEERING SERVICES DIVISION GOLD RIVER F.R. MI. 13.8 CERVUS CREEK BRIDGE GLULAM DETAILS				
FILE NO.: 0262137	DRAWN BY: <i>Atch</i>	CHECKED BY: <i>Atch</i>	DESIGNED BY: <i>Atch</i>	DRAWING NO.
PROJECT: 6967	APPROVED BY: <i>P. Scrimble</i>	DATE: OCTOBER, 1965	SCALE: NOT TO SCALE	106P17-4-6



TYPICAL LAYOUT ON BOTH SIDES OF THE GIRDER AT ALL DIAPHRAGM C'S

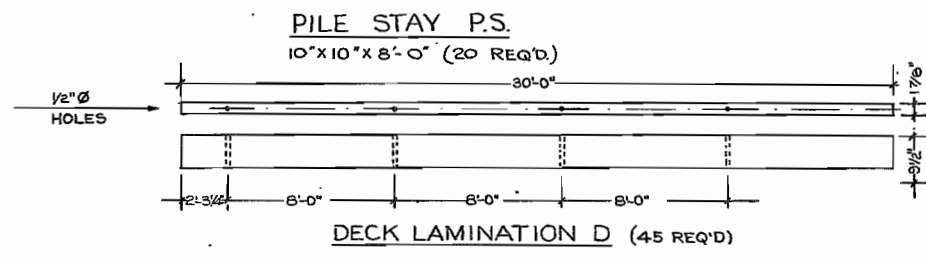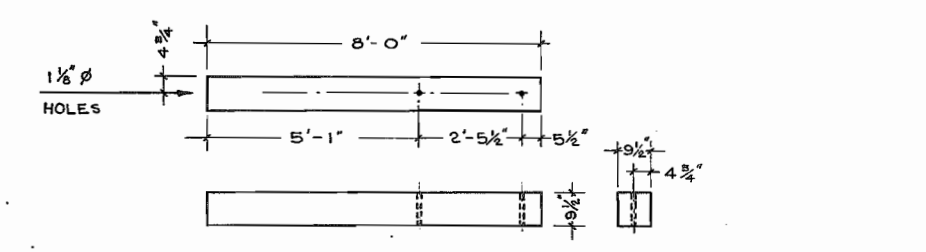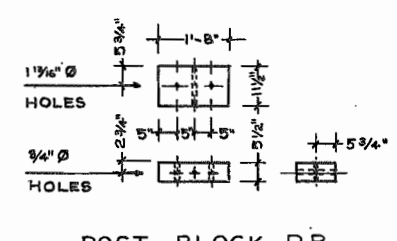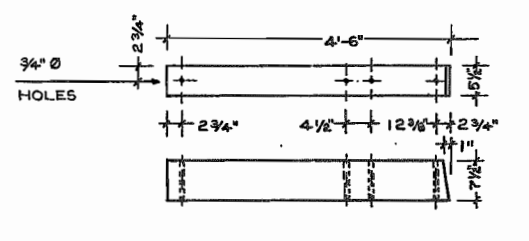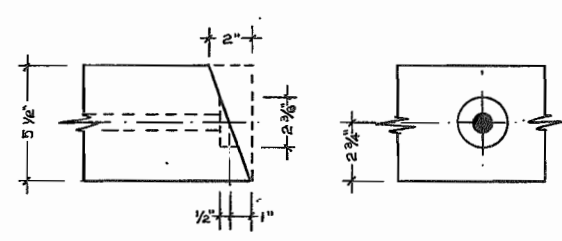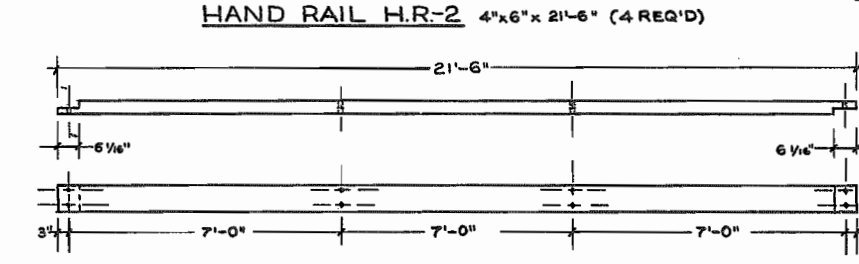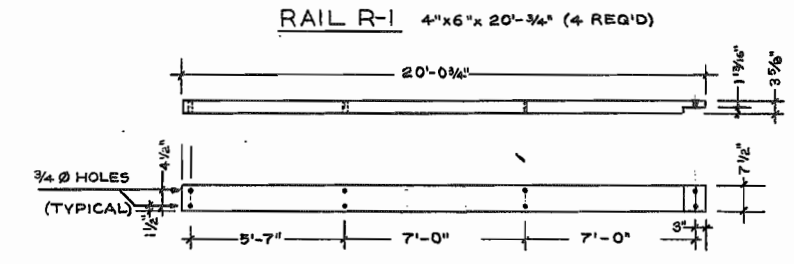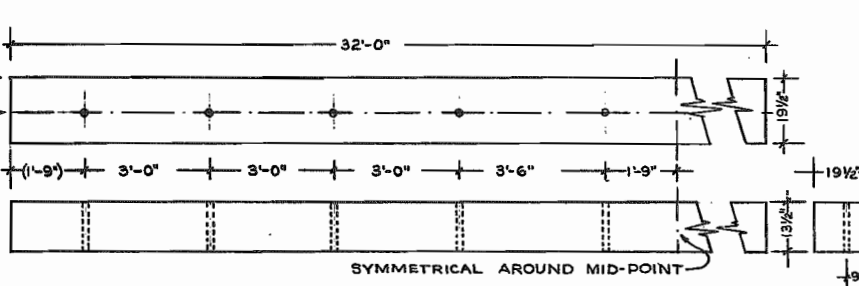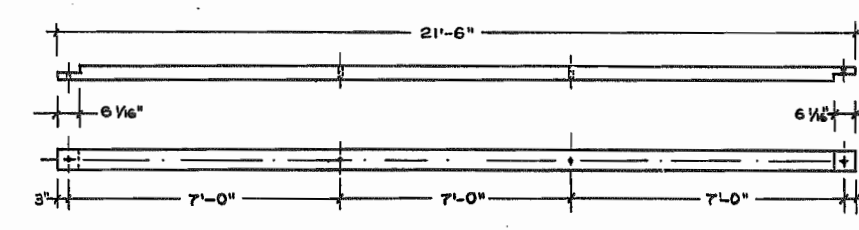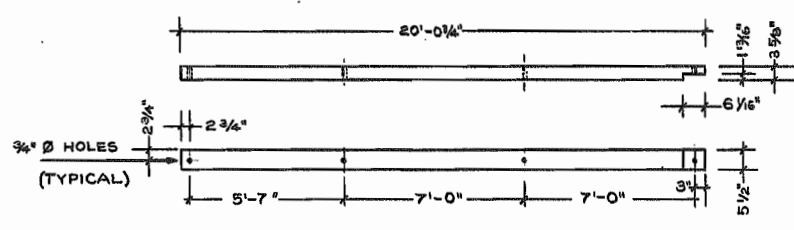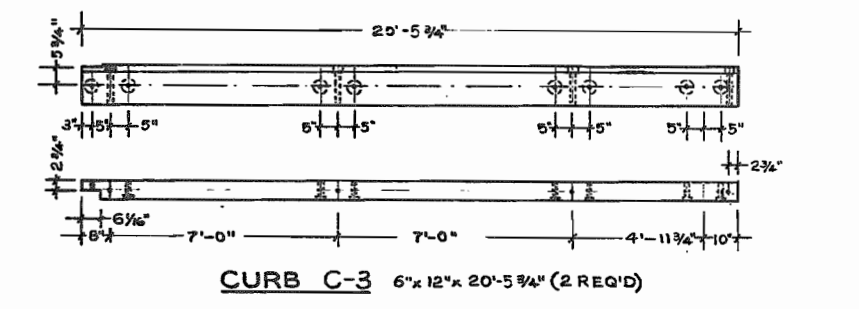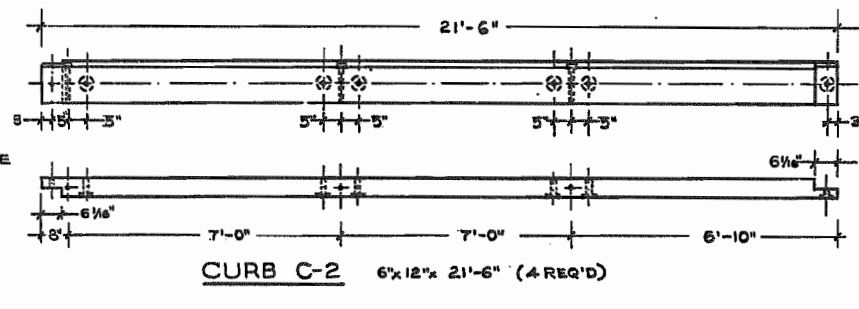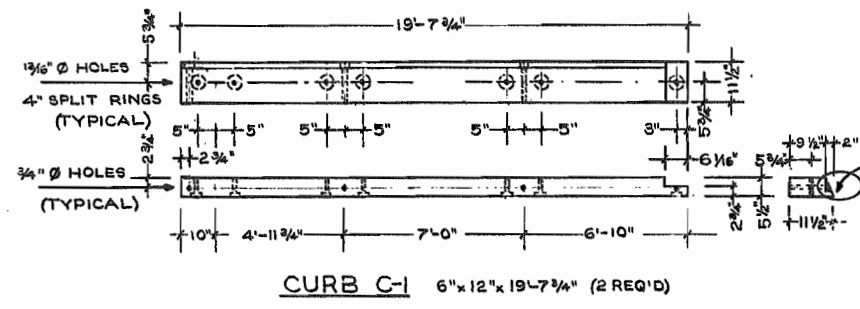


- NOTES**
1. ALL MATERIAL S45 EXCEPT WHERE NOTED.
 2. ALL QUANTITIES SHOWN ARE GROSS QUANTITIES TO BE SUPPLIED.
 3. FOR QUANTITIES, GRADES ETC., ETC., REFER TO SPECS & MATERIALS LIST.
 4. FOR ADDITIONAL UNFABRICATED MATERIAL REFER TO MATERIALS LIST.

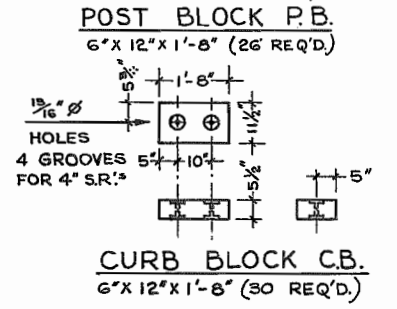



No.	REVISION, ETC.	DATE	FILE	PROJECT
Province of British Columbia — Department of Lands, Forests, and Water Resources Forest Service, Victoria, B.C. — Engineering Services Division				
GOLD RIVER FR. ML 13.8. CERVUS CREEK BRIDGE				
SAWN TIMBERS DETAILS				
FILE No. 0262137	DRAWN BY: M. Smith	CHECKED: R. S. B.	DESIGNED: M. S.	DRAWING No. 106P17-5-6
PROJECT: 6967	APPROVED: R. Smith			
SCALE: NOT TO SCALE	APPROVED:	DATE: OCTOBER 1965	SIZE: C	

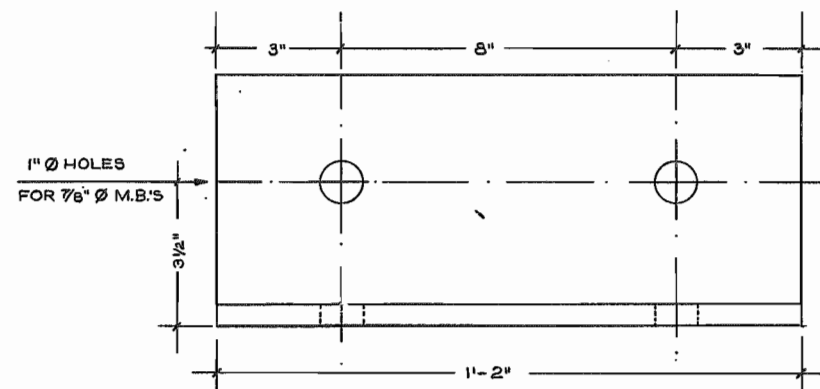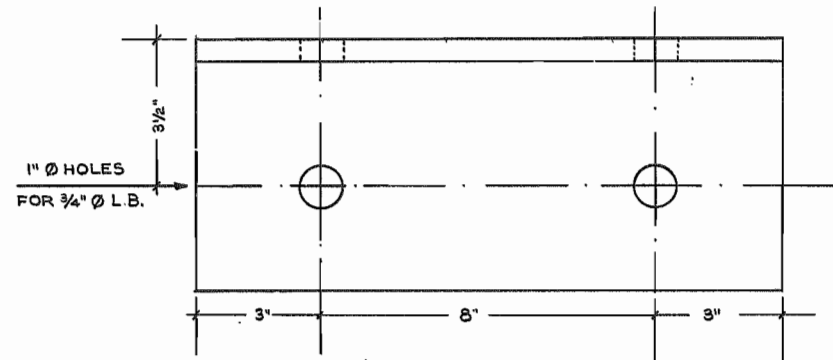

BEARING ANGLE L 6"x6"x1/2"x1'-2" (16 REQ'D)

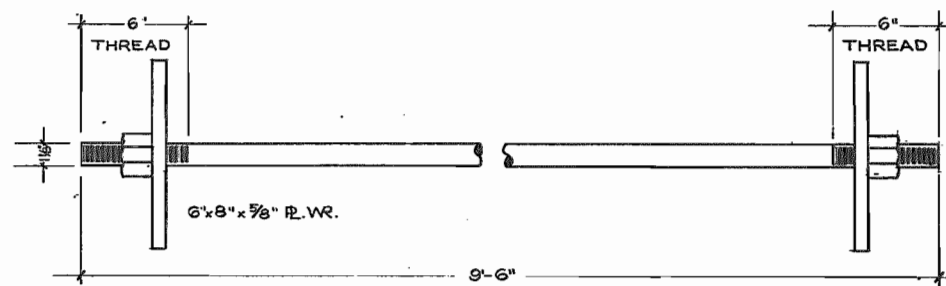


DIAPHRAGM TIE ROD ASSEMBLY
 1 1/2" x 9'-6" TIE ROD WITH 6" THREAD BOTH ENDS.
 2-6"x8"x5/8" PLATE WASHERS WITH A CENTER HOLE OF 1 3/16" Ø
 2-HEAVY HEX NUTS.
 (24 REQ'D)

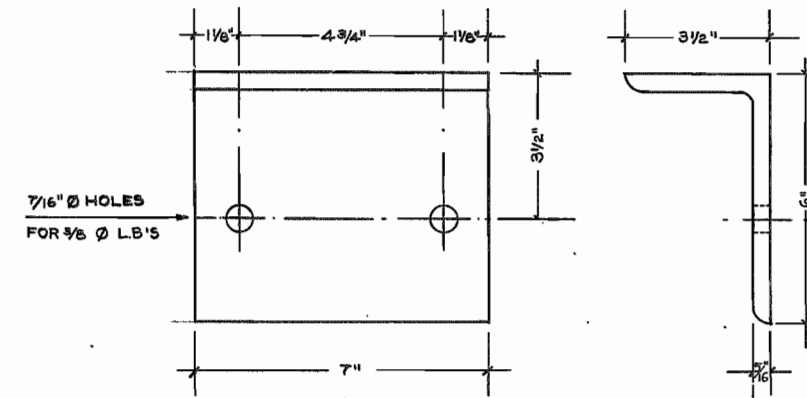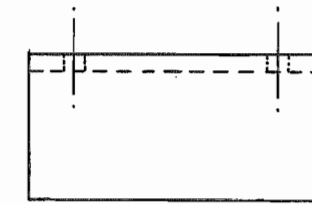

DIAPHRAGM SEAT ANGLE
 6"x3 1/2"x3/16"x0'-7" (24 REQ'D)

NOTE
 ALL STEEL TO BE HOT DIP GALVANIZED IN ACCORDANCE WITH A.S.T.M. SPEC. A153

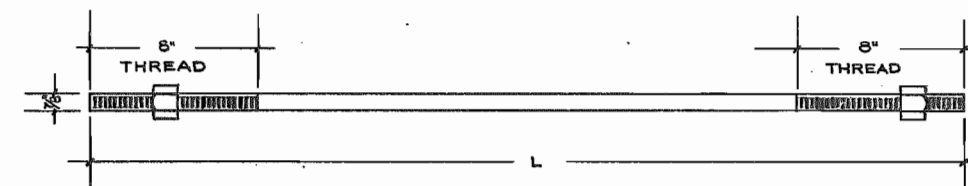

ANCHOR TIE ROD ASSEMBLY
 7/8" Ø TIE ROD 20'-0" L (4 REQ'D)
 7/8" Ø TIE ROD 24'-0" L (8 REQ'D)
 HEAVY HEX NUTS (24 REQ'D)




No.	REVISION, ETC.	DATE	FILE	PROJECT
Province of British Columbia — Department of Lands, Forests, and Water Resources Forest Service, Victoria, B.C. — Engineering Services Division				
GOLD RIVER FR. MI. 13.8 CERVUS CREEK BRIDGE				
STEEL DETAILS				
FILE No.: 0262157	DRAWN BY: <i>Struth</i>	CHECKED BY: <i>R.H.S.</i>	DESIGNED BY: <i>J.R.</i>	DRAWING No. 106P17-6-6
PROJECT: 6967	APPROVED: <i>R. Scarsbird</i>	DATE: OCTOBER, 1965		SCALE: NOT TO SCALE

1A-12-B

GOLD RIVER FR.

1A-12-B

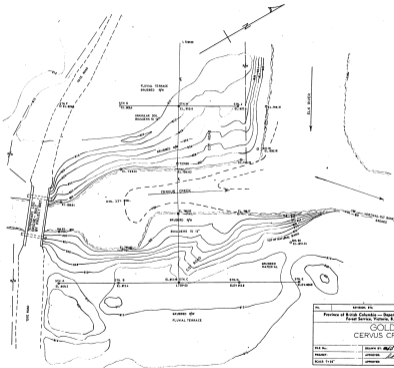

1051100

NO.	APPROVED BY	DATE	BY	REMARKS
Province of British Columbia — Department of Lands, Survey, and Water Resources Forest Service, Victoria, B.C. — Engineering Services Division				
GOLD RIVER FR. CERVUS CR. SITE PLAN				
FILE NO.	DESIGNED BY	DRAWN BY	CHECKED BY	2285-VJ
PROJECT	APPROVED	DATE	BY	
SCALE 1:125	DATE	BY	BY	

GOLD RIVER FR.

2285-VJ