

NOTES:

1. ALL CP CABLE ROUTING AND EQUIPMENT DRAWN BASED ON INDIRECT LOCATION METHODS AND COMPILATION OF HISTORICAL DRAWINGS AND RECORDS. THIS DRAWING IS TO BE USED FOR INFORMATION ONLY. ALL GROUND DISTURBANCE WORK SHOULD FOLLOW TYPICAL LOCATION AND DAYLIGHTING PROCEDURES USING THIS DRAWING AS A GUIDE.
2. SEE DRAWING 5940-2 FOR CATHODIC PROTECTION SYSTEM SCHEMATIC.
3. DIMENSIONS ARE GIVEN IN METERS UNLESS OTHERWISE NOTED.
4. BACKGROUND IMAGE FROM CRD REGIONAL MAP WEBSITE (2019 IMAGERY).



LEGEND

- HORIZONTAL ANODE
- ▣ RECTIFIER
- N— NEGATIVE CABLE
- P— POSITIVE CABLE
- ⊠ TEST STATION

PLAN  
1:500


N:\CORPORATE\DWG\MASTER DWGS 01\2019\67005\DL6795 CAPITAL REGIONAL DISTRICT VICTORIA BC CPD-6795-25\_C2.DWG PLOT DATE: May 28, 2021

								<b>Capital Regional District</b>   Integrated Water Services		REGIONAL WATER SUPPLY				
	DESIGNED	S. McKELVEY	SURVEYED	-	DRAWN	A. ALMODOVAR		DATE	28/05/2021	ST. GILES CATHODIC PROTECTION ANODE GROUNDBED LAYOUT PLAN				
SCALE HORIZONTAL	AS SHOWN	CHECKED	-	SCALE VERTICAL	AS SHOWN	APPROVED	-	CONTRACT NUMBER	2020-624	DRAWING NUMBER	5940	ISSUE	0	SHT. No. 1 OF 2
SEAL	BY	DATE	No.	REVISION	ENG.	No.	DATE	ISSUE						
	AA	28/05/2021	0	RECORD DRAWING	SM	0	28/05/2021	RECORD DRAWING						

NOTES:

1. ALL CP CABLE ROUTING AND EQUIPMENT DRAWN BASED ON INDIRECT LOCATION METHODS AND COMPILATION OF HISTORICAL DRAWINGS AND RECORDS. THIS DRAWING IS TO BE USED FOR INFORMATION ONLY. ALL GROUND DISTURBANCE WORK SHOULD FOLLOW TYPICAL LOCATION AND DAYLIGHTING PROCEDURES USING THIS DRAWING AS A GUIDE.
2. SEE DRAWING 5940-1 FOR CATHODIC PROTECTION LAYOUT.

MAIN NO. 3 – ST. GILES STREET  
CATHODIC PROTECTION SYSTEM OVERVIEW  
NOT TO SCALE

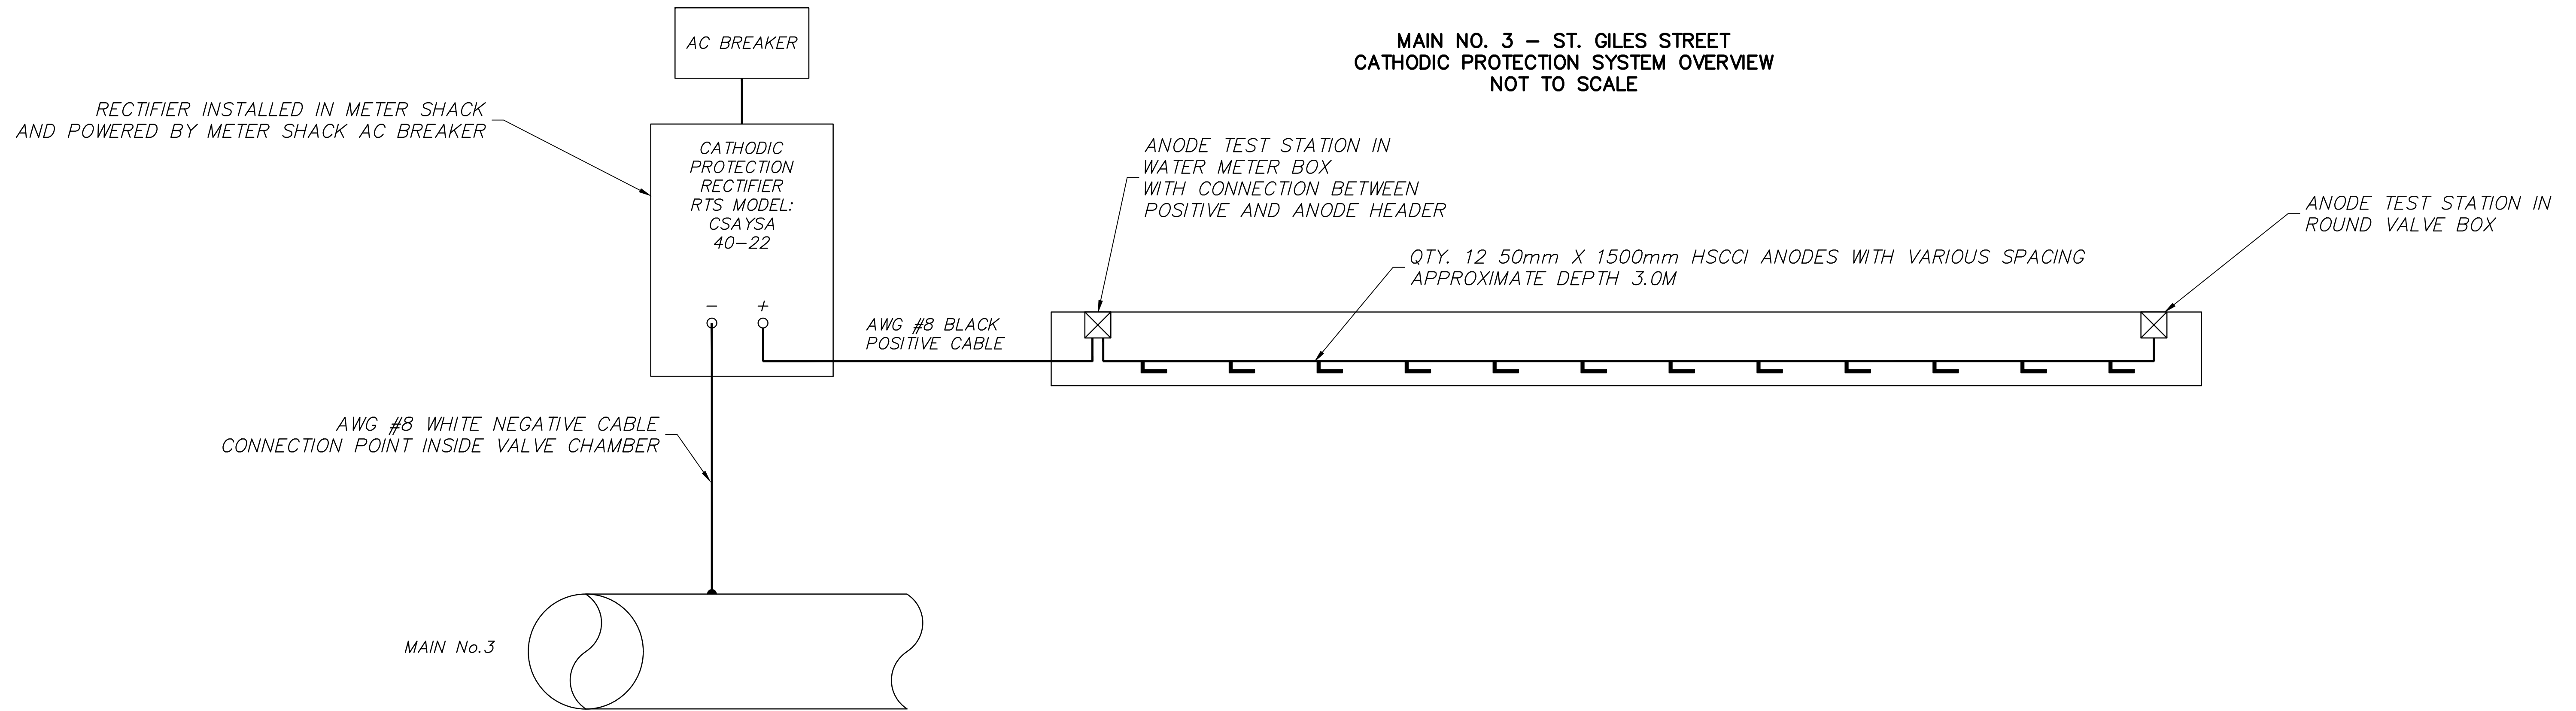

N:\CORPORATE\DFD\DWG\MASTER DWGS 01\2019\6700\DL-6795 CAPITAL REGIONAL DISTRICT VICTORIA BC CPD-6795-30\_C2.DWG PLOT DATE: 28/05/2021

	SEAL						<p>Making a difference...together</p>	Capital Regional District   Integrated Water Services		REGIONAL WATER SUPPLY									
	DESIGNED	S. McKELVEY	SURVEYED			DRAWN		A. ALMODOVAR	DATE	28/05/2021	ST. GILES CATHODIC PROTECTION ANODE GROUNDBED SYSTEM SCHEMATIC								
	SCALE HORIZONTAL	AS SHOWN	CHECKED			SCALE VERTICAL		AS SHOWN	APPROVED	-	CONTRACT NUMBER	2020-624	DRAWING NUMBER	5940	ISSUE	0	SHT. No.	2 OF 2	
	BY	AA	DATE	28/05/2021	No.	0		REVISION	RECORD DRAWING	ENG.	SM	No.	0	DATE	28/05/2021	ISSUE	RECORD DRAWING		