

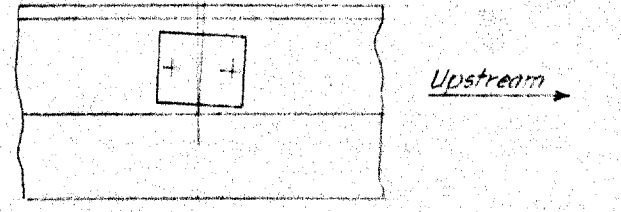
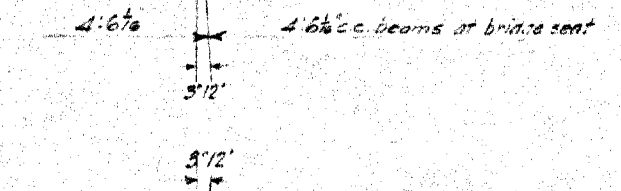




**BRIDGE SEAT ETC.  
AT EAST ABUTMENT**  
West Abutment similar  
Scale -  $\frac{3}{4}$ " = 1'-0"

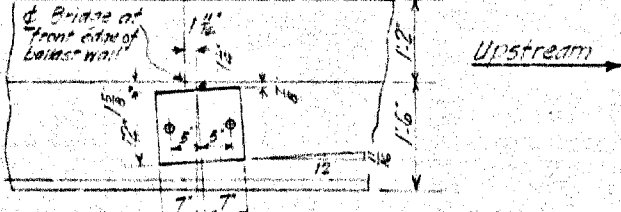


Showing Bed Plate in position  
at West Abutment

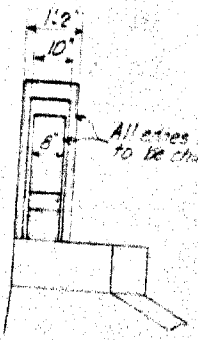


**END POST ON ABUTMENT**  
Scale -  $\frac{1}{2}$ " = 1'-0"  
At East Abutment, looking  
towards the bridge

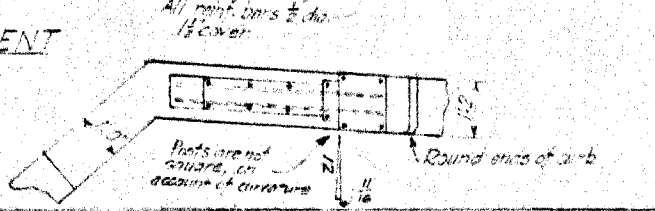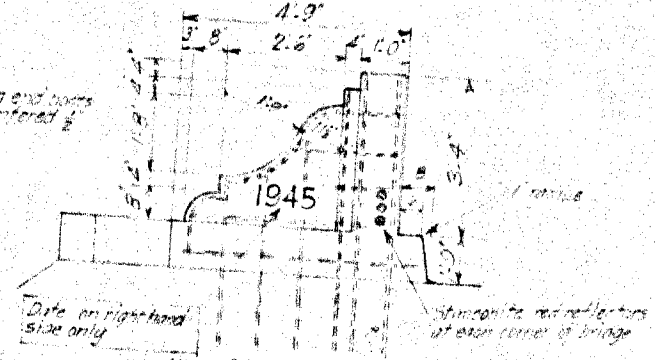


**SIDE ELEV.**

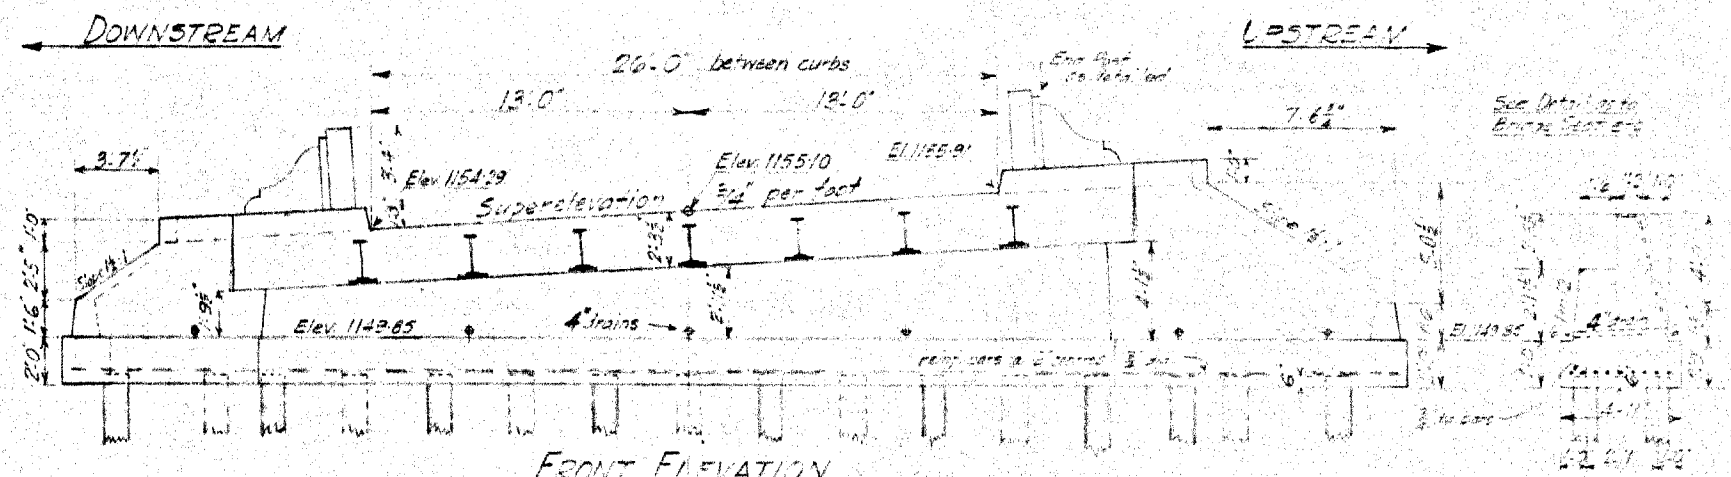

**FRONT ELEVATION**

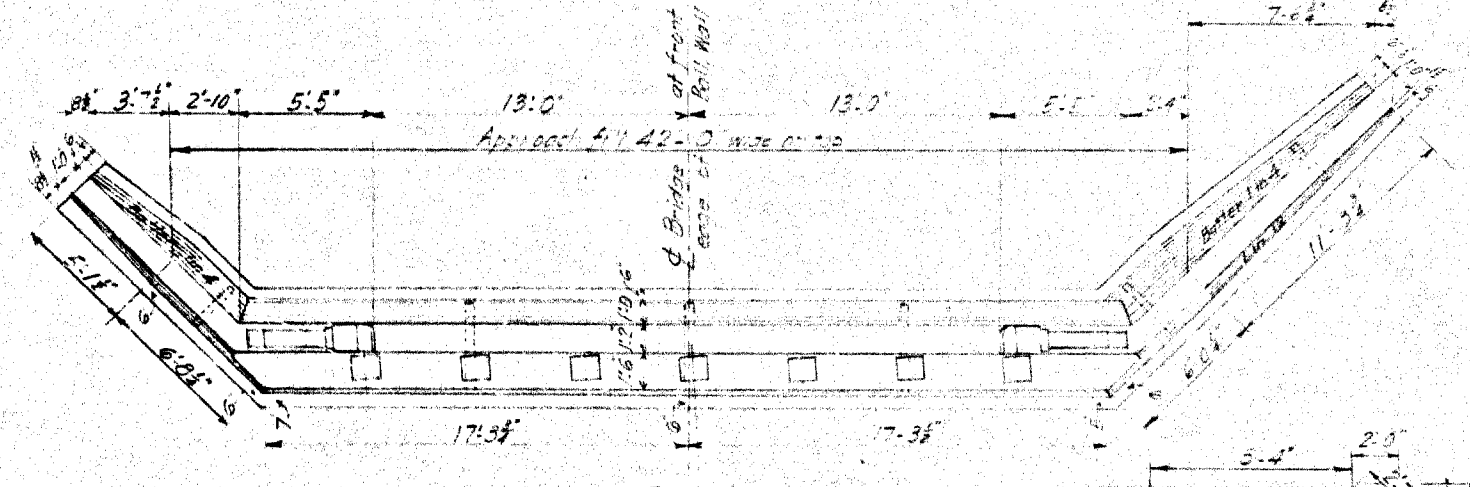

**PLAN**

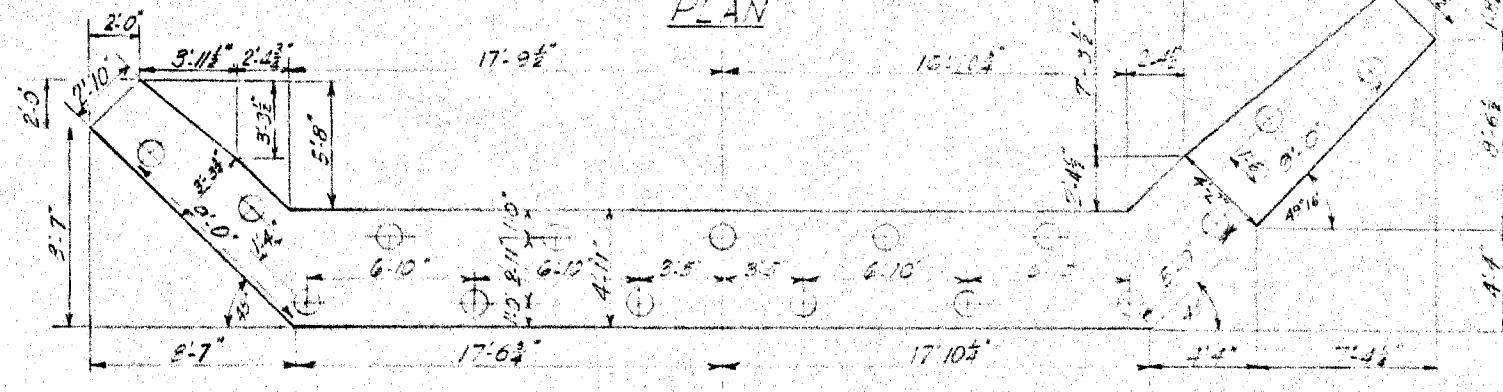

**FOUNDATION PLAN**


**EAST ABUTMENT**  
(West Abutment similar)  
Scale -  $\frac{1}{4}$ " = 1'-0"

16 Piles 24" dia.  
in each abutment  
Small heads of piles  
w/ hot creosote oil  
after cutting off


Chamfer exposed edges if exact where  
shown otherwise.  
Place 10' dia. pipe course at base of abutment  
and wing walls.  
Class C concrete (3 aggregates) for main  
part of abutment.  
Class A concrete (2 aggregates) for base of  
curbs and end posts.  
Class C concrete for treatments. 21 818  
1378 225

**SALMON ARM DISTRICT  
TRANS-CANADA HIGHWAY  
BRIDGE over SALMON RIVER  
AT SALMON ARM  
ABUTMENTS**

CHIEF OF ENGINEERS DEPT. OF HIGHWAYS VICTORIA	
Checked by G.A.S. Aug 1945	Drawn by J.P. 1/25
Checked by J.P. 1/25	Drawn by J.P. 1/25
	Scale 1" = 10'

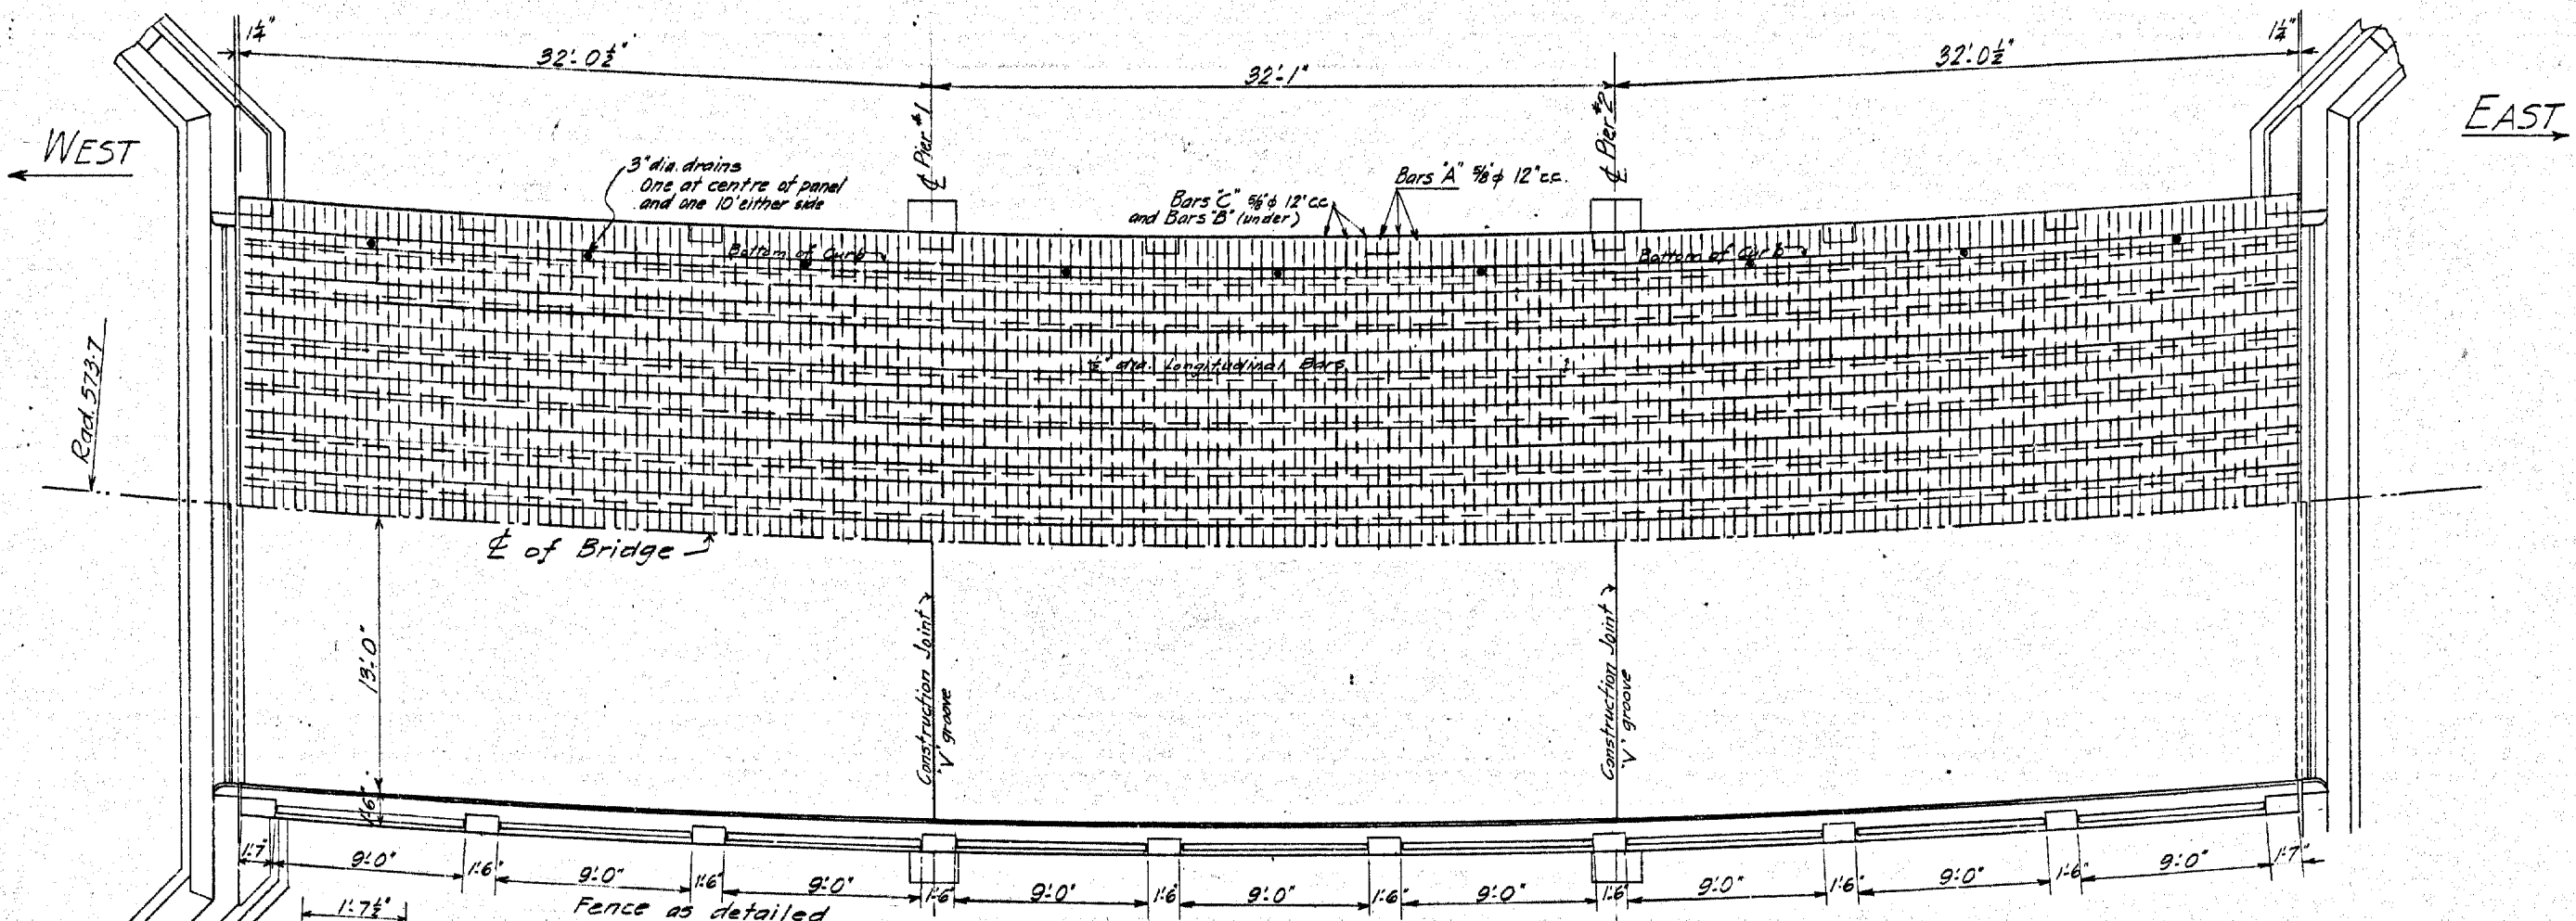


PLAN OF ROADWAY  
Scale: - 1/4" = 1 foot

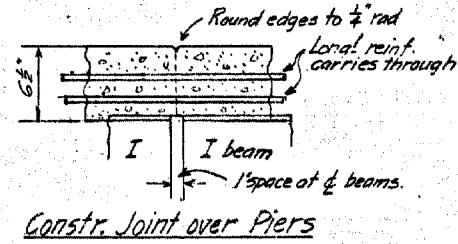


CONCRETE QUANTITIES

Slab (29' wide)	56.0 cu yds.
Curbs	10.2 "
Fence Posts	3.1 "
<b>Total</b>	<b>69.3 cu yds.</b>

Concrete in slab, curbs and fence posts to be Class "A".  
Splices in reinforcement, not less than 30" for 5/8" dia. bars, 24" for 1/2" dia.

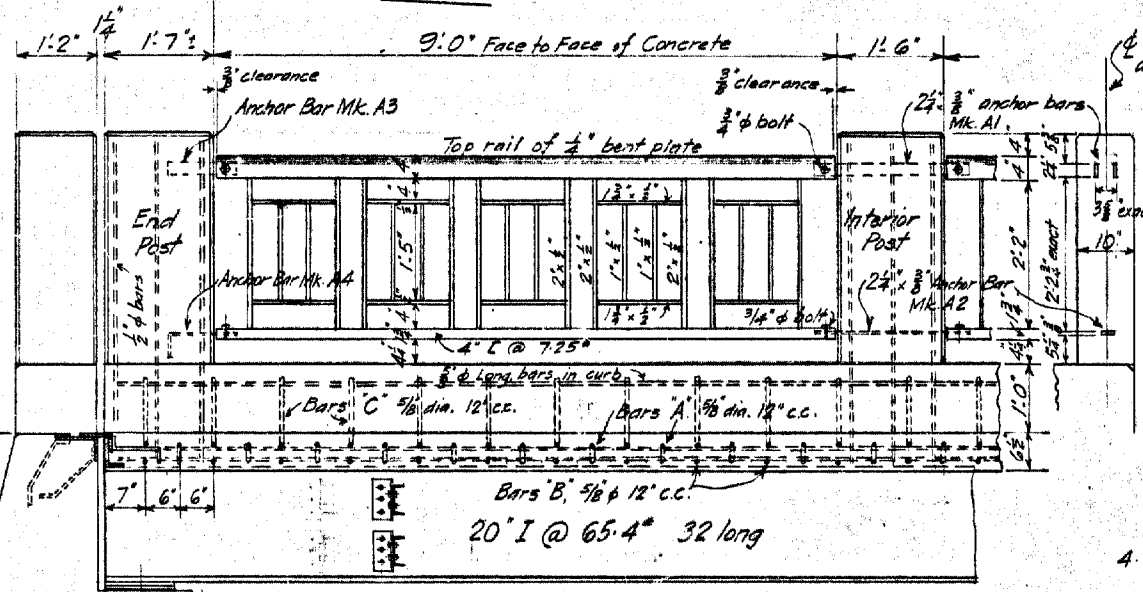

LONG SECTION  
showing Fence and outer I Beam  
Scale: - 3/8" = 1 foot

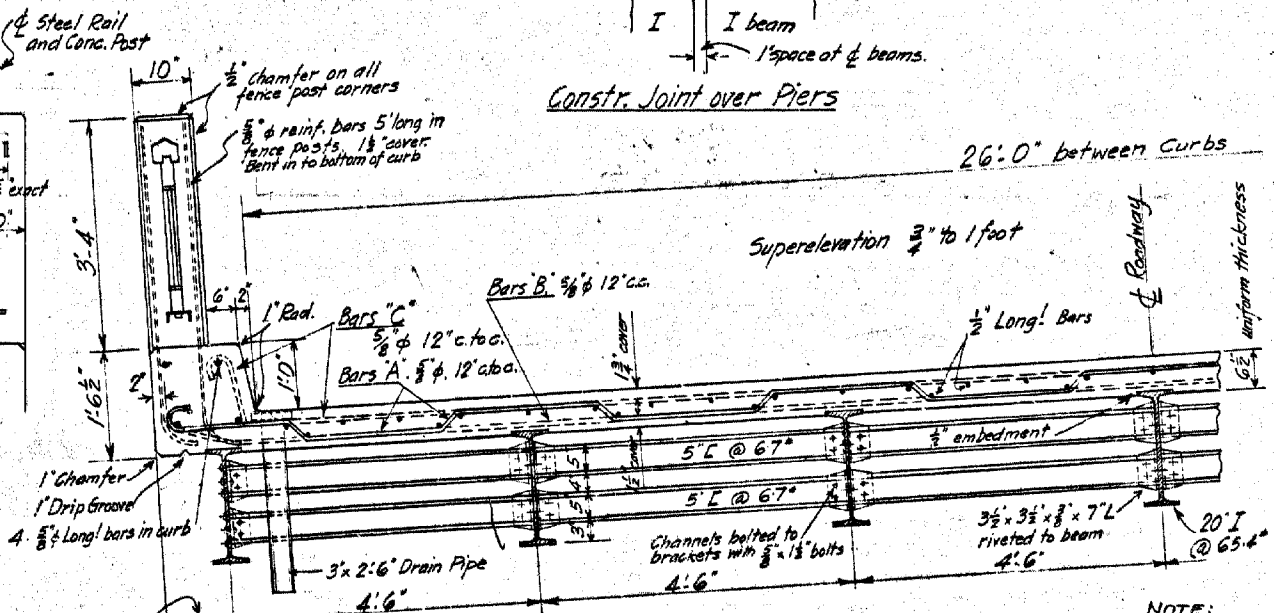

HALF CROSS SECTION OF BEAM SPAN  
Scale: - 3/8" = 1 foot


SALMON ARM DISTRICT  
TRANS-CANADA HIGHWAY  
BRIDGE OVER SALMON RIVER  
AT SALMON ARM  
ROADWAY SLAB & FENCES  
Scales as noted

NOTE:  
The thickness of the asphalt deck varies from 3 1/2" to 4 inches.  
(As per letter Nov. 19 1962 from District Engr. W. M. Sproul)


GOVT. OF BRITISH COLUMBIA  
DEPT. OF PUBLIC WORKS  
VICTORIA.

Made by C.K.S. Aug 1965  
Checked by L.S. Sep 65


DRAWING NO. 1187-4  
Chief Engineer

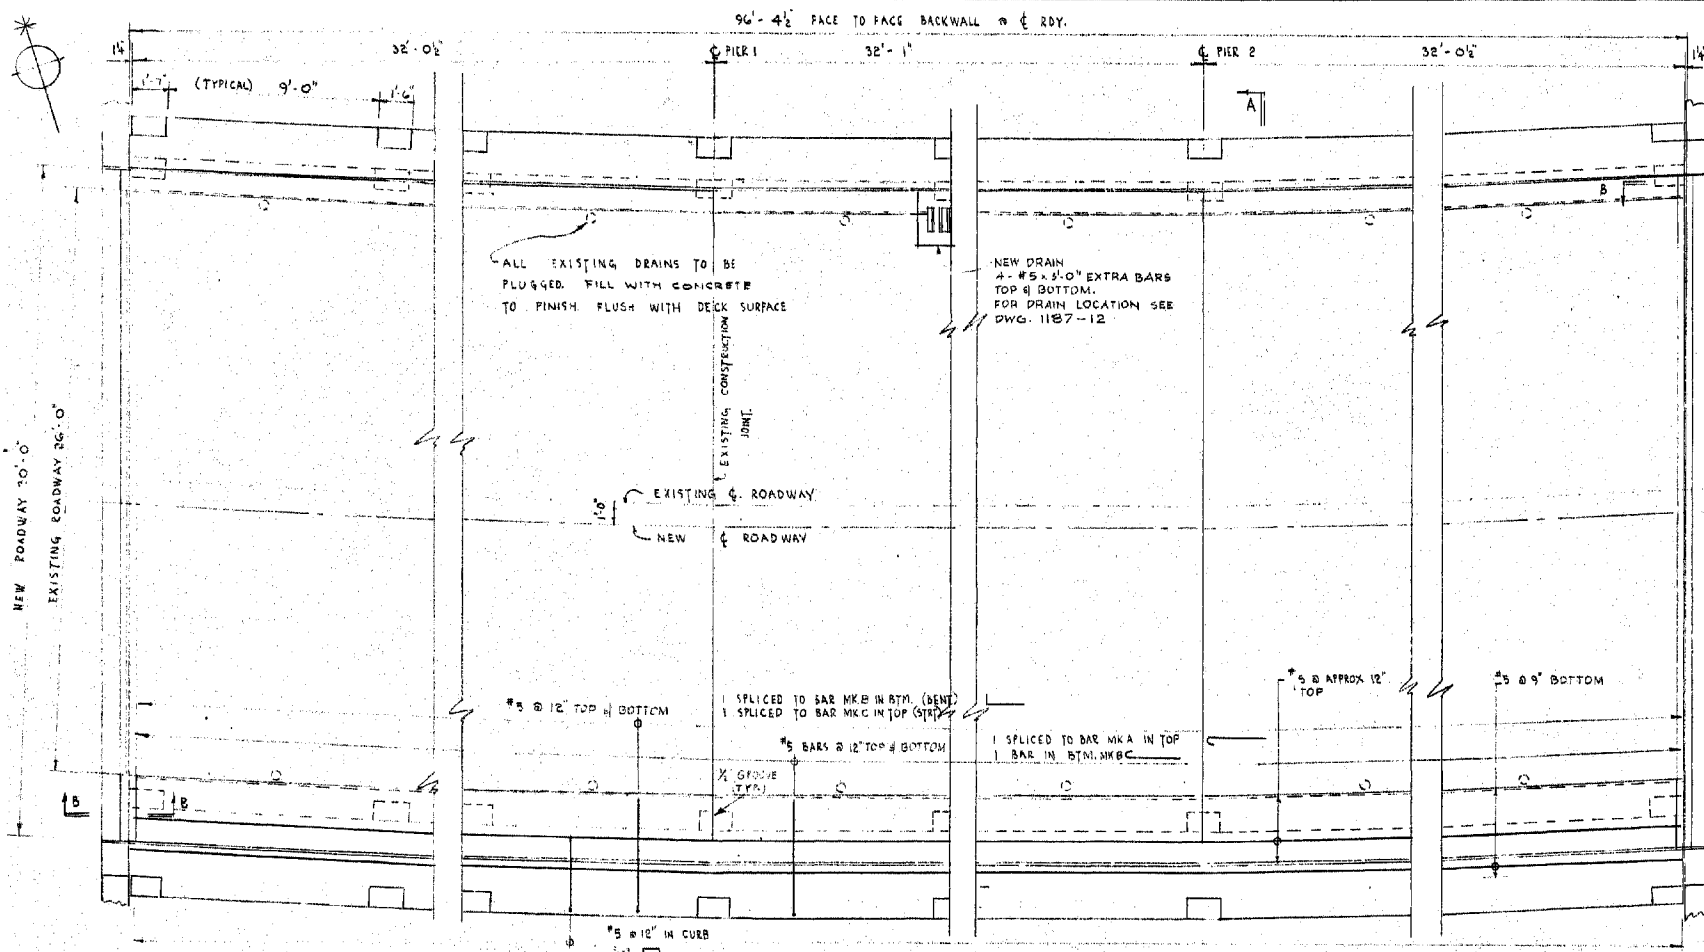

PART PLAN

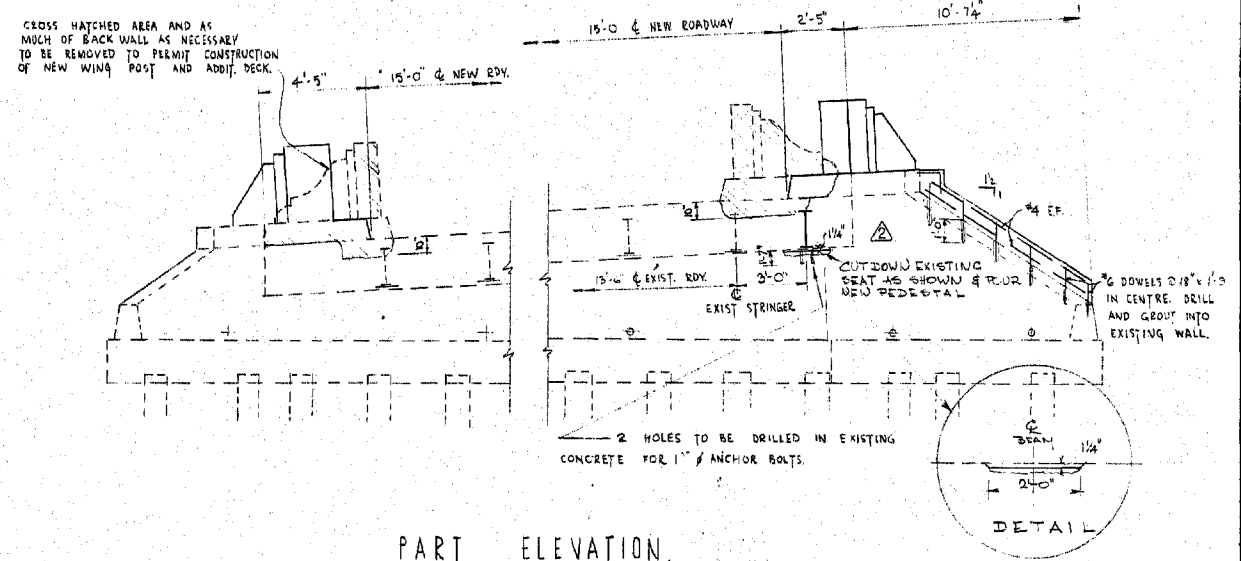


PART ELEVATION

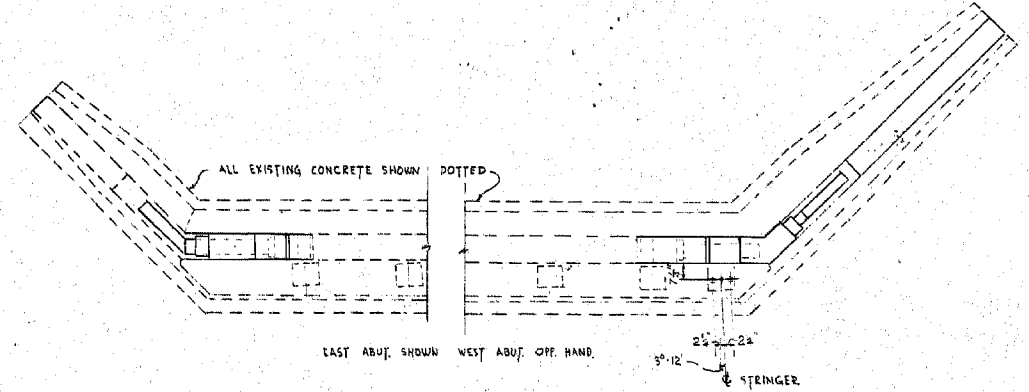


PART PLAN - ABUTMENTS




WELD DETAIL

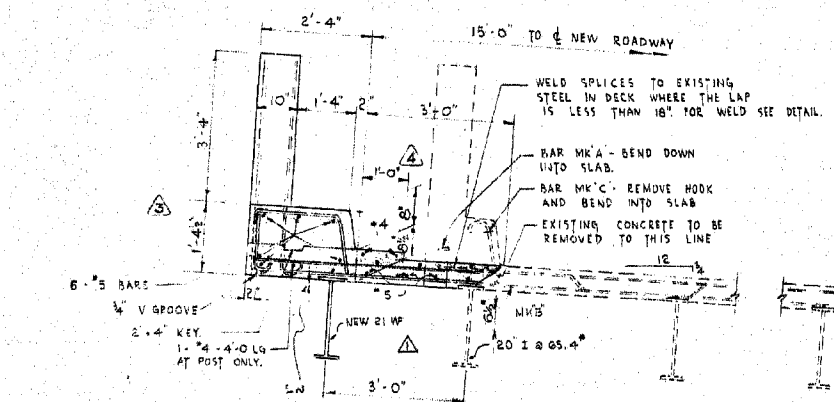

SECTION A-A

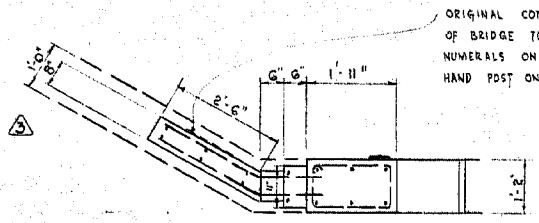


DETAIL OF WING POST

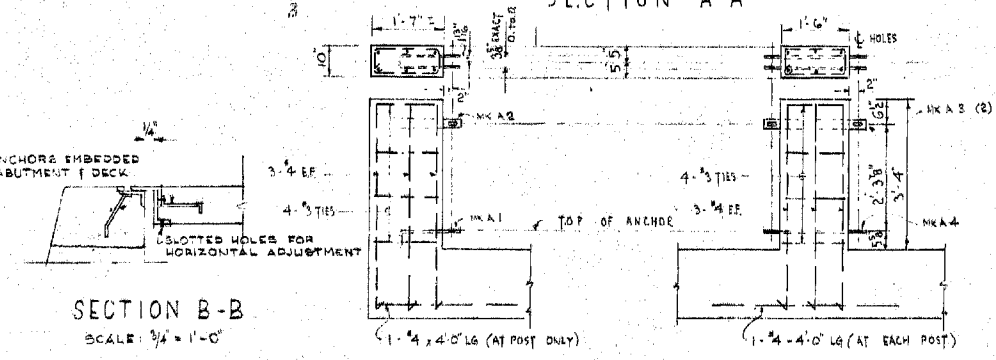

SECTION B-B

END POST

INTERMEDIATE POST

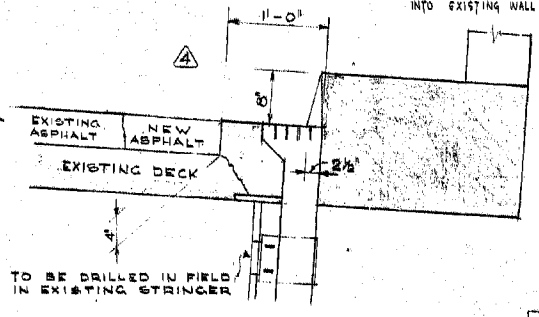

DETAIL AT DRAIN

- NOTES
- 1) FOR GENERAL NOTES SEE DWG. 1187-12
  - 2) DECK CONCRETE TO BE LIGHT WEIGHT
  - 3) EXISTING EXTERIOR STRINGERS TO BE PROBED AT MIDSPANS (WHILE SLAB IS CURRING) AS CALLED FOR IN THE SPECIFICATIONS SO THAT NO LIVE LOAD DEFLECTION WILL OCCUR.
  - 4) ALL EXISTING REINFORCING BARS INCORPORATED INTO NEW CONCRETE TO BE CLEANED OF OLD CONCRETE AND DIRT.
  - 5) FOR DETAILS OF ANCHOR BOLTS SEE DWG. NO. 1187-15

AS BUILT

APPROXIMATE QUANTITIES

	CONCRETE	REINFORCING	FORMWORK
ABUTMENTS	4 CU YD	1,200 LBS	300 SQ. FT.
DECK (LUMP SUM)	25 CU YD	6,000 LBS	1500 SQ. FT.

FENCO  
FOUNDATION OF CANADA  
ENGINEERING CORPORATION  
LIMITED

BRITISH COLUMBIA DEPARTMENT OF HIGHWAYS  
BRIDGE ENGINEER'S OFFICE


SALMON ARM DISTRICT  
TRANS-CANADA HIGHWAY  
SALMON RIVER BRIDGE IMPROVEMENTS  
CONCRETE DETAILS

No. 2456-9J-2


REV.	NO.	DATE	DESCRIPTION
D	1	MAY 28 1964	CURB HEIGHTS REVISED FOR 6\"/>
C	1	MAY 28 1964	CURB HEIGHTS REVERSED DRAIN DETAIL REVISED
B	1	MAY 28 1964	BEAM SEAT DETAIL REVISED
A	1	MAY 28 1964	REINFORCING REVISED

DESIGN	MAY 21 1964	SCALE: 1/4" = 1'-0" & AS NOTED
DRAWN	MAY 21 1964	APPROVED: [Signature]
CHECKED	MAY 21 1964	DRAWING No. 1187-13 D




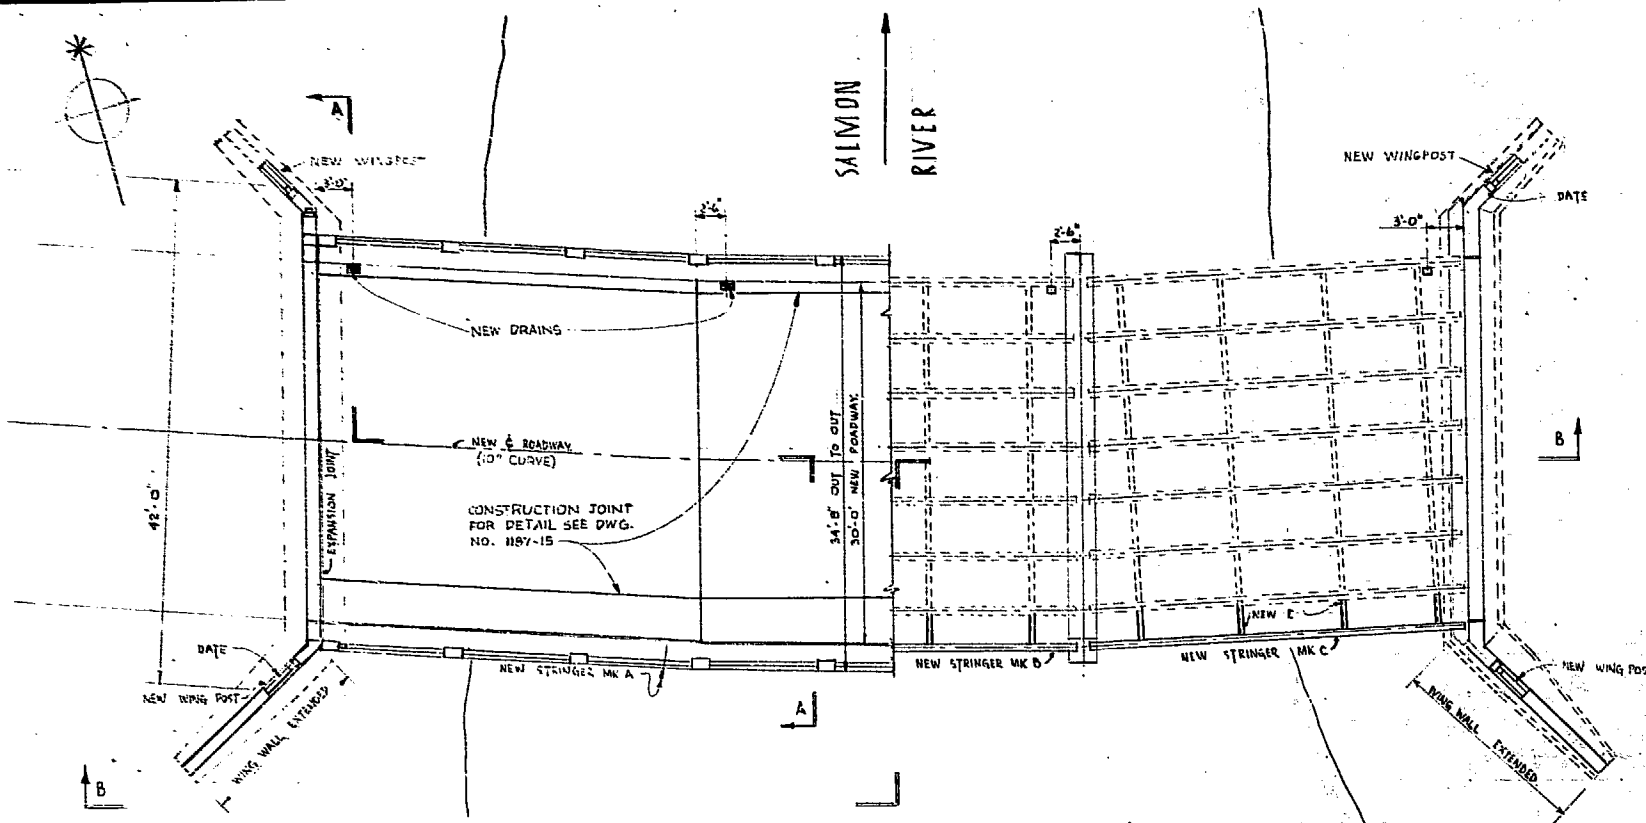


PLAN

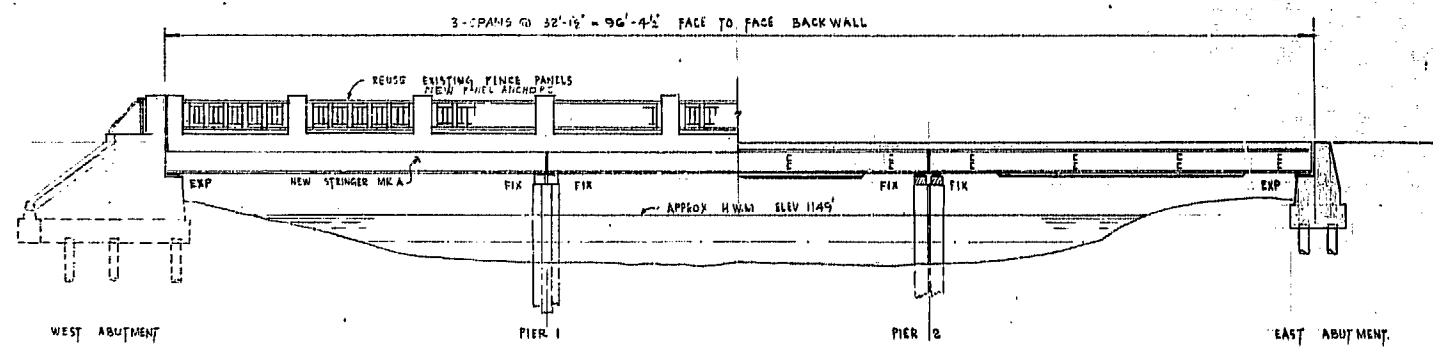

VIEW B-B

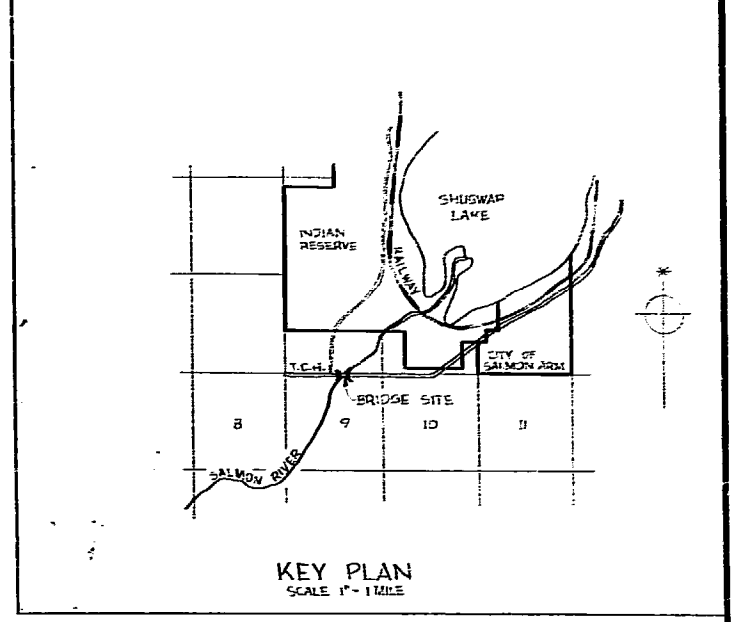

KEY PLAN  
SCALE 1" = 1 MILE

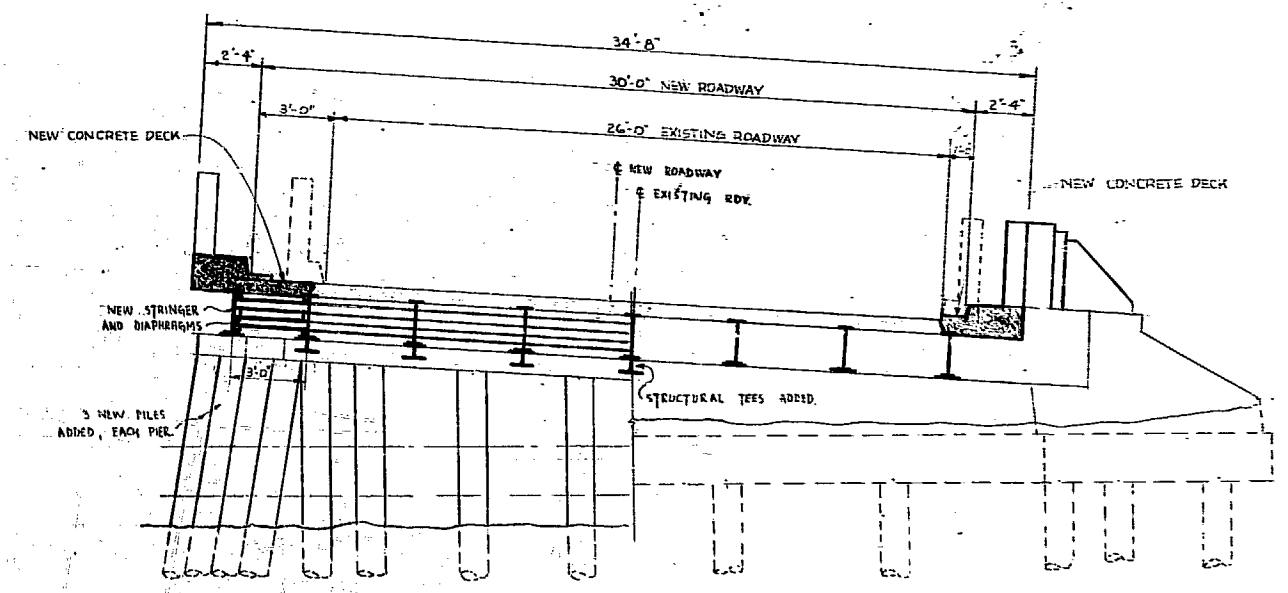

SECTION A-A  
SCALE 3/4" = 1'-0"

AS BUILT

GENERAL NOTES:

DESIGN SPECIFICATION:

SPECIFICATION FOR HIGHWAY BRIDGES (B.C. DEPARTMENT OF HIGHWAYS)  
LIVE LOAD 425 - 520;


CONCRETE:

- 1) CAST IN PLACE CONCRETE TO HAVE A MINIMUM CYLINDER CRUSHING STRENGTH AT 28 DAYS OF 3000 PSI. (CLASS A EXCEPT AS NOTED).
- 2) REINFORCING BARS TO BE BILLET STEEL INTERMEDIATE GRADE DEFORMED BARS CONFORMING TO C.S.A. SPECIFICATIONS G30-1954.
- 3) ALL EXPOSED CONCRETE EDGES TO BE CHAMFERED 1/4".
- 4) UNLESS SHOWN OTHERWISE, ALL REINFORCING STEEL TO HAVE A MINIMUM CLEAR CONCRETE COVER OF:
  - 1" - FOR CURBS, FENCE POSTS, AND SLABS;
  - 3" - FOR CONCRETE POURED IN DIRECT CONTACT WITH SOIL;
  - 2" - FOR ALL OTHERS.
- 5) MINIMUM LENGTH OF LAP FOR REINFORCING BAR SPLICES SHALL BE 24 BAR DIAMETERS.
- 6) ALL DIMENSIONS IN CONNECTION WITH THE EXISTING STRUCTURE SHALL BE VERIFIED BEFORE CONSTRUCTION.


STRUCTURAL STEEL:

- 1) ALL NEW STEELWORK, EXCEPT EXPANSION JOINTS, SHALL BE FABRICATED FROM STRUCTURAL CARBON STEEL COMPLYING WITH THE REQUIREMENTS OF ASTM SPECS. A36-G17.
- 2) EXPANSION JOINT MEMBERS SHALL BE FABRICATED FROM STRUCTURAL CARBON STEEL COMPLYING WITH THE REQUIREMENTS OF ASTM SPECS. A7-G17 OR A36-G17.
- 3) ALL WELDING SHALL COMPLY WITH THE REQUIREMENTS OF C.S.A. SPECIFICATIONS W 59 LATEST EDITION.
- 4) HIGH TENSILE BOLTS SHALL COMPLY WITH THE REQUIREMENTS OF ASTM SPECS. A325-G17.
- 5) THE PAINTING OF STEELWORK SHALL BE IN ACCORDANCE WITH THE REQUIREMENTS OF THE FOLLOWING SECTIONS OF THE 'GENERAL SPECIFICATIONS FOR HIGHWAY CONSTRUCTION OF THE B.C. DEPARTMENT OF HIGHWAYS':
  - SECTION 216 - STEEL BRIDGES - SURFACE PREPARING AND SHOP PAINTING;
  - SECTION 217 - FIELD PAINTING - STEEL BRIDGES (NEW STRUCTURES).
- 6) ALL DIMENSIONS IN CONNECTION WITH THE EXISTING STEELWORK TO BE VERIFIED BEFORE FABRICATION, CONSTRUCTION, AND ERECTION.



<b>FINCO</b>		<b>BRITISH COLUMBIA DEPARTMENT OF HIGHWAYS BRIDGE ENGINEER'S OFFICE</b>	
<b>FOUNDATION OF CANADA ENGINEERING CORPORATION LIMITED</b>		<b>SALMON ARM DISTRICT TRANS - CANADA HIGHWAY SALMON RIVER BRIDGE IMPROVEMENTS</b>	
No. 2456-9J-1		REV. NO. 1	
D		DESIGN	
C		DRAWN	
B		CHECKED	
A		AS BUILT	
REVISIONS		SCALE: 3/4" = 1'-0" & AS NOTED	
APPROVED: <i>[Signature]</i>		DRAWING No. 1187-12 A	

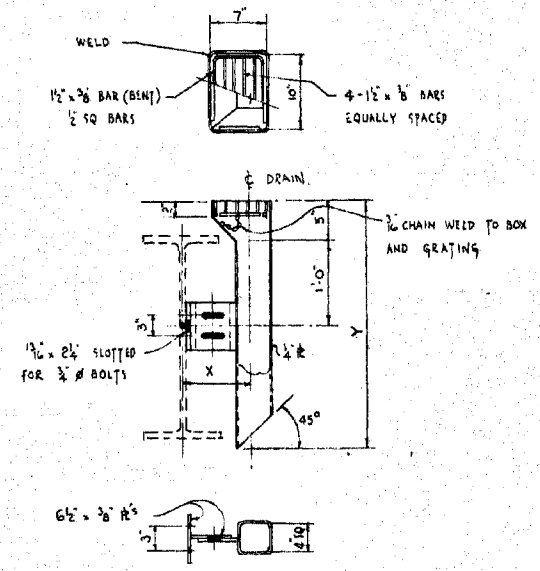


GALVANIZED AFTER FABRICATION  
SCALE: 1" = 1'-0"  
**DRAINS**

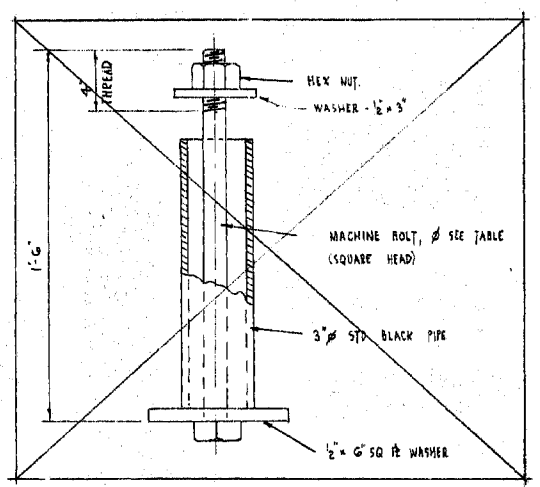


**ANCHOR BOLTS**

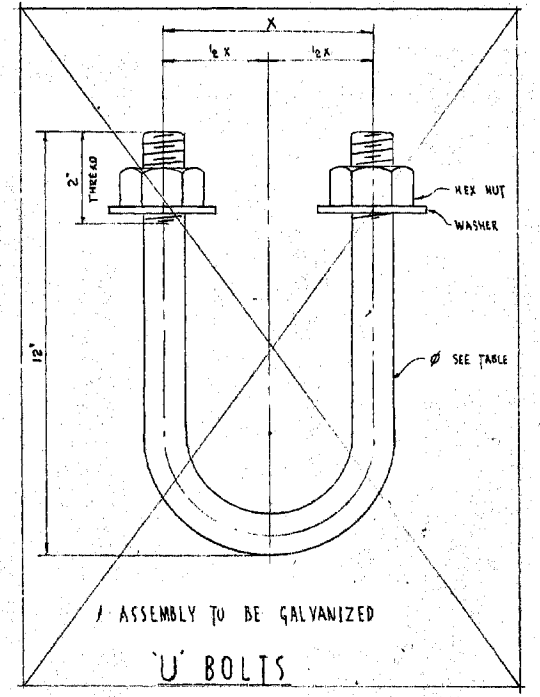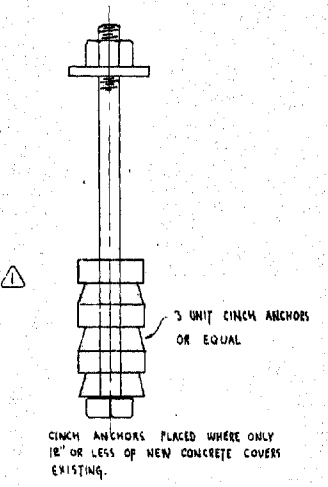


**U BOLTS**

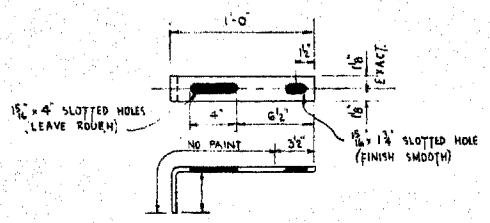


**ANCHOR MK A1**

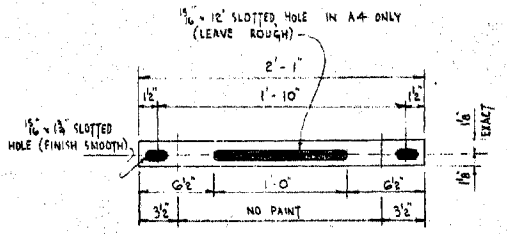


**ANCHOR MK A3 & A4**

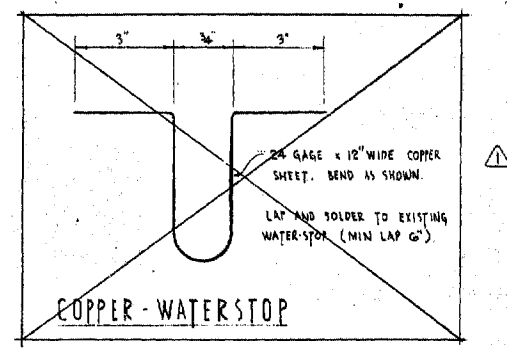

**COPPER - WATERSTOP**

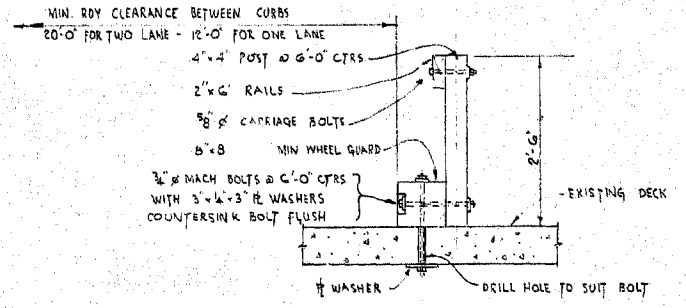


**TEMPORARY FENCE DETAIL**  
SCALE: 3/4" = 1'-0"

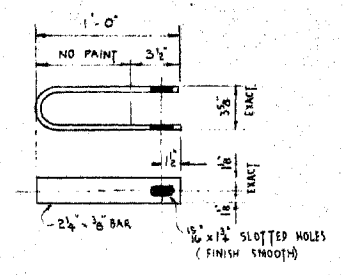

**ANCHOR MK A2**

**FENCE PANEL ANCHORS**  
SCALE: 1/2" = 1'-0"


SAW STRAIGHT EDGE IN EXISTING CONCRETE BEFORE DEMOLISHING ADJACENT EXISTING CONCRETE. CONCRETE TO ACHIEVE A NEAT STRAIGHT LINE. CARE TO BE TAKEN NOT TO DAMAGE EXIST. REINFORCEMENT.

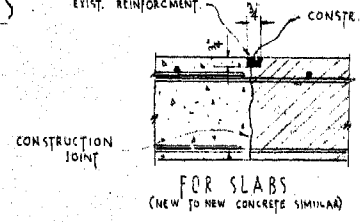

ALL CHAMFERS TO BE STRAIGHT. EXISTING CONCRETE TO BE CUT TO A NEAT LINE FREE FROM BROKEN EDGES.



**CONSTRUCTION JOINT DETAILS**

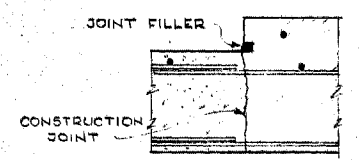








**FOR NORTH SIDE ONLY**  
SEE NOTE FOR CONSTRUCTION JOINT DETAILS

NOTES  
FOR GENERAL NOTES SEE DWG. NO. 1187-12  
ALL STRUCTURAL STEEL SHALL BE MEDIUM STRUCTURAL STEEL CONFORMING TO CANADIAN STANDARDS ASSOCIATION SPECIFICATION G 40.4

TABLE OF DIMENSIONS & QUANTITIES												
DRAINS			ANCHOR BOLTS		WATER STOP	U BOLTS		FENCE PANEL ANCHORS				
NUMBER REQ'D	DIM. X	DIM. Y	NUMBER REQ'D	BOLT Ø	LIN. FEET	*REQ'D	DIM. X	Ø	MK A1	MK A2	MK A3	MK A4
4	6"	2'-6"	4	1"	—	—	—	—	4	4	32	16

**AS BUILT**

<b>FENCO</b> <b>FOUNDATION OF CANADA</b> <b>ENGINEERING CORPORATION</b> <b>LIMITED</b>		<b>BRITISH COLUMBIA DEPARTMENT OF HIGHWAYS</b> <b>BRIDGE ENGINEER'S OFFICE</b>	
<b>No. 2456-9J-4</b>		<b>SALMON ARM DISTRICT</b> <b>TRANS-CANADA HIGHWAY</b> <b>SALMON RIVER BRIDGE IMPROVEMENTS</b>	
<b>MISCELLANEOUS DETAILS</b>		<b>SCALE: AS NOTED</b>	
<b>D</b> <b>C</b> <b>B</b> AS BUILT <b>A</b> ANCHOR BOLT & WATER STOP REVISED	REV. No. (2) JULY 6 1964 MAY 20 1964	DESIGN DRAWN CHECKED	APPROVED: CHIEF ENGINEER <b>1187-15</b>
<b>REVISIONS</b>		CANCEL PRINTS BEARING EARLIER LETTER.	




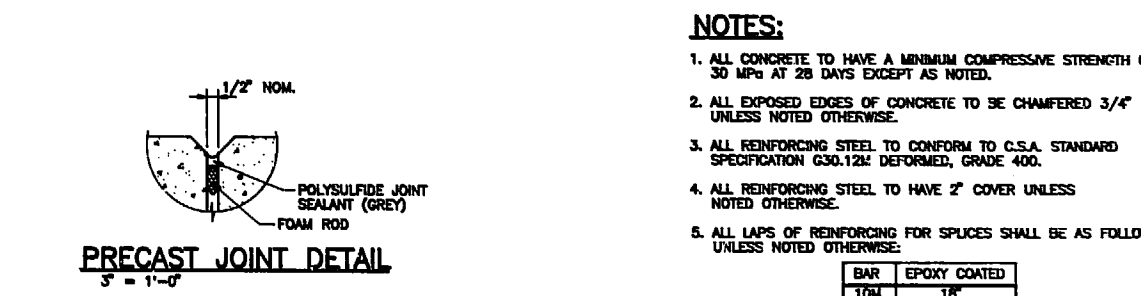
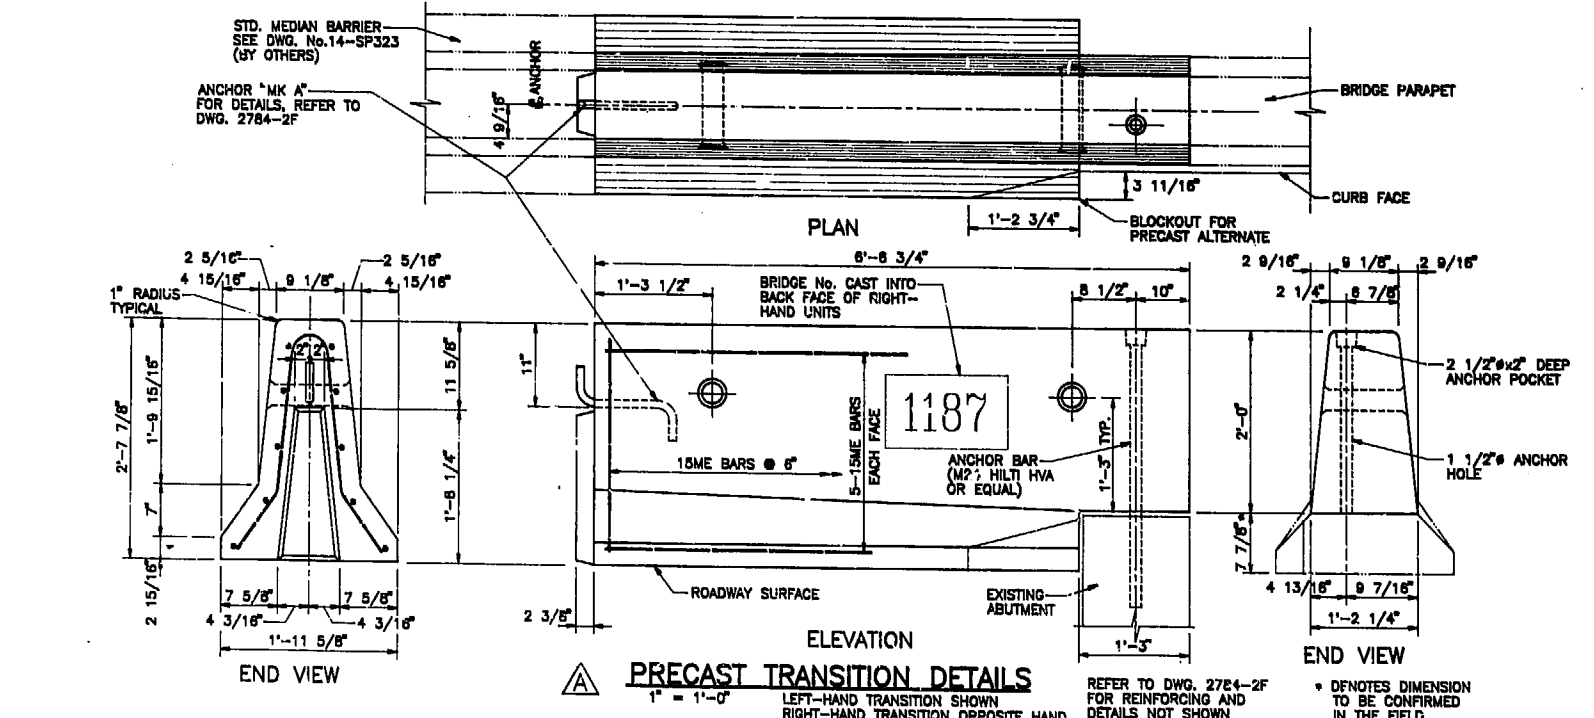
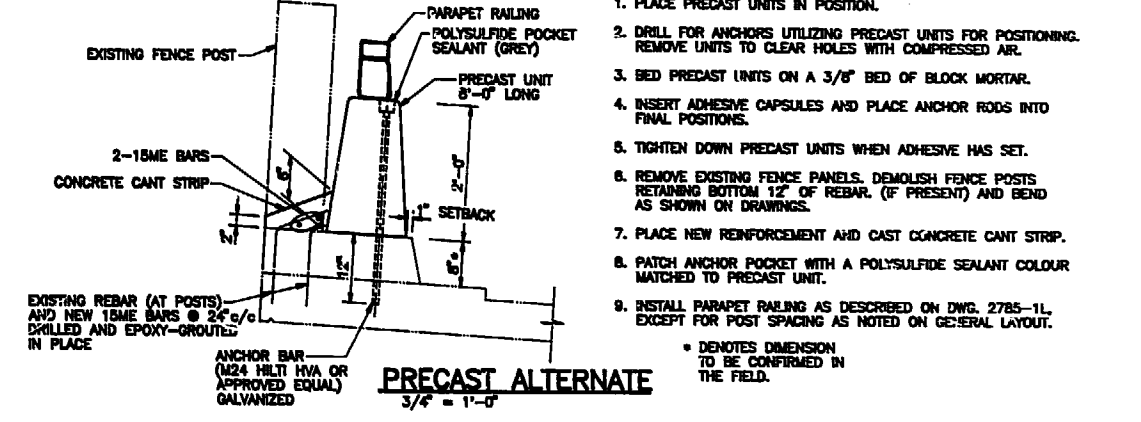
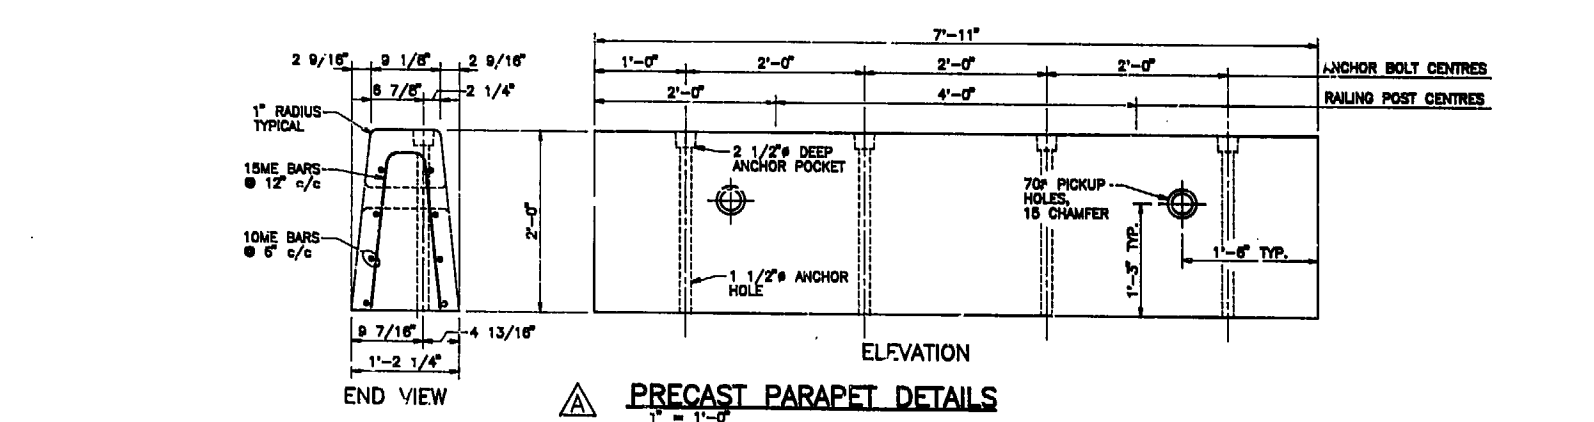
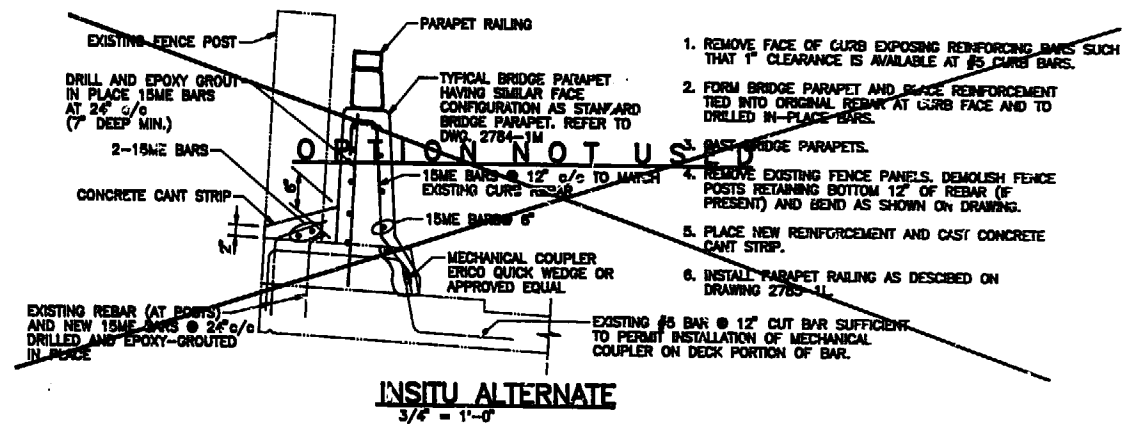
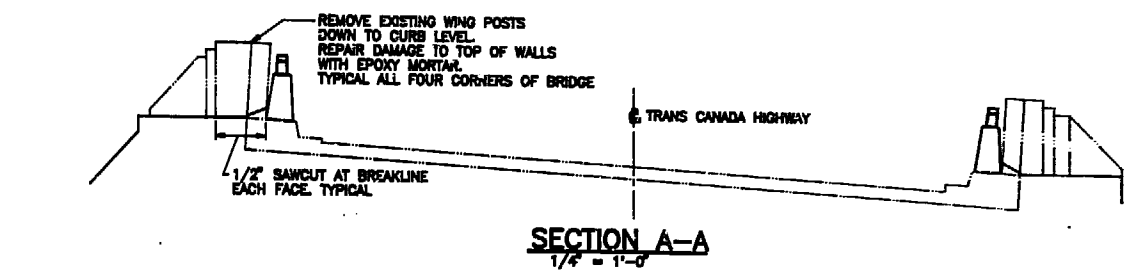
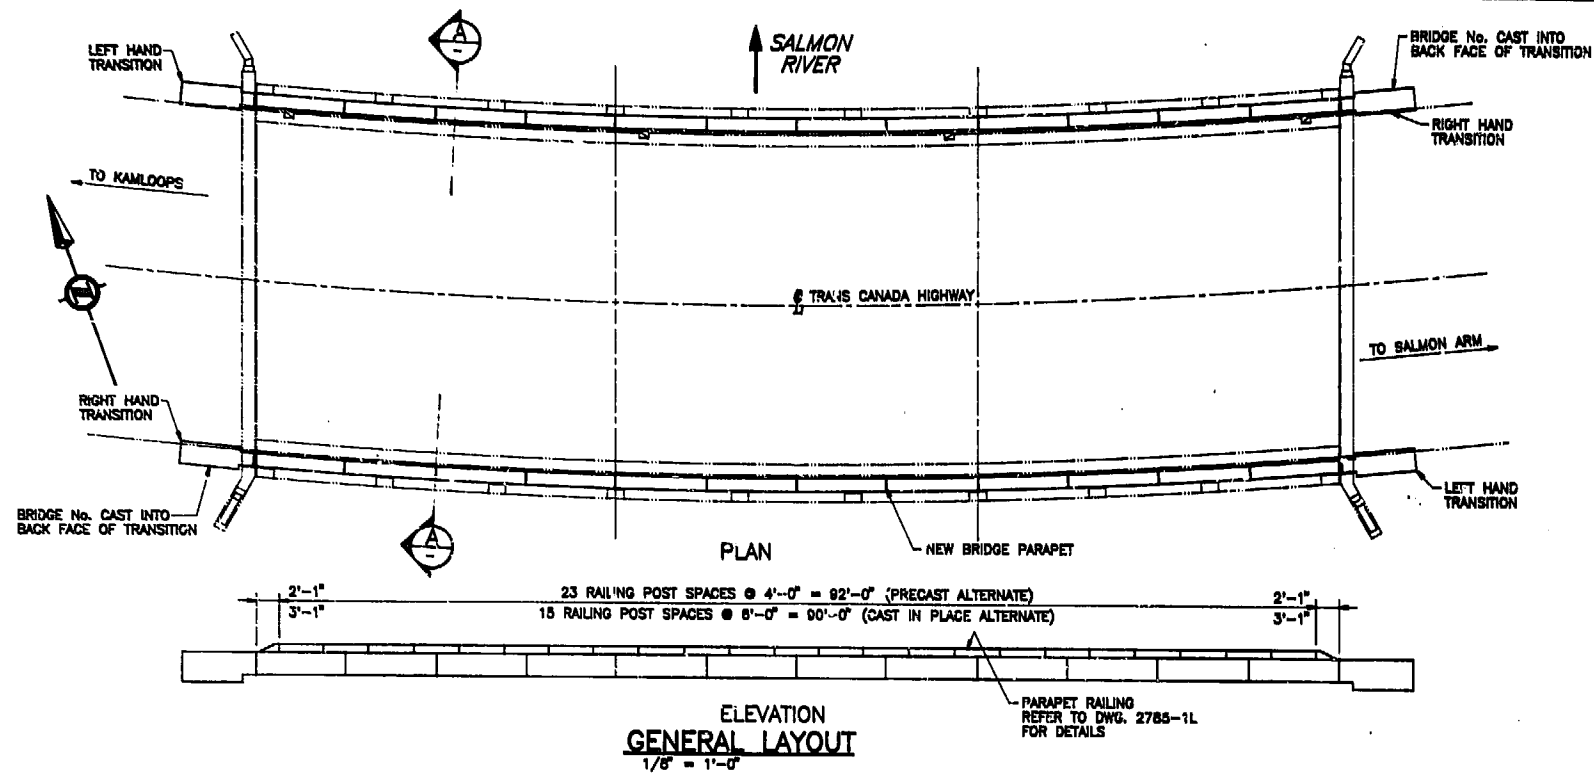


- NOTES:**
1. ALL CONCRETE TO HAVE A MINIMUM COMPRESSIVE STRENGTH OF 30 MPa AT 28 DAYS EXCEPT AS NOTED.
  2. ALL EXPOSED EDGES OF CONCRETE TO BE CHAMFERED 3/4" UNLESS NOTED OTHERWISE.
  3. ALL REINFORCING STEEL TO CONFORM TO C.S.A. STANDARD SPECIFICATION G30.12#2 DEFORMED, GRADE 400.
  4. ALL REINFORCING STEEL TO HAVE 2" COVER UNLESS NOTED OTHERWISE.
  5. ALL LAPS OF REINFORCING FOR SPICES SHALL BE AS FOLLOWS UNLESS NOTED OTHERWISE:
- | BAR | EPOXY COATED |
|-----|--------------|
| 10M | 18"          |
| 15M | 27"          |
6. MECHANICAL COUPLERS SHALL DEVELOP AT LEAST 125% OF THE SPECIFIED YIELD STRENGTH OF THE BAR.

**AS BUILT**

<b>McCall Engineering Ltd.</b> Consulting Civil and Structural Engineers 1547 Montrose Avenue, Victoria, B.C. V8R 5V3 Tel: (604) 598-4003				
DESIGNED J.G.McC. DATE 93-02	CHECKED J.G.McC. DATE 93-02			
SCALE AS NOTED	DATE 93-02			
Rev	Date	Description	INT	DRW
A	94-01-31	AS-BUILT		
REVISIONS				

Province of British Columbia MINISTRY OF TRANSPORTATION AND HIGHWAYS BRIDGE ENGINEERING BRANCH	
368338 JKANAGAN - SHUSWAP DISTRICT TRANS CANADA HIGHWAY	
<b>SALMON RIVER BRIDGE PARAPETS AND TRANSITIONS</b>	
PREPARED BY ORIGINAL SIGNED BY J.G.McCALL, P.Eng.	RECOMMENDED ORIGINAL SIGNED BY K.W.HO, P.Eng. DIRECTOR OF BRIDGE ENGINEERING
DATE 93-02-05	DATE 93-02-08
FILE NO.	NEGATIVE NO.
ACCEPTED FOR CONSTRUCTION ORIGINAL SIGNED FOR E.A.LIND, P.Eng. CHIEF BRIDGE ENGINEER DATE 93-02-10	
2 1187-17 A	

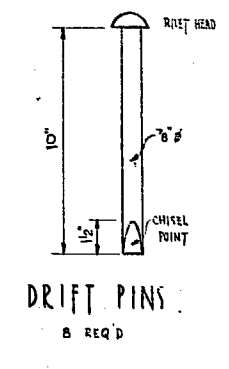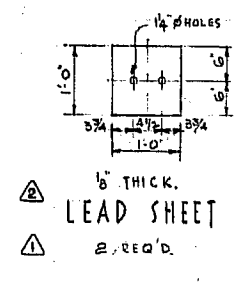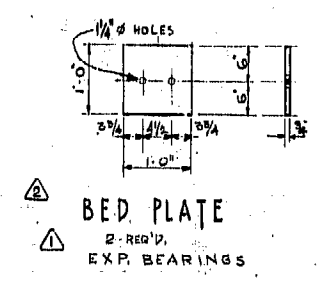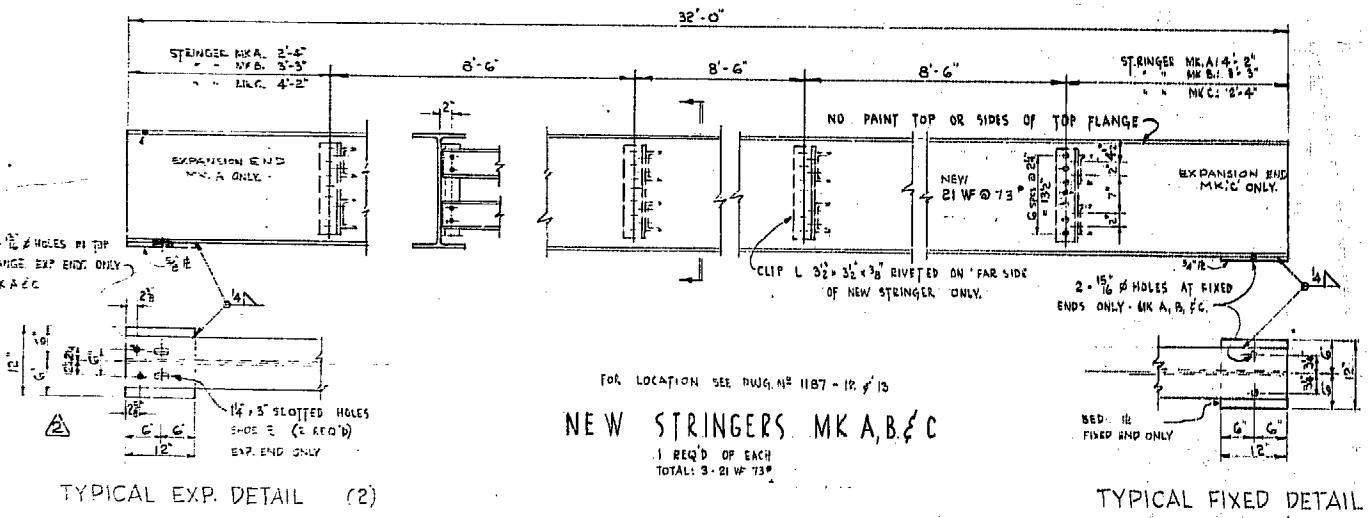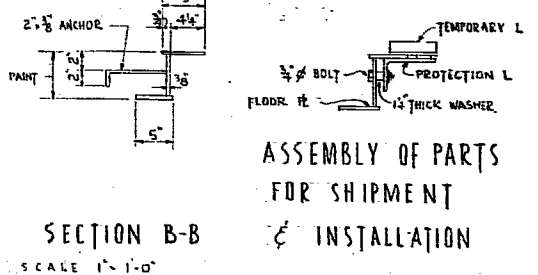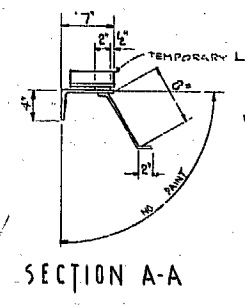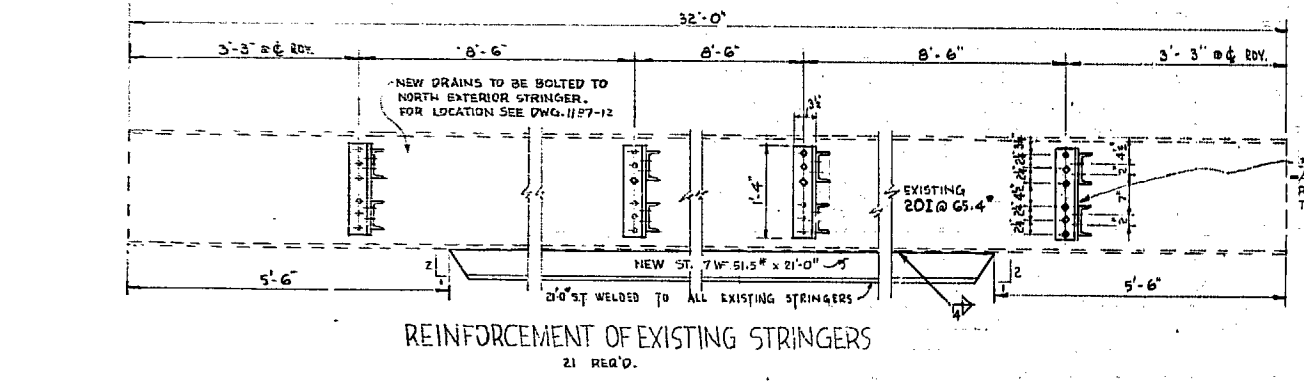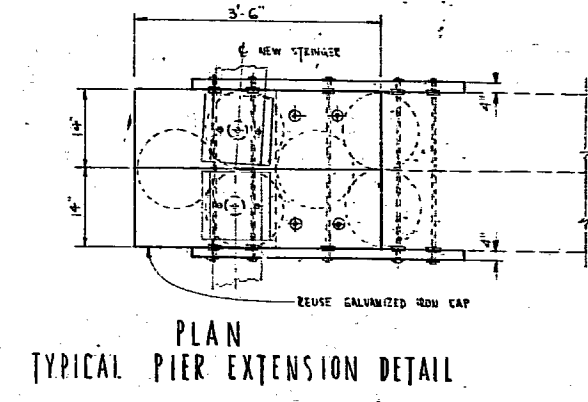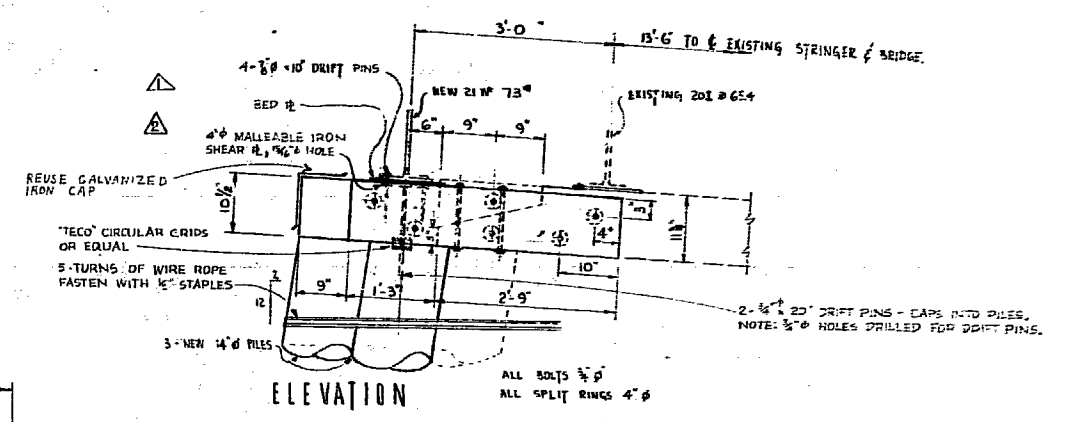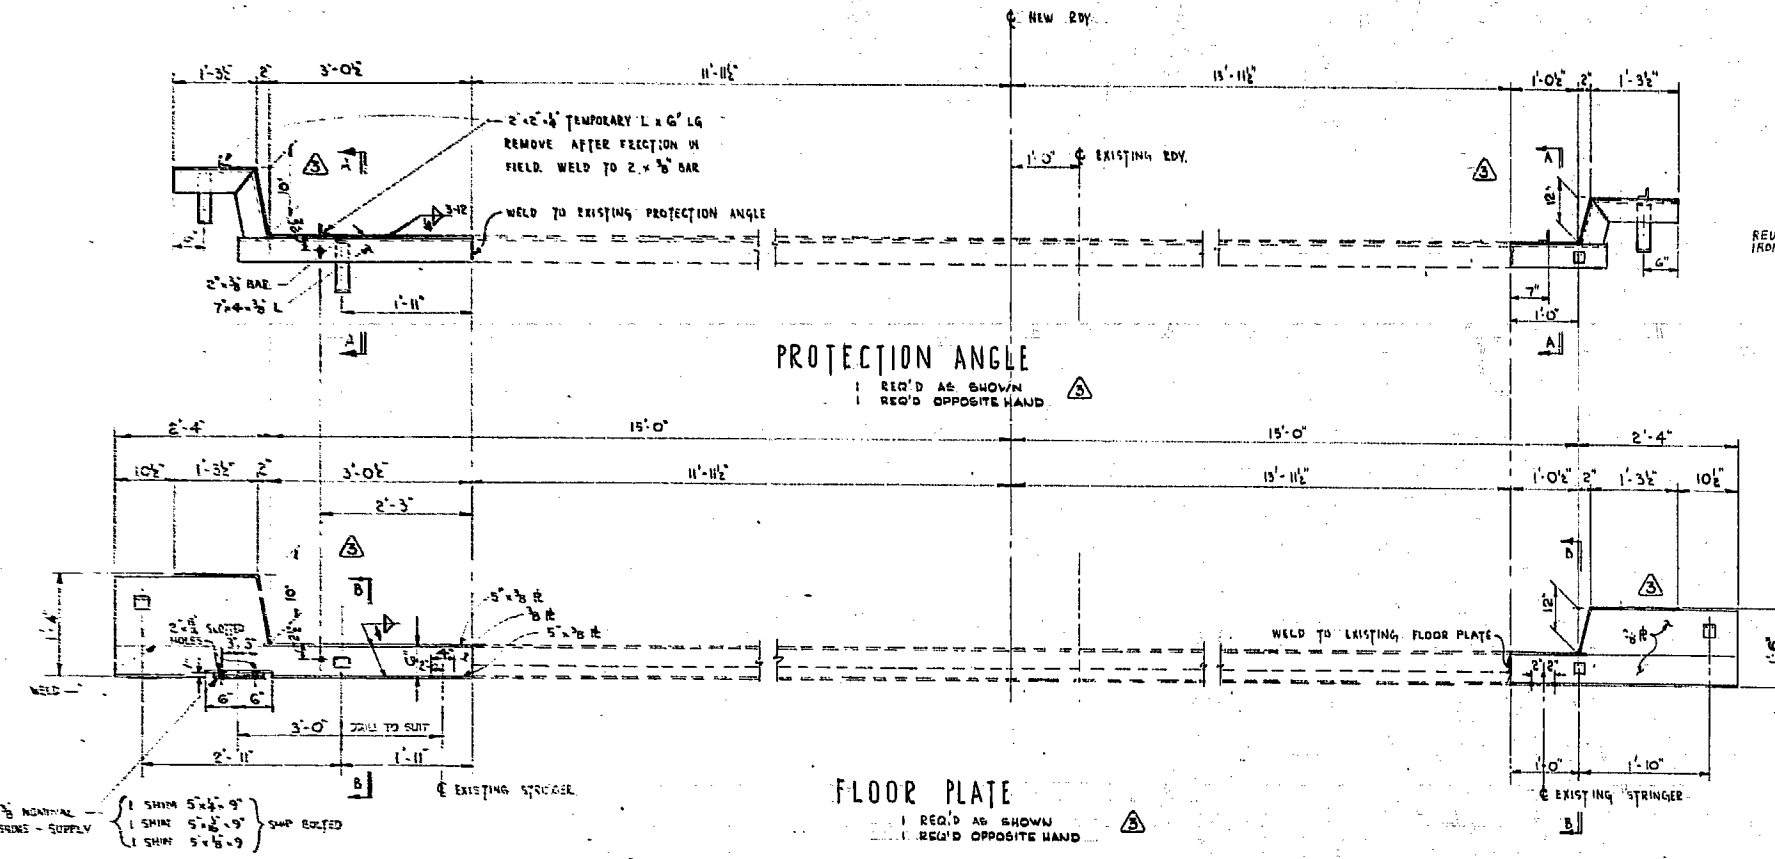


NOTES:  
 1) FOR GENERAL NOTES SEE DWG. 1187-12  
 2) FOR DRAINS, ANCHOR BOLTS AND TEMPORARY FENCE DETAILS, AND FENCE PANEL ANCHORS, SEE DWG. 1187-15  
 3) FOR GRADE AND TREATMENT OF TIMBER SEE SPECIFICATIONS

APPROX. QUANTITIES  
 STRUCTURAL STEEL  
 1. SUPPLY - FABRICATE & ERECT 2,500 LBS  
 2. FABRICATE & ERECT 31,500 LBS

AS BUILT


TYPICAL EXP. DETAIL (2)

TYPICAL FIXED DETAIL (4)


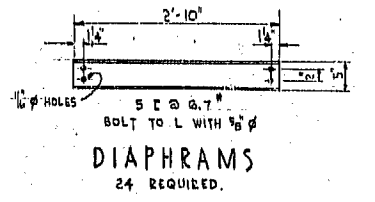


<b>FENCO</b> <b>FOUNDATION OF CANADA</b> <b>ENGINEERING CORPORATION</b> <b>LIMITED</b>		<b>BRITISH COLUMBIA DEPARTMENT OF HIGHWAYS</b> <b>BRIDGE ENGINEER'S OFFICE</b>	
<b>No. 2456-9J-3</b>		<b>SALMON ARM DISTRICT</b> <b>TRANS-CANADA HIGHWAY</b> <b>SALMON RIVER BRIDGE IMPROVEMENTS</b> <b>PIER EXTENSION &amp; STEELWORK DETAILS</b>	
<b>D</b> AS BUILT <b>C</b> CURB HEIGHTS REVERSED <b>B</b> PIER CAP BEYOND REVISED <b>A</b> BEARINGS REVISED	<b>REVISIONS</b>	<b>DESIGN</b> JUN 9 63 <b>DRAWN</b> JUN 17 63 <b>CHECKED</b> JUN 17 63	<b>SCALE:</b> 3/4" = 1'-0" AND AS NOTED. <b>APPROVED:</b> [Signature] <b>DRAWING No.</b> 1187-14




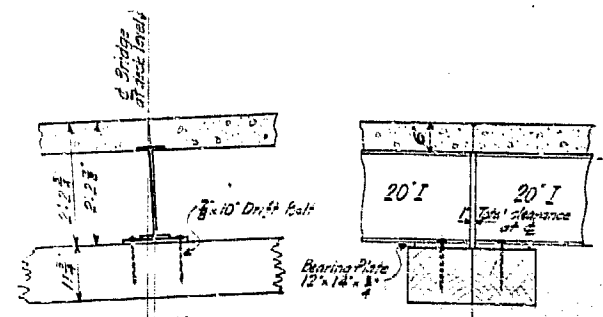

Detail showing position of plates etc. at Pier No 2  
Pier No 1 similar except as shown otherwise

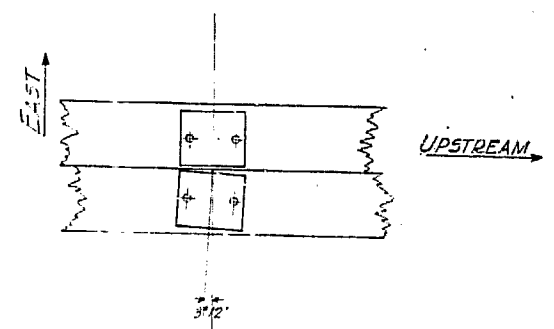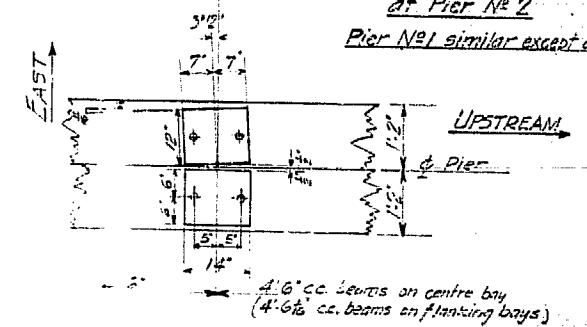


Showing Bearing Plates in position at Pier No 1

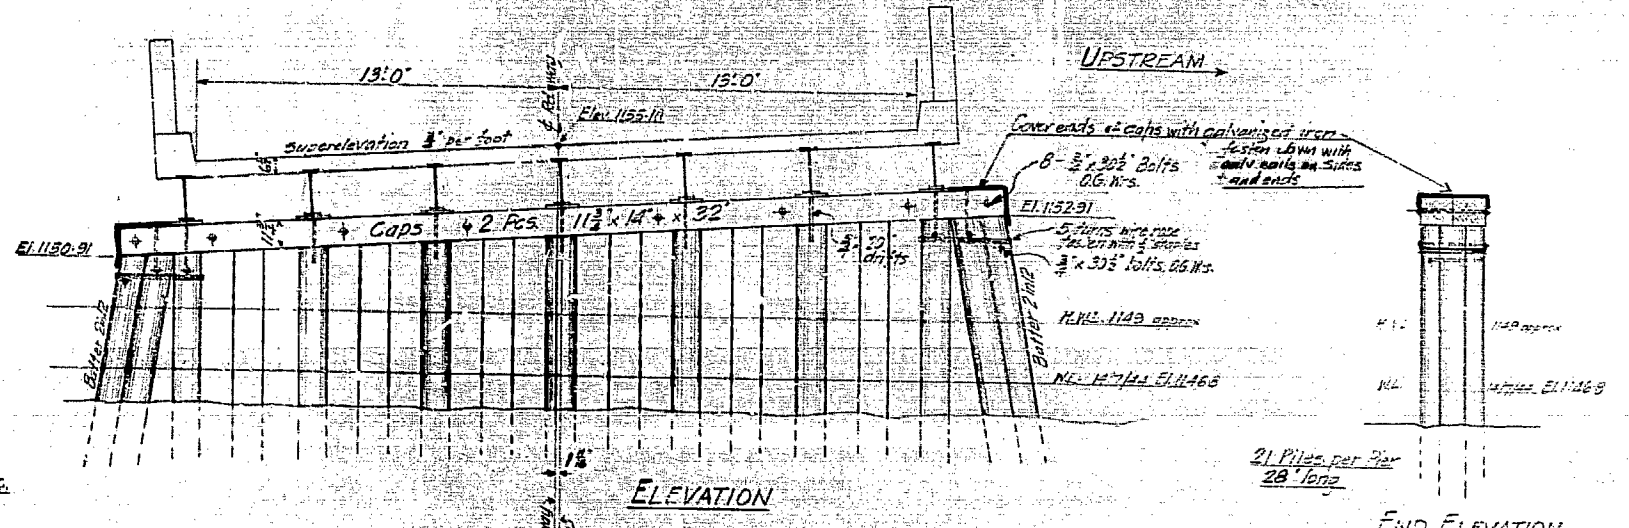


ELEVATION

END ELEVATION

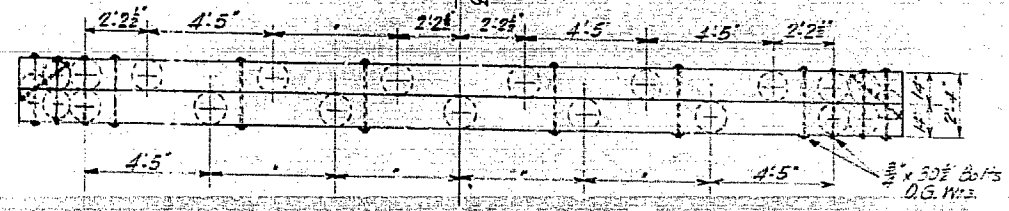

PLAN

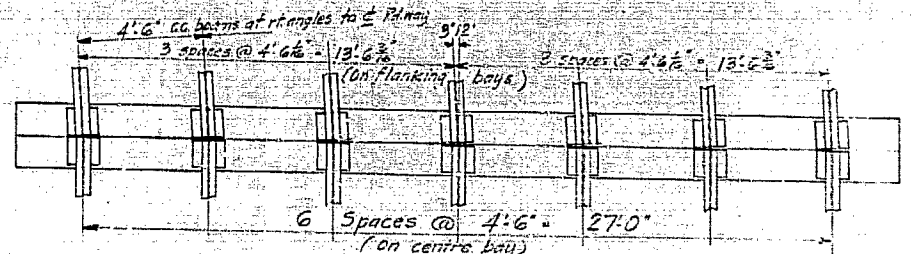

PLAN SHOWING BEAMS  
(See Detail)

PIER No 2  
(Pier No 1 similar except for position of bearing plates)


Piles and caps to be constructed in situ. In situ to be thoroughly encased with concrete. All joints of piles to be encased with concrete and then plastered with fibreglass. Fibreglass to be applied on the ends of the I-beams as in position. Spreads over the fibreglass and press down into the compound. Cover ends of caps with galv. iron.

SALMON ARM DISTRICT  
TRANS-CANADA HIGHWAY  
BRIDGE OVER SALMON RIVER  
AT SALMON ARM  
PIERS  
Scale - 3/8" = 1'-0" Details 3/4" = 1'-0"


GOVT. OF BRITISH COLUMBIA DEPT. OF PUBLIC WORKS VICTORIA.	
Made by GCS: Aug 1945	DRAWING NO. 1157
Checked by	CHIEF ENGINEER
17353	-6

11870


11870

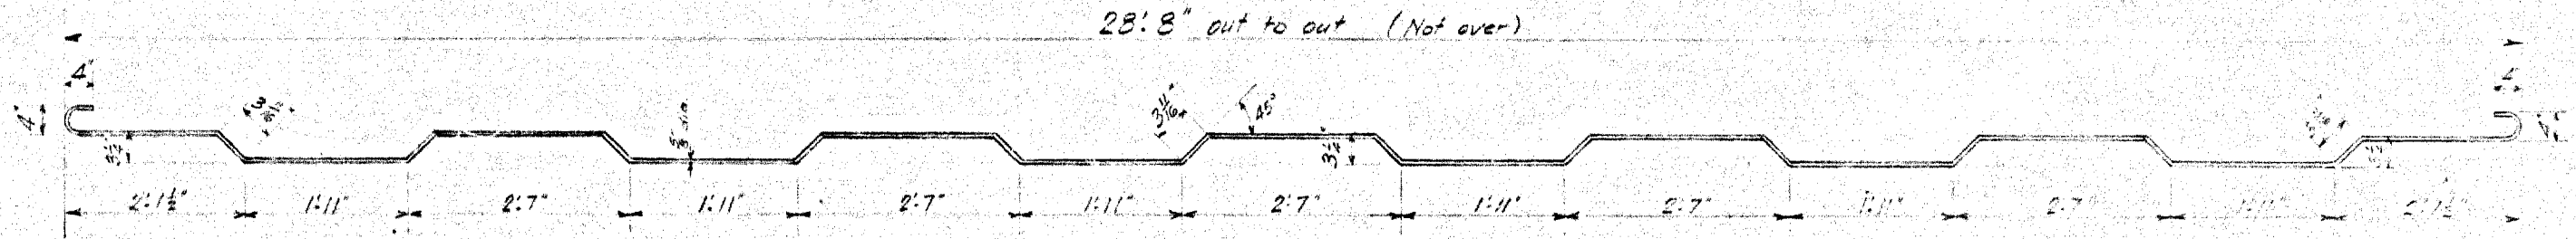

5/8" dia. bar - Mark A - 95 Required - Gross Length before bending - 30'-0 1/2"

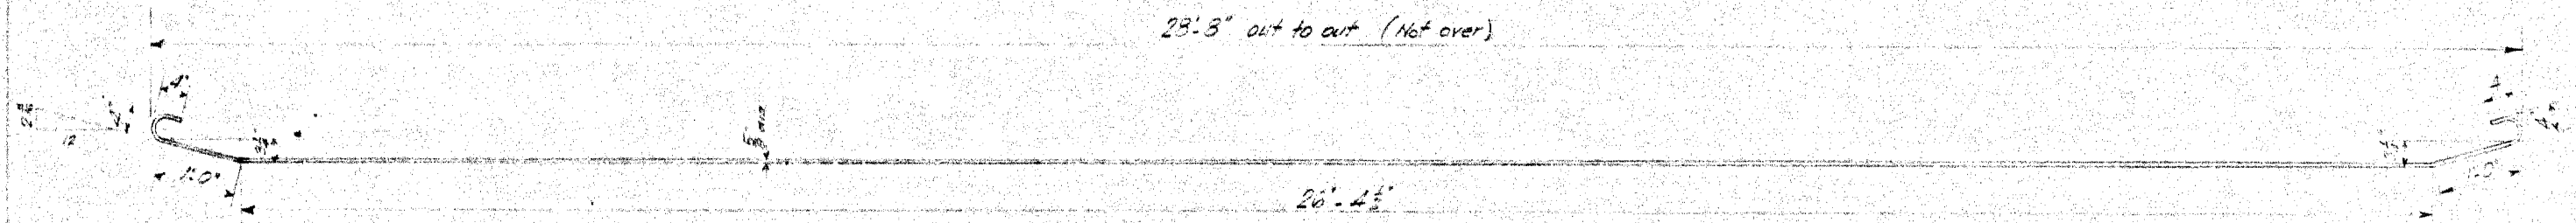

5/8" dia. bar Mark B - 96 Required - Gross length before bending 29'-9 1/2"

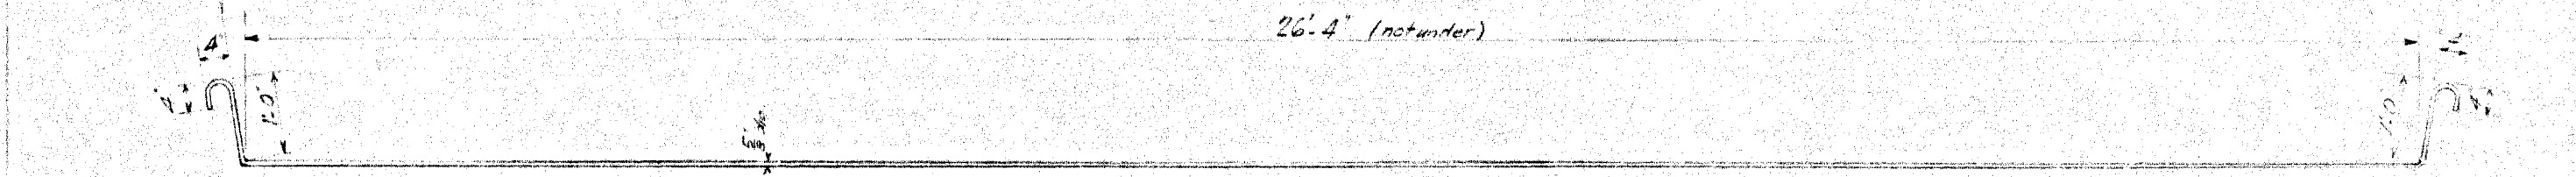

5/8" dia. bar Mark C - 96 Required - Gross length before bending 29'-4"

BAR LIST

Location	No. Req'd	Diam.	Gross Length	Mark	Total No. lbs	Remarks
Floor Slab	95	5/8"	30'-0 1/2"	A	2976	See as shown
"	96	5/8"	29'-9 1/2"	B	2977	"
"	96	5/8"	29'-4"	C	2938	"
Curb	8	5/8"	15'-0"		224	straight
"	5	5/8"	34'-0"		284	"
"	5	5/8"	39'-0"		318	"
Fence Posts on span	120	3/8"	4'-0"		501	"
Balloon Wall	52	3/8"	4'-0"		212	"
Base of Abutments	-	3/8"	1000 Lin. Ft. <sup>Stock Lengths</sup>		1576	"
Floor Slab	-	1/2"	4200 "		2806	"
End Posts	-	1/2"	450 "		301	"
			No. 15 gauge annealed wire		100	
					Total Wt.	15,255 lbs

SALMON ARM DISTRICT  
TRANS-CANADA HIGHWAY  
BRIDGE OVER SALMON RIVER  
AT SALMON ARM  
REINFORCING STEEL


GOVT. OF BRITISH COLUMBIA  
DEPT. OF PUBLIC WORKS  
VICTORIA

Made by C.K.S. Aug 1945  
Checked by L.J. Sept 45  
Drawing NO. 1187  
-9  
Chief Engineer


17396

11871


11871

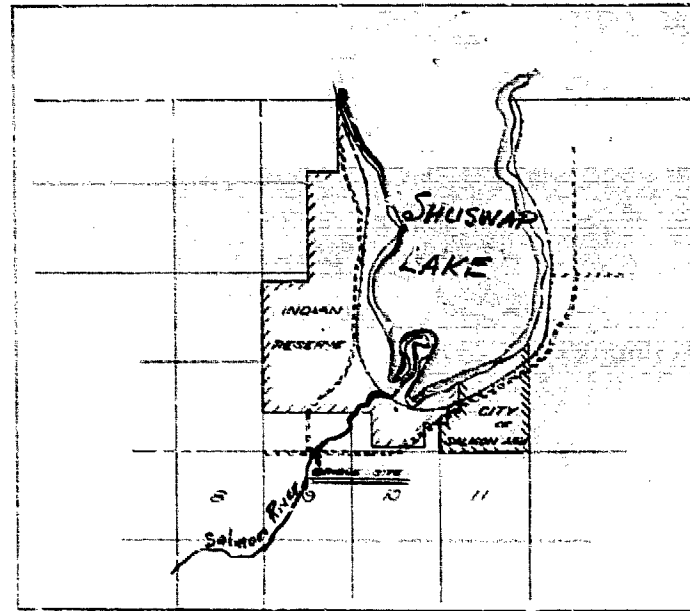

**KEY MAP**  
SCALE - 1 INCH = 1 MILE

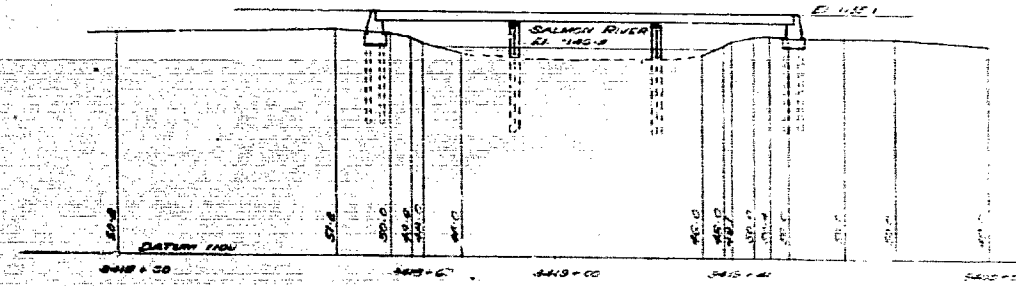

**PROFILE ON LOCATION LINE**  
SCALE 20 FT. = 1 INCH

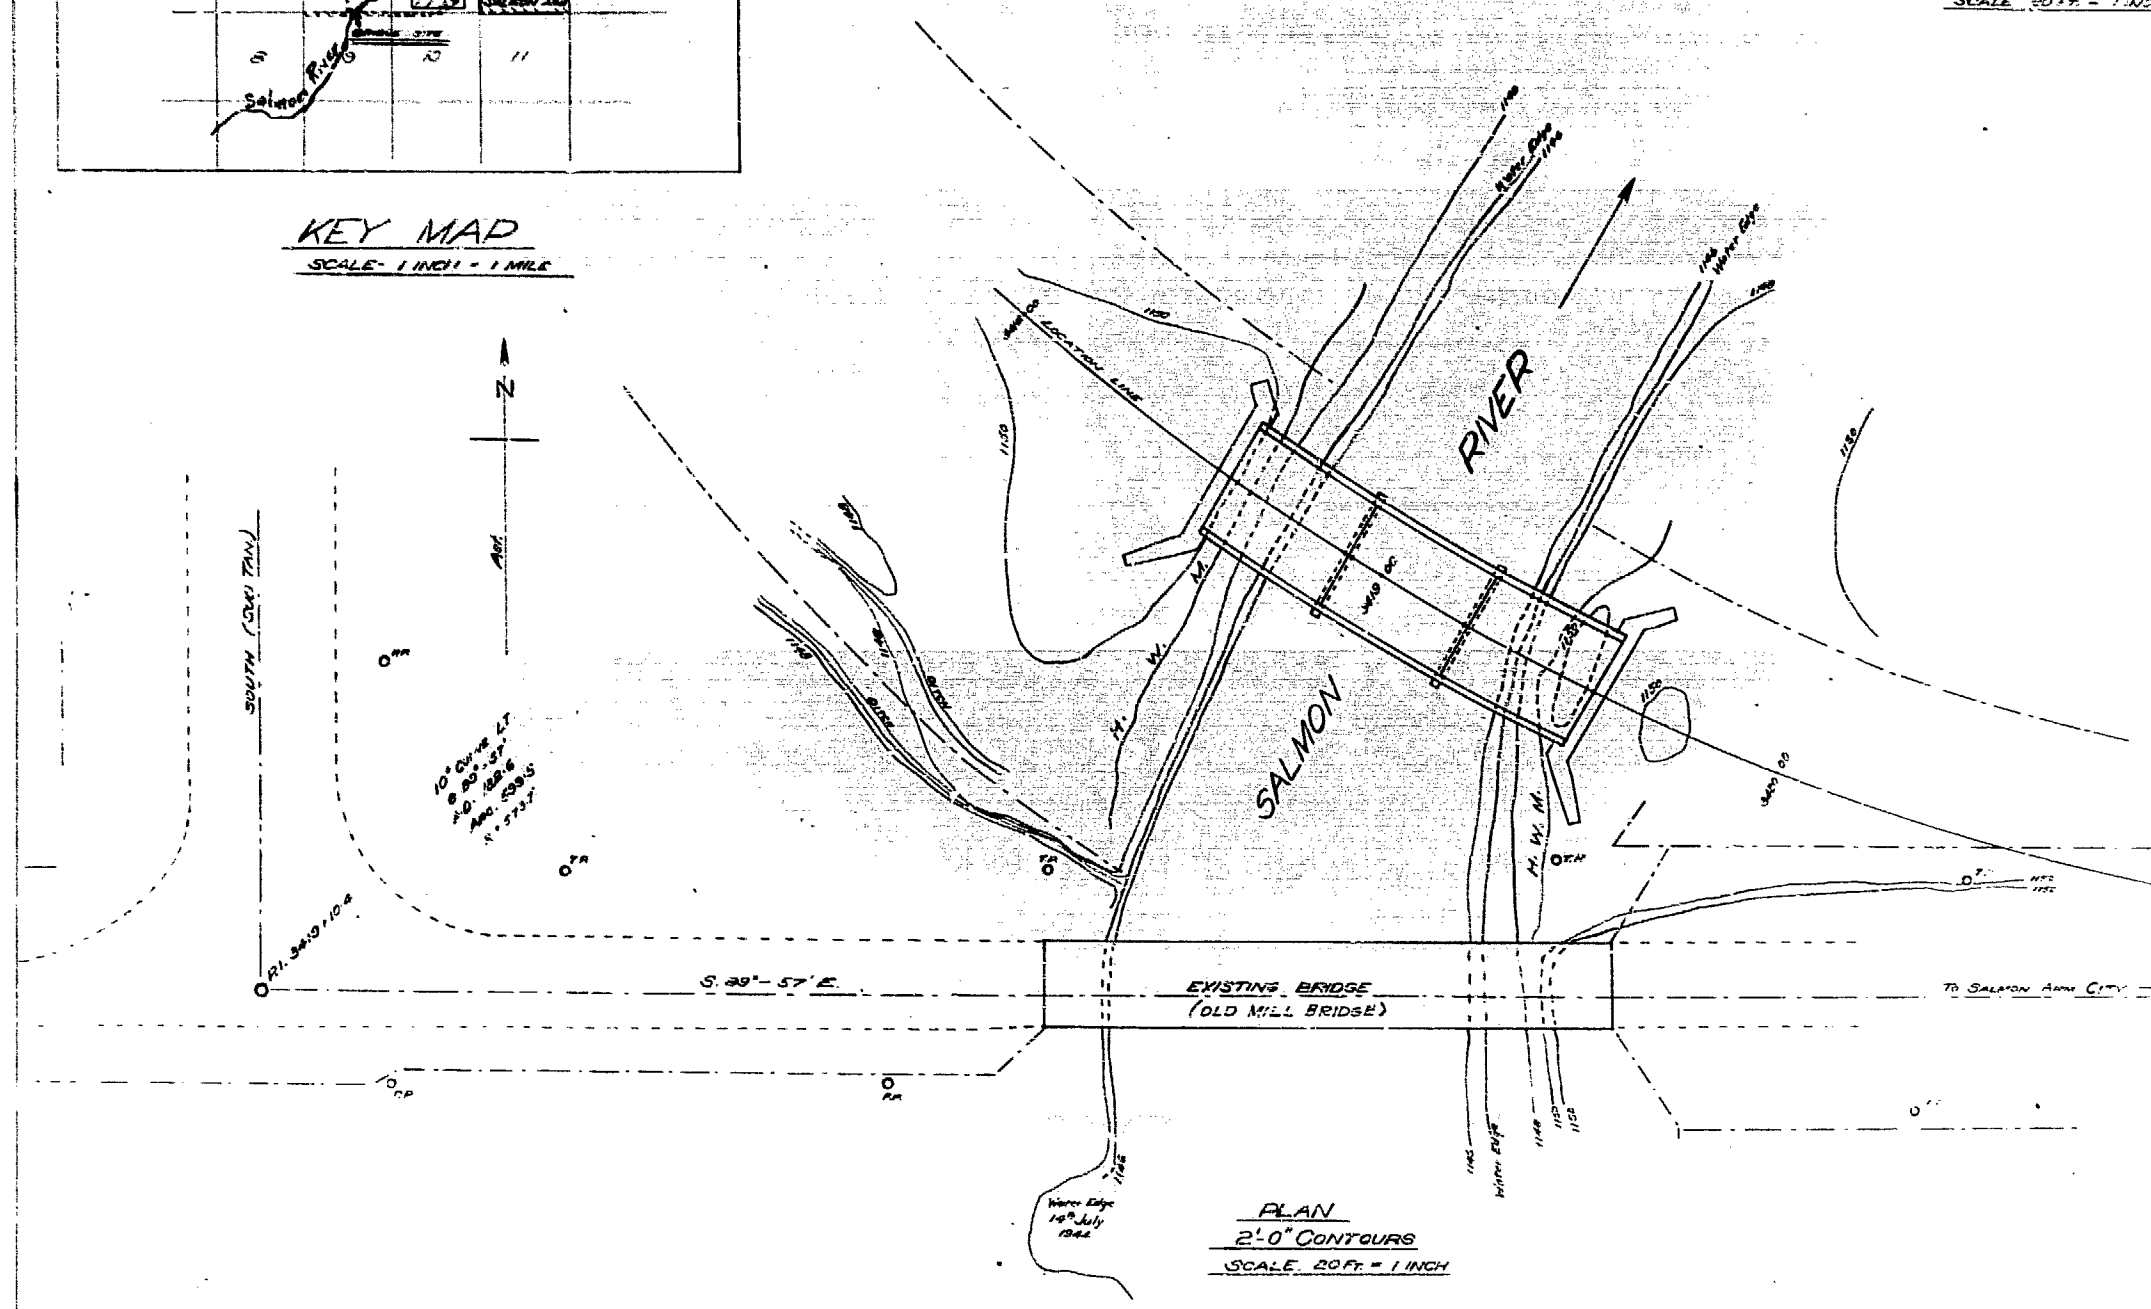

**PLAN**  
2.0' CONTOURS  
SCALE 20 FT. = 1 INCH

- INDEX OF PLANS
- 115T-2 GENERAL LOCATION AND KEY MAP
  - 2 LAYOUT
  - 4 DETAILS OF BRIDGE SECTIONS AND DETAILS
  - 5 DETAILS OF BRIDGEWORK
  - 6 DETAILS OF PILES
  - 7 DETAILS OF STEEL BEAMS ETC.
  - 8 DETAILS OF BRIDGE WALLS, ETC.
  - 9 DETAILS OF APPROACHING RAMP


**SALMON ARM DISTRICT  
TRA'S-CANADA HIGHWAY  
BRIDGE OVER SALMON RIVER**

AT SALMON ARM  
GENERAL LOCATION AND KEY MAP


SCALE 1 INCH = 1 MILE  
 G.P. of B.C. DISTRICT  
 1944  
 PLAN 21344  
 DRAWN BY  
 115T  
 -2

11871


11871

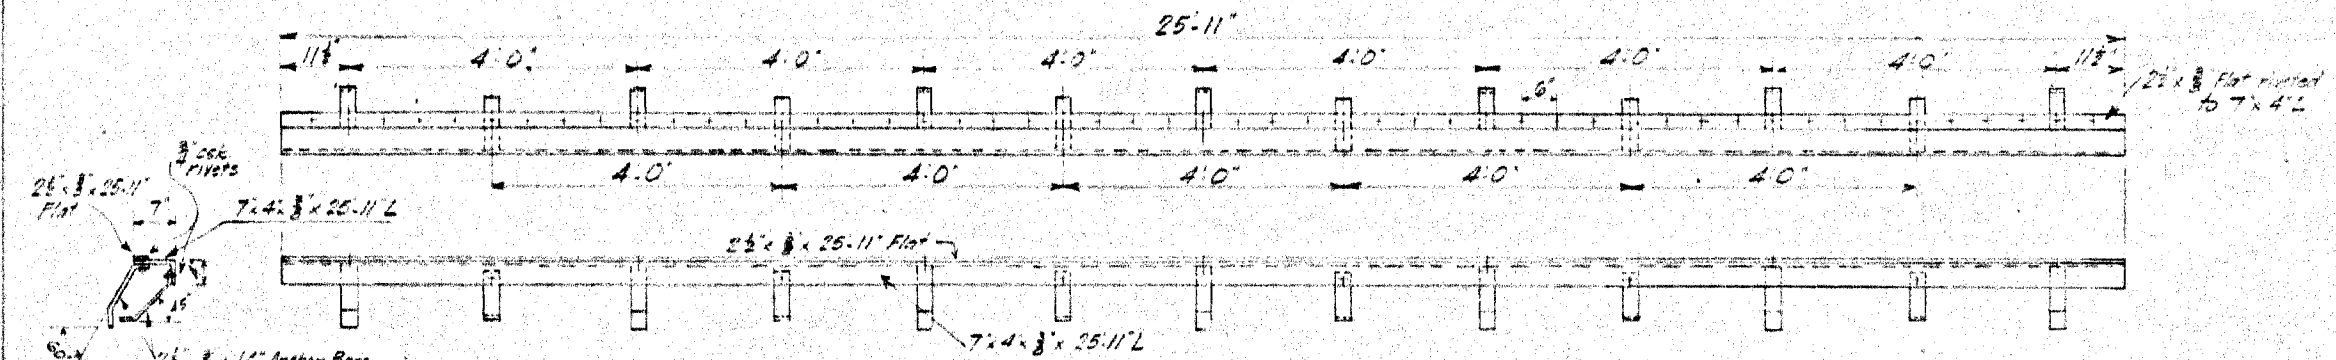


**BALLAST WALL ANGLE**  
2 Required

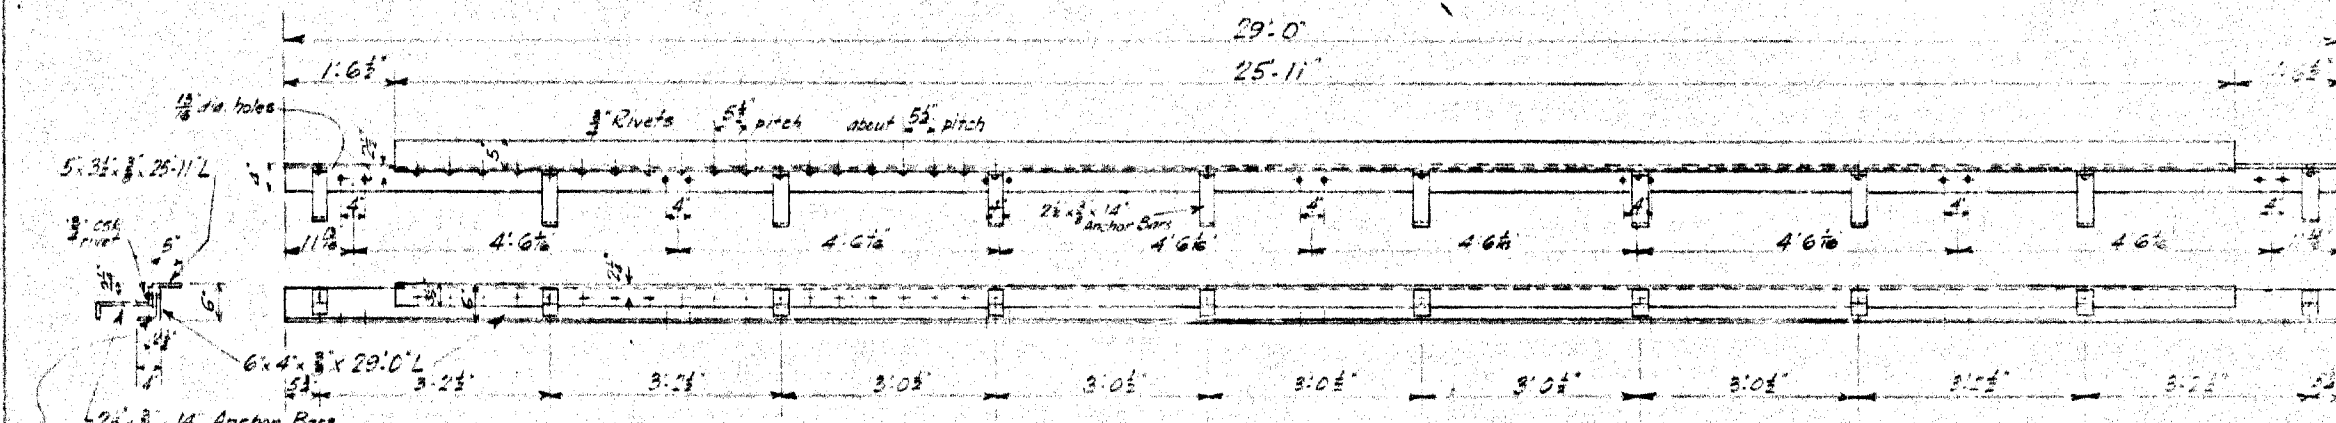

**FLOOR PLATE ANGLE**  
2 Required

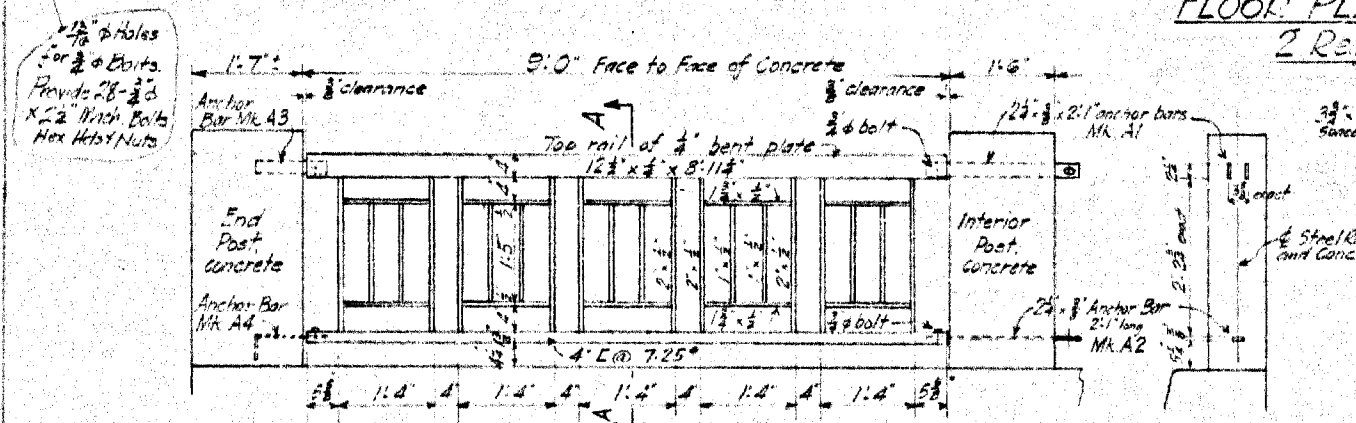


**ELEVATION OF ONE SECTION OF FENCE**  
18 SECTIONS REQ'D  
Scale - 3/4" = 1 foot

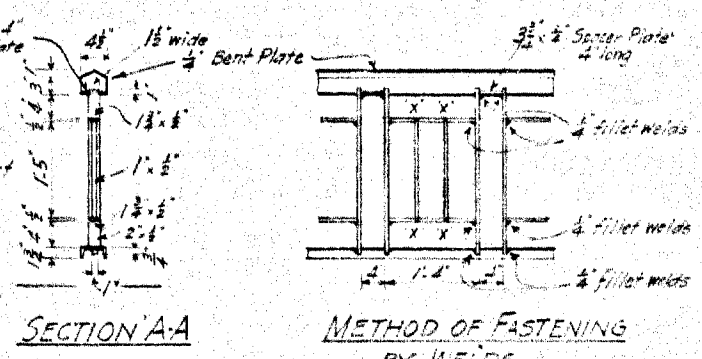


**SECTION A-A**  
**METHOD OF FASTENING BY WELDS**



**Detail of X**

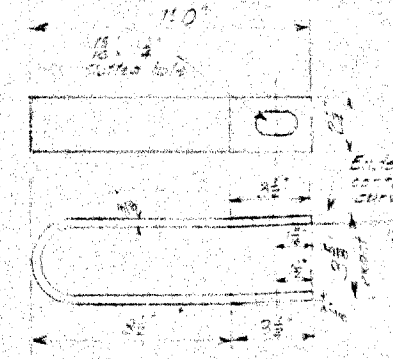


**ANCHORS MARK A3**  
2 1/2 x 3/8 x 2-1/2  
4 Rods

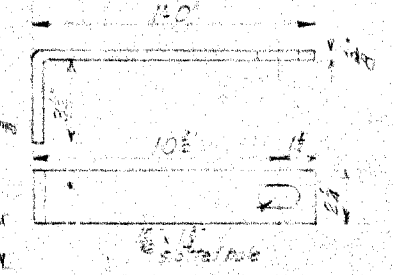

**ANCHORS MARK A1**  
2 1/2 x 3/8 x 2-1/2  
4 Rods

**ANCHORS MARK A2**  
2 1/2 x 3/8 x 2-1/2  
16 Req'd

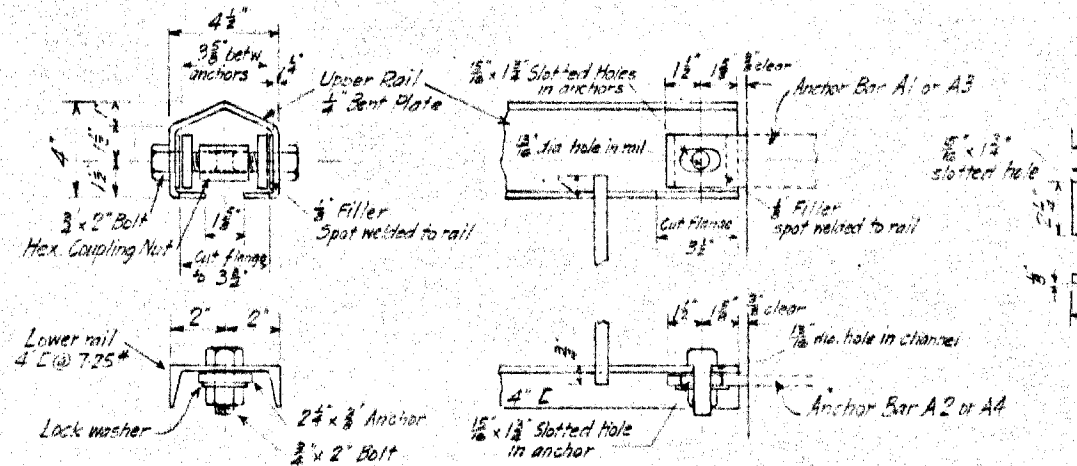

**DETAILS OF RAIL CONNECTIONS TO POSTS**  
Scale - 3" = 1 ft.

SALMON ARM DISTRICT  
TRANS-CANADA HIGHWAY  
BRIDGE OVER SALMON RIVER  
AT SALMON ARM  
BALLAST WALL &  
FLOOR PLATE ANGLES  
AND FENCE

17395

GOVERNMENT OF BRITISH COLUMBIA DEPT. OF PUBLIC WORKS VICTORIA	
PROJECT NO. 138-20-40-45	DRAWING NO. 1187
Checked by _____	NO. - 8
_____	Chief Engineer

Anchor bolts to be in anchors to be turned smooth and true. Spot all steelwork on this sheet, including bolts and nuts, but excluding parts to be enclosed in concrete. One shop can't read last figure. Submit 4 prints of shop drawings for approval before fabricating.


11871

11871








17391



**PLAN OF STEEL BEAMS**  
Scale - 1/4" = 1 foot

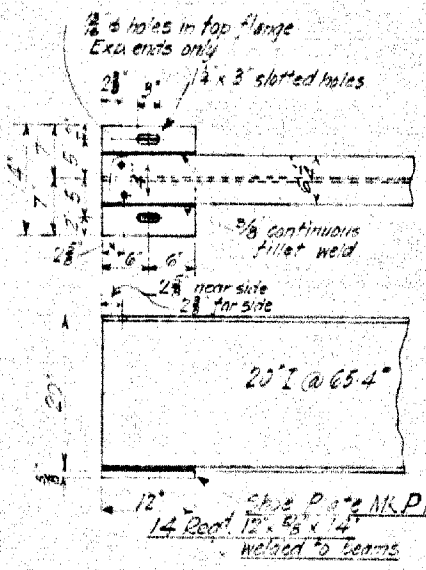

**DETAIL OF SHOE & BEARING PLATES**  
Scale - 1" = 1 foot

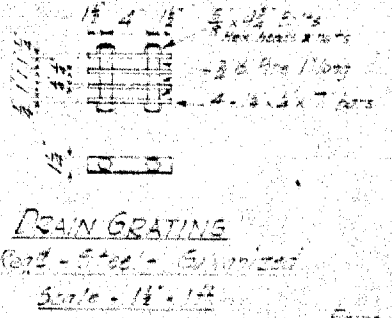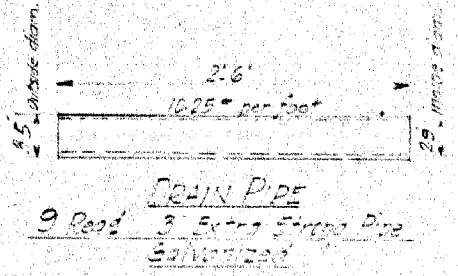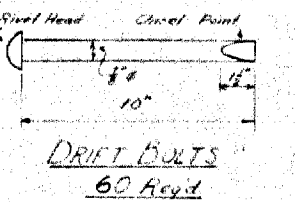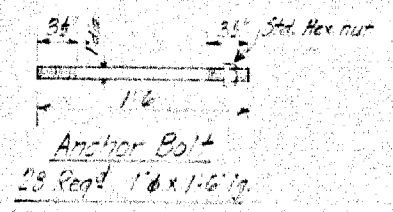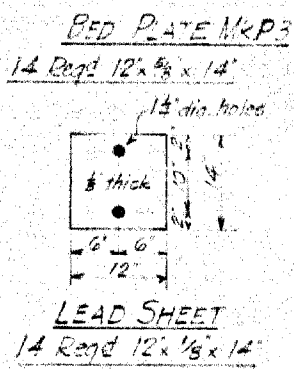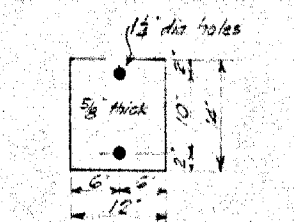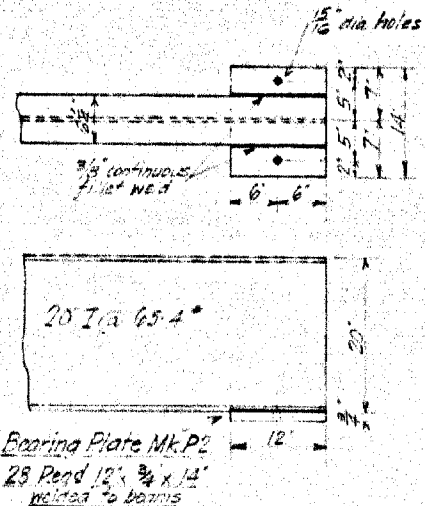

CHANNEL SECTIONS  
12 L Profile  
Supply 590 8 x 1 1/2 Bolts  
for heads and nuts  
Scale 1/2" = 1'-0"

SALMON ARM DISTRICT  
TRANS. CANADA HIGHWAY  
BRIDGE OVER SALMON RIVER  
AT SALMON ARM  
STEEL BEAMS ETC  
Scale as noted

Print all steelwork on this sheet and show cut and detail except for rivet heads and nuts and bolts to be engaged in concrete.  
Submit four prints of specifications for approval before fabricating.

GOVT. OF BRITISH COLUMBIA DEPT. OF PUBLIC WORKS VICTORIA	
Made by G.H.S. & Co. Ltd.	DRAWING NO.
Checked by L.W. Jones	1125
	7