




LOCATION	WEST CURB			C OF ROADWAY			EAST CURB		
	FIELD	OFFICE	DIV	FIELD	OFFICE	DIV	FIELD	OFFICE	DIV
S. Exp. Jt.	99.185	99.20	125	99.29	99.45	125	99.18	99.305	125
Filled Jt.	99.20	99.28	09	99.28	99.42	14	99.20	99.315	115
Filled Jt.	99.20	99.308	102	99.30	99.425	125	99.20	99.324	124
Filled Jt.	99.18	99.318	113	99.31	99.433	123	99.20	99.334	134
Exp. Jt.	99.20	99.325	125	99.318	99.44	125	99.22	99.345	125
Filled Jt.	99.225	99.33	108	99.35	99.456	106	99.24	99.355	115
Filled Jt.	99.24	99.334	094	99.37	99.471	101	99.25	99.365	115
Exp. Jt.	99.215	99.34	125	99.36	99.485	125	99.25	99.375	125
Filled Jt.	99.215	99.343	128	99.34	99.477	137	99.25	99.36	11
Filled Jt.	99.28	99.347	067	99.39	99.47	163	99.27	99.349	079
Filled Jt.	99.26	99.35	09	99.355	99.463	108	99.24	99.336	096
N. Exp. Jt.	99.23	99.355	125	99.33	99.455	125	99.20	99.326	125

AS BUILT GRADES


LOCATION	WEST CURB		C OF ROADWAY		EAST CURB	
	FIELD	OFFICE	FIELD	OFFICE	FIELD	OFFICE
S. Exp. Jt.	9.29		9.42		9.29	
Filled Jt.	9.31		9.44		9.30	
Filled Jt.	9.33		9.46		9.33	
Filled Jt.	9.31		9.44		9.31	
Exp. Jt.	9.30		9.43		9.31	
Filled Jt.	9.35		9.48		9.35	
Filled Jt.	9.35		9.48		9.35	
Exp. Jt.	9.35		9.48		9.36	
Filled Jt.	9.37		9.50		9.37	
Filled Jt.	9.40		9.53		9.40	
Filled Jt.	9.38		9.51		9.38	
N. Exp. Jt.	9.33		9.46		9.32	

NOTES:

- All steelwork material to conform to C.S.A. Specifications G40.21 (38M) or better.
- All welding electrodes shall conform to A.W.S. Specifications A.5.1 Classification E7018
- All elevations based on B.M. located at top of curb SE corner of bridge, assumed to be 10.00'

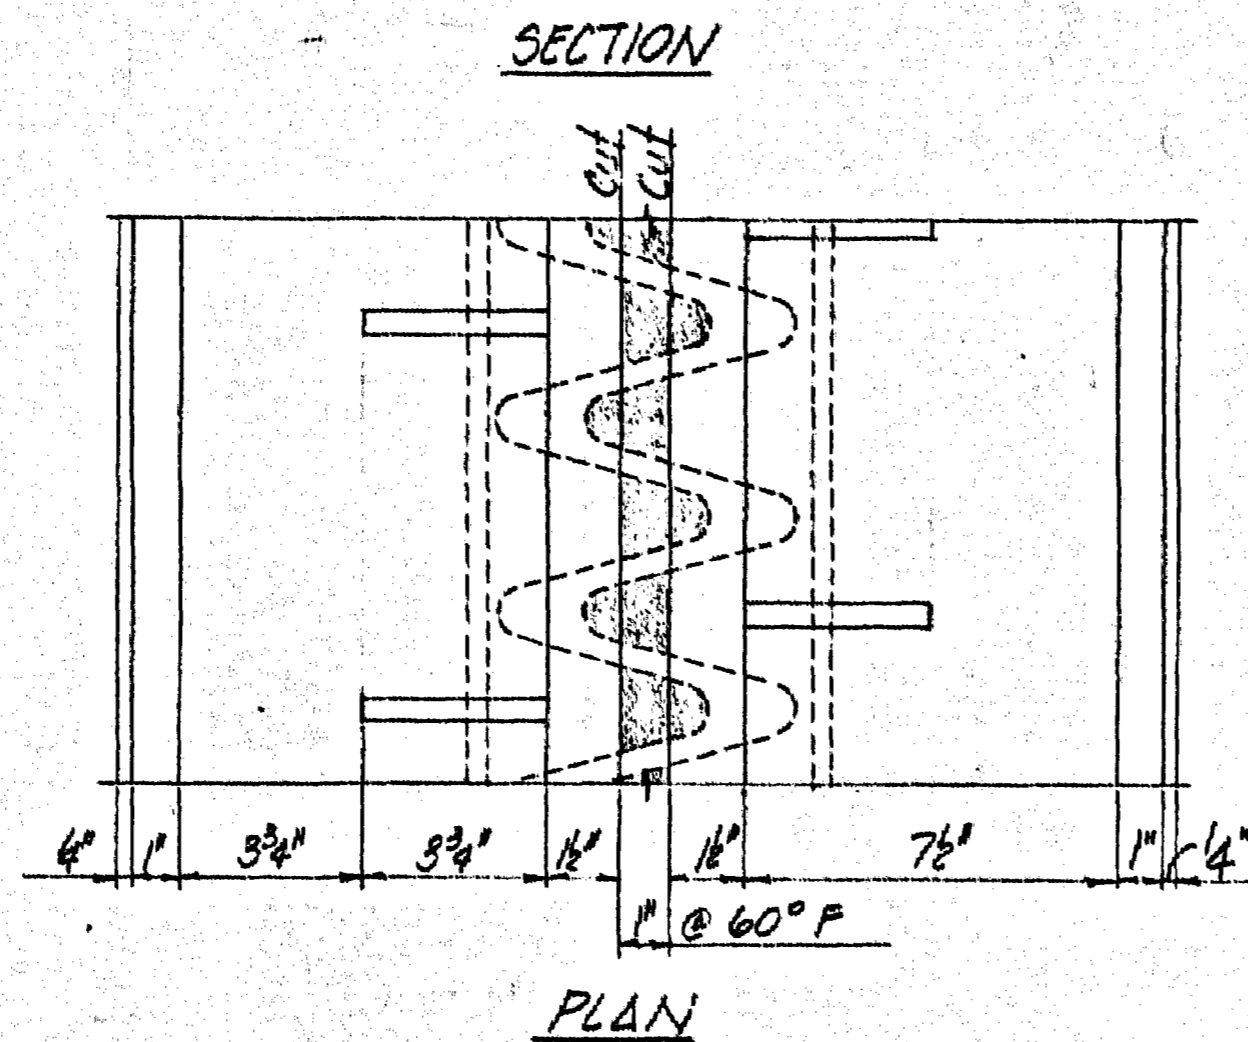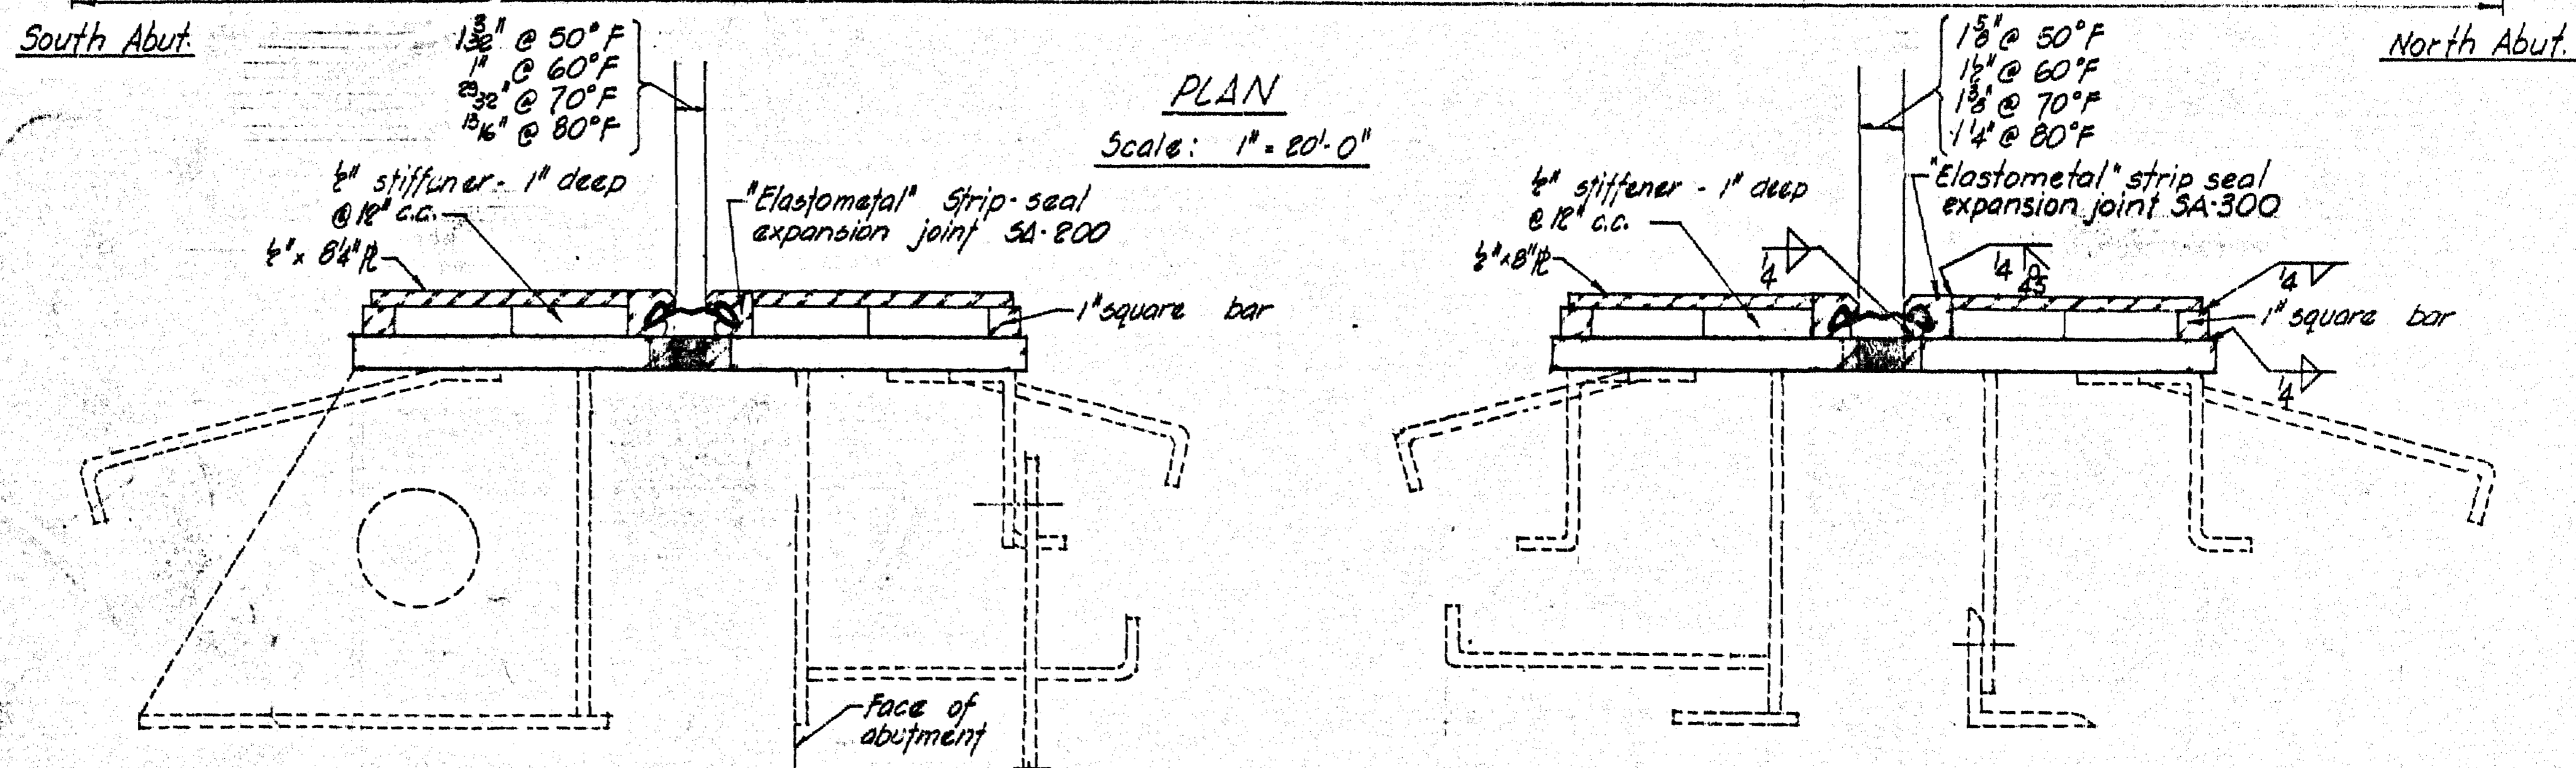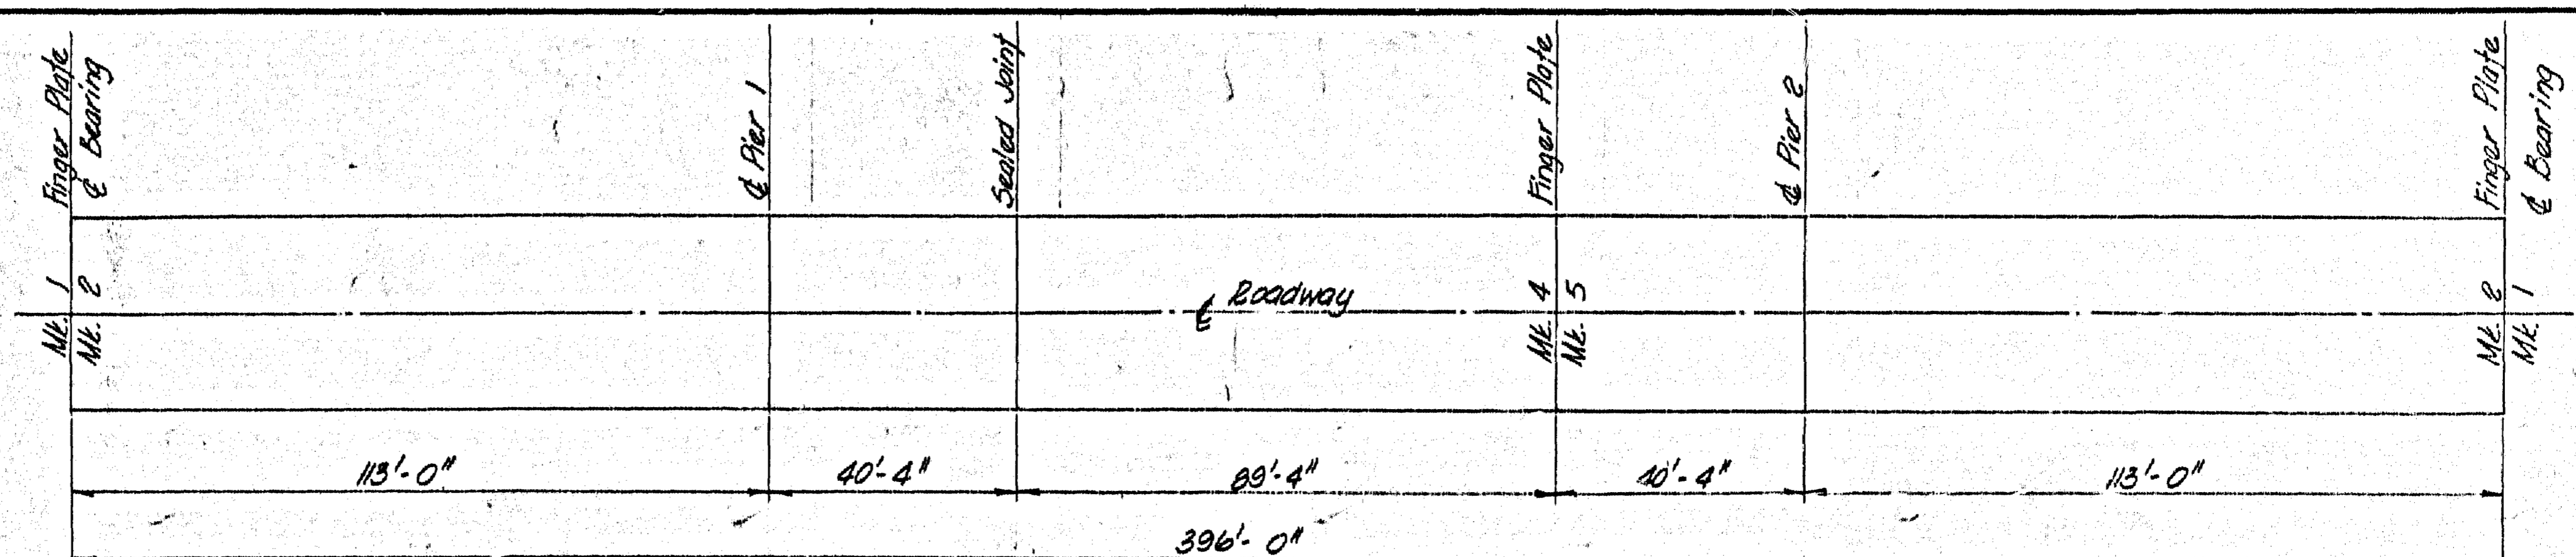

Mk. 2 Mk. 1
113' EXPANSION

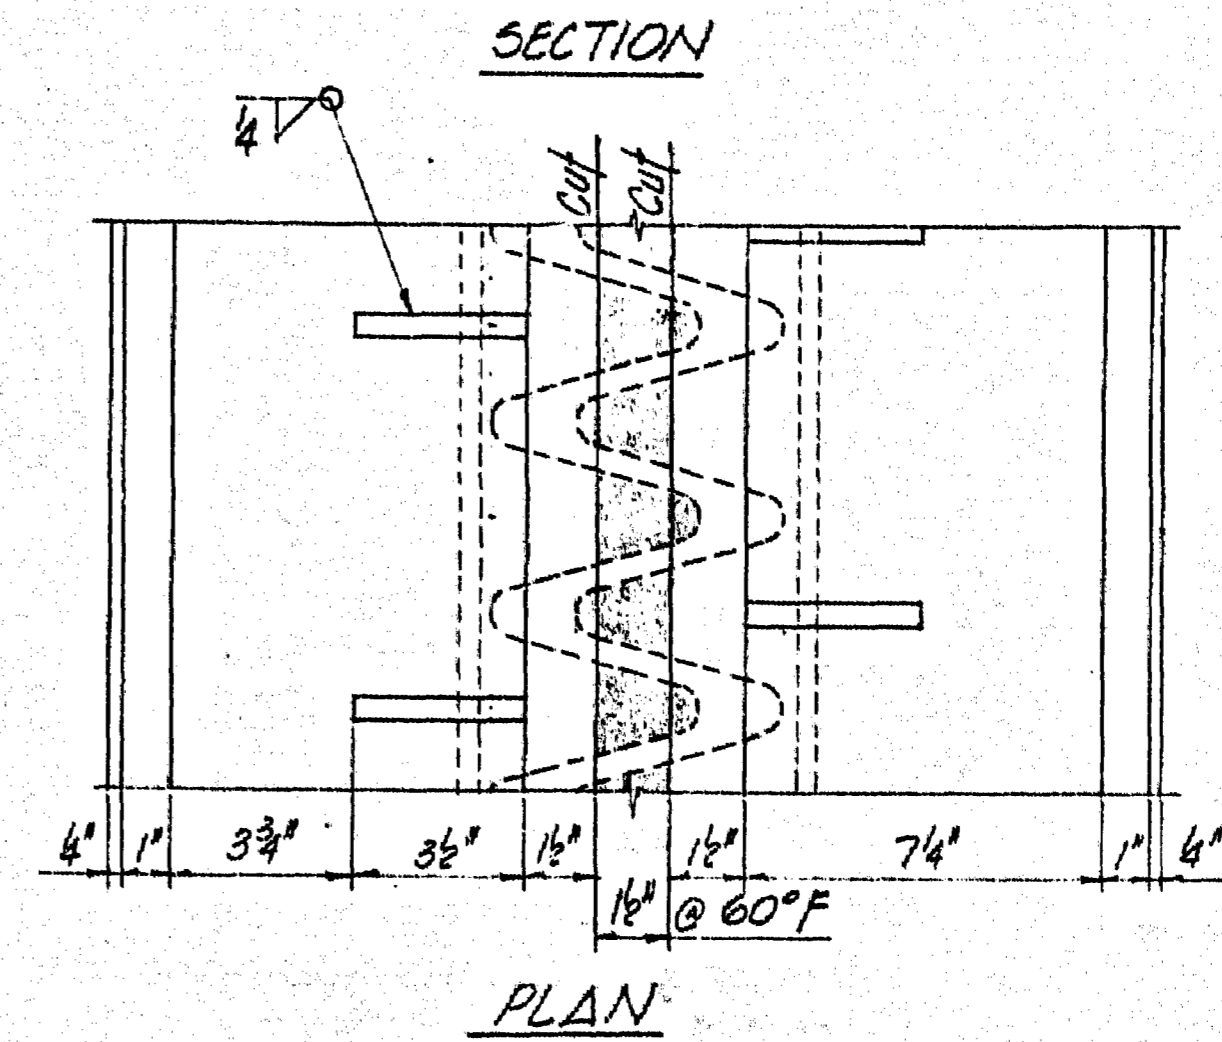

Mk. 5 Mk. 4
170' EXPANSION

GOVERNMENT OF BRITISH COLUMBIA
MINISTRY OF HIGHWAYS AND PUBLIC WORKS
BRIDGE ENGINEERING BRANCH

NELSON DISTRICT 298734
CASTLEGAR - NELSON HIGHWAY
SHOREACRES BRIDGE over SLOCAN RIVER
BRIDGE RESURFACING

298734

D	RECOMMENDED	SCALE: 3" = 1'-0" and as noted
C		DRAWN: PFB 28/6/78 CHECKED: R.J.D. 28/6/78
B	SENIOR BRIDGE DESIGN ENGINEER	APPROVED: [Signature]
A	As Built Grades 1/B.M. New/BC	DRAWING No. 599-100 A

REVISIONS