


**NOTE**



Elevations shown are intended theoretical elevations. The actual elevations of the North Abutment will be adjusted by the Engineer to compensate for settlement depending on the time the approach fill is placed.

▲ Elevations of North Abutment raised as

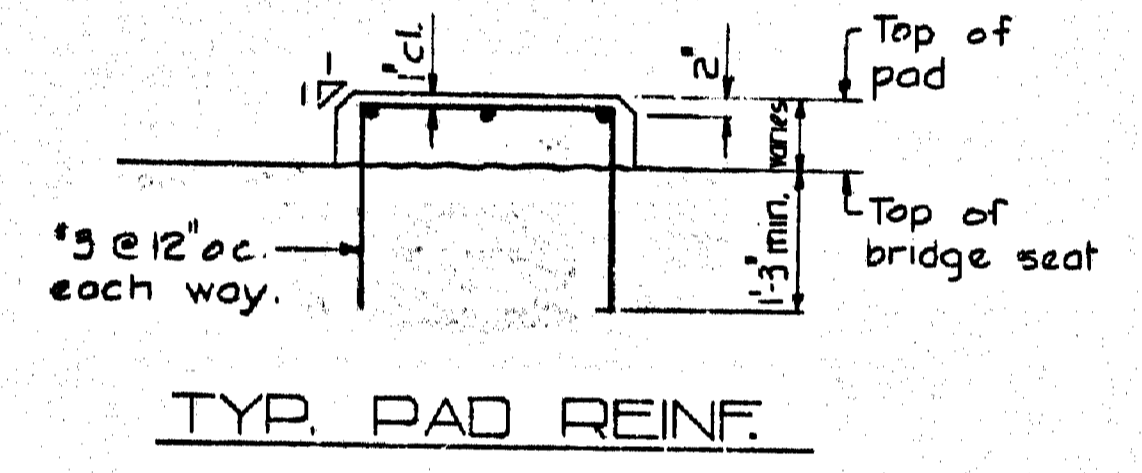

**NOTE**

6" layer of compacted pit run gravel to be placed under footing as ordered by Engineer. See specifications

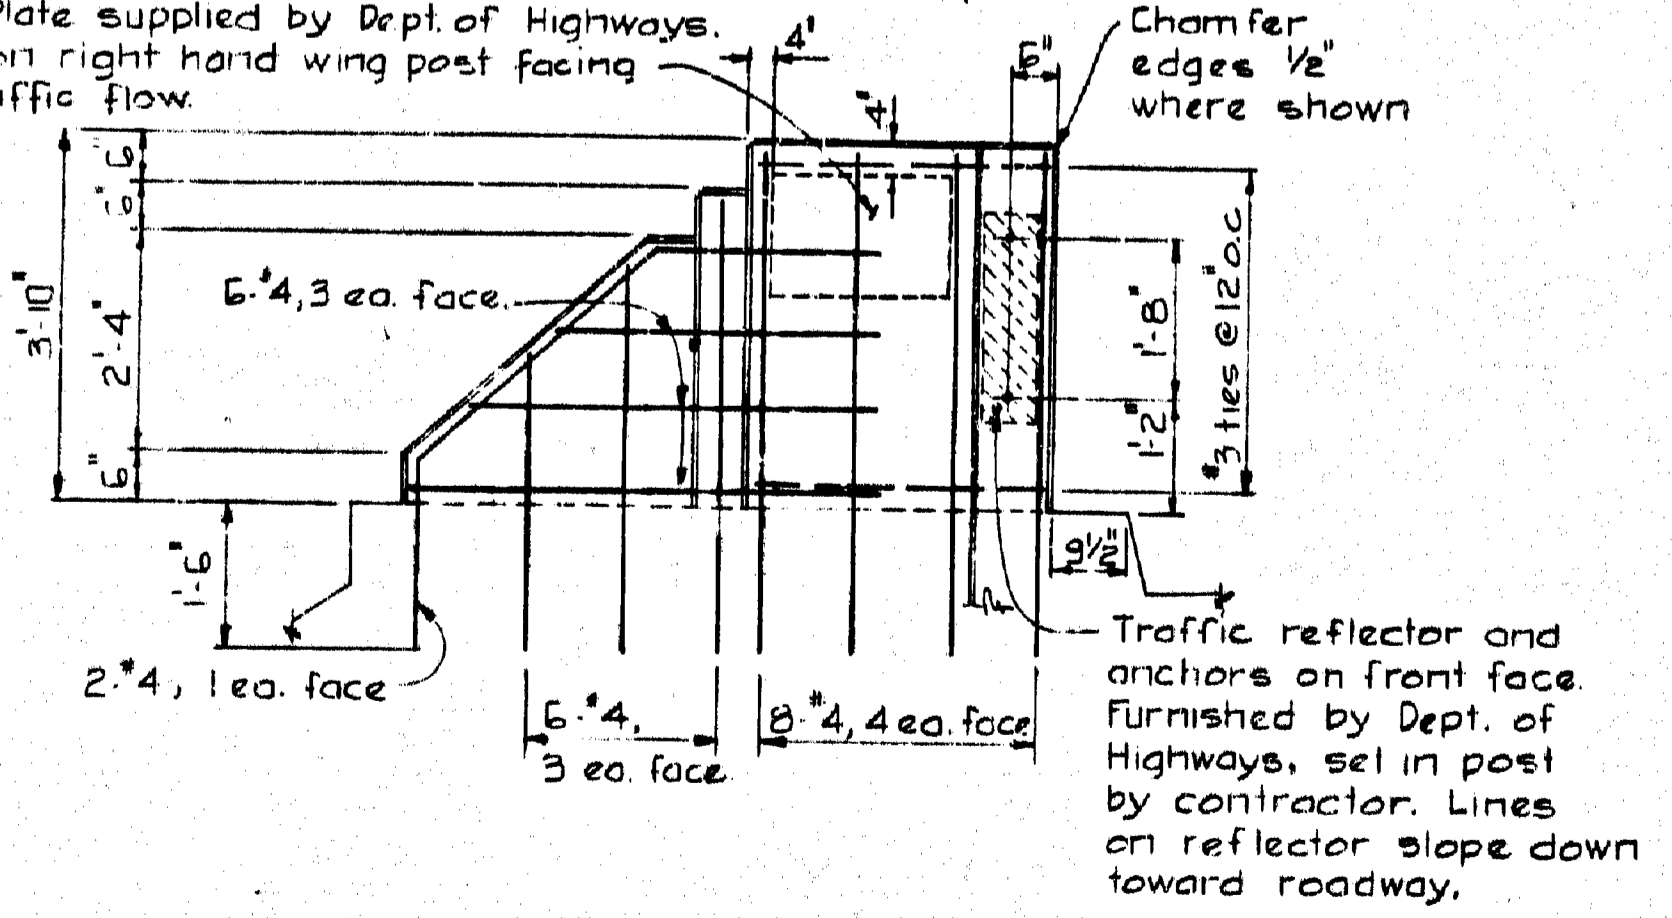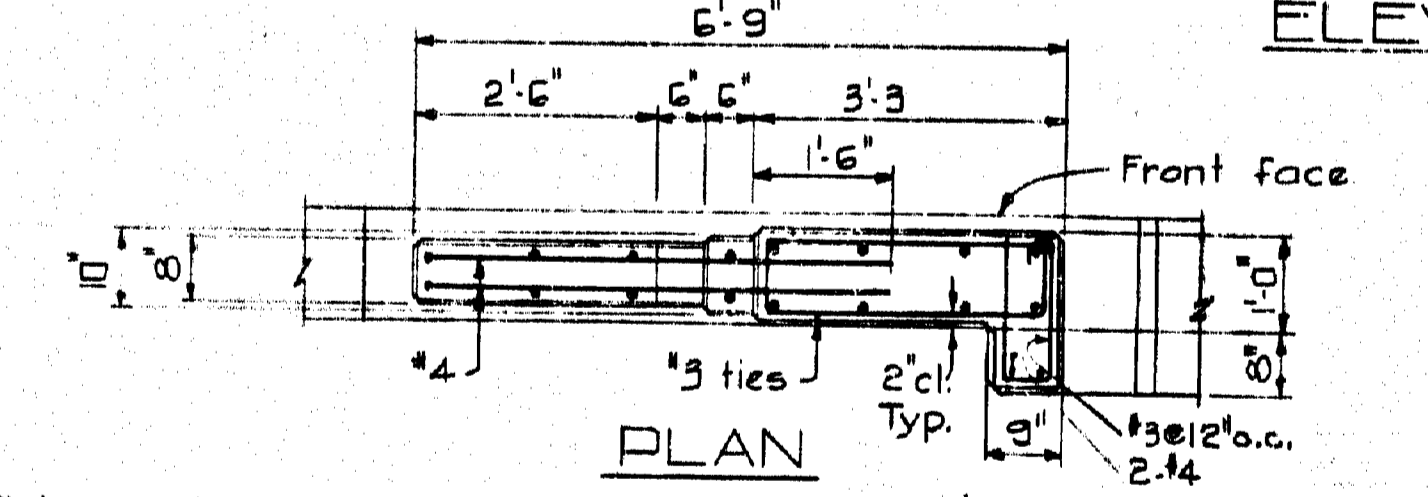

**NOTES**

For general notes see Dwg 599-22

Sept 64	A as Built
NO. DATE	REVISION



GOV'T. OF THE PROV. OF BRITISH COLUMBIA  
DEPT. OF HIGHWAYS

CASTLEGAR - NELSON HIGHWAY  
SHOREACRES BRIDGE  
OVER  
SLOCAN RIVER

ABUTMENTS

CHOUKALOS, WOODBURN, HOOLEY & MCKENZIE LTD.  
CONSULTING ENGINEERS  
1159 West Broadway, Vancouver 9 B.C.

Drawn: D.R.H. Date: June 9, 1961 Scale: 1/4" = 3'-0" - 1'-0"

Checked: D.D. Date: DWG. 599-23X

GENERAL ARRANGEMENT APPROVED

Chief Engineer, Dept. of Highways