



HALF CROSS SECTION


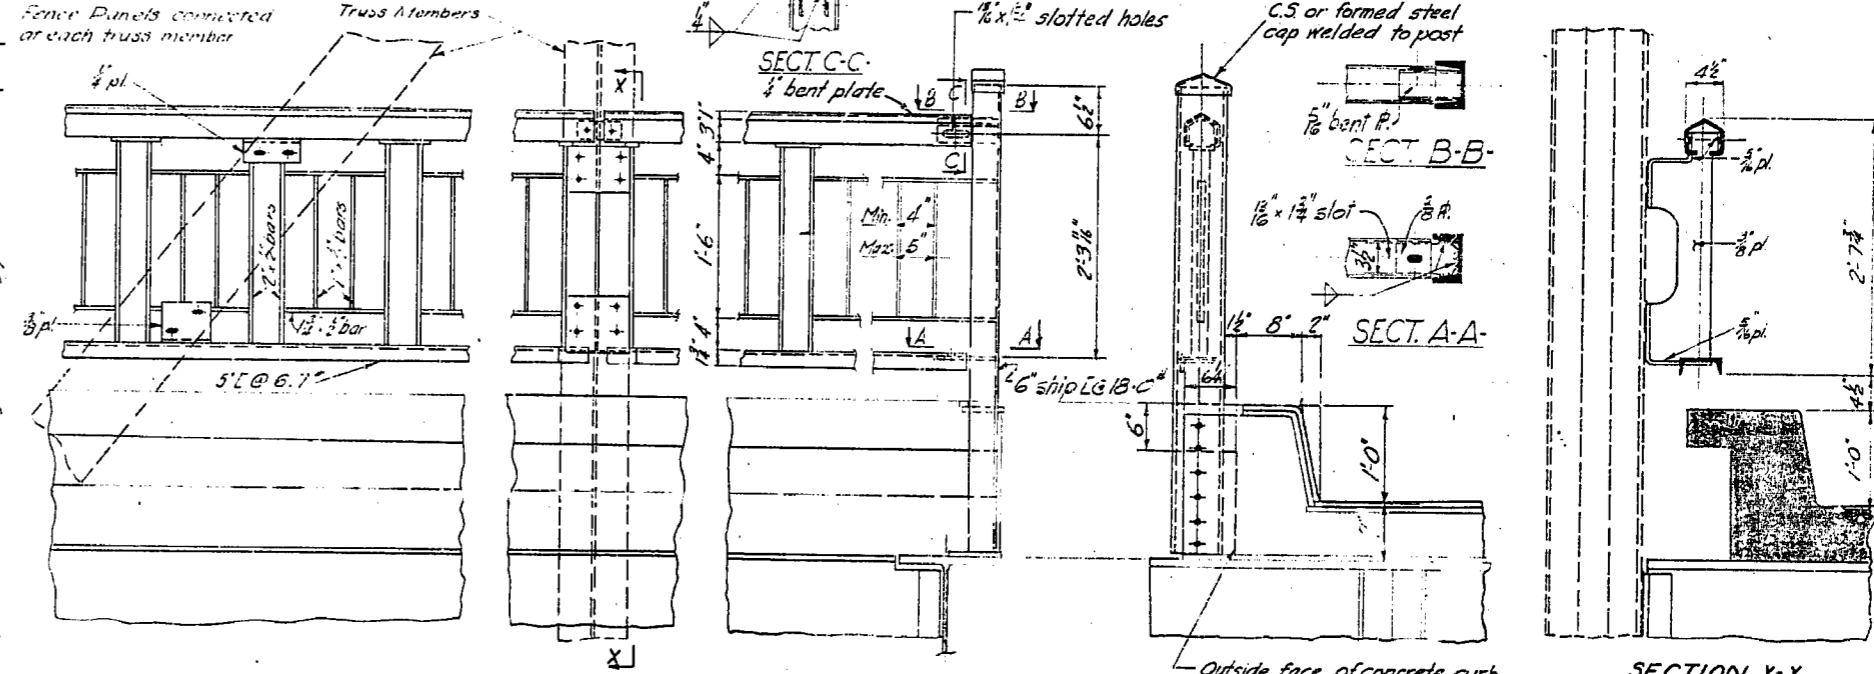


DETAIL OF FENCE AND FENCE POST CONNECTIONS

Scale: 1"=1'-0"

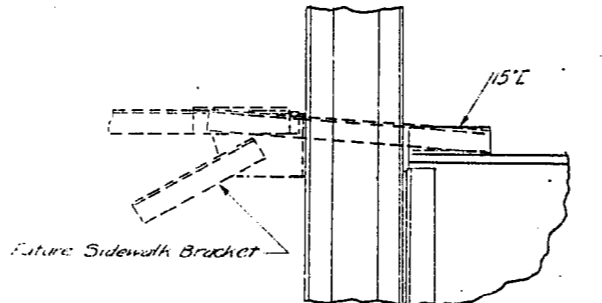


DETAIL OF FUTURE SIDEWALK BRACKET CONNECTION TO TRUSS

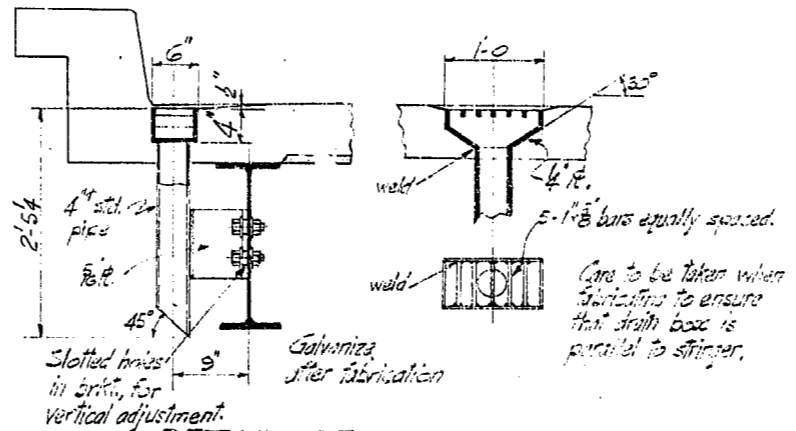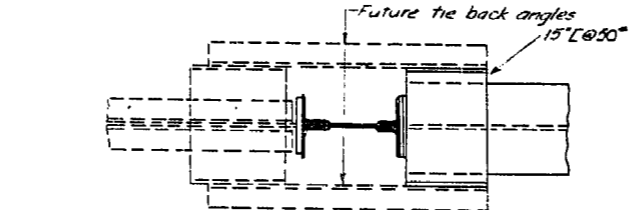

DETAIL OF DRAIN

Scale: 1"=1'-0"

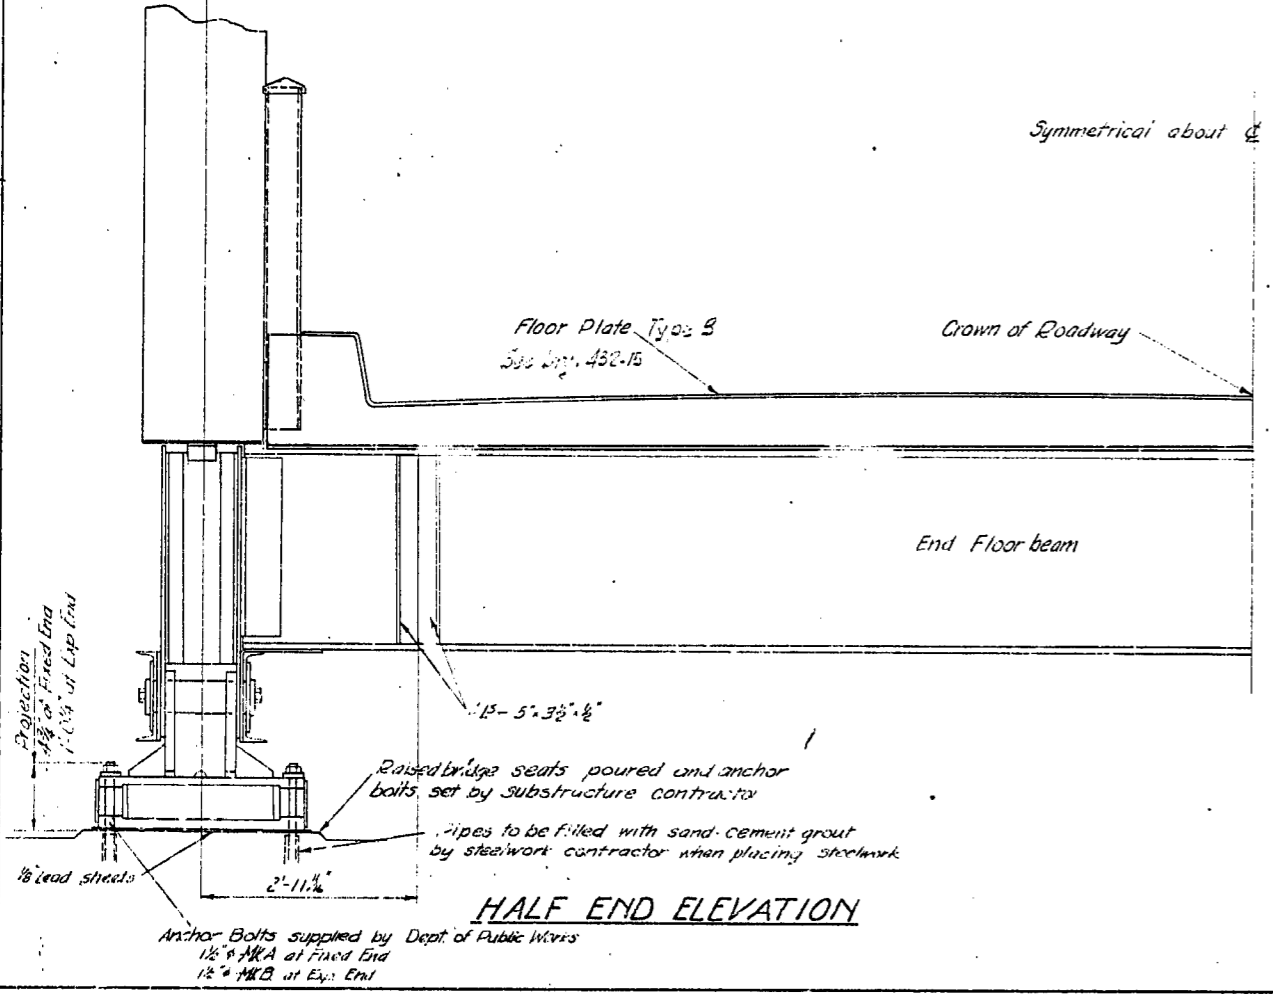

HALF END ELEVATION

REVISIONS				GOVT. OF BRITISH COLUMBIA	
Rev.	Description	Init.	Date	DEPT. OF PUBLIC WORKS	
A	Slab thickness as built	J.P.	Oct 21-57	BRIDGE ENGINEER'S OFFICE	
				Drawn by	DR. J.P.
				Checked by	W.C. 11/1/52
				No. BRIDGES 432-13	
				W.C. 11/1/52	