




248 - 3rd Avenue West  
 Prince Rupert, B.C.  
 Canada V8J 1L1




MOT PERMIT #: 03-026-13666

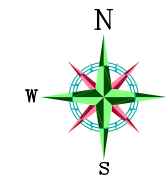

**Drawing List:**

Site Specific Drawings	Sheet No.
EXHIBIT "A1" TITLE/KEY	A1
EXHIBIT "B1" - NOTES	B1
EXHIBIT "B2" - DETAILS	B2
EXHIBIT "B3" - DETAILS	B3
EXHIBIT "C1" - CUT LENGTHS	C1
EXHIBIT "C2" - BILL OF MATERIALS	C2
EXHIBIT "D35" - BRIDGE DETAILS	D35
ALIGNMENT	361-370

<b>ASBUILT</b>		
DATE	5/DEC/06	REV 1

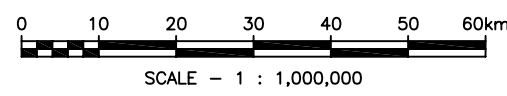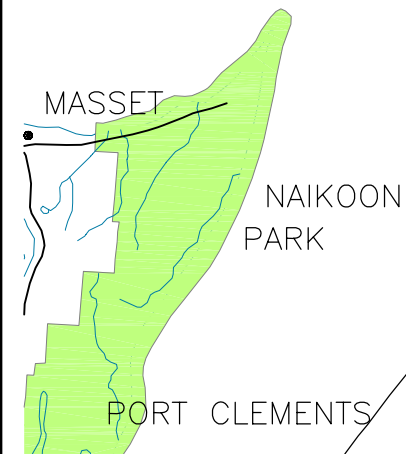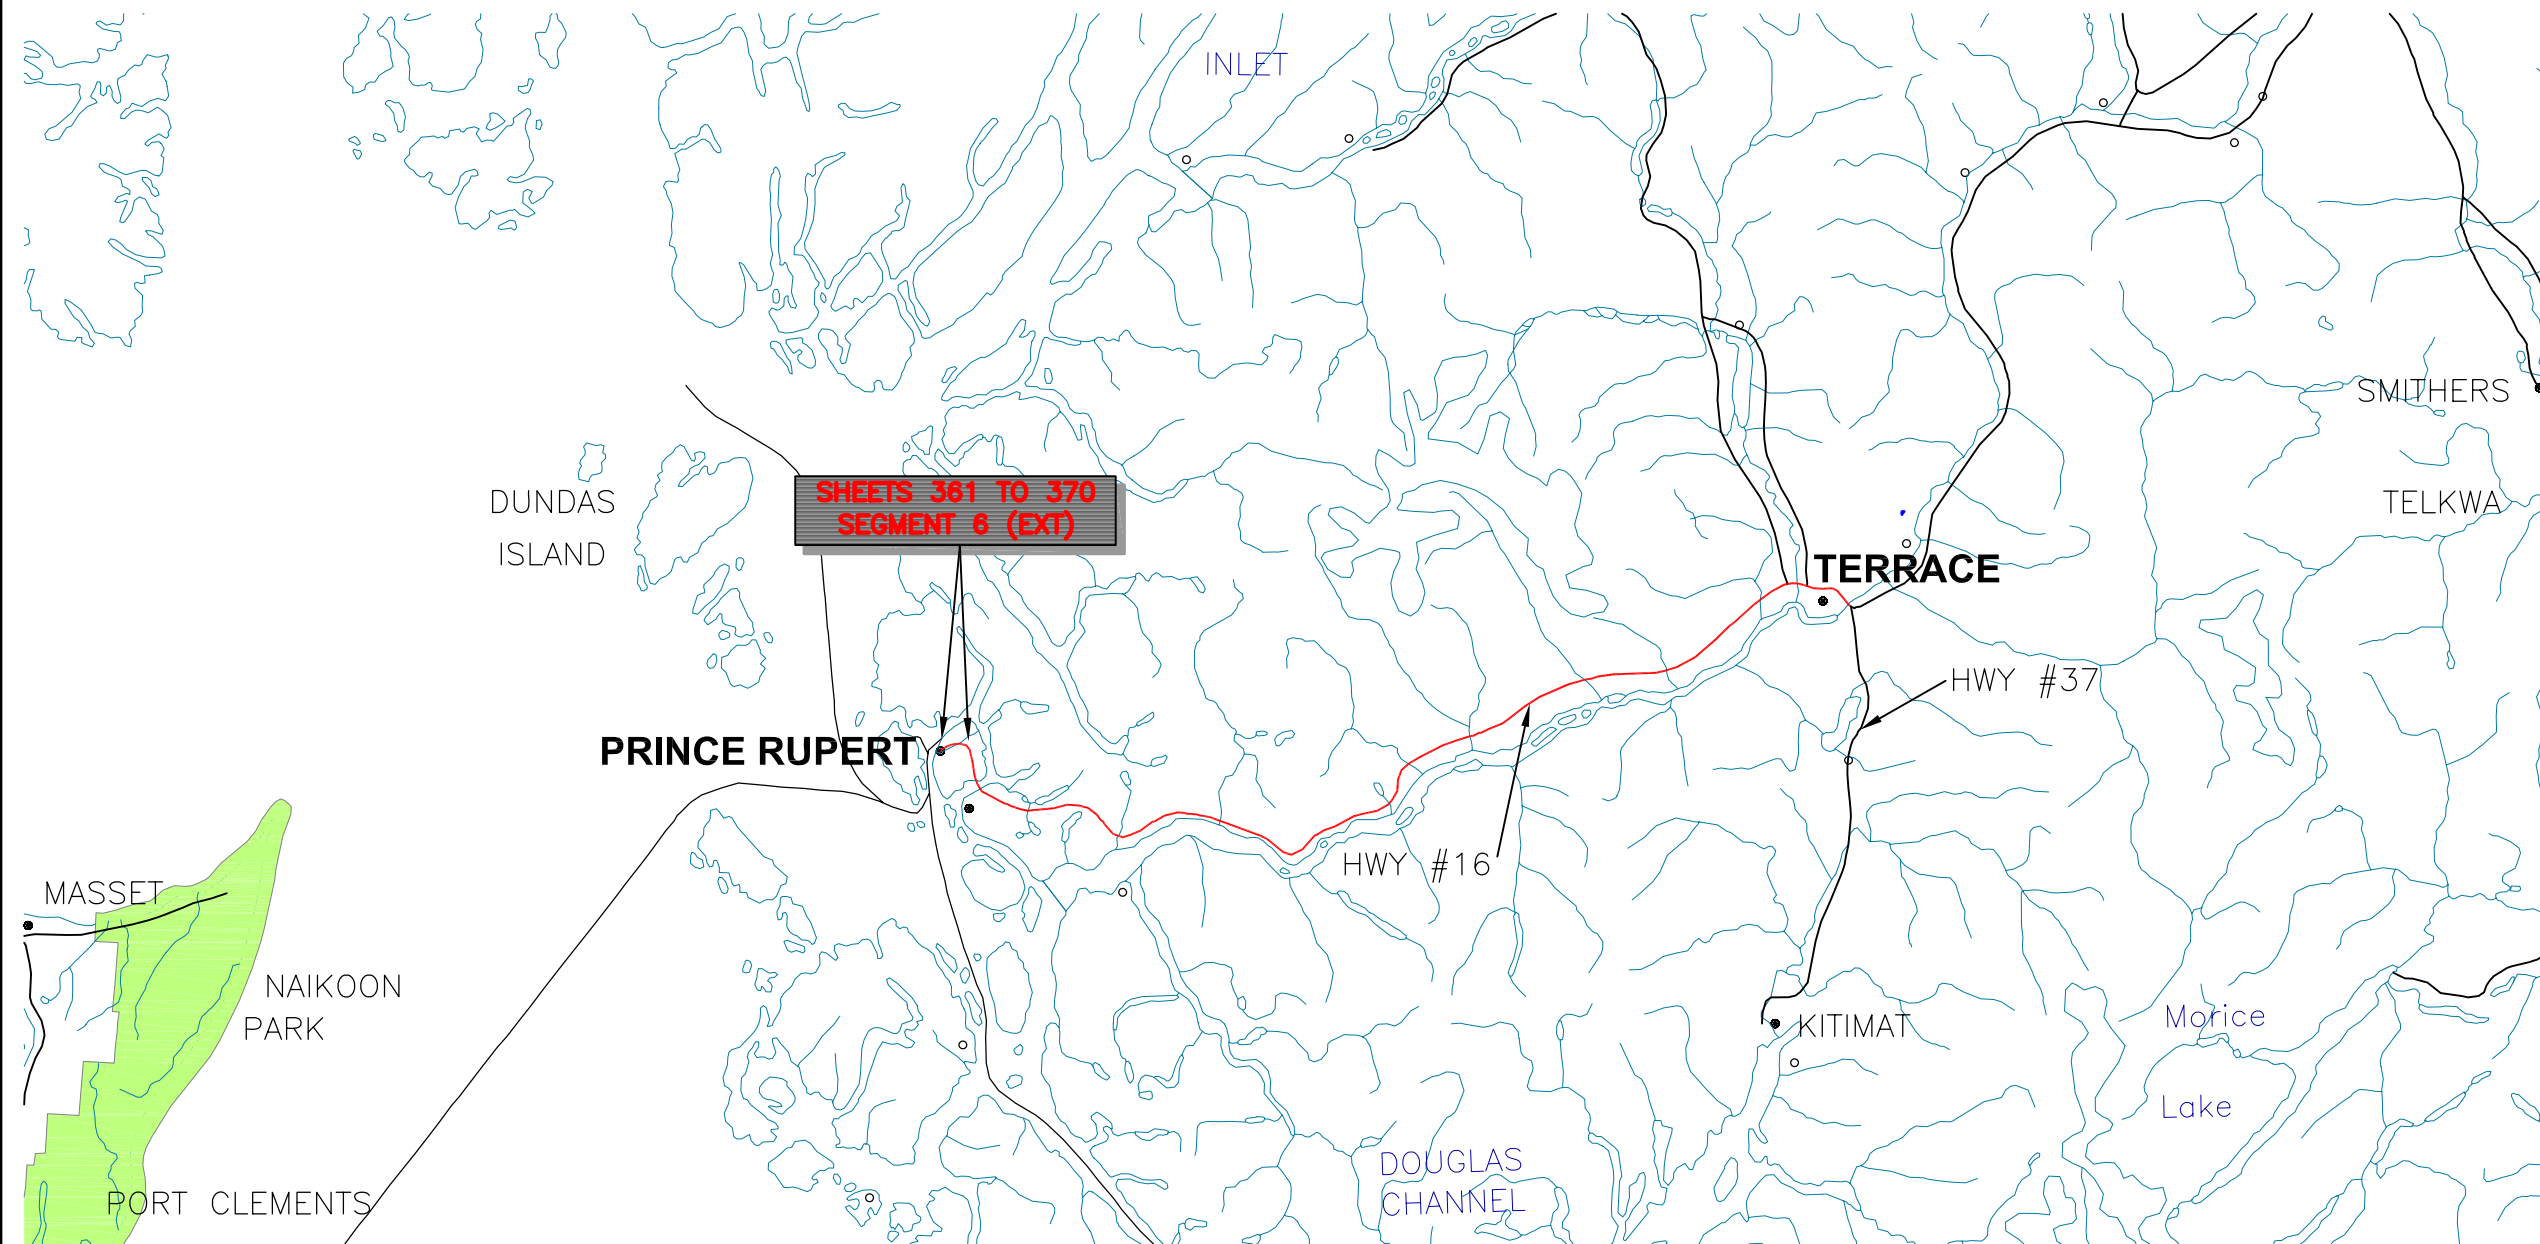


248 - 3rd Avenue West  
 Prince Rupert, B.C.  
 Canada V8J 1L1

Project: **CITYWEST  
 TERRACE TO PRINCE RUPERT  
 FIBRE OPTIC BUILD**

Location: Terrace to Prince Rupert

Rev.	dd/mm/yy	Revision/Issue Description	Drn.	App.
1	05/12/06	Asbuilt	PM	BM
0	02/06/06	MOT Permit Drawing Prince Rupert Extension	PM	BM

Prepared for / by:  
 Suite 1200,  
 1067 West Cordova Street  
 Vancouver, B.C.  
 Canada V6C 7C7



**DISCLAIMER:**  
 THE LOCATIONS OF ALL UTILITIES—INCLUDING THE CITYWEST FIBRE OPTIC LINE—SHOWN ON THIS DRAWING ARE FOR REFERENCE AND PLANNING PURPOSES ONLY. LEDCOR TECHNICAL SERVICES HEREBY DISCLAIMS ANY RESPONSIBILITY TO THIRD PARTIES FOR THE ACCURACY OF THIS INFORMATION. PERSONS WORKING IN THE AREA COVERED BY THIS DRAWING MUST CONTACT THE APPROPRIATE CALL-BEFORE-YOU-DIG SYSTEM TO ASCERTAIN THE LOCATION OF ALL UNDERGROUND UTILITIES PRIOR TO PERFORMING ANY EXCAVATION.

Project ID: Terrace to Prince Rupert - Fibre Optic Build			
Lecor Technical Services Project No.: 5080004			
Scales:	Designed by: BS	Rev.	<b>1</b>
Horiz. 1 : 1,000,000	Drawn by: PM		
Vert. -	Approved by: BM		
Date: June 06, 2006	Acad File: LTS05-1353-ENG02.DWG	Sheet No: A1	

## CONSTRUCTION NOTES

1. MINIMUM CONDUIT COVER 1000mm ALL S, EXCEPT WHERE OTHERWISE NOTED.
2. ALL DUCTS TO BE 100mm P.V.C. DB2 OR 50mm P.V.C. DB2 UNLESS OTHERWISE NOTED.
3. ALL MANUFACTURED BENDS TO BE 0.91m & 3.8m RADIUS UNLESS OTHERWISE NOTED.
4. CONTRACTOR IS TO PROVE THE LOCATIONS OF ALL EXISTING UNDERGROUND UTILITIES AND SERVICES AFFECTED BY CONSTRUCTION.
5. CONTRACTOR TO CONTACT BC ONE CALL 48 HOURS PRIOR TO STARTING WORK.

### BC ONE CALL

PH: 1-800-474-6886










\*FAX: 1-604-451-0344










ONLINE: www.bconecall.bc.ca








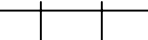
\*TO FAX IN A LOCATE REQUEST, PRINT AND COMPLETE THE APPROPRIATE FORM.

6. ALL PERMANENT RESTORATION BY CONTRACTOR AS PER CITY OF TERRACE RESTORATION SPECIFICATIONS. ALL RESTORATION ARRANGEMENTS TO BE IN PLACE, PRIOR TO START OF CONSTRUCTION.
7. IDENTIFICATION MARKER TAPE TO BE PLACED IN TRENCH LINE, 300mm BELOW FINAL GRADE.
8. WHEN REQUIRED CLEARANCES CANNOT BE MAINTAINED, CONDUITS MAY BE CONCRETE ENCASED OR STEEL PROTECTION.
9. MINIMUM 1.0m HORIZONTAL SEPARATION AND 0.3m VERTICAL SEPARATION UNDER EXISTING UTILITIES WHERE POSSIBLE. MAINTAIN MINIMUM 1.8m HORIZONTAL SEPARATION AND 0.5m VERTICAL SEPARATION WHEN CROSSING OVER WATER MAINS.
10. DIRECTIONAL BORE SECTIONS ARE ESTIMATED.

## LEGEND

PROPOSED DUCT ALIGNMENT	
FACE OF CURB, EDGE OF WALK AND EDGE OF ROAD	
ALIGNMENT REFERENCED EDGE OF PAVEMENT	
EDGE OF GRAVEL	
LOT AND BLOCK BOUNDARIES	
OVER POWER	
BURIED POWER CABLE/DUCT	
BURIED PIPELINE	
BURIED GAS	

BURIED BELL CABLE/DUCT	
BURIED TELUS CABLE/DUCT	
BURIED FIBRE OPTIC CABLE	
TRAFFIC CONTROL	
WATER	
SEWER DRAIN	
SEWER SANITARY	
FENCE	
PROPOSED CITYWEST CABLE IN EXISTING MONARCH DUCT	

RIGHT-OF-WAY BOUNDARIES	
DIRECTIONAL BORE	
STREET LIGHT POLE	
POWER POLE	
TRAFFIC CONTROL POLE	
CULVERT	
RAIL CROSSING LIGHTS	
RAIL TRACKS	

<b>ASBUILT</b>		
DATE	5/DEC/06	REV 1



248 - 3rd Avenue West  
Prince Rupert, B.C.  
Canada V8J 1L1

Project: **CITYWEST  
TERRACE TO PRINCE RUPERT  
FIBRE OPTIC BUILD**

Location: Terrace to Prince Rupert


Rev.	dd/mm/yy	Revision/Issue Description	Drn.	App.
1	05/12/06	Asbuilt	PM	BM
0	02/06/06	MOT Permit Drawing Prince Rupert Extension	PM	BM

Prepared for / by:  
Suite 1200,  
1067 West Cordova Street  
Vancouver, B.C.  
Canada V6C 7C7




**DISCLAIMER:**  
THE LOCATIONS OF ALL UTILITIES—INCLUDING THE CITYWEST FIBER OPTIC LINE—SHOWN ON THIS DRAWING ARE FOR REFERENCE AND PLANNING PURPOSES ONLY. LEDCOR TECHNICAL SERVICES HEREBY DISCLAIMS ANY RESPONSIBILITY TO THIRD PARTIES FOR THE ACCURACY OF THIS INFORMATION. PERSONS WORKING IN THE AREA COVERED BY THIS DRAWING MUST CONTACT THE APPROPRIATE CALL-BEFORE-YOU-DIG SYSTEM TO ASCERTAIN THE LOCATION OF ALL UNDERGROUND UTILITIES PRIOR TO PERFORMING ANY EXCAVATION.


Project ID: Terrace to Prince Rupert - Fibre Optic Build			
Ledcor Technical Services Project No.: 5080004			
Scale:	Designed by: BS	Rev.	<b>1</b>
Horiz. -	Drawn by: PM		
Vert. -	Approved by: BM		
Date: June 06, 2006	Acad File: LTS05-1353-ENG02.DWG	Sheet No: B1	

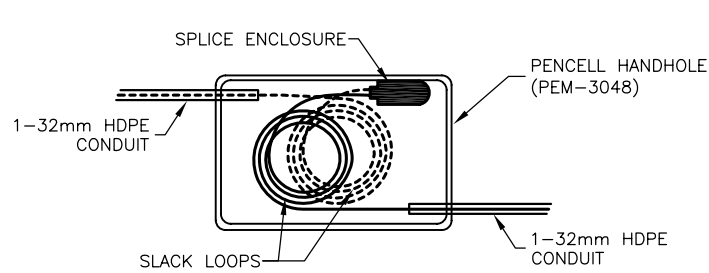


**TYPICAL CABLE SPLICE HANDHOLE DETAIL** (2) NOT TO SCALE

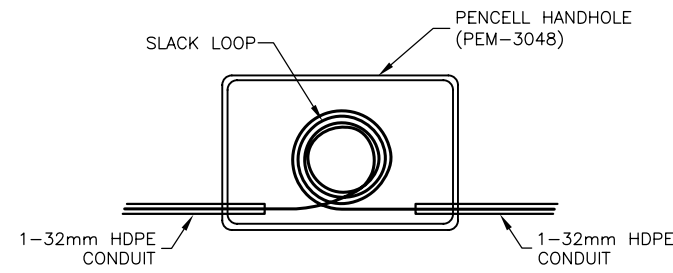


**TYPICAL CABLE SLACK HANDHOLE DETAIL** (2) NOT TO SCALE

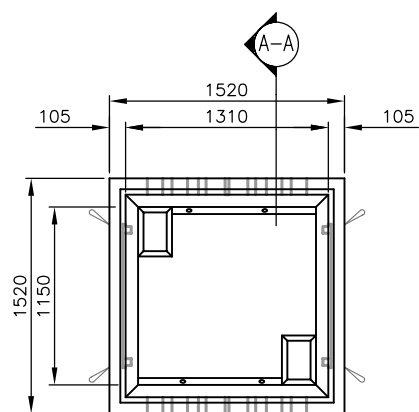

**PLAN VIEW**

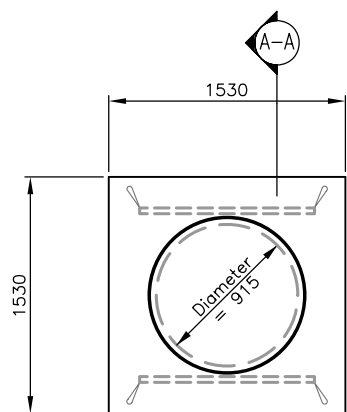


**PLAN VIEW WITH LID SLAB**

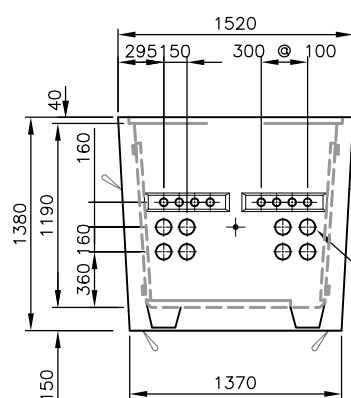


**ELEVATION A**

**SERVICE VAULT 1.5 X 1.5** (1) NOT TO SCALE

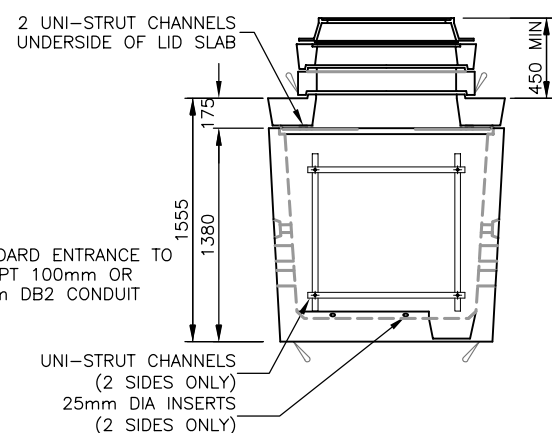


**SECTION A-A**


1 : 50

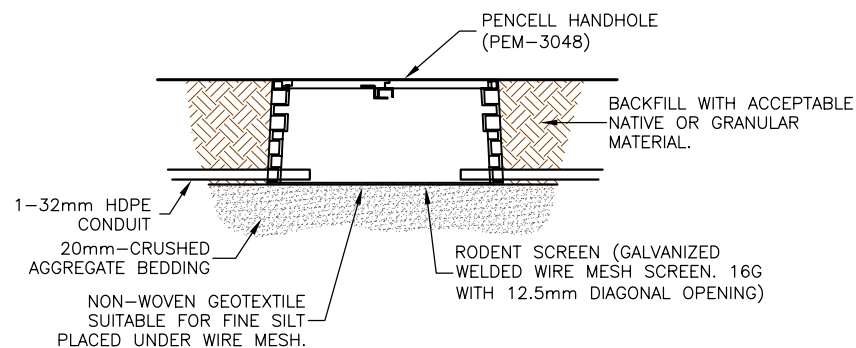

**TYPICAL HANDHOLE PLACEMENT DETAIL** (2) NOT TO SCALE

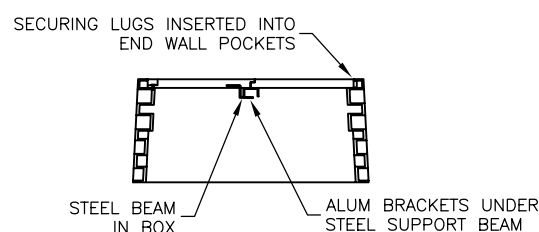

**PENCIL HANDHOLE DETAIL (PEM-3048)** (2) NOT TO SCALE

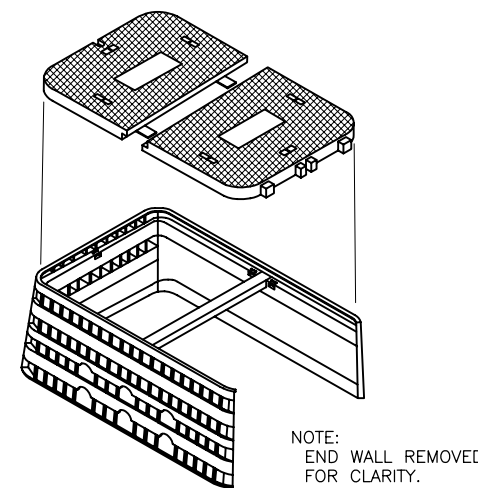

**HANDHOLE ISO DETAIL** NOT TO SCALE

<b>ASBUILT</b>		
DATE	5/DEC/06	REV 1



248 - 3rd Avenue West  
Prince Rupert, B.C.  
Canada V8J 1L1

Project: **CITYWEST TERRACE TO PRINCE RUPERT FIBRE OPTIC BUILD**

Location: Terrace to Prince Rupert


Rev.	dd/mm/yy	Revision/Issue Description	Drn.	App.
1	05/12/06	Asbuilt	PM	BM
0	02/06/06	MOT Permit Drawing Prince Rupert Extension	PM	BM

Prepared for / by:  
Suite 1200,  
1067 West Cordova Street  
Vancouver, B.C.  
Canada V6C 7C7




**DISCLAIMER:**  
THE LOCATIONS OF ALL UTILITIES—INCLUDING THE CITYWEST FIBER OPTIC LINE—SHOWN ON THIS DRAWING ARE FOR REFERENCE AND PLANNING PURPOSES ONLY. LEDCOR TECHNICAL SERVICES HEREBY DISCLAIMS ANY RESPONSIBILITY TO THIRD PARTIES FOR THE ACCURACY OF THIS INFORMATION. PERSONS WORKING IN THE AREA COVERED BY THIS DRAWING MUST CONTACT THE APPROPRIATE CALL-BEFORE-YOU-DIG SYSTEM TO ASCERTAIN THE LOCATION OF ALL UNDERGROUND UTILITIES PRIOR TO PERFORMING ANY EXCAVATION.

Project ID: Terrace to Prince Rupert - Fibre Optic Build			
Ledcor Technical Services Project No.: 5080004			
Scales:	Horiz. AS SHOWN	Designed by: BS	Rev. <b>1</b>
	Vert.	Drawn by: PM	
		Approved by: BM	
Date: June 06, 2006	Acad File: LTS05-1353-ENG02.DWG	Sheet No: B2	

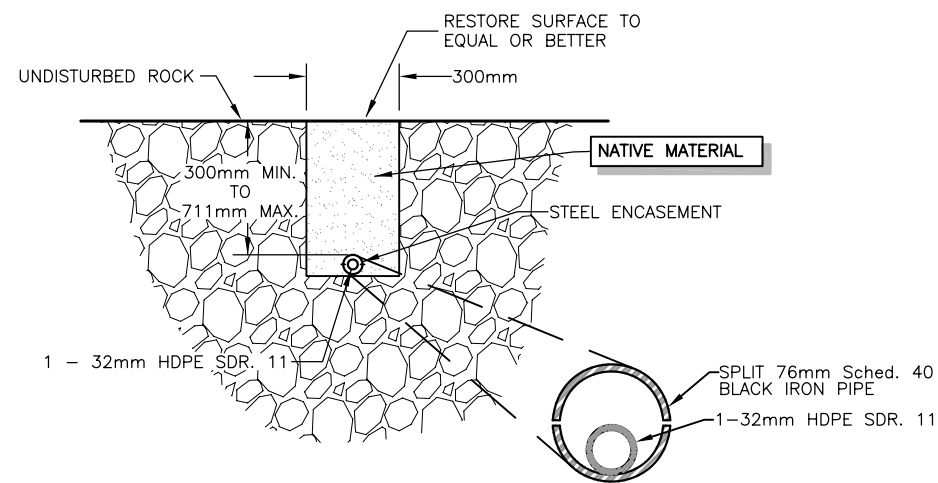


**1 - 32mm HDPE SDR. 11  
STEEL ENCASEMENT DETAIL**

1 : 25

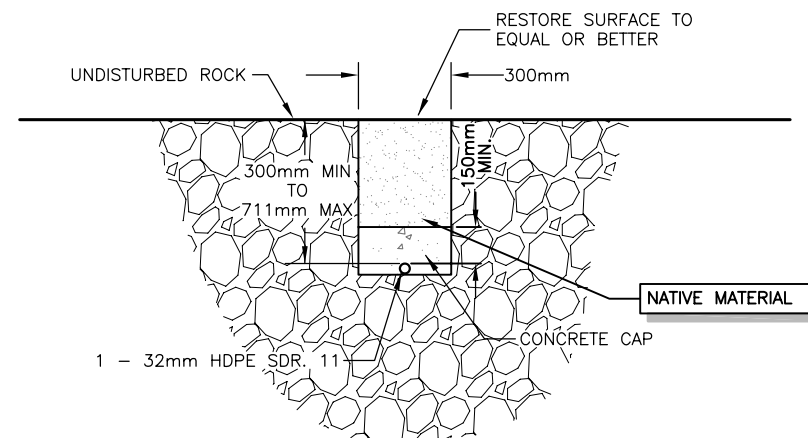


**1 - 32mm HDPE SDR. 11  
CONCRETE CAP DETAIL**

1 : 25

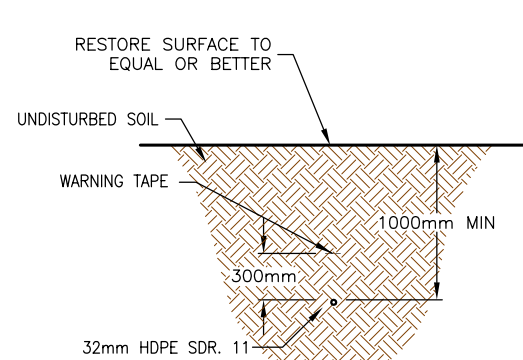


**1 - 32mm HDPE SDR. 11  
PLOW DETAIL**

1 : 50

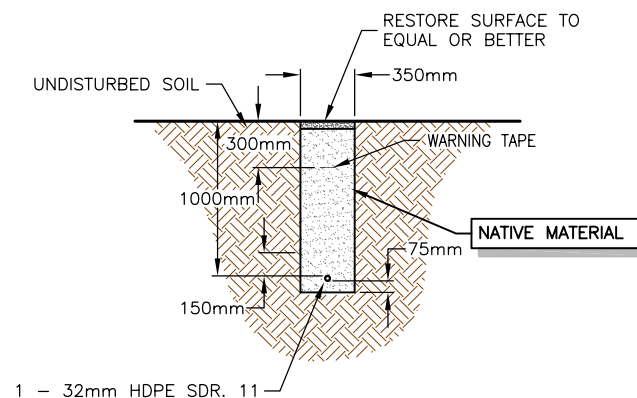

**NON-TRAVELLED  
1 - 32mm HDPE SDR. 11  
DIRECT BURIED TRENCH DETAIL**

1 : 50

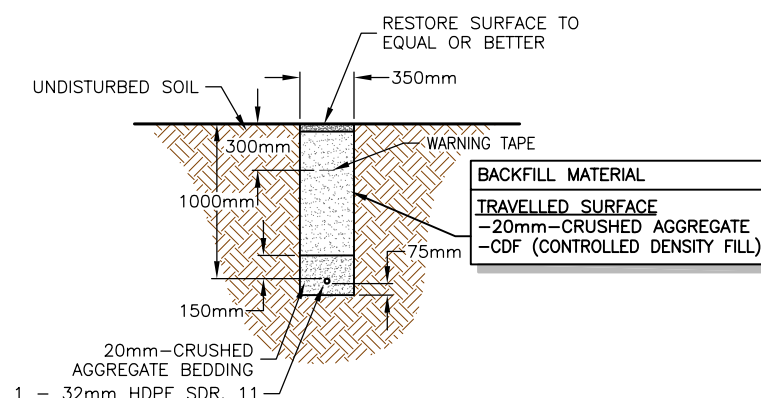

**TRAVELLED  
1 - 32mm HDPE SDR. 11  
DIRECT BURIED TRENCH DETAIL**

1 : 50

<b>ASBUILT</b>		
DATE	5/DEC/06	REV 1



248 - 3rd Avenue West  
Prince Rupert, B.C.  
Canada V8J 1L1

Project: **CITYWEST  
TERRACE TO PRINCE RUPERT  
FIBRE OPTIC BUILD**

Location: Terrace to Prince Rupert

Rev.	dd/mm/yy	Revision/Issue Description	Drn.	App.
1	05/12/06	Asbuilt	PM	BM
0	02/06/06	MOT Permit Drawing Prince Rupert Extension	PM	BM

Prepared for / by:  
Suite 1200,  
1067 West Cordova Street  
Vancouver, B.C.  
Canada V6C 7C7



**DISCLAIMER:**  
THE LOCATIONS OF ALL UTILITIES—INCLUDING THE CITYWEST FIBER OPTIC LINE—SHOWN ON THIS DRAWING ARE FOR REFERENCE AND PLANNING PURPOSES ONLY. LEDCOR TECHNICAL SERVICES HEREBY DISCLAIMS ANY RESPONSIBILITY TO THIRD PARTIES FOR THE ACCURACY OF THIS INFORMATION. PERSONS WORKING IN THE AREA COVERED BY THIS DRAWING MUST CONTACT THE APPROPRIATE CALL-BEFORE-YOU-DIG SYSTEM TO ASCERTAIN THE LOCATION OF ALL UNDERGROUND UTILITIES PRIOR TO PERFORMING ANY EXCAVATION.

Project ID: Terrace to Prince Rupert - Fibre Optic Build			
Ledcor Technical Services Project No.: 5080004			
Scale:	Designed by: BS	Rev.	<b>1</b>
Horiz. AS SHOWN	Drawn by: PM		
Vert.	Approved by: BM		
Date: June 06, 2006	Acad File: LTS05-1353-ENG02.DWG	Sheet No: B3	

## CABLE CUTTING LENGTHS

Section	Cable	From	Duct/Aerial	Structure	Duct/Aerial	Structure	Duct/Aerial	Structure	Duct/Aerial	Structure	Duct/Aerial	Structure	Duct/Aerial	Structure	Duct/Aerial
		Length	Length	Length	Length	Length	Length	Length	Length	Length	Length	Length	Length	Length	Length
#31 - Sheets 361-370 CWHH-129 to CWMH-04	156f	HH-129	1181.0	HH-130	1006.0	HH-131	563.0	HH-132	165.0	MH#01	252.0	MH#02	198.0	MH#03	75.0
		39.0		30.0		30.0		28.0		27.0		5.0		16.0	
		MH#04	40.0												
														Sub Total	3655.0

#32 - Sheets 370 CWMH-07 to CO	204f	MH#04	227.0	MH#05	41.0	MH#06	226.0	MH#07	55.0	CO					
		40.0		17.0		14.0		23.0		17.0					
														Sub Total	660.0

SPLICE LOCATION

<b>ASBUILT</b>	
DATE <b>05/DEC/06</b>	REV <b>1</b>



248 - 3rd Avenue West  
Prince Rupert, B.C.  
Canada V8J 1L1

Project: **CITYWEST  
TERRACE TO PRINCE RUPERT  
FIBRE OPTIC BUILD**

Location: Terrace to Prince Rupert

Rev.	dd/mm/yy	Revision/Issue Description	Drn.	App.
1	05/12/06	Asbuilt	PM	BM
0	02/06/06	MOT Permit Drawing Prince Rupert Extension	PM	BM

Prepared for / by:  
Suite 1200,  
1067 West Cordova Street  
Vancouver, B.C.  
Canada V6C 7C7

**DISCLAIMER:**  
THE LOCATIONS OF ALL UTILITIES--INCLUDING THE CITYWEST FIBER OPTIC LINE-- SHOWN ON THIS DRAWING ARE FOR REFERENCE AND PLANNING PURPOSES ONLY. LEDCOR TECHNICAL SERVICES HEREBY DISCLAIMS ANY RESPONSIBILITY TO THIRD PARTIES FOR THE ACCURACY OF THIS INFORMATION. PERSONS WORKING IN THE AREA COVERED BY THIS DRAWING MUST CONTACT THE APPROPRIATE CALL-BEFORE-YOU-DIG SYSTEM TO ASCERTAIN THE LOCATION OF ALL UNDERGROUND UTILITIES PRIOR TO PERFORMING ANY EXCAVATION.

Project ID: Terrace to Prince Rupert - Fibre Optic Build		
Ledcor Technical Services Project No.: 5080004		
Scales:	Designed by: BS	Rev.
Horiz. AS SHOWN	Drawn by: PM	<b>1</b>
Vert.	Approved by: BM	
Date: June 6, 2006	Acad File: LTS05-1353-ENG02.DWG	Sheet No: C1



# BILL OF MATERIALS - SEGMENT 6 (Extension)

	MATERIALS	SHEET #										TOTAL			
		361	362	363	364	365	366	367	368	369	370				
UNDERGROUND	CONDUIT	32mm HDPE SDR-11	400	400	450	400	400	400	400	350				3200	
		100mm HDPE SDR-11													
		100mm SCHED. 40 B.I.P.													
		SCHED PCI-SD25-10 SPLIT (2 1/2")													
		HANDHOLE - PEM-3048-PCX-20K LID				1				1	1				3
		MANHOLE 1.5m X 1.5m													
		WARNING TAPE (m)	400	400	450	400	400	400	400	350					3200
		BURIED CABLE MARKER POST	1	1	1	1	1	1	1	1					8
		GROUND RODS/PLATE													
		E-LOC COUPLER 100mm DB2 HDPE													
		E-LOC COUPLER 32mm HDPE SDR-11	1	1	1	1	1	1	1	1					8
		CABLE	156 SMF28 FIBRE OPTIC CABLE	400	400	450	400	400	400	400	350	350			3550
204 SMF28 FIBRE OPTIC CABLE											660		660		
CABLE TAGS											4		4		
SPLICE	RAYCHEM TYPE "B" CLOSURE														
	SPLICE TRAYS														
BRIDGE	GSP PCI-2-120-GECS (10' LENGTH)														
	ELBOW - GSP 90' 50mm (2")														
	BONDING JUMPER														
	EXPANSION COUPLER														
	PIPE CLAMP														
	PIPE SPACER														

<b>ASBUILT</b>		
DATE	16/OCT/06	REV 3



248 - 3rd Avenue West  
Prince Rupert, B.C.  
Canada V8J 1L1

**Project:**  
**CITYWEST**  
**TERRACE TO PRINCE RUPERT**  
**FIBRE OPTIC BUILD**

**Location:** Terrace to Prince Rupert


Rev.	dd/mm/yy	Revision/Issue Description	Drn.	App.
3	16/10/06	Asbuilt	PM	BM
2	21/12/05	Issued for Construction	LB	CB
1	28/11/05	Ministry Of Transportation Submission	LB	CB
0	08/10/05	Preliminary Drawing	LB	CB

Prepared for / by:  
Suite 1200,  
1067 West Cordova Street  
Vancouver, B.C.  
Canada V6C 7C7




**DISCLAIMER:**  
THE LOCATIONS OF ALL UTILITIES-INCLUDING THE CITYWEST FIBER OPTIC LINE-SHOWN ON THIS DRAWING ARE FOR REFERENCE AND PLANNING PURPOSES ONLY. LEDCOR TECHNICAL SERVICES HEREBY DISCLAIMS ANY RESPONSIBILITY TO THIRD PARTIES FOR THE ACCURACY OF THIS INFORMATION. PERSONS WORKING IN THE AREA COVERED BY THIS DRAWING MUST CONTACT THE APPROPRIATE CALL-BEFORE-YOU-DIG SYSTEM TO ASCERTAIN THE LOCATION OF ALL UNDERGROUND UTILITIES PRIOR TO PERFORMING ANY EXCAVATION.

Project ID: Terrace to Prince Rupert - Fibre Optic Build			
Ledcor Technical Services Project No.: 5080004			
Scales:	Designed by: MH	Rev.	
Horiz.	Drawn by: LB		<b>3</b>
Vert.	Approved by: CB		
Date:	Acad File:	Sheet No:	
December 21, 2005	LTS05-1353-ENG02.DWG	C2	

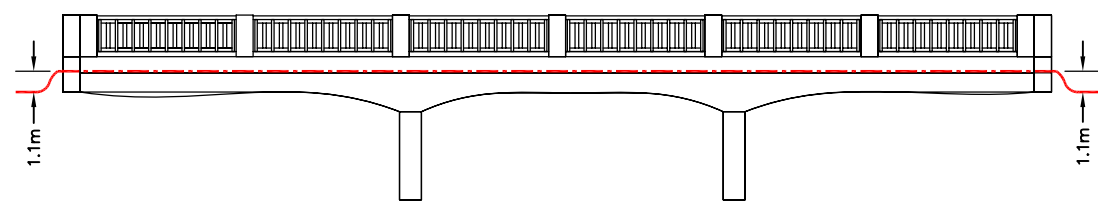

**PROFILE A – SIDEVIEW  
FACING SOUTH SIDE**  
N.T.S.

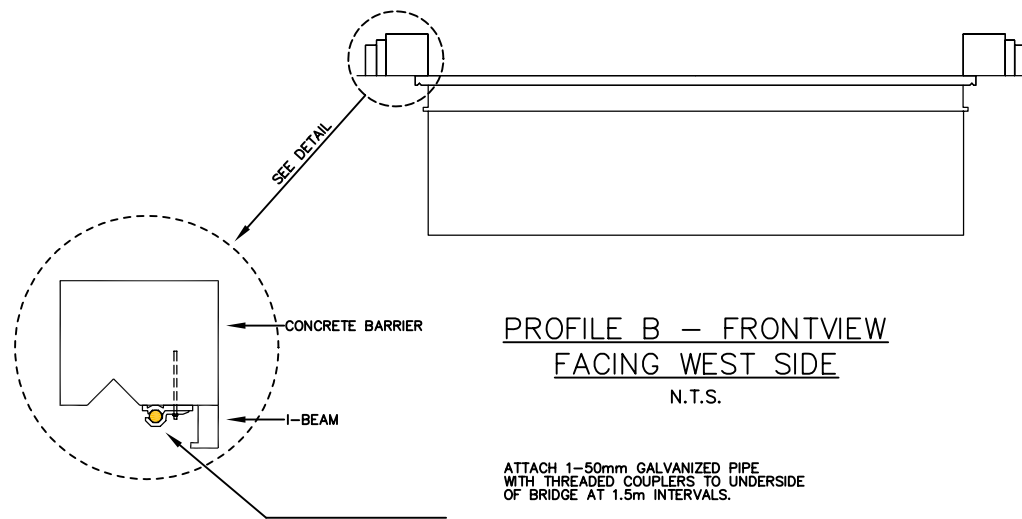


**PROFILE B – FRONTVIEW  
FACING WEST SIDE**  
N.T.S.

ATTACH 1-50mm GALVANIZED PIPE WITH THREADED COUPLERS TO UNDERSIDE OF BRIDGE AT 1.5m INTERVALS.

**NOTES:**

USE THOMAS AND BETTS CONDUIT FITTINGS #1281 (PIPE STRAP) AND #1351 (PIPE SPACER) WITH STAINLESS STEEL ANCHORS AT 1.5m INTERVALS

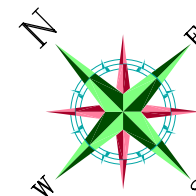

<b>ASBUILT</b>		
DATE	5/DEC/06	REV 1



248 - 3rd Avenue West  
Prince Rupert, B.C.  
Canada V8J 1L1

**Project:**  
**CITYWEST  
TERRACE TO PRINCE RUPERT  
FIBRE OPTIC BUILD**

**Location:** Terrace to Prince Rupert

Rev.	dd/mm/yy	Revision/Issue Description	Drn.	App.
1	05/12/06	Asbuilt	PM	BM
0	06/06/06	McClymont Bridge Design for Approval	PM	BM

Prepared by:

500 - 4th Ave SW,  
Calgary, Alberta.  
Canada T2P 2V6



**DISCLAIMER:**

THE LOCATIONS OF ALL UTILITIES—INCLUDING THE CITYWEST FIBER OPTIC LINE—SHOWN ON THIS DRAWING ARE FOR REFERENCE AND PLANNING PURPOSES ONLY. LEDCOR TECHNICAL SERVICES HEREBY DISCLAIMS ANY RESPONSIBILITY TO THIRD PARTIES FOR THE ACCURACY OF THIS INFORMATION. PERSONS WORKING IN THE AREA COVERED BY THIS DRAWING MUST CONTACT THE APPROPRIATE CALL-BEFORE-YOU-DIG SYSTEM TO ASCERTAIN THE LOCATION OF ALL UNDERGROUND UTILITIES PRIOR TO PERFORMING ANY EXCAVATION.

Project ID: Terrace to Prince Rupert – Fibre Optic Build

LTS Project No.: 5080004


Scales:	Horiz. 1 : 1,500	Vert.	Designed by: BS	Rev.
			Drawn by: PM	<b>1</b>
			Approved by: BM	

Date: JUNE 6, 2006	Acad File: LTS06-5080004-DWG001	Sheet No: D-35
--------------------	---------------------------------	----------------






**THOMAS & BETTS PIPE CLAMP  
T&B PART #1281**

N.T.S.

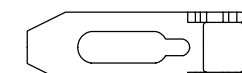

**THOMAS & BETTS PIPE SPACER  
T&B PART #1351**



N.T.S.

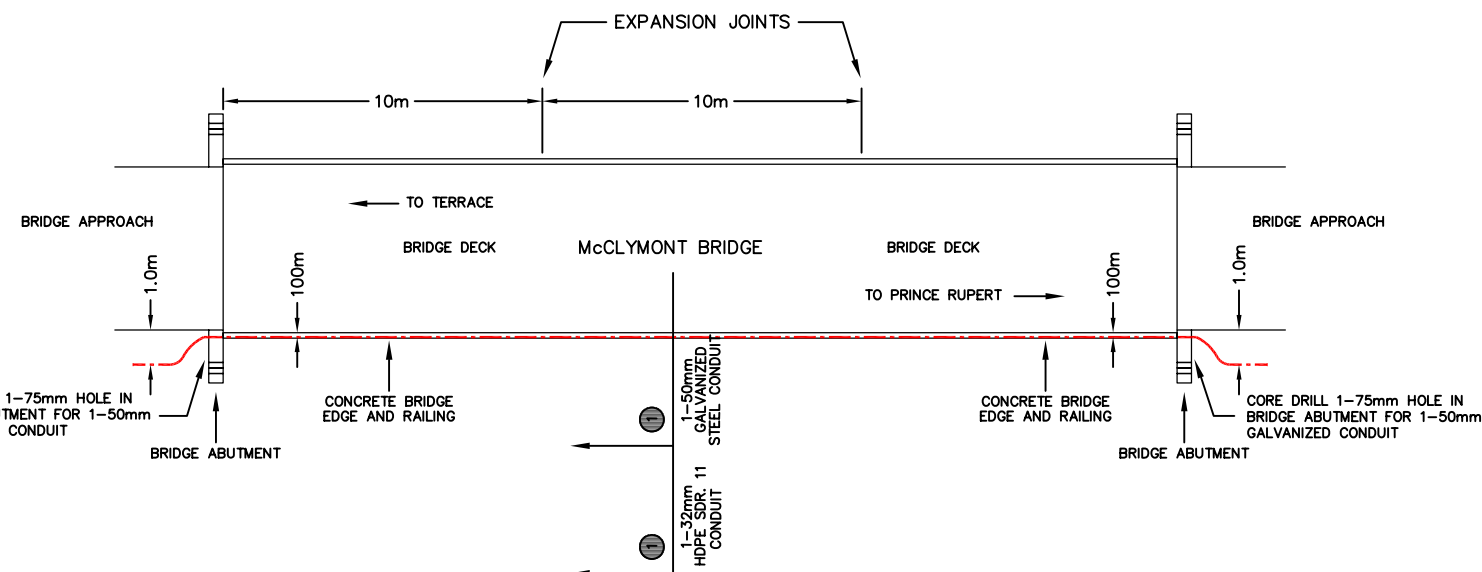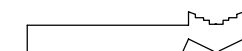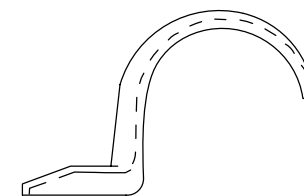

**PROFILE C – TOPVIEW**  
N.T.S.

**CONSTRUCTION NOTES:**

1. ALL HOLES AND PENETRATIONS INTO CONCRETE AND STEEL, BOTH USED AND ABANDONED ARE TO BE SEALED AGAINST MOISTURE INGRESS.
2. ALL ABANDONED HOLES IN CONCRETE MUST BE FILLED WITH NON SHRINK GROUT.
3. A MAGNETIC REBAR DETECTOR, SUCH AS A PACHOMETER, MUST BE USED TO ENSURE HOLES DRILLED IN REINFORCED CONCRETE DO NOT COINCIDE WITH ANY REINFORCED STEEL.
4. DIAMOND TIPPED DRILL BITS MUST NOT BE USED TO DRILL HOLES FOR HANGER INSERTS.

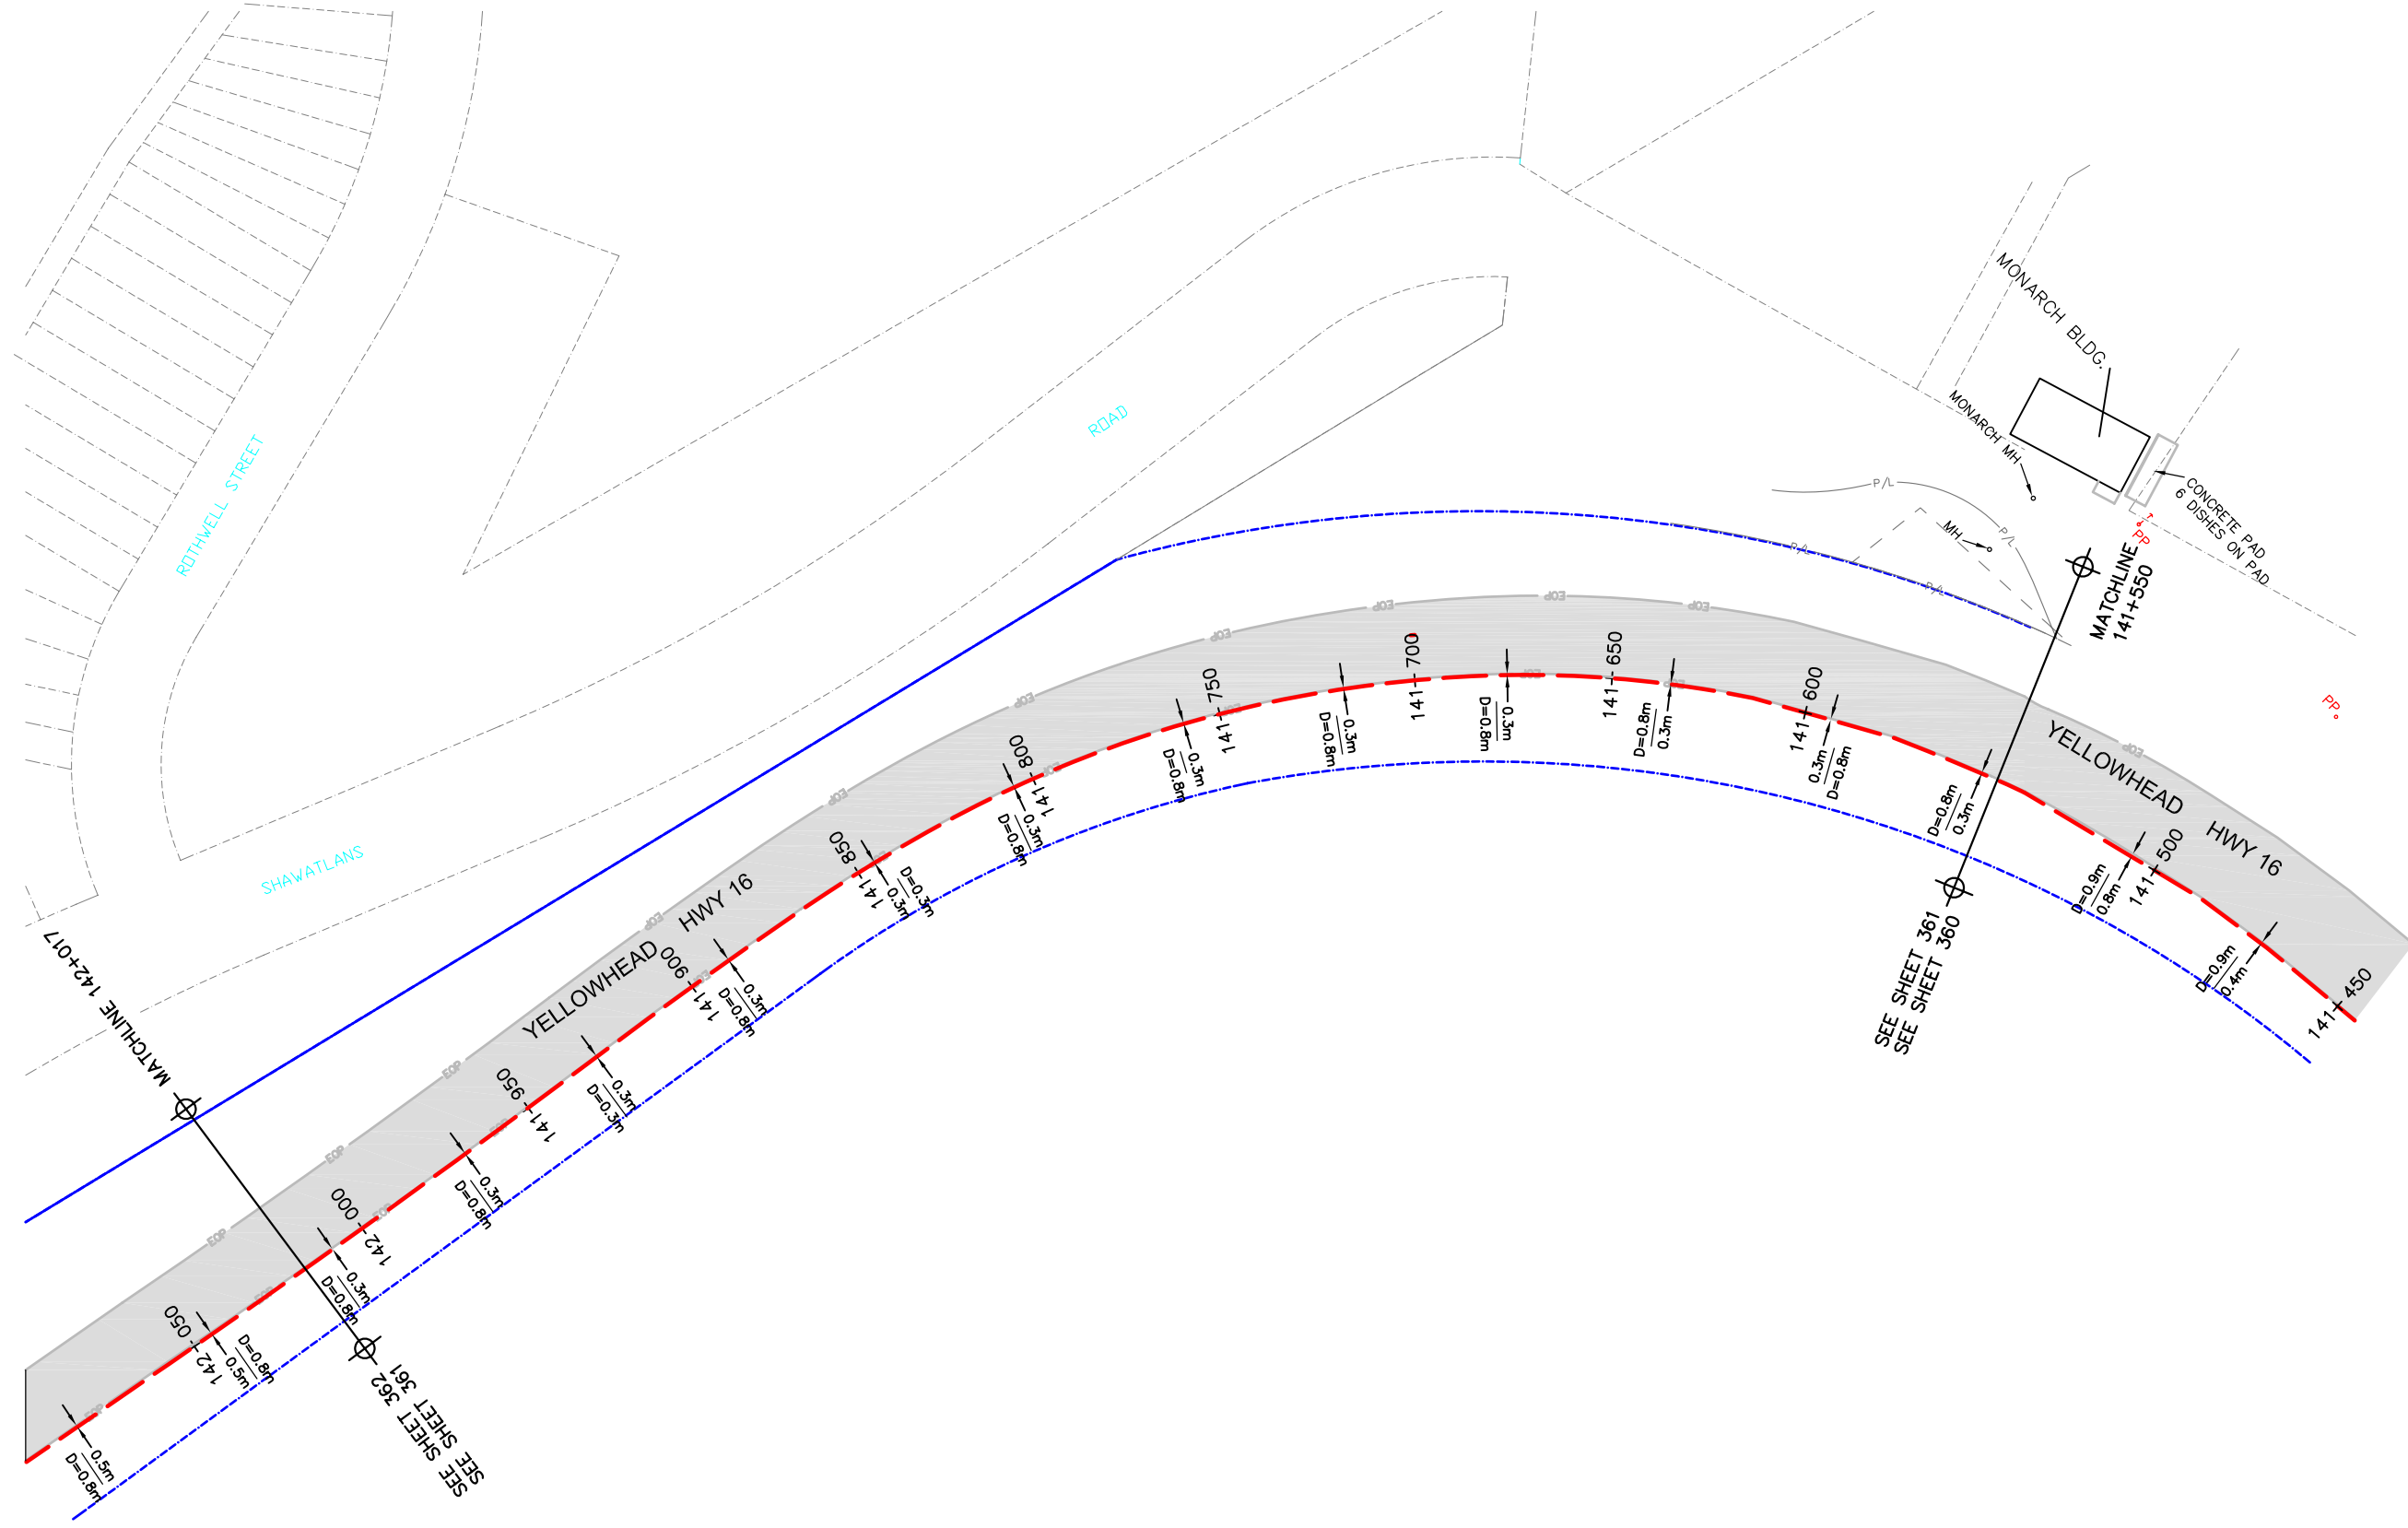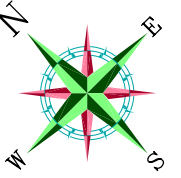

<b>ASBUILT</b>		
DATE	5/DEC/06	REV 1

**CityWest**

248 - 3rd Avenue West  
Prince Rupert, B.C.  
Canada V8J 1L1

Project: **CITYWEST TERRACE TO PRINCE RUPERT FIBRE OPTIC BUILD**

Location: Terrace to Prince Rupert


Rev.	dd/mm/yy	Revision/Issue Description	Drn.	App.
1	05/12/06	Asbuilt	PM	BM
0	02/06/06	MOT Permit Drawing Prince Rupert Extension	PM	BM

Prepared by:  
500 - 4th Ave SW,  
Calgary, Alberta.  
Canada T2P 2V6

**DISCLAIMER:**  
THE LOCATIONS OF ALL UTILITIES—INCLUDING THE CITYWEST FIBRE OPTIC LINE—SHOWN ON THIS DRAWING ARE FOR REFERENCE AND PLANNING PURPOSES ONLY. LEDCOR TECHNICAL SERVICES HEREBY DISCLAIMS ANY RESPONSIBILITY TO THIRD PARTIES FOR THE ACCURACY OF THIS INFORMATION. PERSONS WORKING IN THE AREA COVERED BY THIS DRAWING MUST CONTACT THE APPROPRIATE CALL-BEFORE-YOU-DIG SYSTEM TO ASCERTAIN THE LOCATION OF ALL UNDERGROUND UTILITIES PRIOR TO PERFORMING ANY EXCAVATION.

Project ID: Terrace to Prince Rupert - Fibre Optic Build			
LTS Project No.: 5080004			
Scale:	Horiz. 1 : 1,500	Designed by: BS	Rev. <b>1</b>
	Vert. -	Drawn by: PM	
		Approved by: BM	
Date: JUNE 6, 2006	Acad File: LTS06-5080004-DWG001	Sheet No: 361	



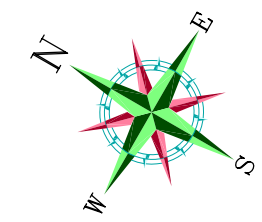

<b>ASBUILT</b>		
DATE	5/DEC/06	REV 1

**CityWest**

248 - 3rd Avenue West  
Prince Rupert, B.C.  
Canada V8J 1L1

Project: **CITYWEST  
TERRACE TO PRINCE RUPERT  
FIBRE OPTIC BUILD**

Location: Terrace to Prince Rupert

Rev.	dd/mm/yy	Revision/Issue Description	Drn.	App.
1	05/12/06	Asbuilt	PM	BM
0	02/06/06	MOT Permit Drawing Prince Rupert Extension	PM	BM



Prepared by:

500 - 4th Ave SW,  
Calgary, Alberta.  
Canada T2P 2V6

**DISCLAIMER:**

THE LOCATIONS OF ALL UTILITIES—INCLUDING THE CITYWEST FIBER OPTIC LINE—SHOWN ON THIS DRAWING ARE FOR REFERENCE AND PLANNING PURPOSES ONLY. LEDCOR TECHNICAL SERVICES HEREBY DISCLAIMS ANY RESPONSIBILITY TO THIRD PARTIES FOR THE ACCURACY OF THIS INFORMATION. PERSONS WORKING IN THE AREA COVERED BY THIS DRAWING MUST CONTACT THE APPROPRIATE CALL-BEFORE-YOU-DIG SYSTEM TO ASCERTAIN THE LOCATION OF ALL UNDERGROUND UTILITIES PRIOR TO PERFORMING ANY EXCAVATION.

Project ID: Terrace to Prince Rupert – Fibre Optic Build		
LTS Project No.: 5080004		
Scales:	Designed by: BS	Rev. <b>1</b>
Horiz. 1 : 1,500	Drawn by: PM	
Vert. -	Approved by: BM	
Date: JUNE 6, 2006	Acad File: LTS06-5080004-DWG001	Sheet No: 362

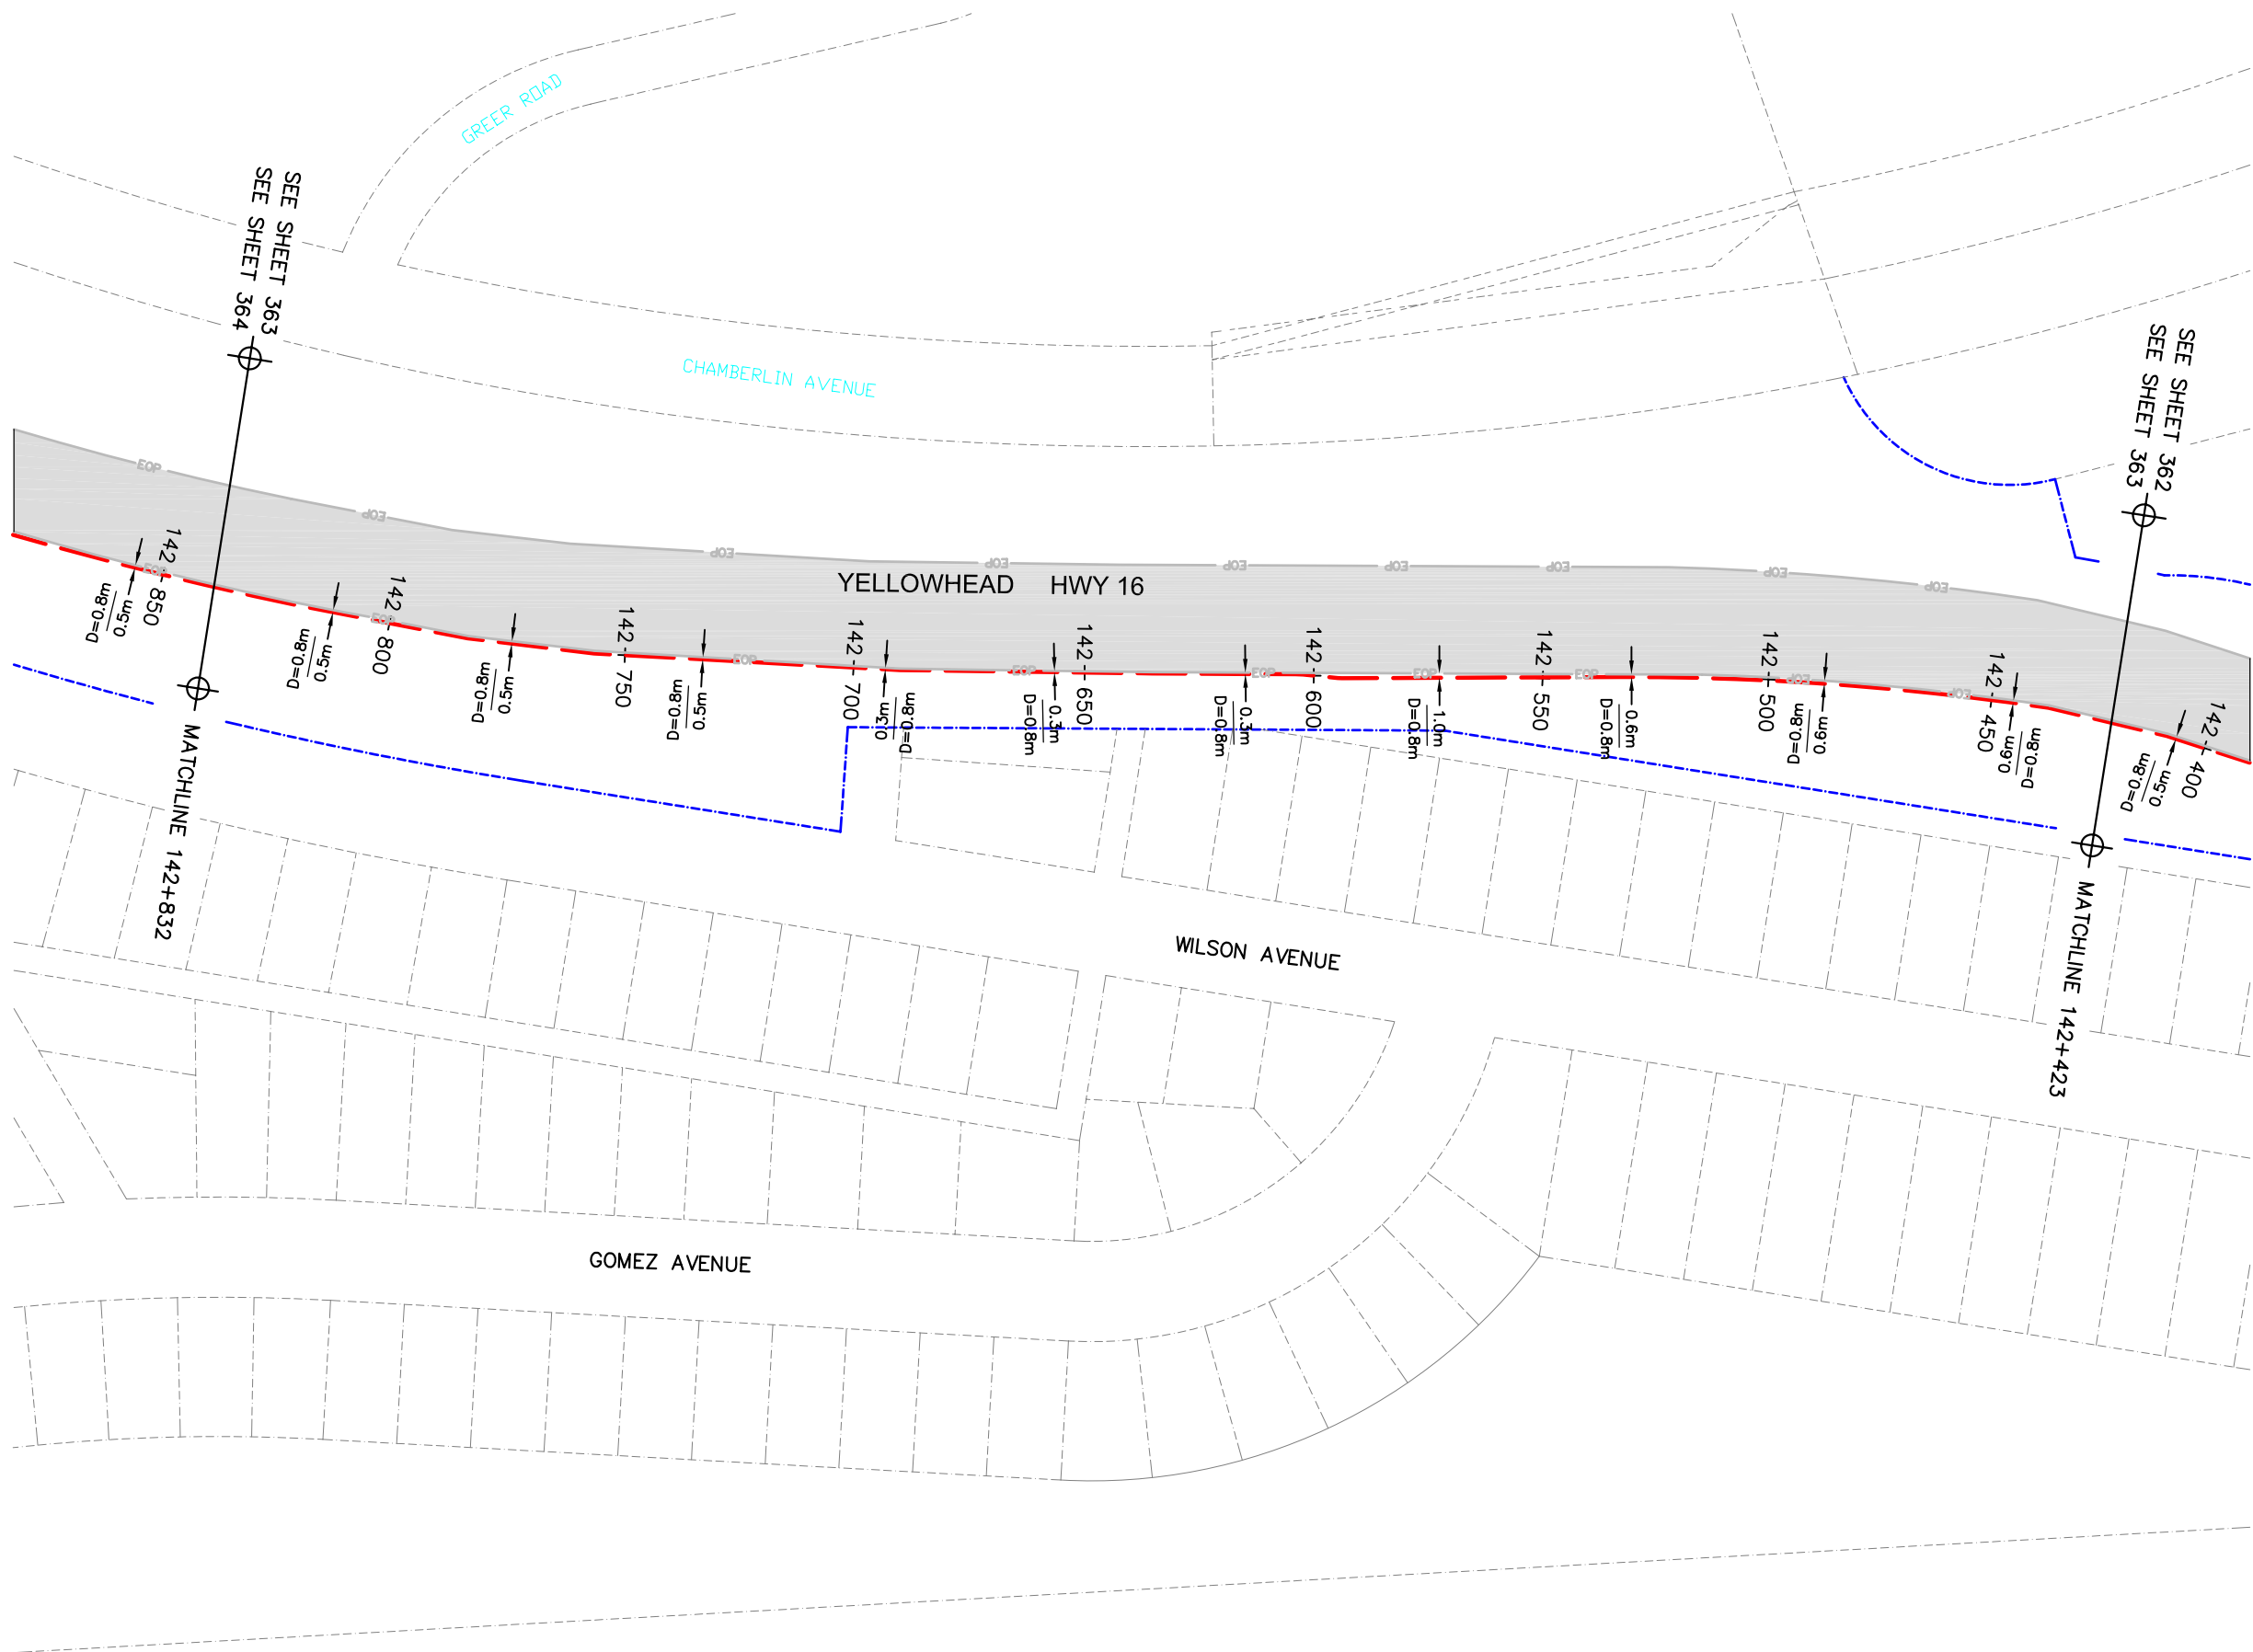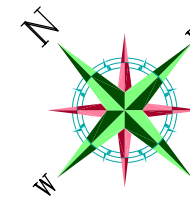

<b>ASBUILT</b>	
DATE	5/DEC/06
REV	1



248 - 3rd Avenue West  
Prince Rupert, B.C.  
Canada V8J 1L1


Project: **CITYWEST  
TERRACE TO PRINCE RUPERT  
FIBRE OPTIC BUILD**

Location: Terrace to Prince Rupert

Rev.	dd/mm/yy	Revision/Issue Description	Drn.	App.
1	05/12/06	Asbuilt	PM	BM
0	02/06/06	MOT Permit Drawing Prince Rupert Extension	PM	BM

Prepared by:



500 - 4th Ave SW,  
Calgary, Alberta.  
Canada T2P 2V6



**DISCLAIMER:**

THE LOCATIONS OF ALL UTILITIES—INCLUDING THE CITYWEST FIBRE OPTIC LINE—SHOWN ON THIS DRAWING ARE FOR REFERENCE AND PLANNING PURPOSES ONLY. LEDCOR TECHNICAL SERVICES HEREBY DISCLAIMS ANY RESPONSIBILITY TO THIRD PARTIES FOR THE ACCURACY OF THIS INFORMATION. PERSONS WORKING IN THE AREA COVERED BY THIS DRAWING MUST CONTACT THE APPROPRIATE CALL-BEFORE-YOU-DIG SYSTEM TO ASCERTAIN THE LOCATION OF ALL UNDERGROUND UTILITIES PRIOR TO PERFORMING ANY EXCAVATION.

Project ID: Terrace to Prince Rupert - Fibre Optic Build		
LTS Project No.: 5080004		
Scales:	Designed by: BS	Rev.
Horiz. 1 : 1,500	Drawn by: PM	<b>1</b>
Vert. -	Approved by: BM	
Date: JUNE 6, 2006	Acad File: LTS06-5080004-DWG001	Sheet No: 363

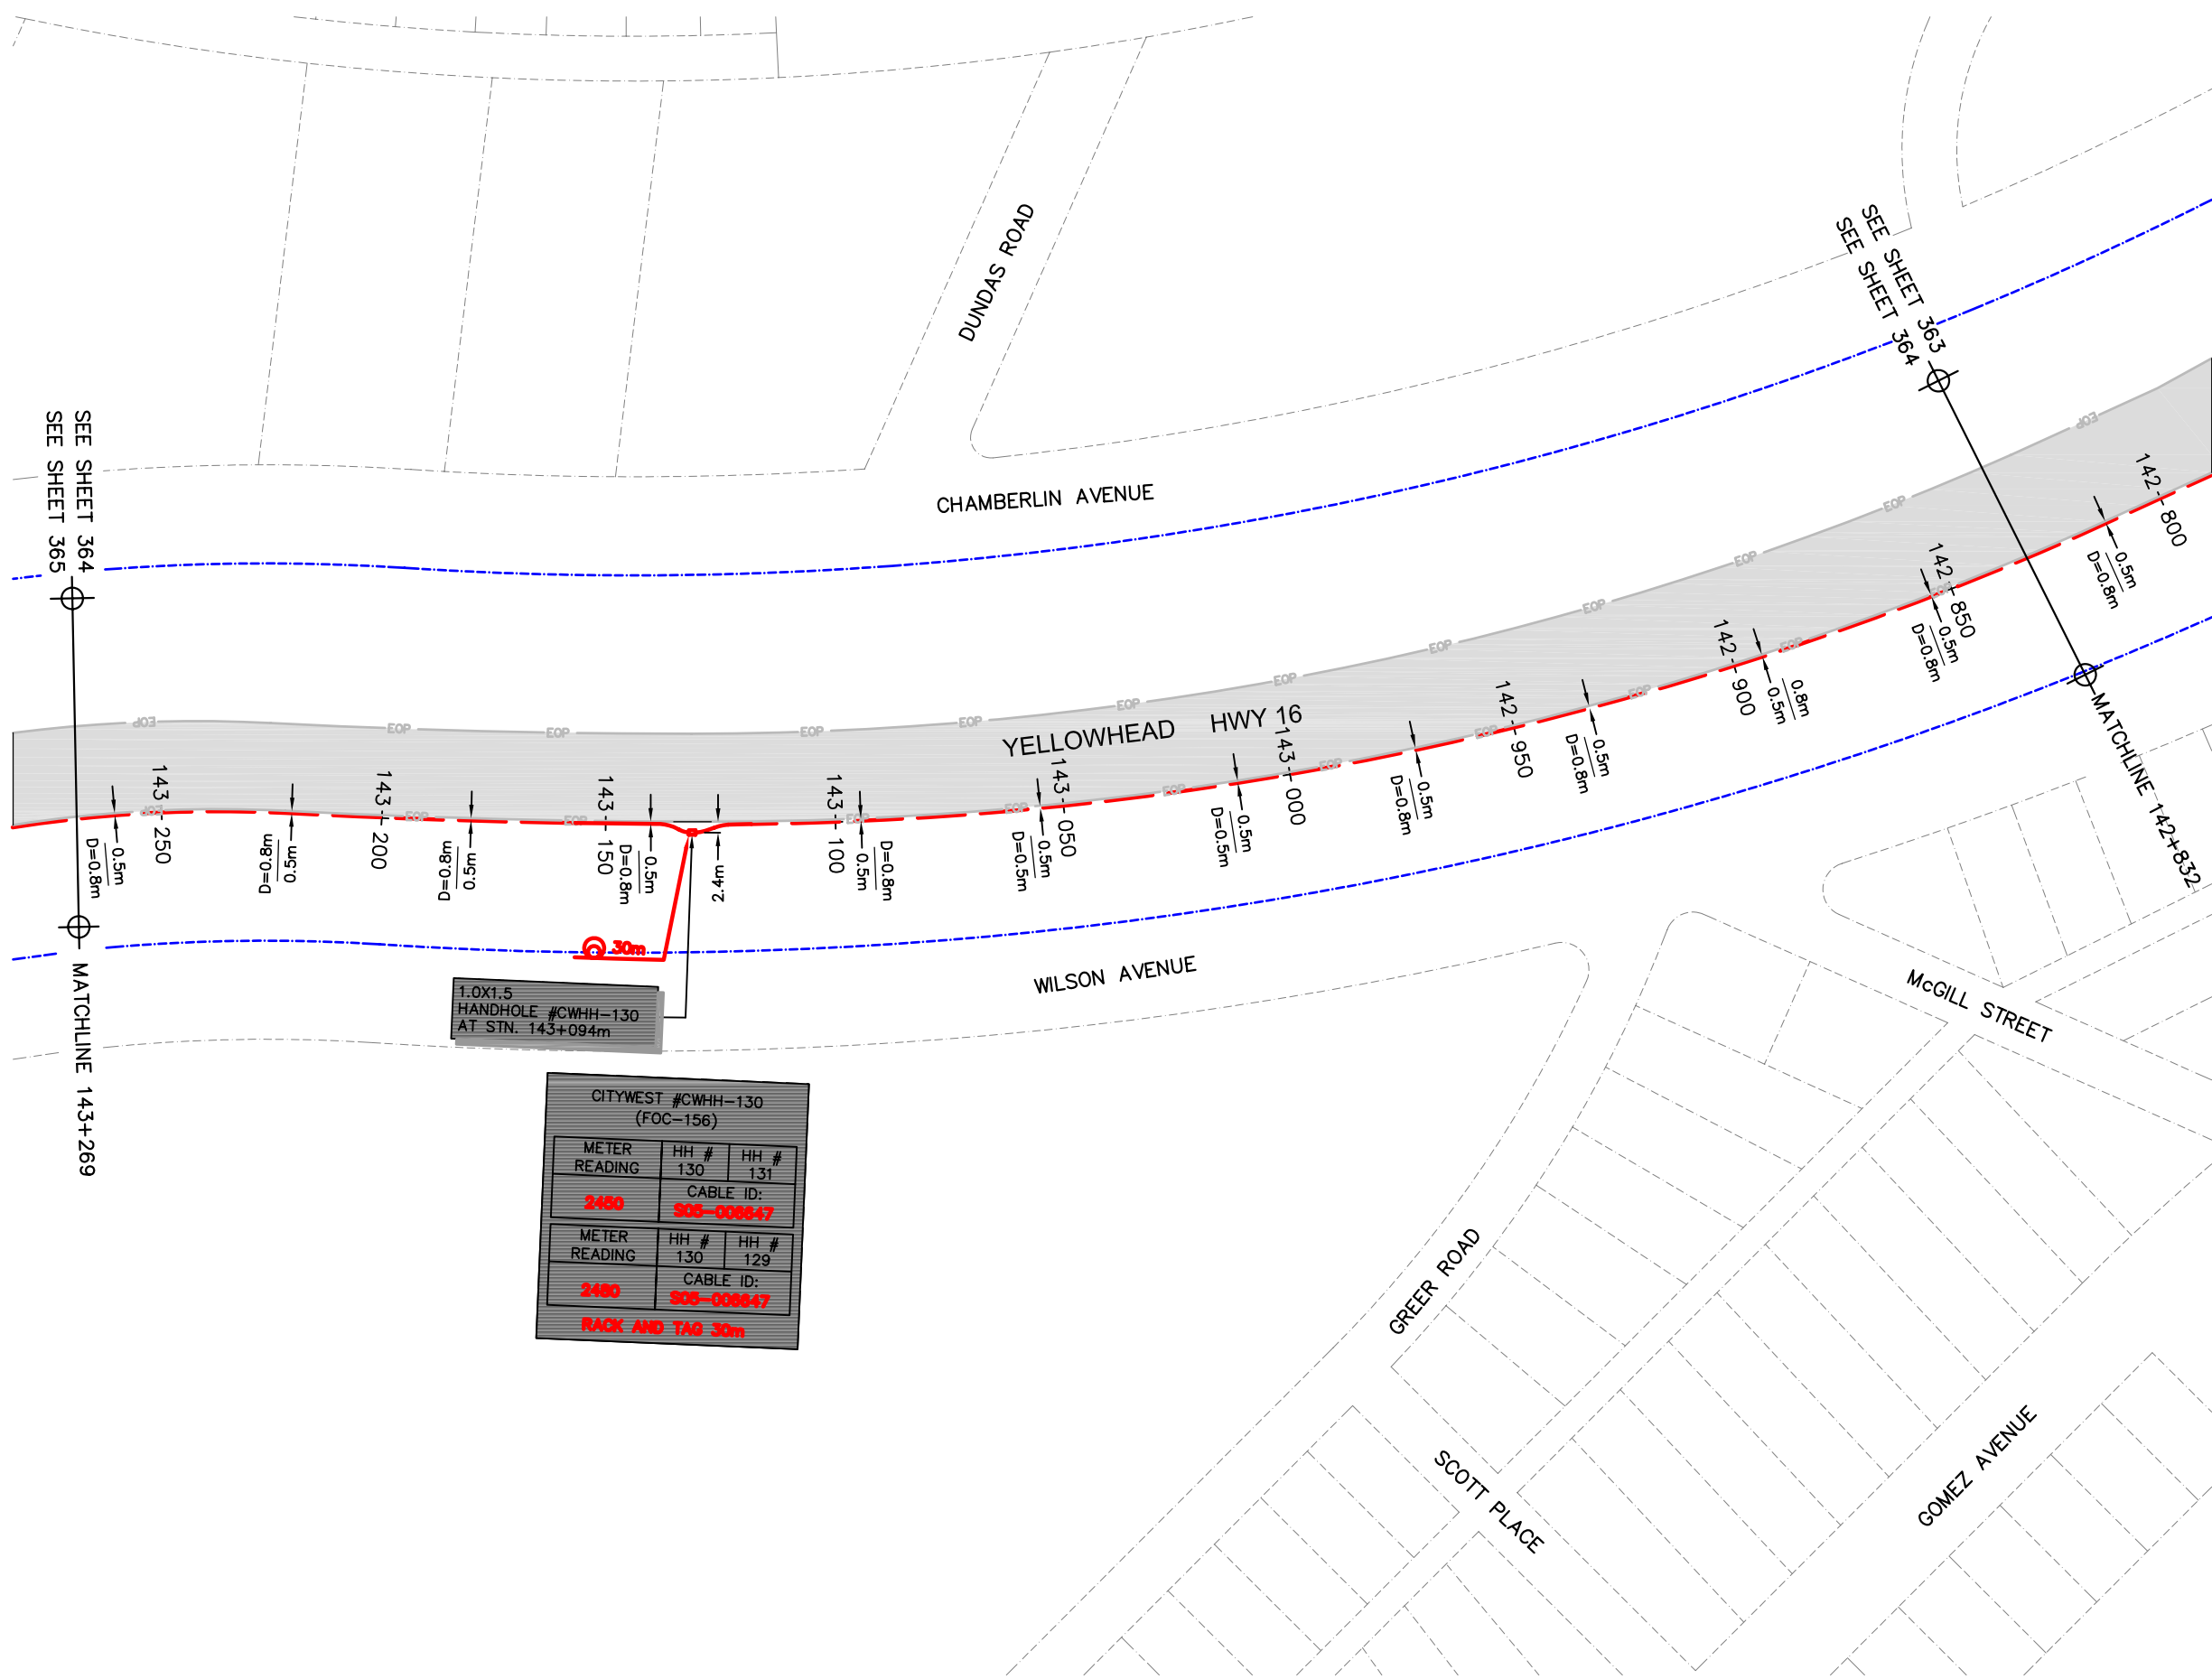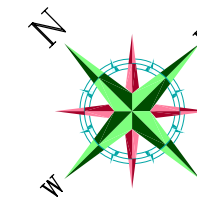

<b>ASBUILT</b>		
DATE	5/DEC/06	REV 1

248 - 3rd Avenue West  
Prince Rupert, B.C.  
Canada V8J 1L1

Project: **CITYWEST TERRACE TO PRINCE RUPERT FIBRE OPTIC BUILD**  
Location: Terrace to Prince Rupert


Rev.	dd/mm/yy	Revision/Issue Description	Drn.	App.
1	05/12/06	Asbuilt	PM	BM
0	02/06/06	MOT Permit Drawing Prince Rupert Extension	PM	BM

Prepared by:  
500 - 4th Ave SW,  
Calgary, Alberta.  
Canada T2P 2V6

**DISCLAIMER:**  
THE LOCATIONS OF ALL UTILITIES—INCLUDING THE CITYWEST FIBER OPTIC LINE—SHOWN ON THIS DRAWING ARE FOR REFERENCE AND PLANNING PURPOSES ONLY. LEDOR TECHNICAL SERVICES HEREBY DISCLAIMS ANY RESPONSIBILITY TO THIRD PARTIES FOR THE ACCURACY OF THIS INFORMATION. PERSONS WORKING IN THE AREA COVERED BY THIS DRAWING MUST CONTACT THE APPROPRIATE CALL-BEFORE-YOU-DIG SYSTEM TO ASCERTAIN THE LOCATION OF ALL UNDERGROUND UTILITIES PRIOR TO PERFORMING ANY EXCAVATION.

CITYWEST #CWHH-130 (FOC-156)		
METER READING	HH #	HH #
2480	130	131
CABLE ID: S05-008647		
METER READING	HH #	HH #
2480	130	129
CABLE ID: S05-008647		
RACK AND TAG 30m		

Project ID: Terrace to Prince Rupert - Fibre Optic Build		
LTS Project No.: 5080004		
Scales:	Designed by: BS	Rev. <b>1</b>
Horiz. 1 : 1,500	Drawn by: PM	
Vert. -	Approved by: BM	
Date: JUNE 6, 2006	Acad File: LTS06-5080004-DWG001	Sheet No: 364

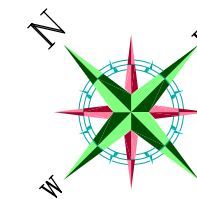

<b>ASBUILT</b>		
DATE	5/DEC/06	REV 1

  
 248 - 3rd Avenue West  
 Prince Rupert, B.C.  
 Canada V8J 1L1

Project: **CITYWEST TERRACE TO PRINCE RUPERT FIBRE OPTIC BUILD**  
 Location: Terrace to Prince Rupert



Rev.	dd/mm/yy	Revision/Issue Description	Drn.	App.
1	05/12/06	Asbuilt	PM	BM
0	02/06/06	MOT Permit Drawing Prince Rupert Extension	PM	BM

Prepared by:  
 500 - 4th Ave SW,  
 Calgary, Alberta.  
 Canada T2P 2V6



**DISCLAIMER:**  
 THE LOCATIONS OF ALL UTILITIES—INCLUDING THE CITYWEST FIBER OPTIC LINE—SHOWN ON THIS DRAWING ARE FOR REFERENCE AND PLANNING PURPOSES ONLY. LEDOR TECHNICAL SERVICES HEREBY DISCLAIMS ANY RESPONSIBILITY TO THIRD PARTIES FOR THE ACCURACY OF THIS INFORMATION. PERSONS WORKING IN THE AREA COVERED BY THIS DRAWING MUST CONTACT THE APPROPRIATE CALL-BEFORE-YOU-DIG SYSTEM TO ASCERTAIN THE LOCATION OF ALL UNDERGROUND UTILITIES PRIOR TO PERFORMING ANY EXCAVATION.

Project ID: Terrace to Prince Rupert - Fibre Optic Build			
LTS Project No.: 5080004			
Scales:	Horiz. 1 : 1,500	Designed by: BS	Rev. <b>1</b>
	Vert. -	Drawn by: PM	
		Approved by: BM	
Date: JUNE 6, 2006	Acad File: LTS06-5080004-DWG001	Sheet No: 365	

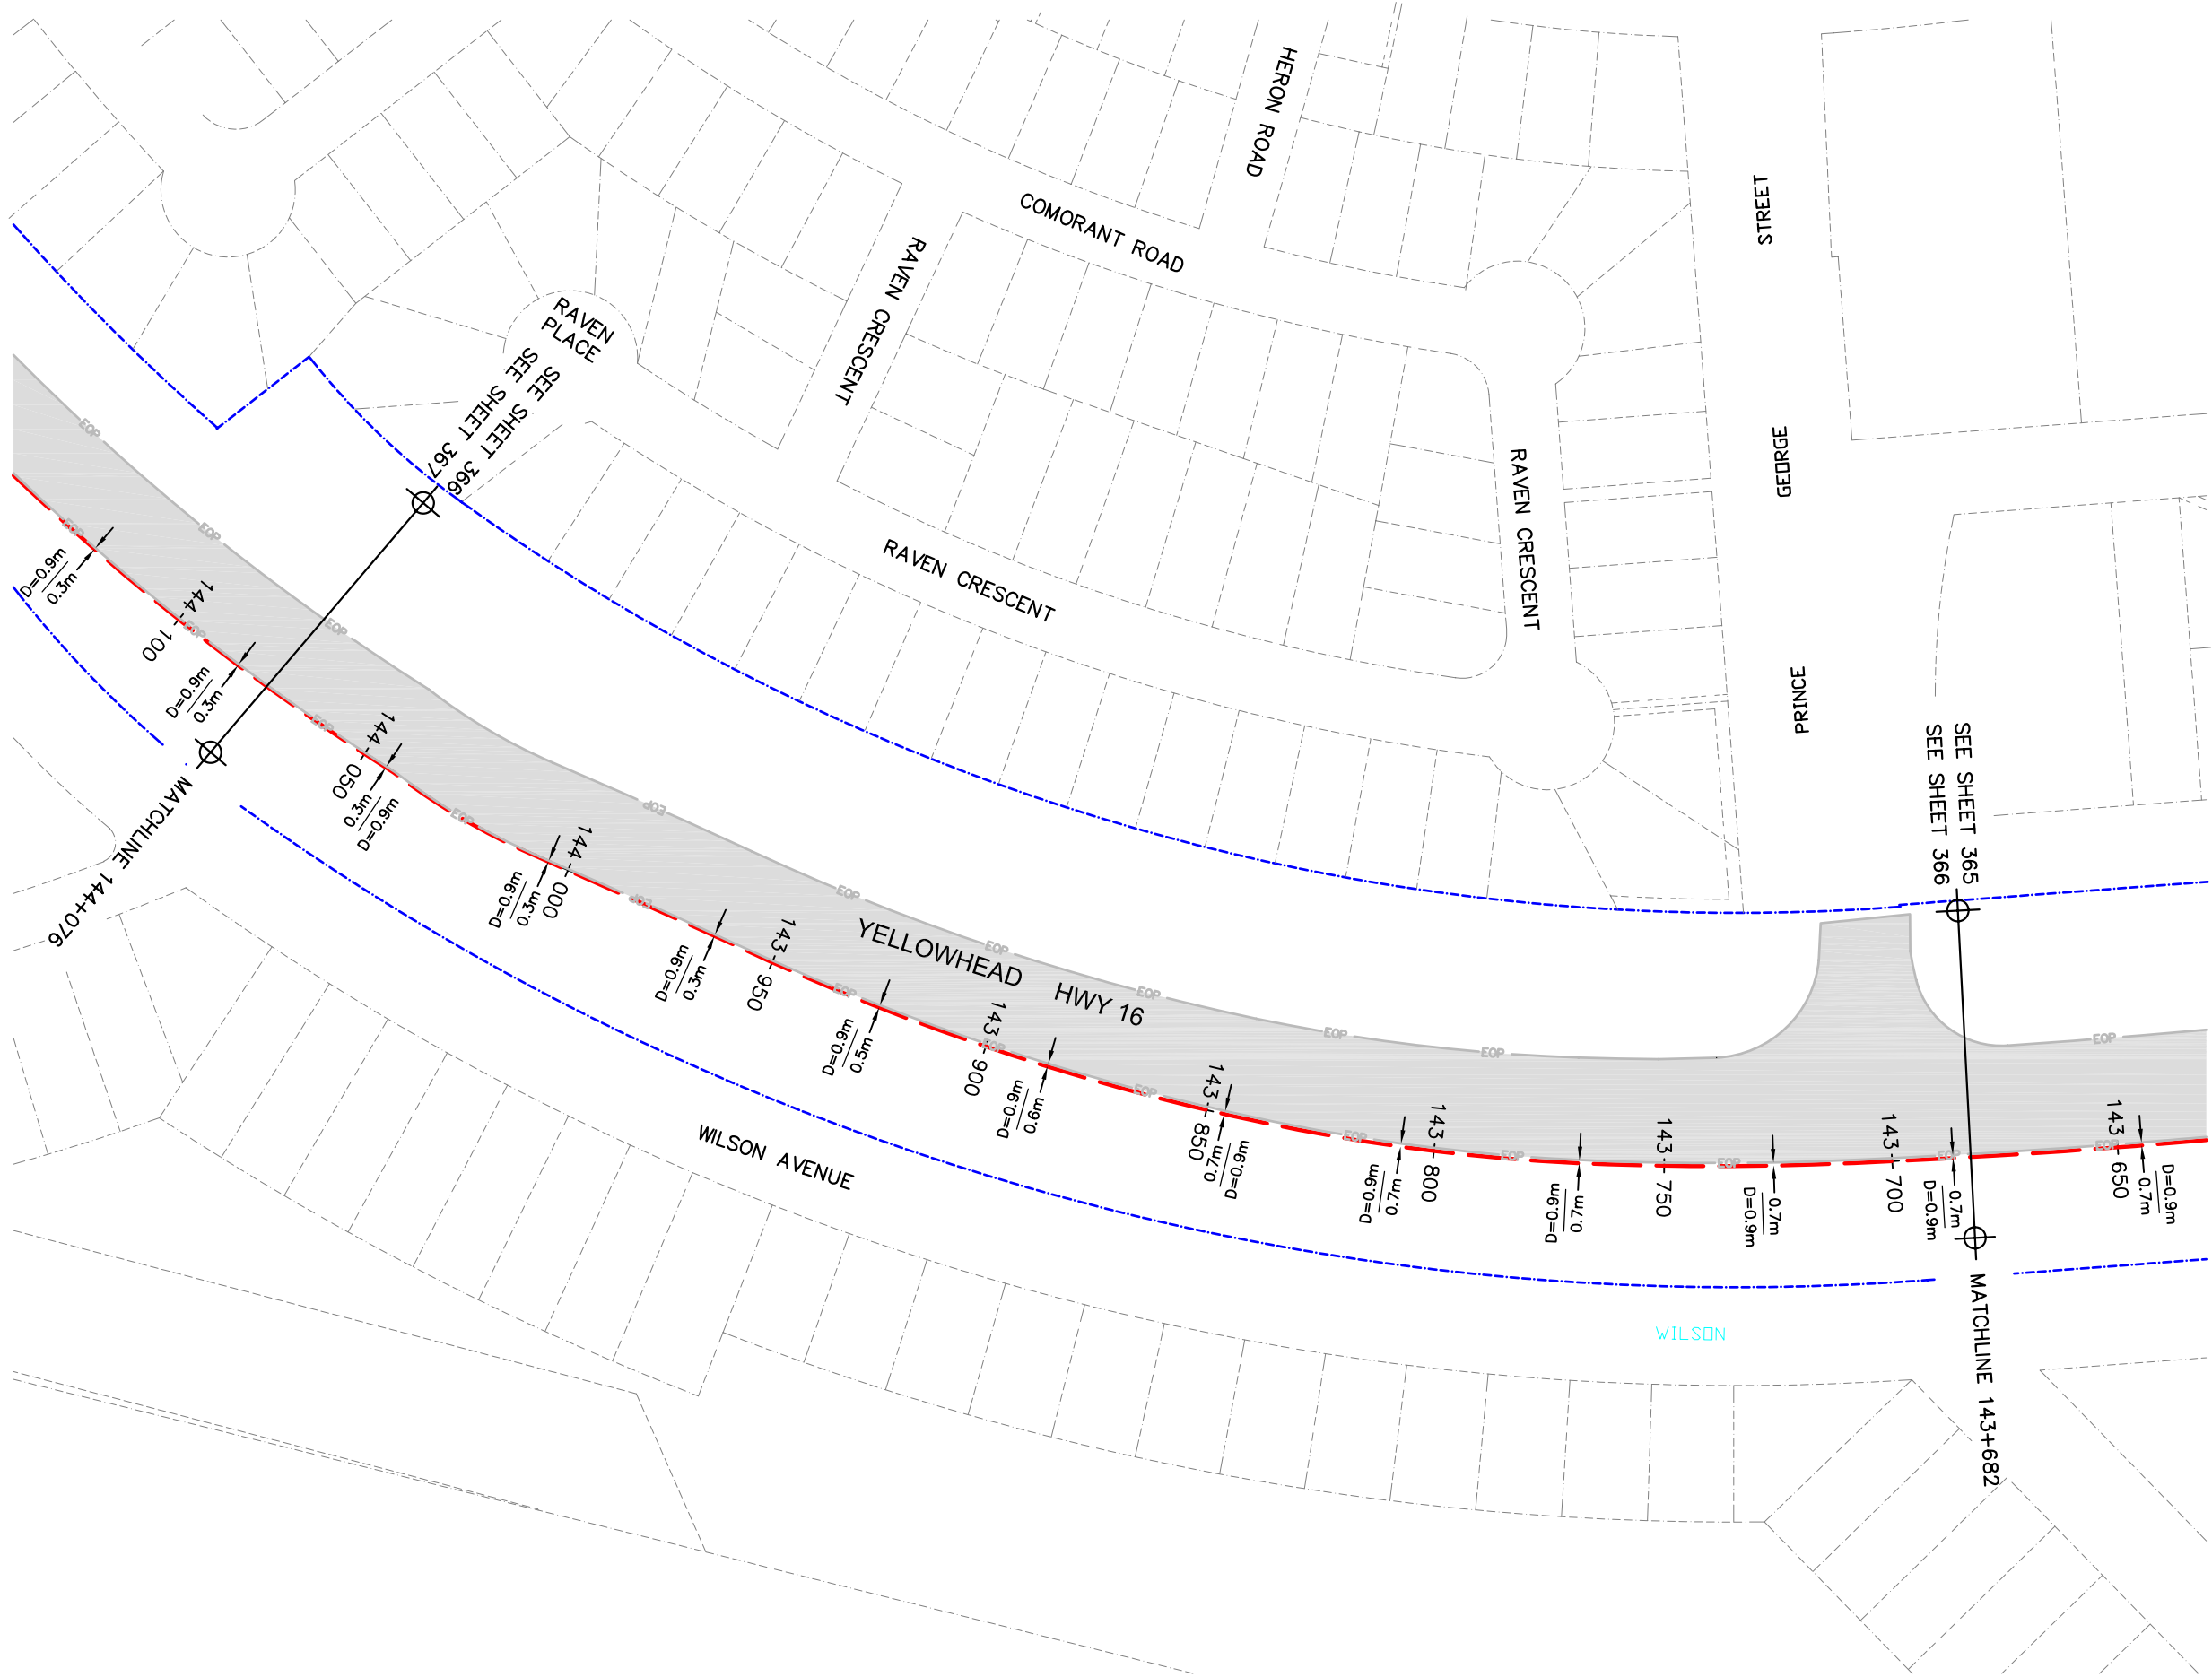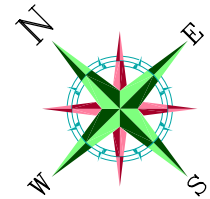


<b>ASBUILT</b>		
DATE	5/DEC/06	REV 1

  
 248 - 3rd Avenue West  
 Prince Rupert, B.C.  
 Canada V8J 1L1

Project: **CITYWEST TERRACE TO PRINCE RUPERT FIBRE OPTIC BUILD**  
 Location: Terrace to Prince Rupert

Rev.	dd/mm/yy	Revision/Issue Description	Drn.	App.
1	05/12/06	Asbuilt	PM	BM
0	02/06/06	MOT Permit Drawing Prince Rupert Extension	PM	BM



Prepared by:  
 500 - 4th Ave SW,  
 Calgary, Alberta.  
 Canada T2P 2V6



**DISCLAIMER:**  
 THE LOCATIONS OF ALL UTILITIES—INCLUDING THE CITYWEST FIBER OPTIC LINE—SHOWN ON THIS DRAWING ARE FOR REFERENCE AND PLANNING PURPOSES ONLY. LEDCOR TECHNICAL SERVICES HEREBY DISCLAIMS ANY RESPONSIBILITY TO THIRD PARTIES FOR THE ACCURACY OF THIS INFORMATION. PERSONS WORKING IN THE AREA COVERED BY THIS DRAWING MUST CONTACT THE APPROPRIATE CALL-BEFORE-YOU-DIG SYSTEM TO ASCERTAIN THE LOCATION OF ALL UNDERGROUND UTILITIES PRIOR TO PERFORMING ANY EXCAVATION.

Project ID: Terrace to Prince Rupert – Fibre Optic Build			
LTS Project No.: 5080004			
Scale:	Horiz. 1 : 1,500	Designed by: BS	Rev. <b>1</b>
	Vert. -	Drawn by: PM	
		Approved by: BM	
Date: JUNE 6, 2006	Acad File: LTS06-5080004-DWG001	Sheet No: 366	



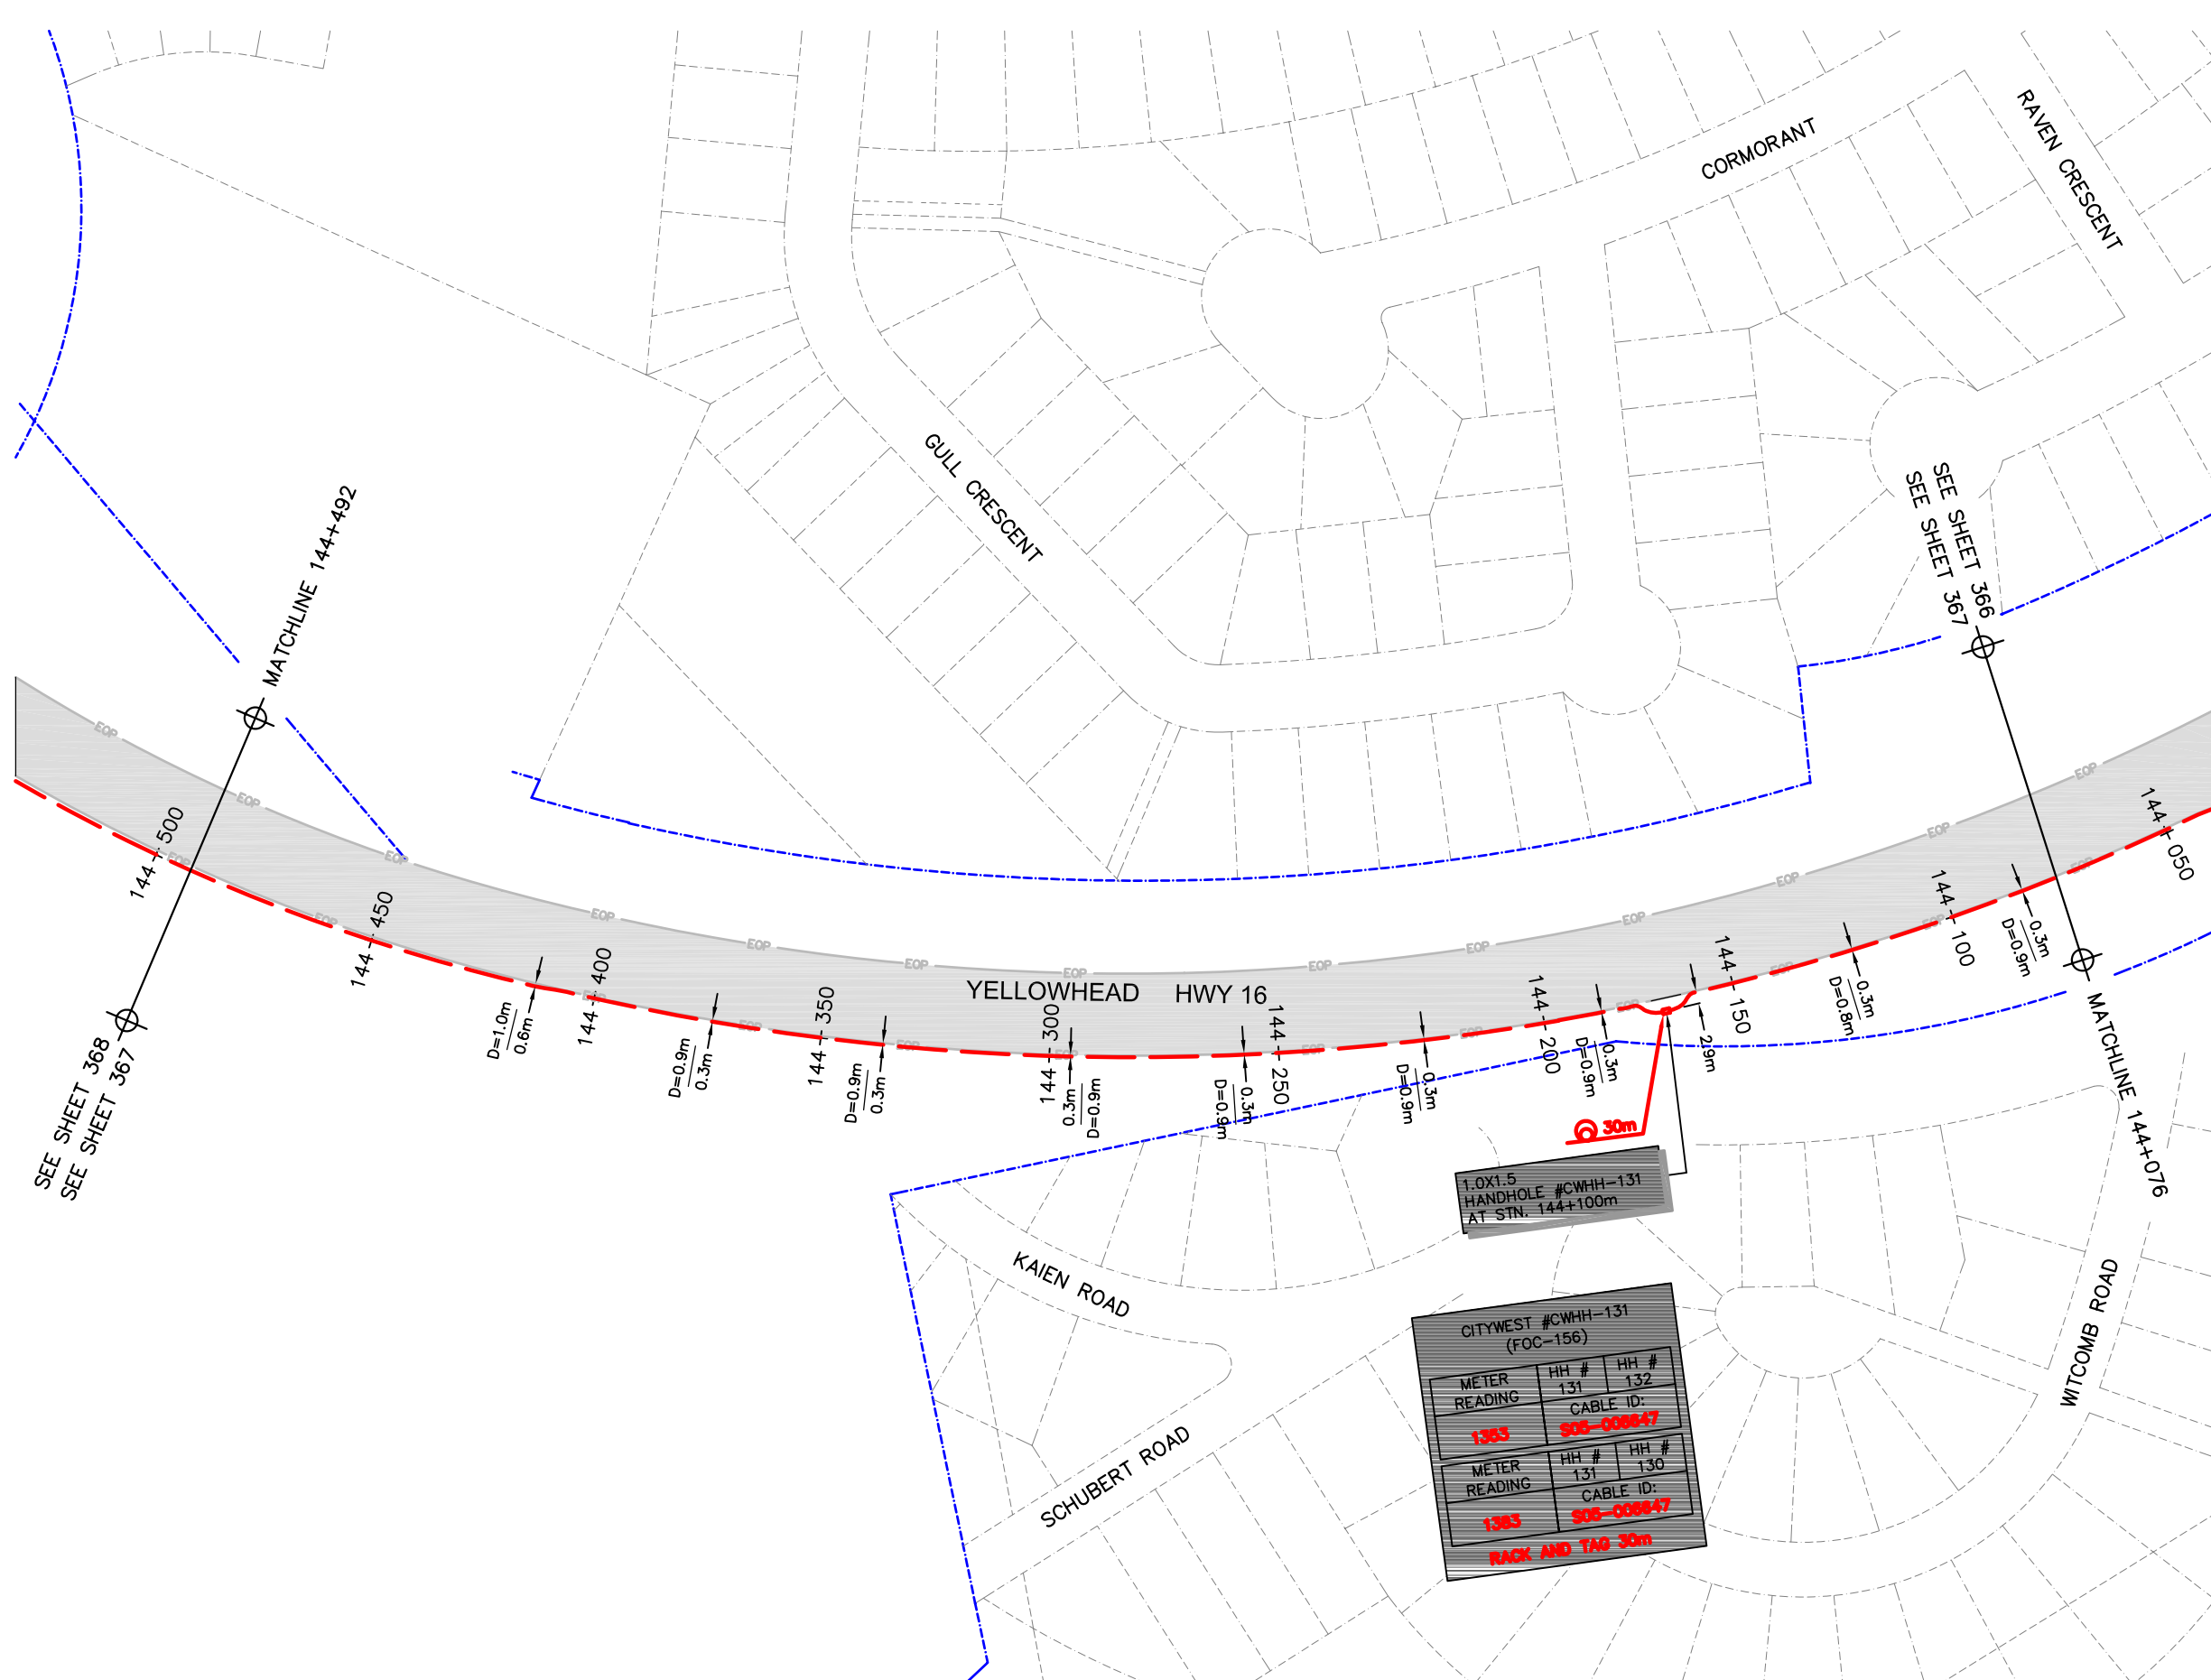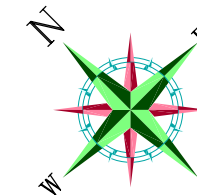

<b>ASBUILT</b>		
DATE	5/DEC/06	REV 1

**CityWest**

248 - 3rd Avenue West  
Prince Rupert, B.C.  
Canada V8J 1L1

Project: **CITYWEST TERRACE TO PRINCE RUPERT FIBRE OPTIC BUILD**

Location: Terrace to Prince Rupert

Rev.	dd/mm/yy	Revision/Issue Description	Drn.	App.
1	05/12/06	Asbuilt	PM	BM
0	02/06/06	MOT Permit Drawing Prince Rupert Extension	PM	BM

Prepared by:

500 - 4th Ave SW,  
Calgary, Alberta.  
Canada T2P 2V6


**DISCLAIMER:**

THE LOCATIONS OF ALL UTILITIES—INCLUDING THE CITYWEST FIBER OPTIC LINE—SHOWN ON THIS DRAWING ARE FOR REFERENCE AND PLANNING PURPOSES ONLY. LEDOR TECHNICAL SERVICES HEREBY DISCLAIMS ANY RESPONSIBILITY TO THIRD PARTIES FOR THE ACCURACY OF THIS INFORMATION. PERSONS WORKING IN THE AREA COVERED BY THIS DRAWING MUST CONTACT THE APPROPRIATE CALL-BEFORE-YOU-DIG SYSTEM TO ASCERTAIN THE LOCATION OF ALL UNDERGROUND UTILITIES PRIOR TO PERFORMING ANY EXCAVATION.

Project ID: Terrace to Prince Rupert - Fibre Optic Build			
LTS Project No.: 5080004			
Scales:	Horiz. 1 : 1,500	Designed by: BS	Rev. <b>1</b>
	Vert. -	Drawn by: PM	
		Approved by: BM	
Date: JUNE 6, 2006	Acad File: LTS06-5080004-DWG001	Sheet No: 367	

1.0X1.5 HANDHOLE #CWHH-131 AT STN. 144+100m


CITYWEST #CWHH-131 (FOC-156)			
METER READING	HH #	HH #	
1383	131	132	
CABLE ID: SOC-006847			
METER READING	HH #	HH #	
1383	131	130	
CABLE ID: SOC-006847			
RACK AND TAG 30m			

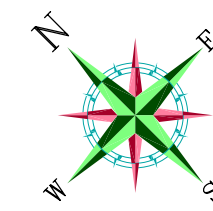

<b>ASBUILT</b>		
DATE	5/DEC/06	REV 1

CITYWEST #CWHH-001 (FOC-156)			
METER READING	MH #	MH #	
	001	002	
CABLE ID:			
817 805-00847			
METER READING	MH #	HH #	
	001	132	
CABLE ID:			
844 805-00847			
RACK AND TAG 27m			

CITYWEST #CWHH-132 (FOC-156)			
METER READING	HH #	MH #	
	132	001	
CABLE ID:			
800 805-00847			
METER READING	HH #	HH #	
	132	131	
CABLE ID:			
837 805-00847			
RACK AND TAG 28m			

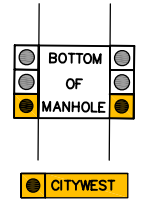

248 - 3rd Avenue West  
Prince Rupert, B.C.  
Canada V8J 1L1



Project: **CITYWEST TERRACE TO PRINCE RUPERT FIBRE OPTIC BUILD**  
Location: Terrace to Prince Rupert

1	05/12/06	Asbuilt	PM	BM
0	02/06/06	MOT Permit Drawing Prince Rupert Extension	PM	BM
Rev.	dd/mm/yy	Revision/Issue Description	Drn.	App.

Prepared by:  
500 - 4th Ave SW,  
Calgary, Alberta.  
Canada T2P 2V6

**DISCLAIMER:**  
THE LOCATIONS OF ALL UTILITIES—INCLUDING THE CITYWEST FIBER OPTIC LINE—SHOWN ON THIS DRAWING ARE FOR REFERENCE AND PLANNING PURPOSES ONLY. LEDOR TECHNICAL SERVICES HEREBY DISCLAIMS ANY RESPONSIBILITY TO THIRD PARTIES FOR THE ACCURACY OF THIS INFORMATION. PERSONS WORKING IN THE AREA COVERED BY THIS DRAWING MUST CONTACT THE APPROPRIATE CALL-BEFORE-YOU-DIG SYSTEM TO ASCERTAIN THE LOCATION OF ALL UNDERGROUND UTILITIES PRIOR TO PERFORMING ANY EXCAVATION.

Project ID: Terrace to Prince Rupert - Fibre Optic Build			
LTS Project No.: 5080004			
Scales:	Horiz. 1 : 1,500	Vert. -	Rev. 1
	Designed by: BS	Drawn by: PM	Approved by: BM
Date: JUNE 6, 2006	Acad File: LTS06-5080004-DWG001	Sheet No: 368	

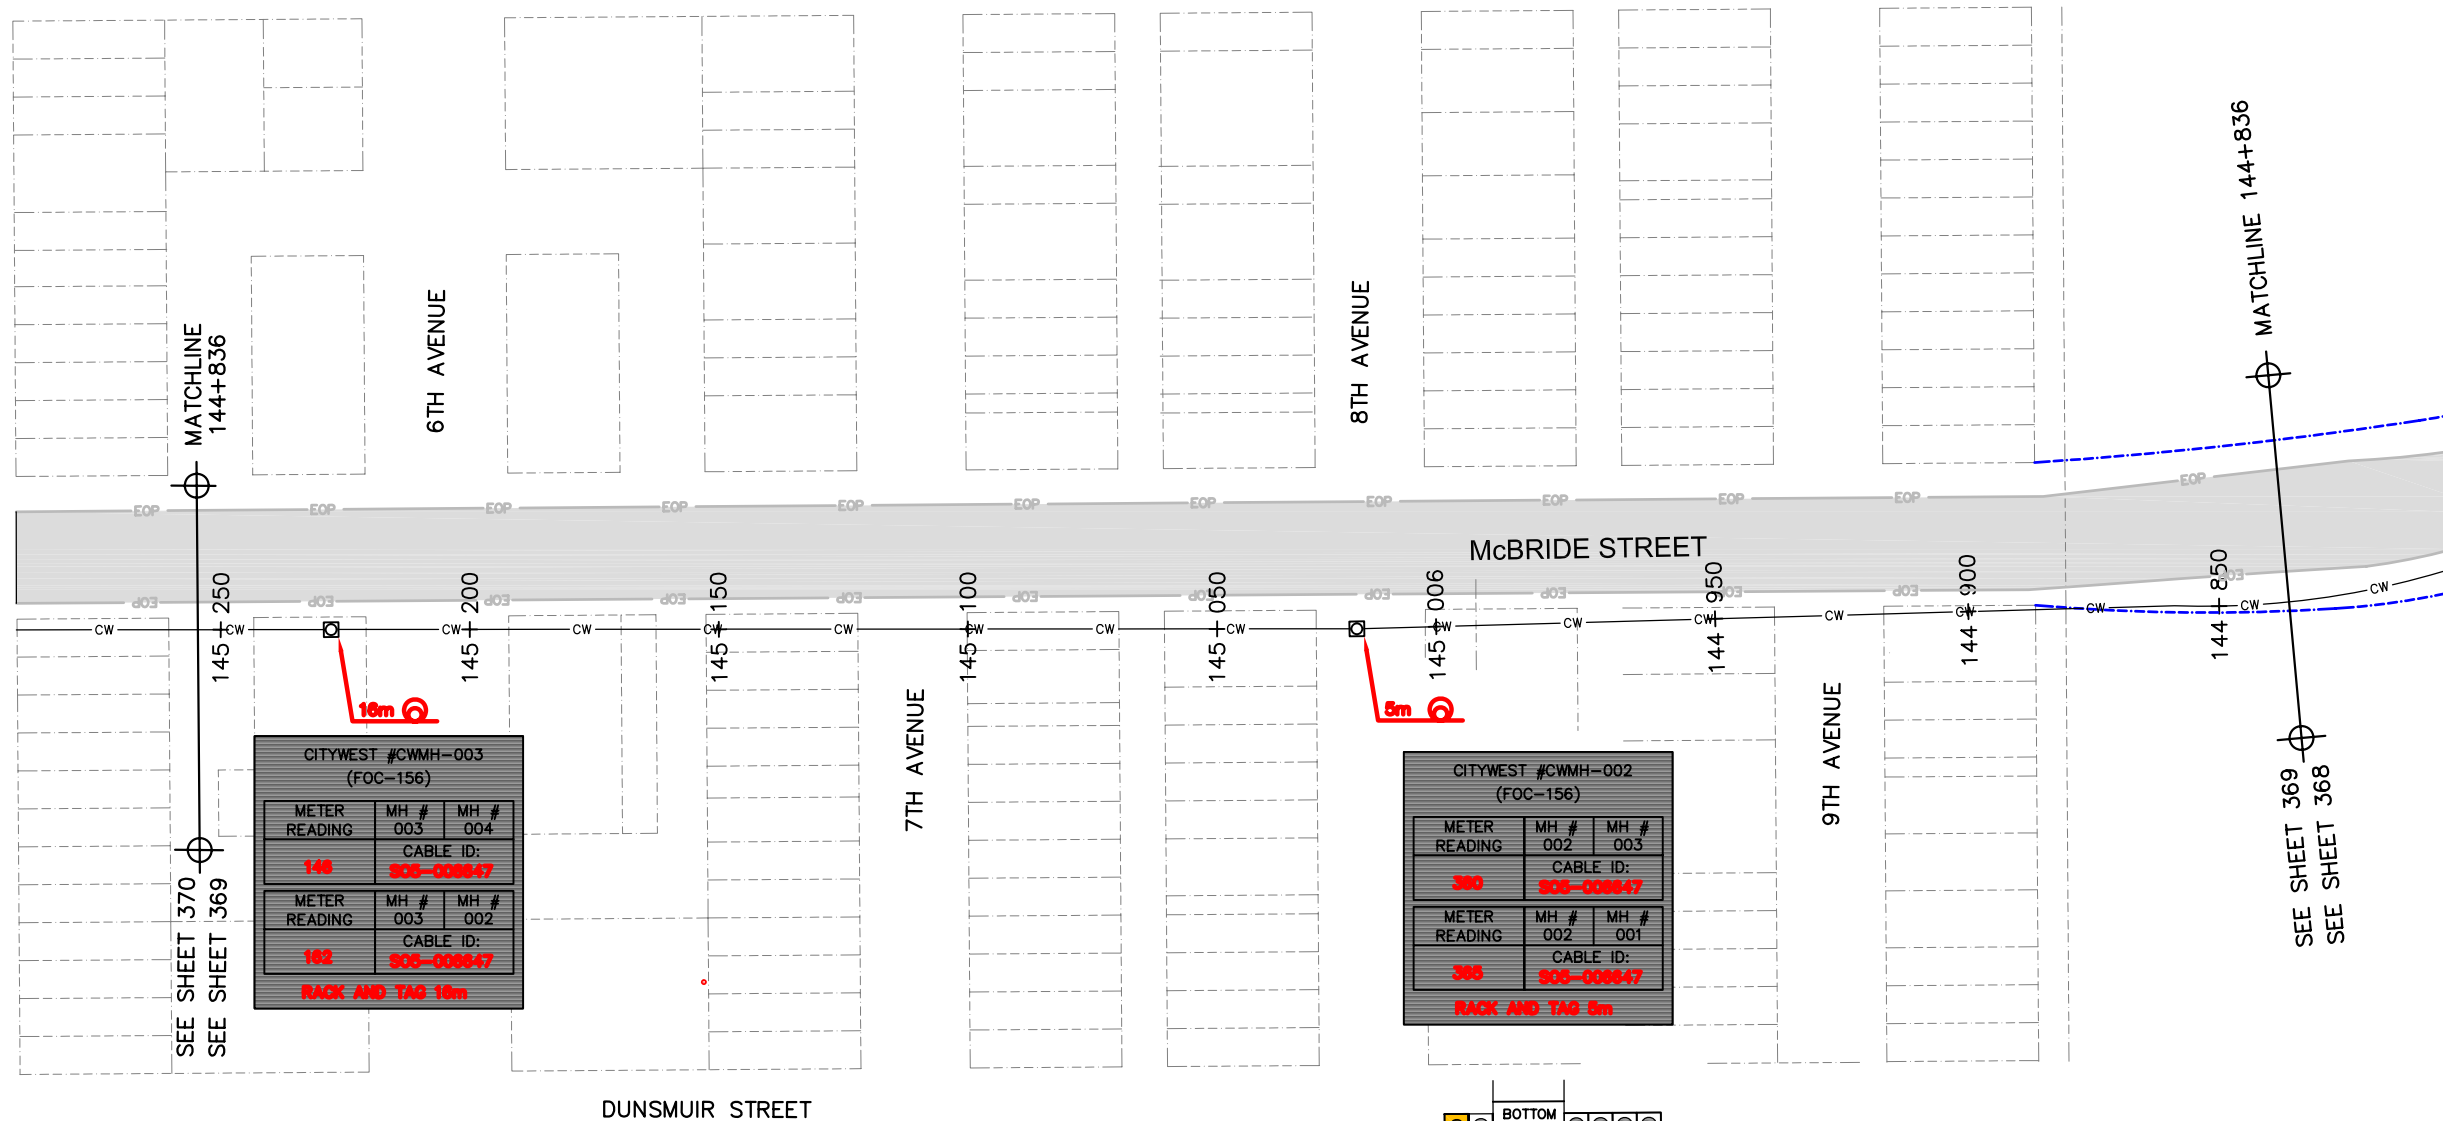
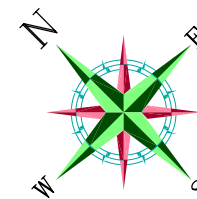


CITYWEST #CWMH-003  
(FOC-156)

METER READING	MH #	MH #
148	003	004
CABLE ID: 305-00847		
METER READING	MH #	MH #
182	003	002
CABLE ID: 305-00847		
RACK AND TAG 18m		

CITYWEST #CWMH-002  
(FOC-156)

METER READING	MH #	MH #
380	002	003
CABLE ID: 305-00847		
METER READING	MH #	MH #
385	002	001
CABLE ID: 305-00847		
RACK AND TAG 5m		

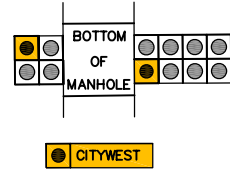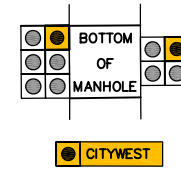

ASBUILT		
DATE	5/DEC/06	REV 1




248 - 3rd Avenue West  
Prince Rupert, B.C.  
Canada V8J 1L1

Project: **CITYWEST  
TERRACE TO PRINCE RUPERT  
FIBRE OPTIC BUILD**

Location: Terrace to Prince Rupert

Rev.	dd/mm/yy	Revision/Issue Description	Drn.	App.
1	05/12/06	Asbuilt	PM	BM
0	02/06/06	MOT Permit Drawing Prince Rupert Extension	PM	BM

Prepared by:  
500 - 4th Ave SW,  
Calgary, Alberta.  
Canada T2P 2V6



**DISCLAIMER:**  
THE LOCATIONS OF ALL UTILITIES--INCLUDING THE CITYWEST FIBRE OPTIC LINE--SHOWN ON THIS DRAWING ARE FOR REFERENCE AND PLANNING PURPOSES ONLY. LEDCOR TECHNICAL SERVICES HEREBY DISCLAIMS ANY RESPONSIBILITY TO THIRD PARTIES FOR THE ACCURACY OF THIS INFORMATION. PERSONS WORKING IN THE AREA COVERED BY THIS DRAWING MUST CONTACT THE APPROPRIATE CALL-BEFORE-YOU-DIG SYSTEM TO ASCERTAIN THE LOCATION OF ALL UNDERGROUND UTILITIES PRIOR TO PERFORMING ANY EXCAVATION.


Project ID: Terrace to Prince Rupert - Fibre Optic Build			
LTS Project No.: 5080004			
Scale:	Horiz. 1 : 1,500	Vert. -	Designed by: BS Drawn by: PM Approved by: BM
Date:	JUNE 6, 2006	Acad File:	LTS06-5080004-DWG001
Sheet No.:	369	Rev.:	<b>1</b>









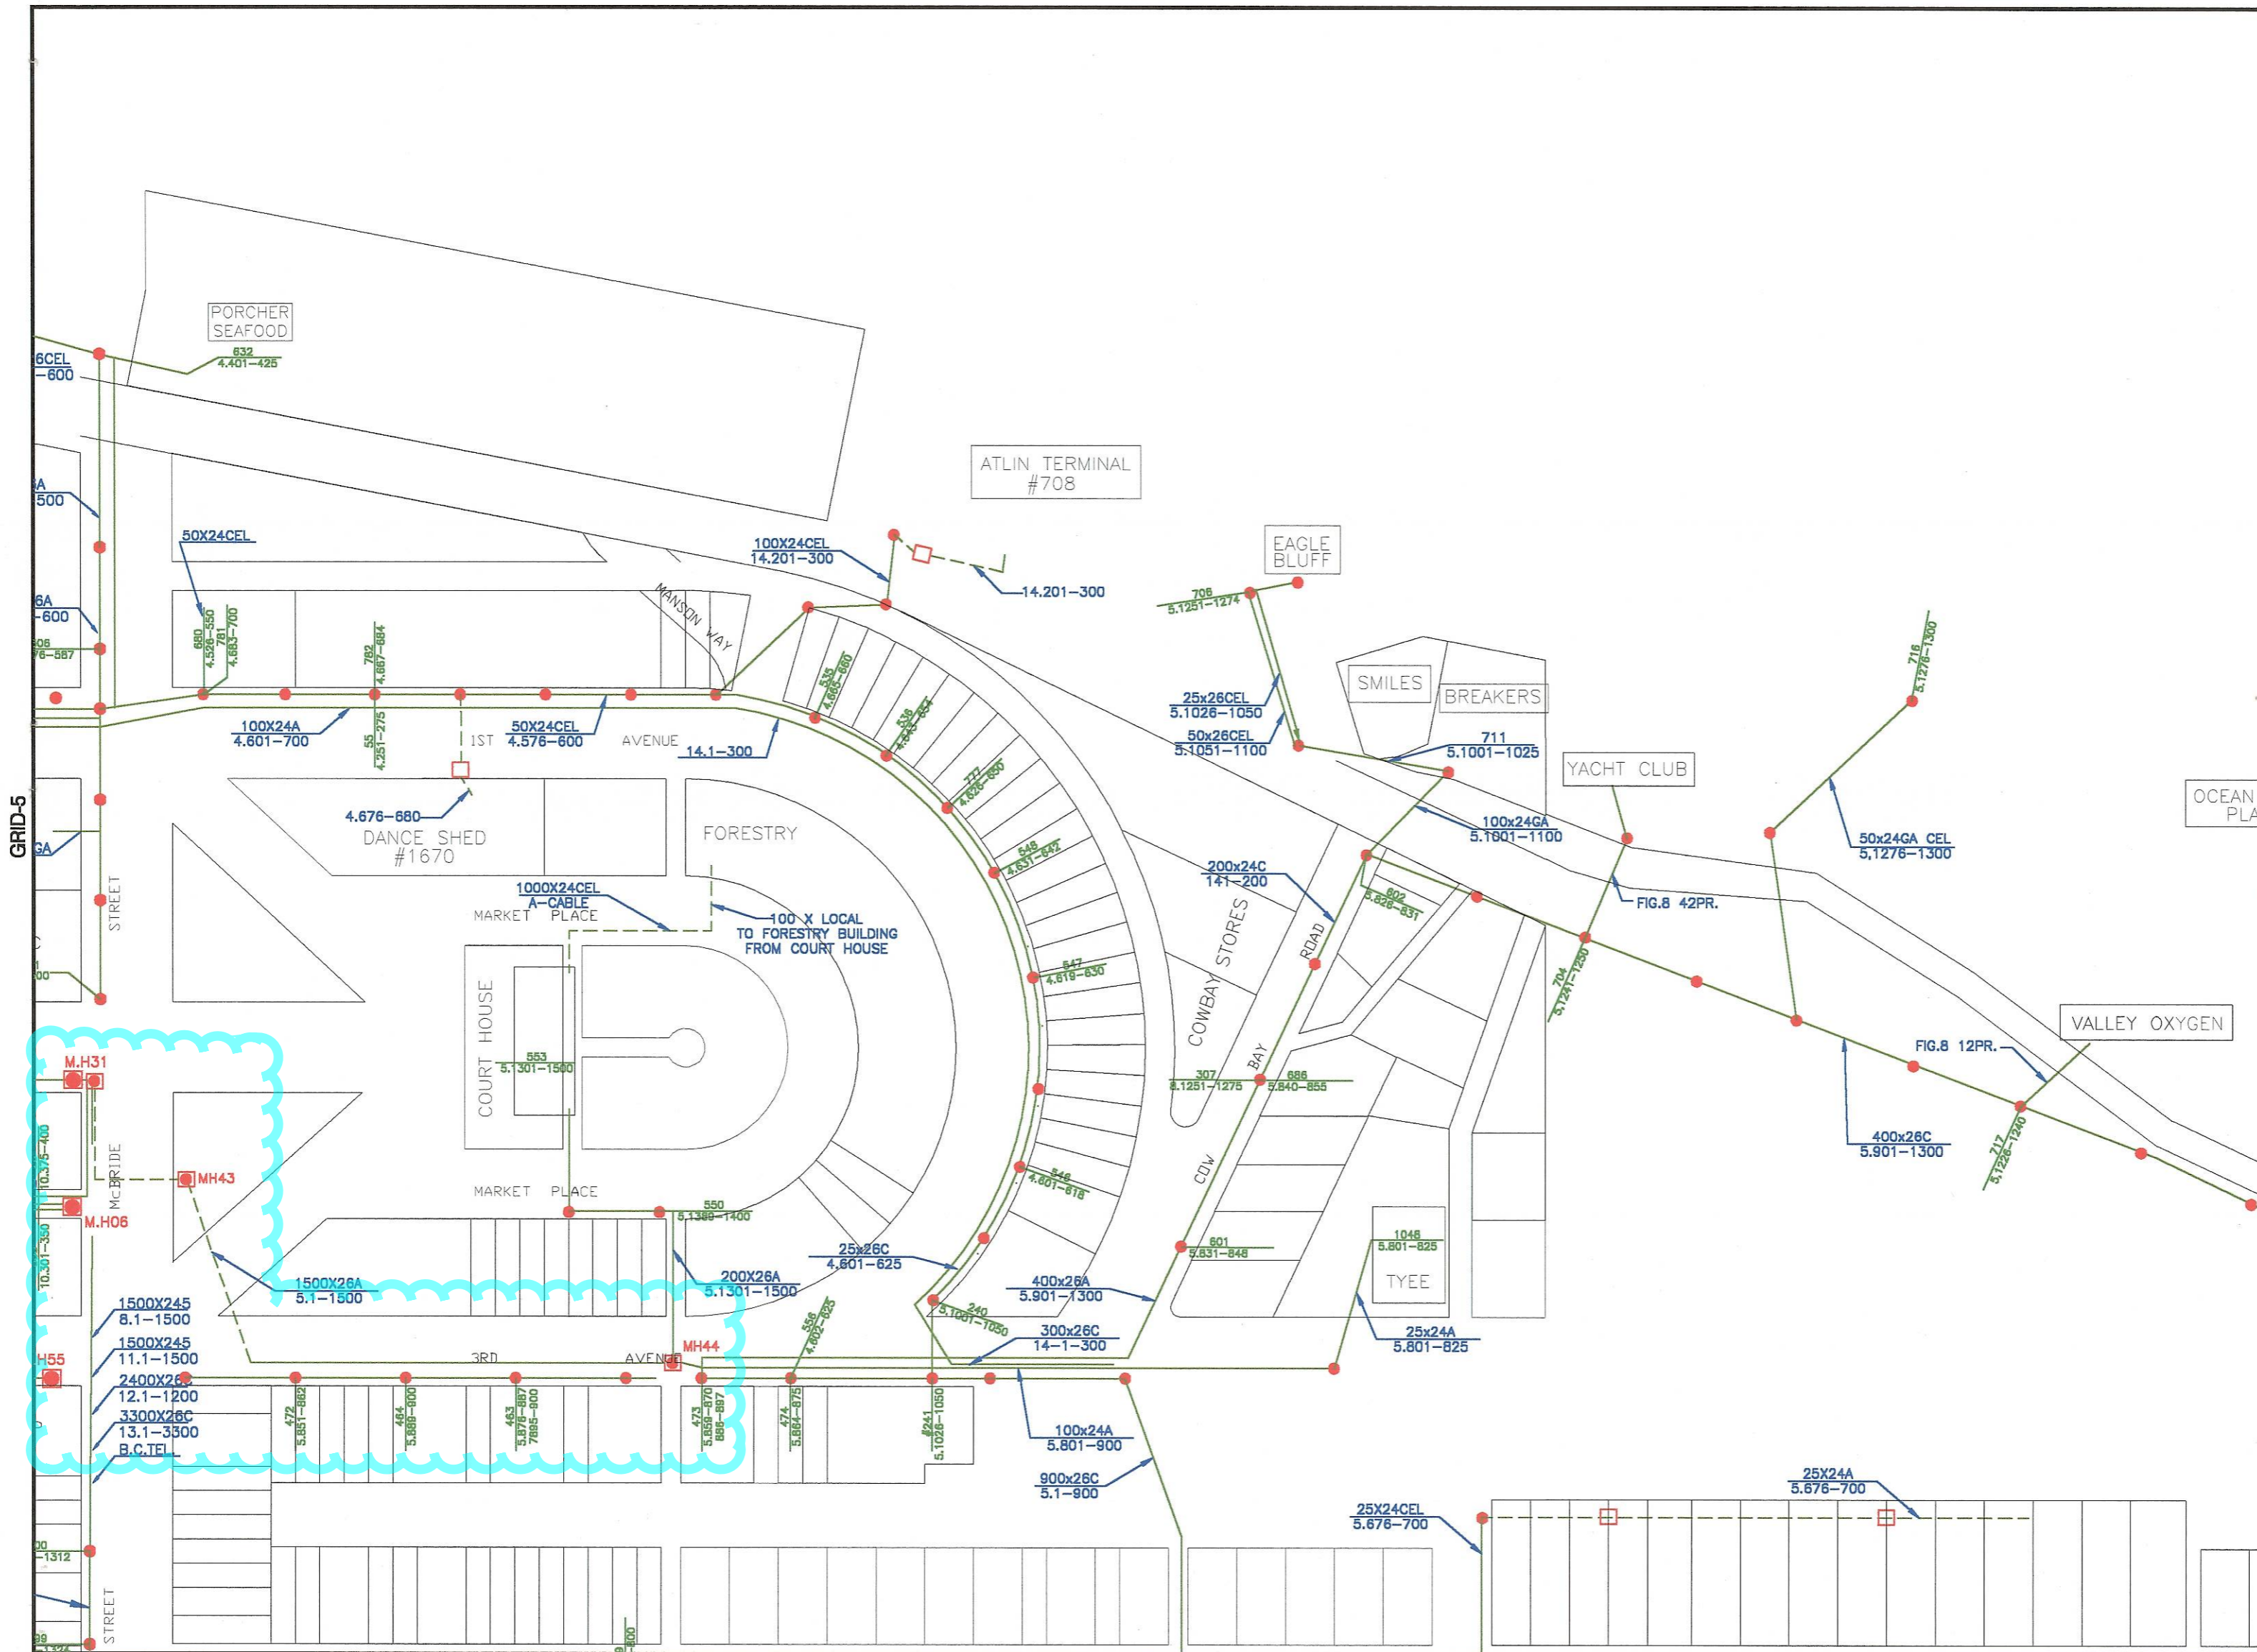

CITY TELEPHONE SERVICES	
GRID LAYOUT	DATE: JUNE 14/03
D-06	DWG NO.
	REV
	SHEET 6 OF 49

Square-T Drafting Services  
 417 RFD DRIVE S STELOWAY, B.C. V1V2L2  
 Phone: (250) 866-8916 EMAIL: pntavo@shaw.ca

