


- LEGEND**
- WP - Work point
  - HHW - High high water
  - MHW - Mean high water
  - LLW - Low low water
  - SW - Submarine watermain
  - W - Water
  - G - Gas

**NOTE**

Datum based on Canadian Geodetic Datum 0.00 for Tide Heights - Burrard Inlet Tidal Survey - May 1954.

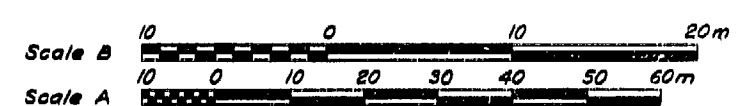

GOVERNMENT OF BRITISH COLUMBIA  
MINISTRY OF TRANSPORTATION AND HIGHWAYS  
BRIDGE ENGINEERING BRANCH

**ANNACIS CHANNEL MOVABLE BRIDGE  
GENERAL ARRANGEMENT**



	<b>CRIPPEN CONSULTANTS</b>		NORTH VANCOUVER, B.C.		PROJECT NO 10331	
	D					
	C					
	B	As Built				
A	APPROVED FOR CONSTRUCTION					
REVISIONS						

PREPARED UNDER THE DIRECTION OF	DATE	SCALE: As shown	NRG No.
<i>[Signature]</i>	7/11/54		
DRAWN	DESIGNED	CHECKED	JCH
<i>[Signature]</i>	<i>[Signature]</i>	<i>[Signature]</i>	
APPROVED FOR USE IN CONSTRUCTION	DATE	EXAMINED AND ACCEPTED	DATE
<i>[Signature]</i>	7/11/54	<i>[Signature]</i>	
DRAWING No.			2760-102 B