


KEY PLAN  
Scale: 1"=1320'

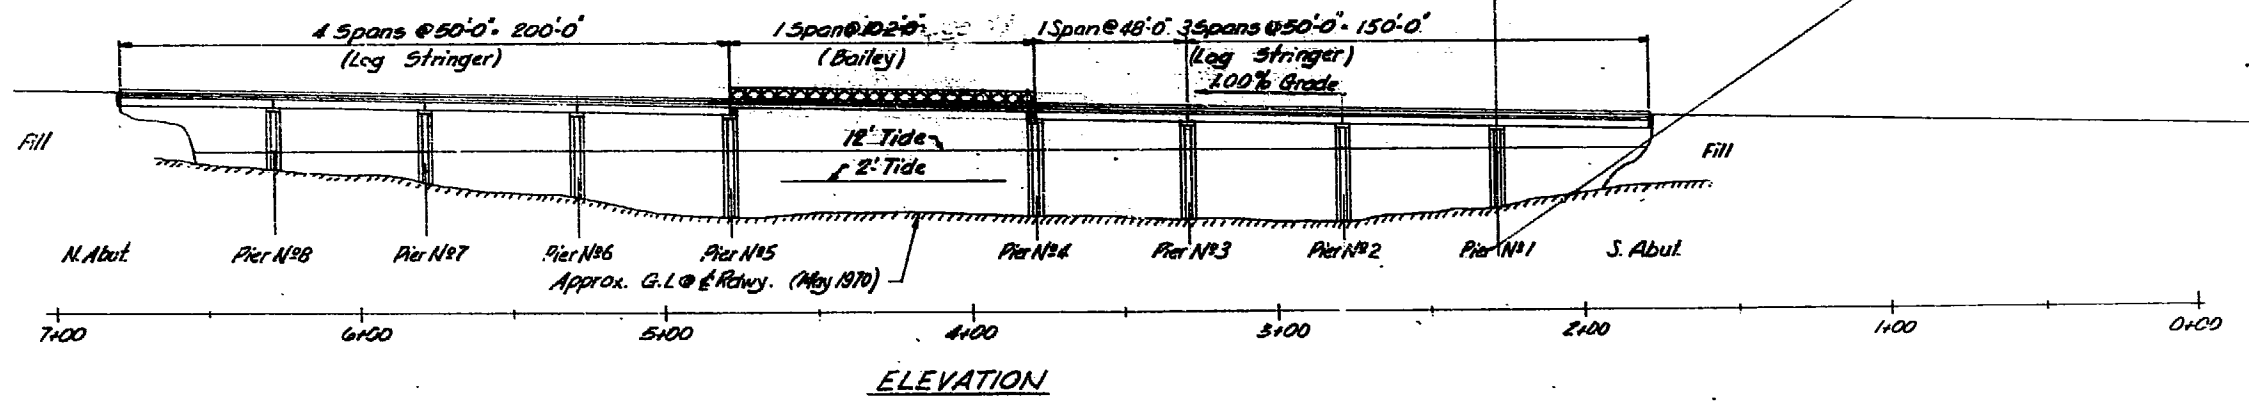

LIST OF DRAWINGS	
Dwg. No.	Title
B31-35	General Arrangement
B31-36	Details of Bents & Approach Spans
B31-37	Details of Piers & Log Spans

Note:  
 1. Elevations shown are in feet referenced to zero tide datum.  
 2. Plus elevations are below datum, minus elevations are above datum.  
 3. Soundings by Dock District: Plan No. 25-77 June 1970.

BRITISH COLUMBIA DEPARTMENT OF HIGHWAYS  
BRIDGE DESIGN

SAANICH DISTRICT  
WEST COAST ROAD  
HARRIS COVE BRIDGE  
GENERAL ARRANGEMENT

288822

SCALE: 1"=30'

APPROVED: *[Signature]* SENIOR DESIGN ENGINEER  
 DRAWN: *[Signature]* CHECKED: *[Signature]*  
 APPROVED: *[Signature]* SENIOR DESIGN ENGINEER  
 DRAWING No. 831-35 A

REVISIONS	
No.	Description
D	
C	
B	
A	As Built