


PLAN  
 FOR SECTIONS A-A, B-B, C-C & D-D SEE DWG 231-104

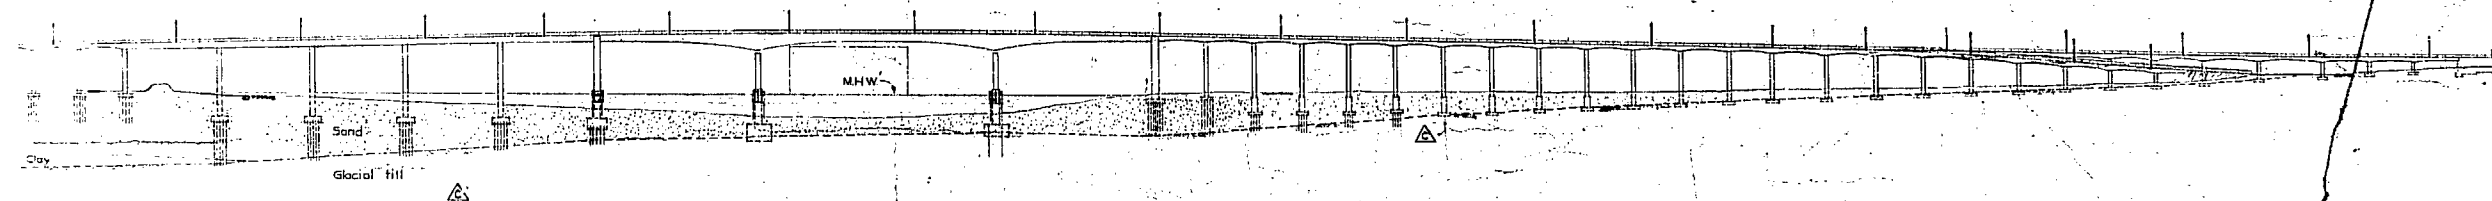

ELEVATION

**NOTE**  
 The basis of design is the 'Specifications for Highway Bridges - 1951' of the Department of Public Works of B.C. for H20-S16-44 loading. Allowance has been made for carrying 2-18"  $\phi$   $\frac{1}{8}$ " wall, water lines as indicated on drawings.

Oct 10 1957	T.W.C.	Boylie N17 relocated, as built.	
Mar 1 1959	H.D. W.C.M.	River Road moved, figs. altered.	
		Note added, $\Delta$ Road added.	
REV. LETTER	DATE	DR. BY	DESCRIPTION
<b>OAK STREET BRIDGE</b>			
PROVINCIAL GOVERNMENT OF BRITISH COLUMBIA DEPARTMENT OF PUBLIC WORKS			
GENERAL ARRANGEMENT NORTH HALF			
PHILLIPS, BARRATT AND PARTNERS CONSULTING ENGINEERS VANCOUVER, B.C.			

55095

231-102

DESTROY PRINTS OF THIS NUMBER BEARING PREVIOUS EDITIONS