

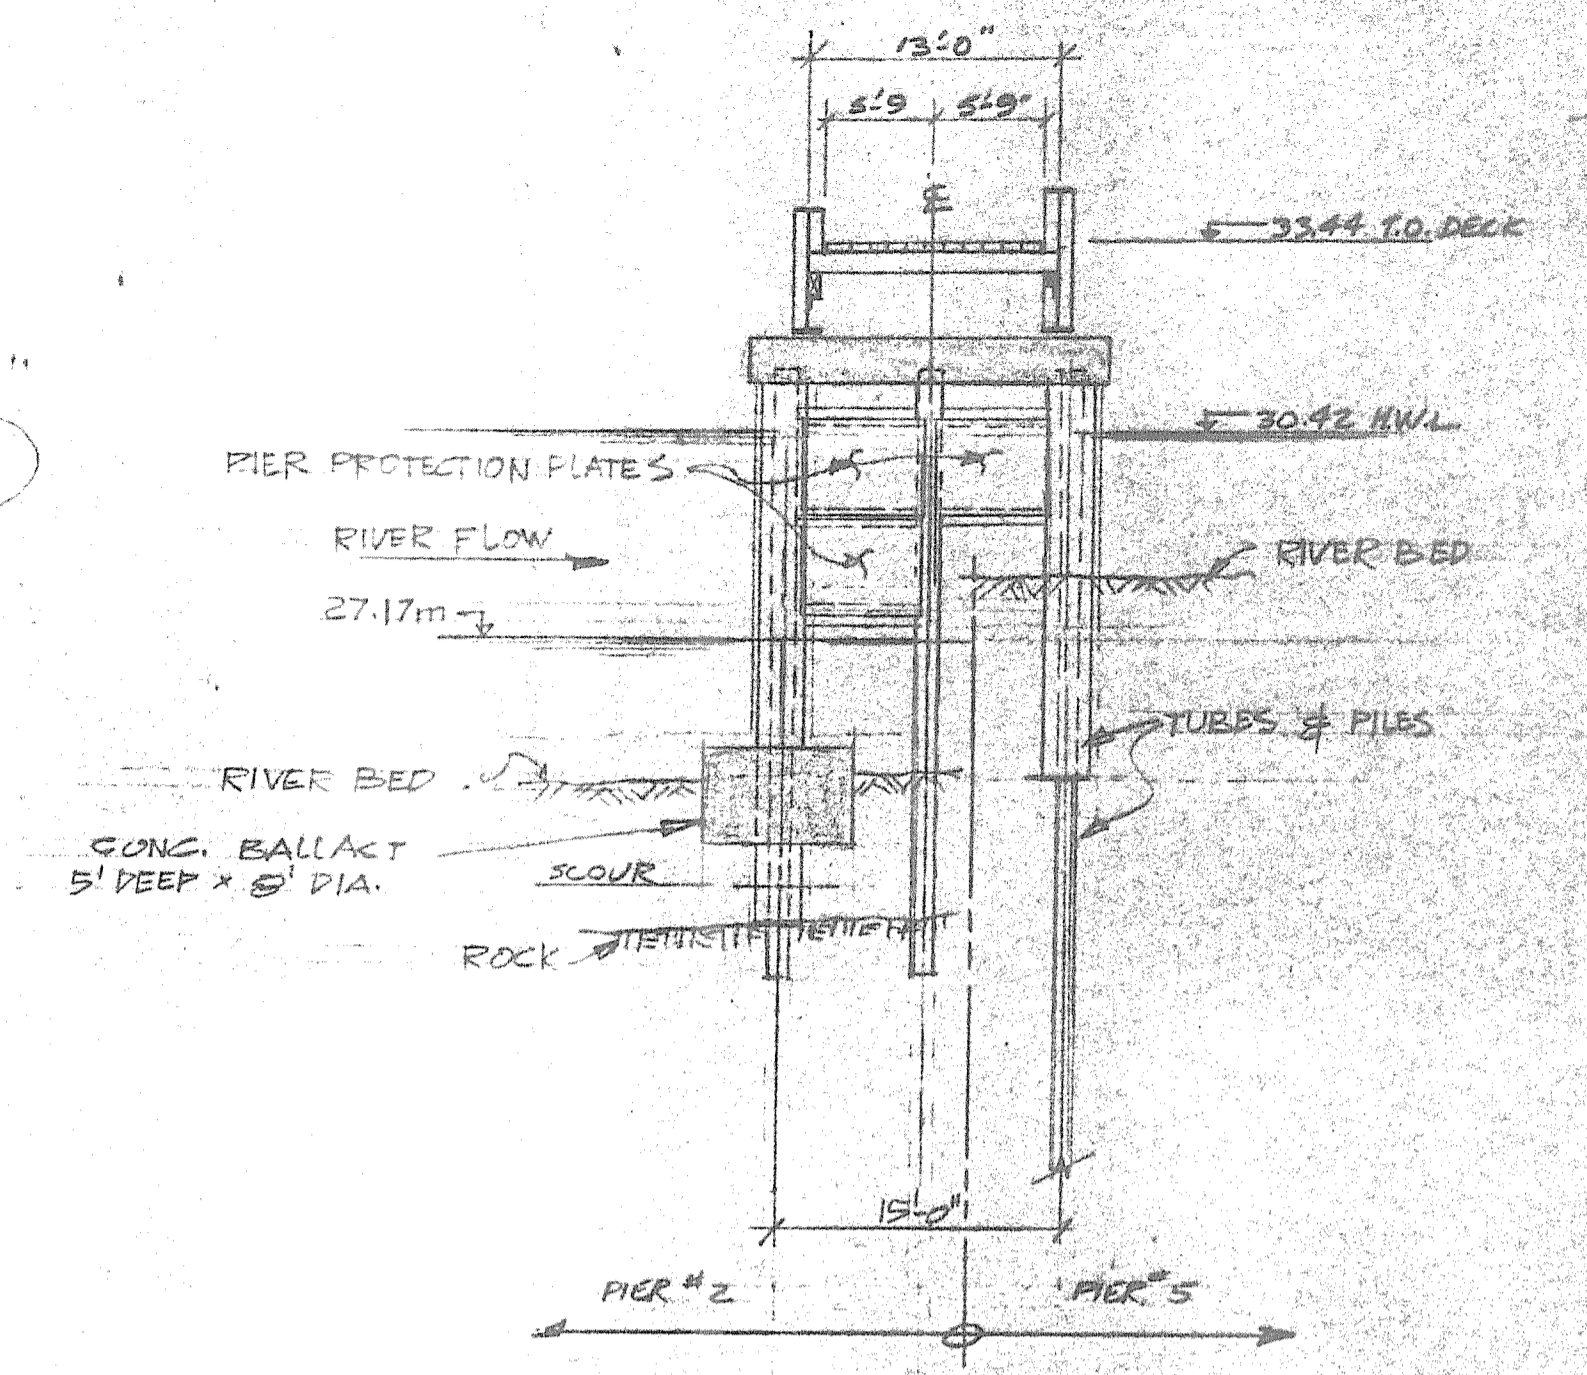


PLAN
SCALE 1:500

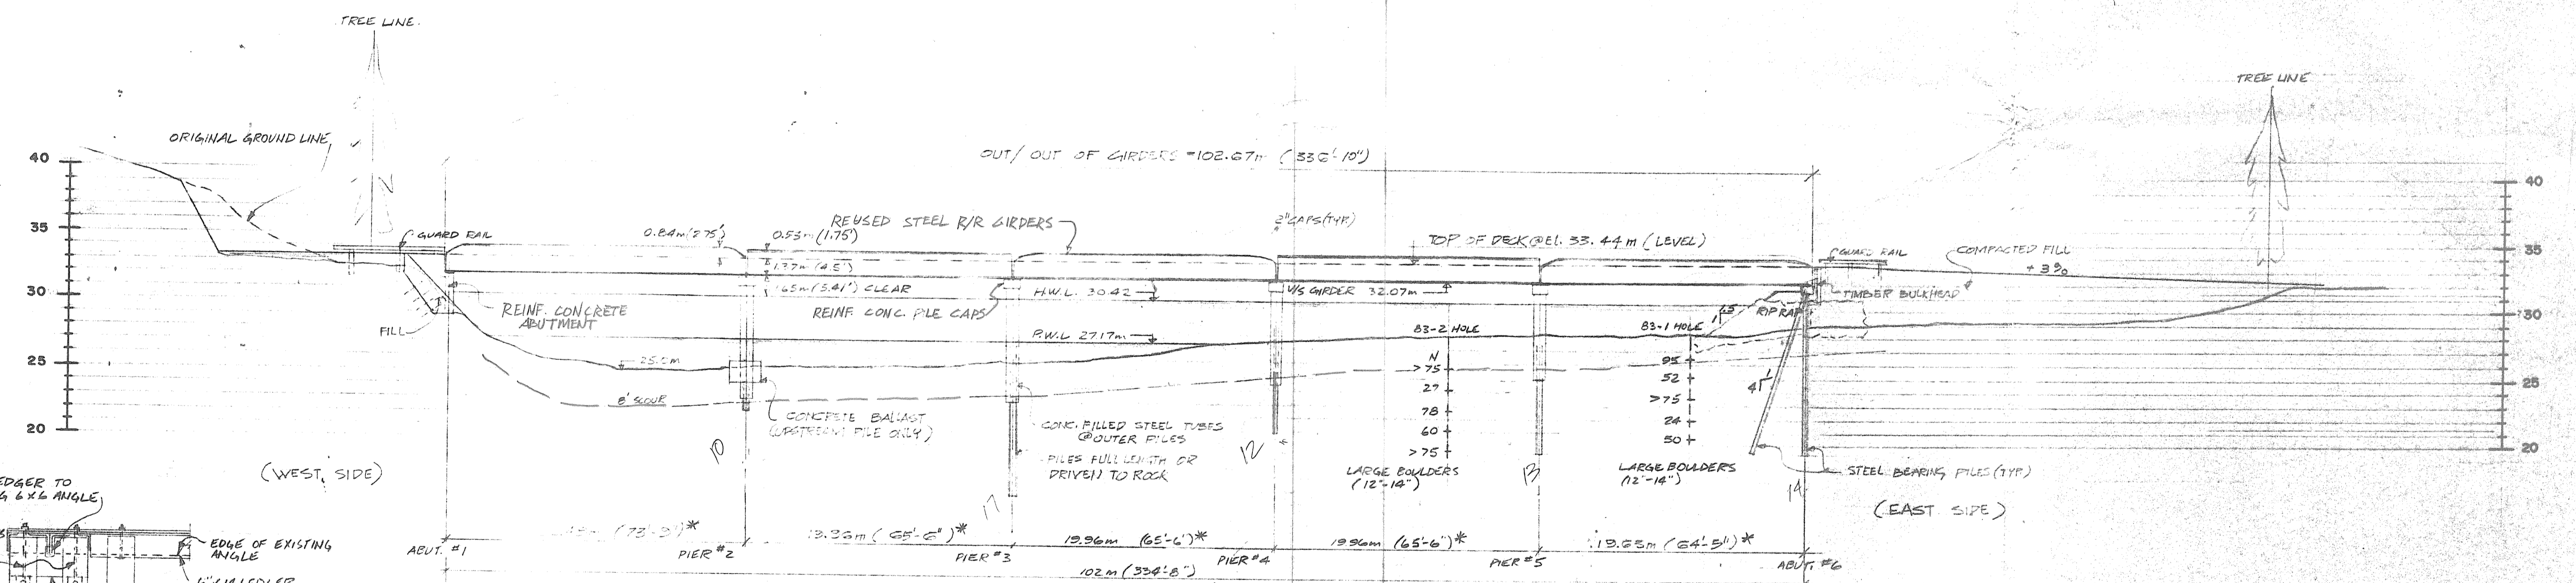



PIER SECTION
SCALE 1"=10'-0"

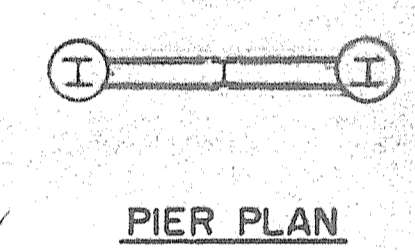

ELEVATION (SCALE: 1/240) OR (1"=20'-0")


NOTE
1) * DIMENSIONS OF GIRDERS TO BE CONFIRMED ON SITE.

Note: Design Truck Load 70 Ton Truck

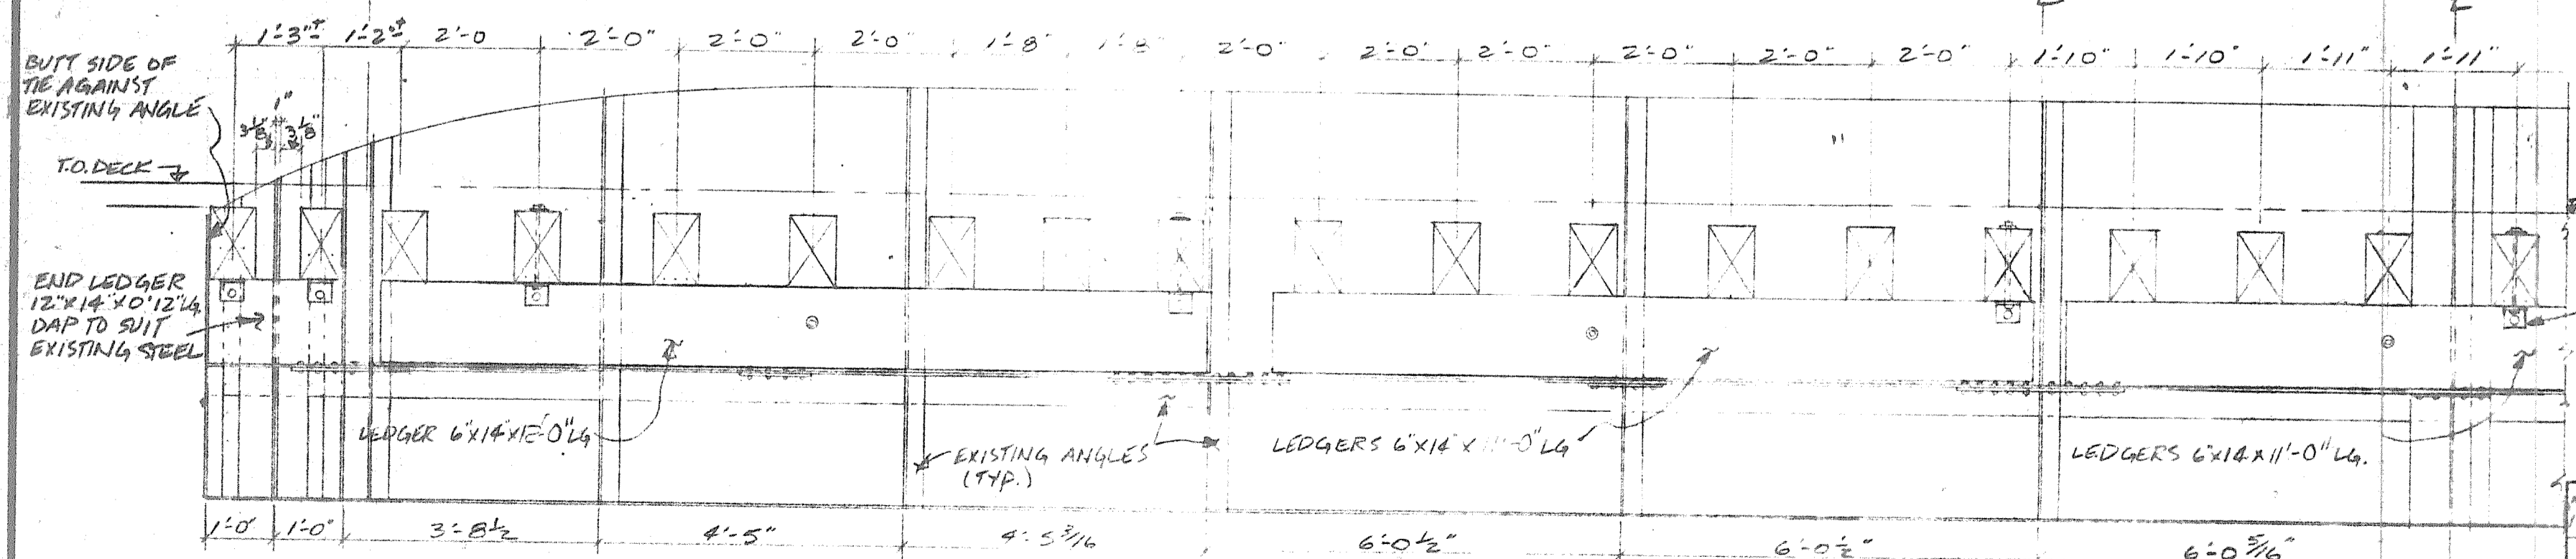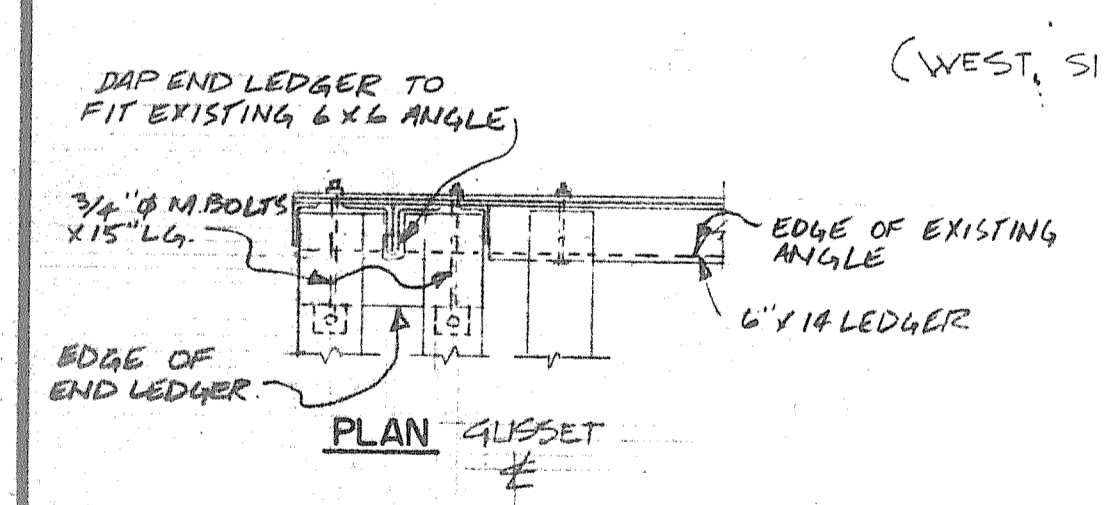

SUGGESTED TIE & TIMBER LEDGER LAYOUT (FOR 60' GIRDERS ONLY)
SCALE 1/2"=1'-0" (GIRDER INFORMATION TAKEN FROM C.P.R. DWG # 47010-6)

DATE	REVISION	No.
MAY 12/83	REVISED AS BUILT	C
MAR 23/83	TIE & LEDGER SPACING	B
MARCH 18/83	REVISED FOR CONSTRUCTION	A

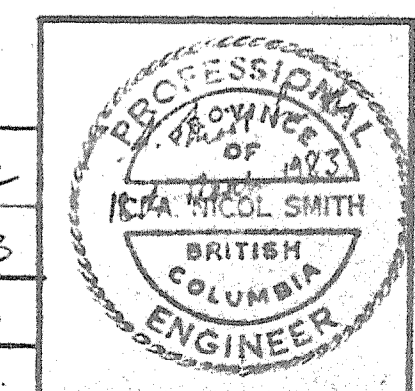

GOWER, YEUNG & ASSOCIATES LTD.
CONSULTING ENGINEERS
360, 522 - 7th STREET
NEW WESTMINSTER, B.C. 524-8521

EVANS PRODUCTS COMPANY LTD.	
COLUMBIA RIVER CROSSING 7439 DOGTOOTH	GENERAL ARRANGEMENT
PROJ. No. 1200	DWG. No. 1 of 5

MAY 17 1983