


ELEVATION - (looking north)

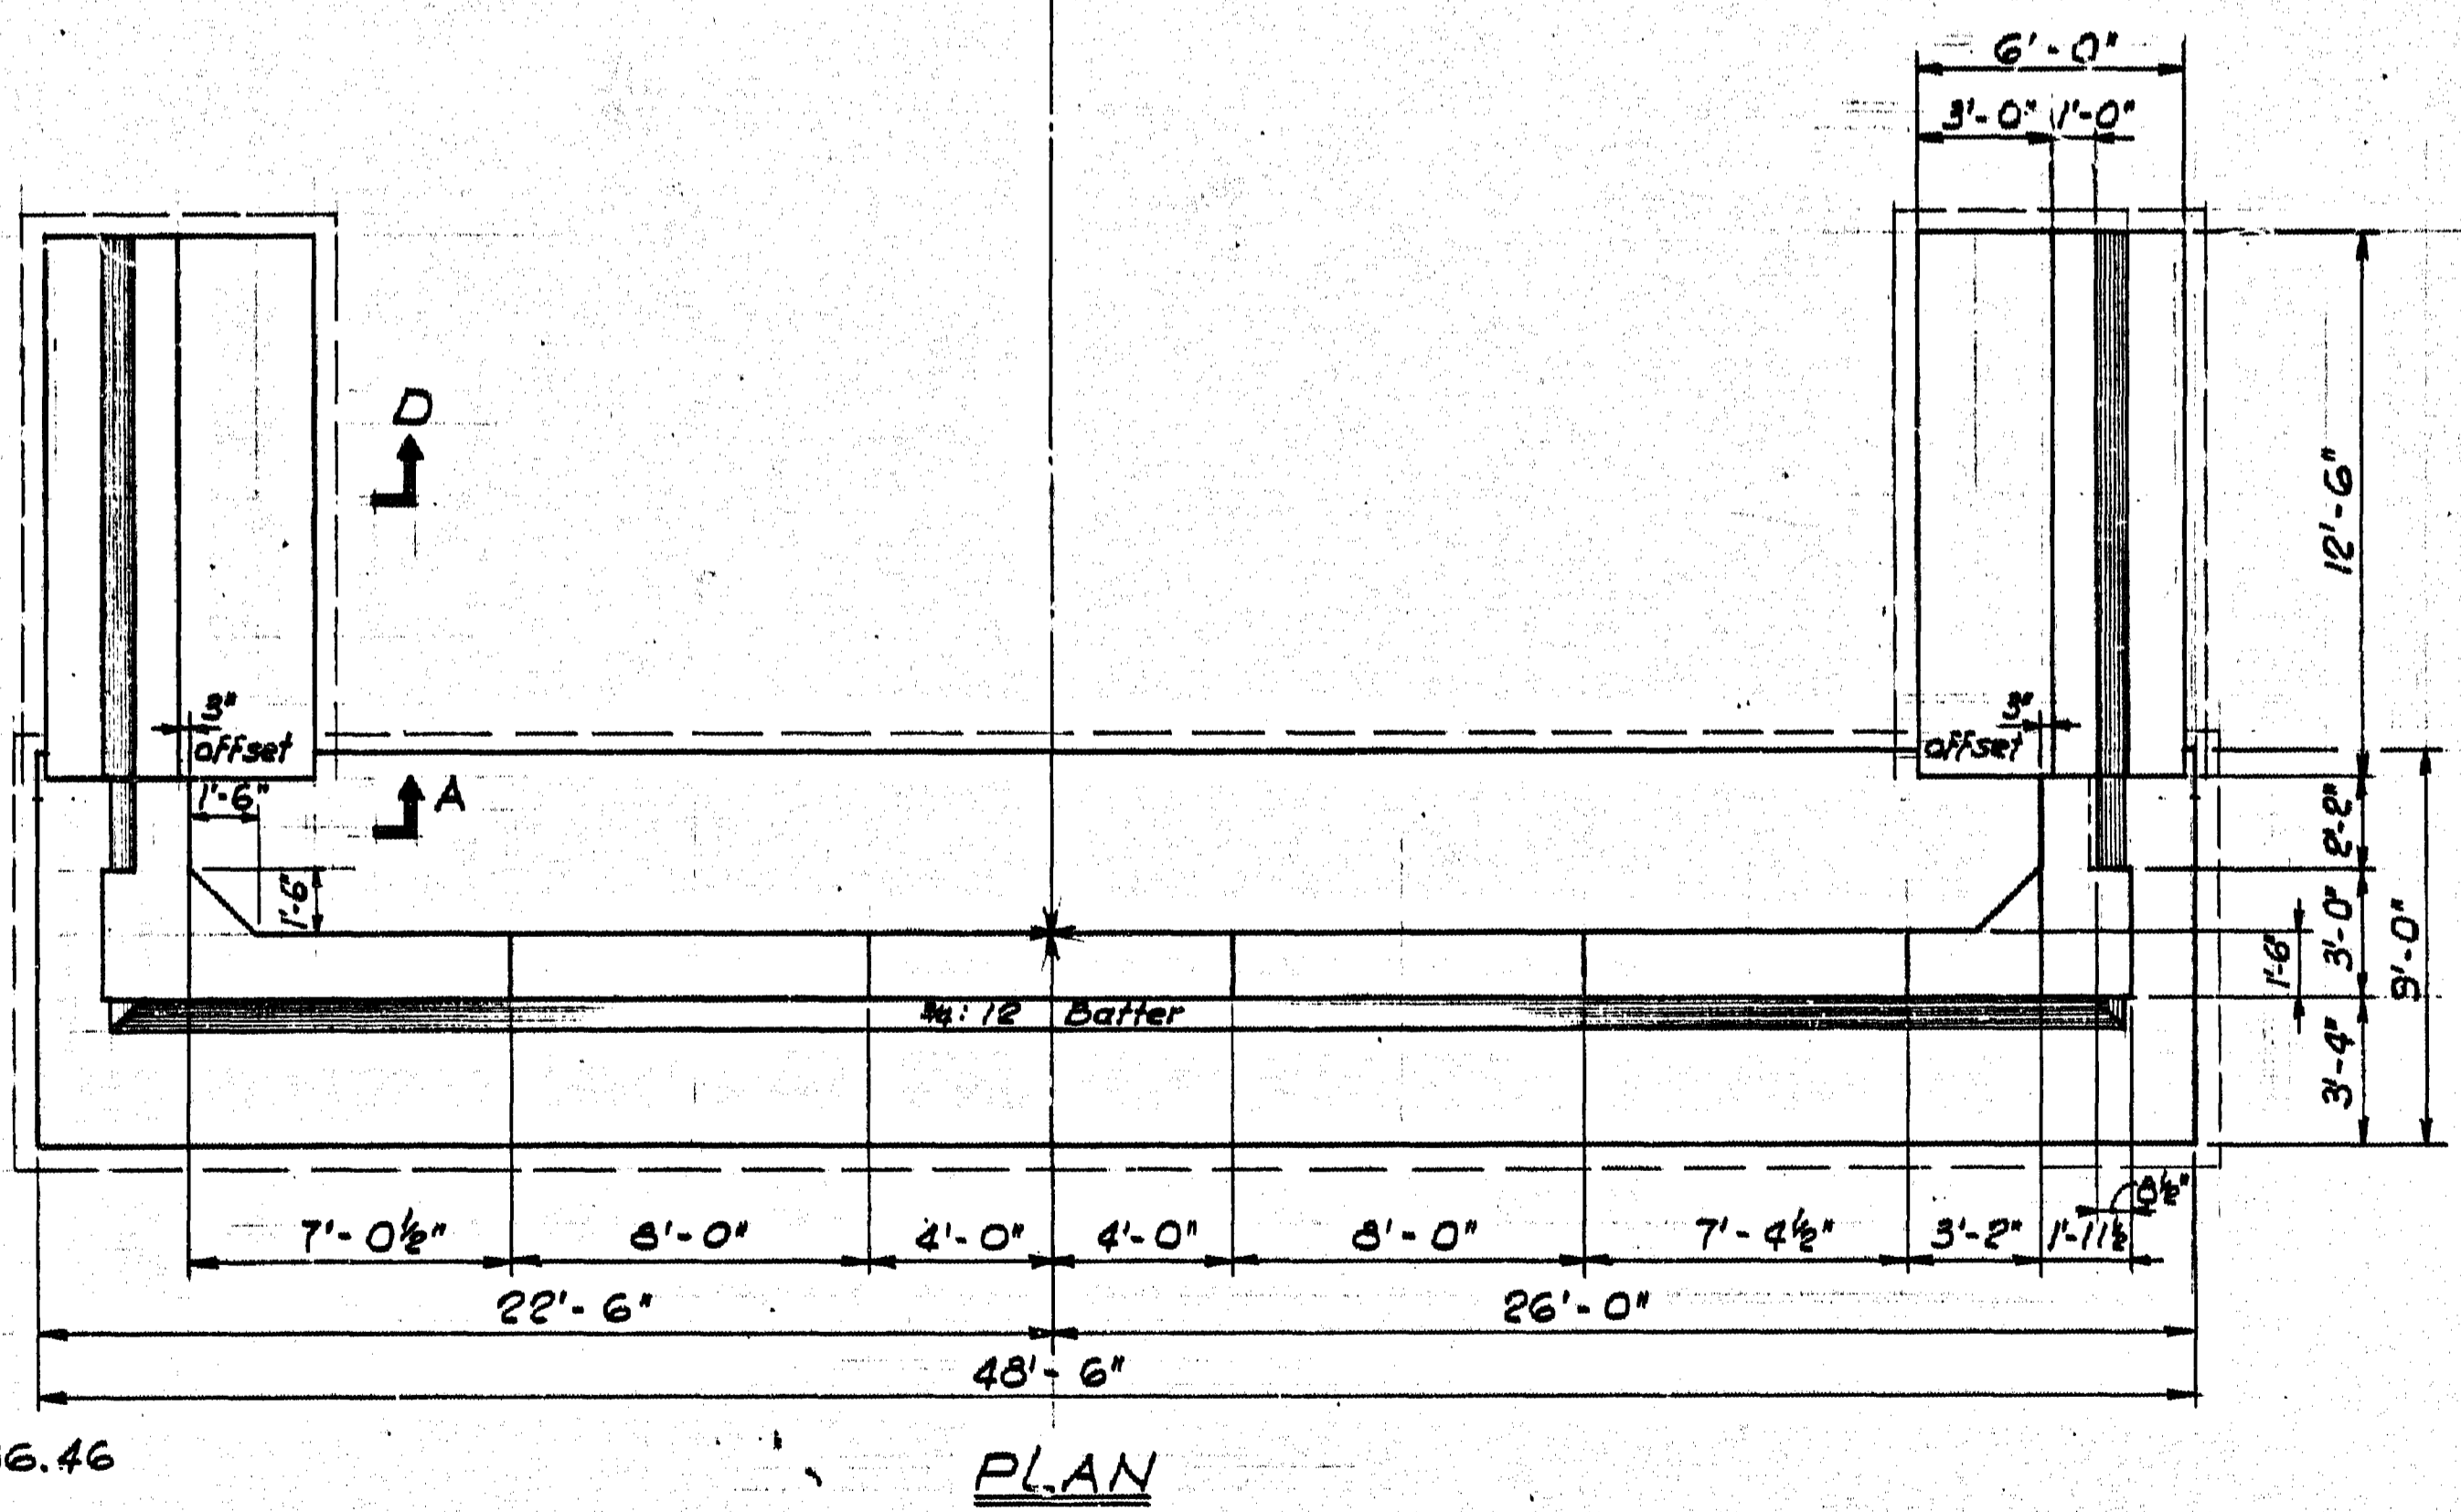

PLAN

ESTIMATED QUANTITIES			
Class 'C' concrete	Class 'A' concrete	Formwork	Reinf. Steel
6.5 cu. yds.	89 cu. yds.	2120 sq. ft.	7900 lbs.

REVISIONS	DATE	BY	REASON
D			
C			
B			As built
A			Redrawn

Notes:
1. For General Notes see Dwg. 2542-4

GOVERNMENT OF BRITISH COLUMBIA
MINISTRY OF TRANSPORTATION, COMMUNICATION AND HIGHWAYS
BRIDGE ENGINEERING BRANCH

NELSON DISTRICT
SOUTHERN TRANS - PROVINCIAL HIGHWAY
ERIE CREEK BRIDGE 149287
NORTH ABUTMENT

SCALE: 1/4" = 1'-0" & as noted

DRAWN: D.C., May 79
CHECKED: J.E.S., June 79
APPROVED: MGE/ct
EXECUTIVE DIRECTOR OF ENGINEERING

DRAWING No. 2542-10 B