


Note "A"
Riprap for these areas to be stockpiled at site by M.O.H. To be placed by the bridge contractor after construction of piers.

NOTE:
Bearing pads to be ozone resistant natural rubber of 50 shore durometer hardness.

Notes:
1. Design Specifications: A.A.S.H.O. 1973.
2. Live load: H. 5. 25.

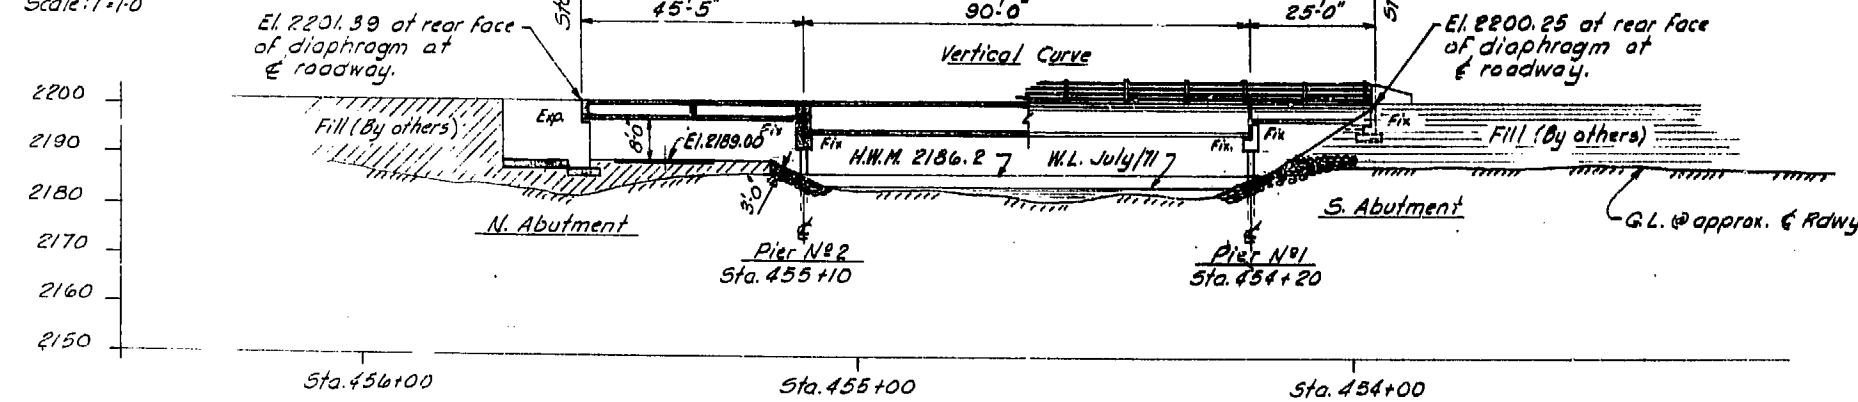

GOVERNMENT OF BRITISH COLUMBIA
MINISTRY OF TRANSPORTATION, COMMUNICATION AND HIGHWAYS
BRIDGE ENGINEERING BRANCH

NELSON DISTRICT
SOUTHERN TRANS - PROVINCIAL HIGHWAY
ERIE CREEK BRIDGE 149280
GENERAL ARRANGEMENT

D	As built	J.T.H. Nov 80	RECOMMENDED	SCALE: 1"=20' and as noted.
C	Bearing Pads & Dowel Layout	J.E.S. May 78	SENIOR BRIDGE DESIGN ENGINEER	DRAWN: J.E.S. May 78 CHECKED: E.L. Jun 78
B	Revised & redrawn	J.E.S. May 78	RECOMMENDED	APPROVED: 1978-07-25 DRAWING NO.
A			DIRECTOR OF BRIDGES & BEAMS	2542-3C

CANCEL PRINTS BEARING EARLIER LETTER