

PITEAU ASSOCIATES
Geotechnical and Hydrogeological Consultants
Vancouver Lima

LOG OF MW07-01

CITY OF QUESNEL, BC RAILWAY COMPANY
AS-BUILT REPORT FOR
REMEDIAL WORKS AT LEGION DRIVE
CONTAMINATED SITE
QUESNEL, B.C.


Drilling Contractor : Geotech Drilling Services Ltd.
Drilling Method : ODEX
Project Supervisor : David Tiplady
Field Engineer : Christopher Homes
Date : December 19, 2007

Project Number : 2452
Borehole Location : See Fig. 1
Hole Diameter : 114mm

Depth in metres	DESCRIPTION	GRAPHIC	REMARKS
-----------------	-------------	---------	---------

0	Asphalt		(0.05)
0.5	Blue-grey c gravel, tr. sand (fill)		
1			
1.5			
2			
2.5			
3	Moist blue-grey gravel, tr. sand (fill)		(2.90)
3.5			
4			
4.5	Brown + grey gravel, some sand		(4.58)
5			
5.5			Water Level Dec. 20/07 5.325m-btoPVC
6			(5.94)

Stick-up: MW07-01

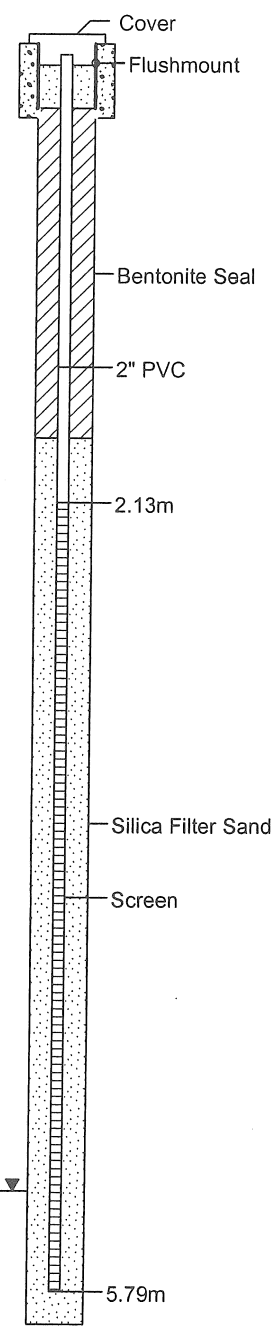

01-08-2008 h:\Project\2452\Logs\MW07-01.BOR