

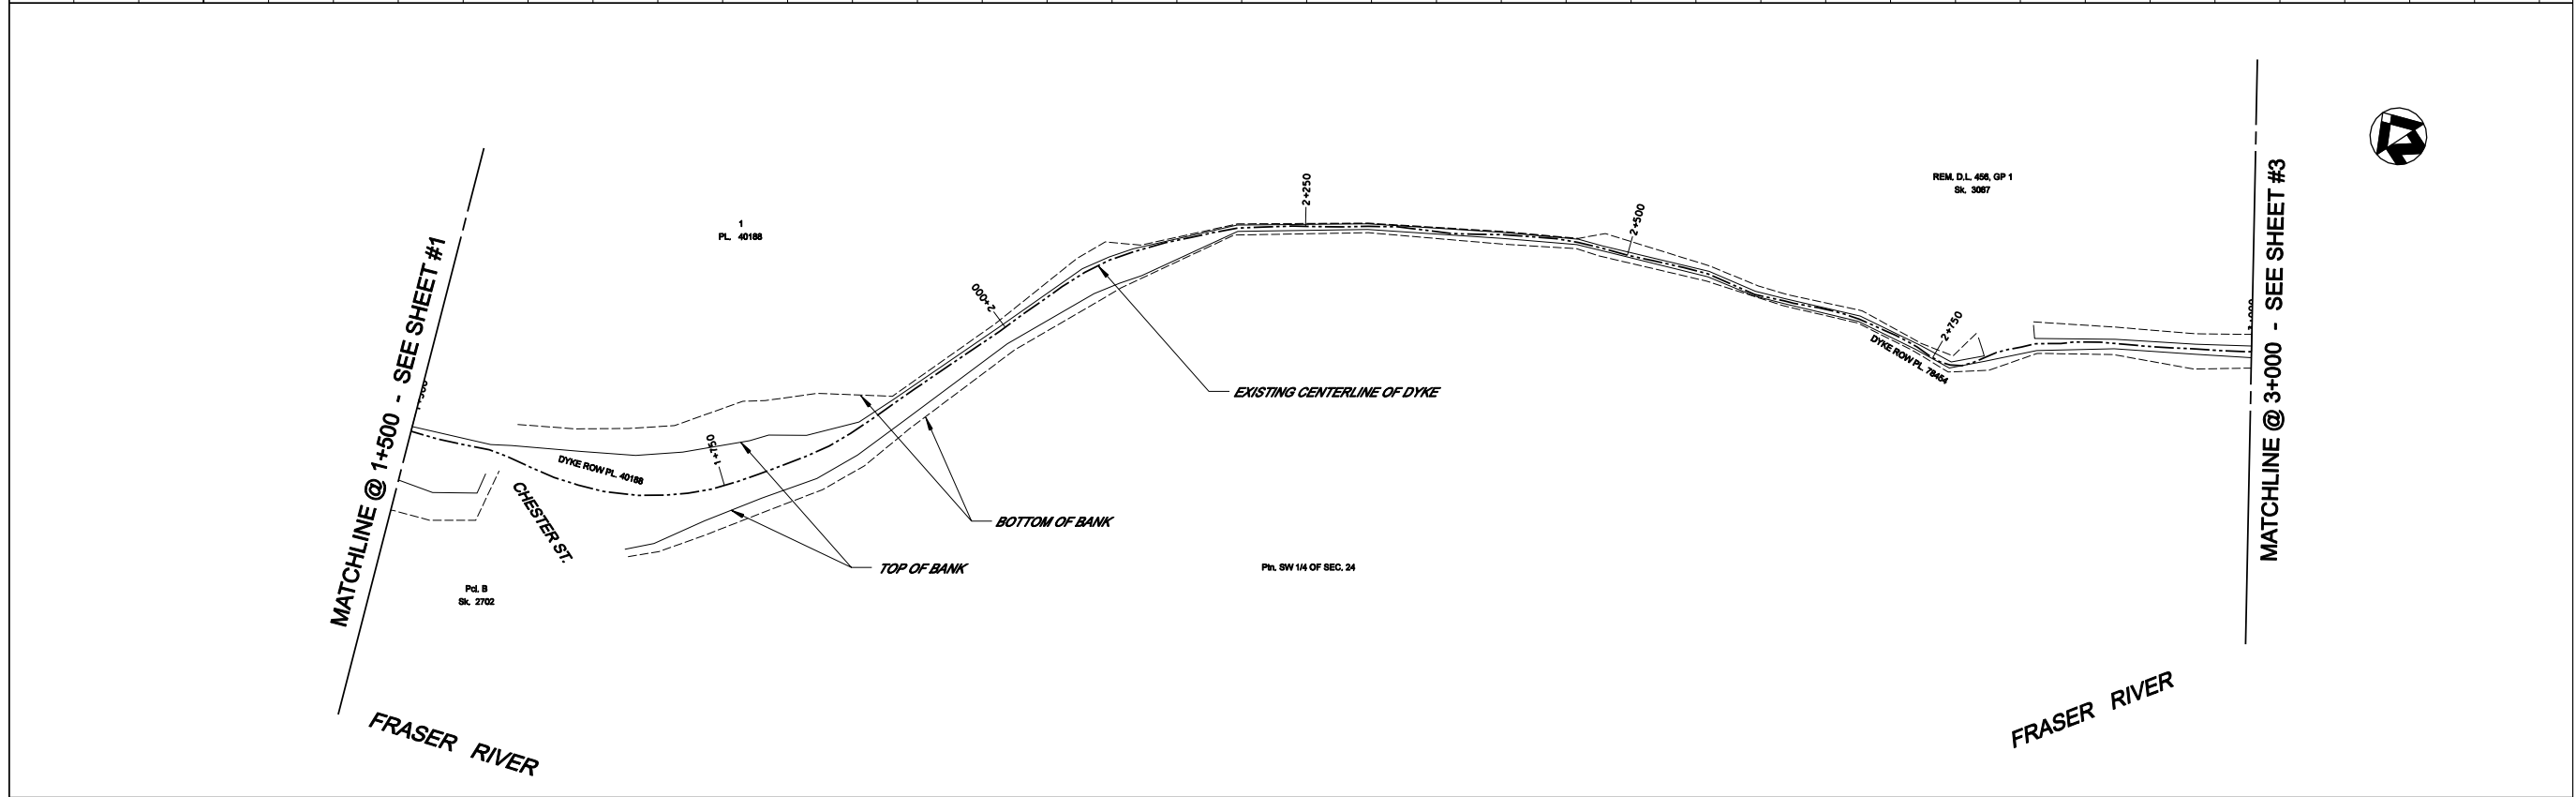
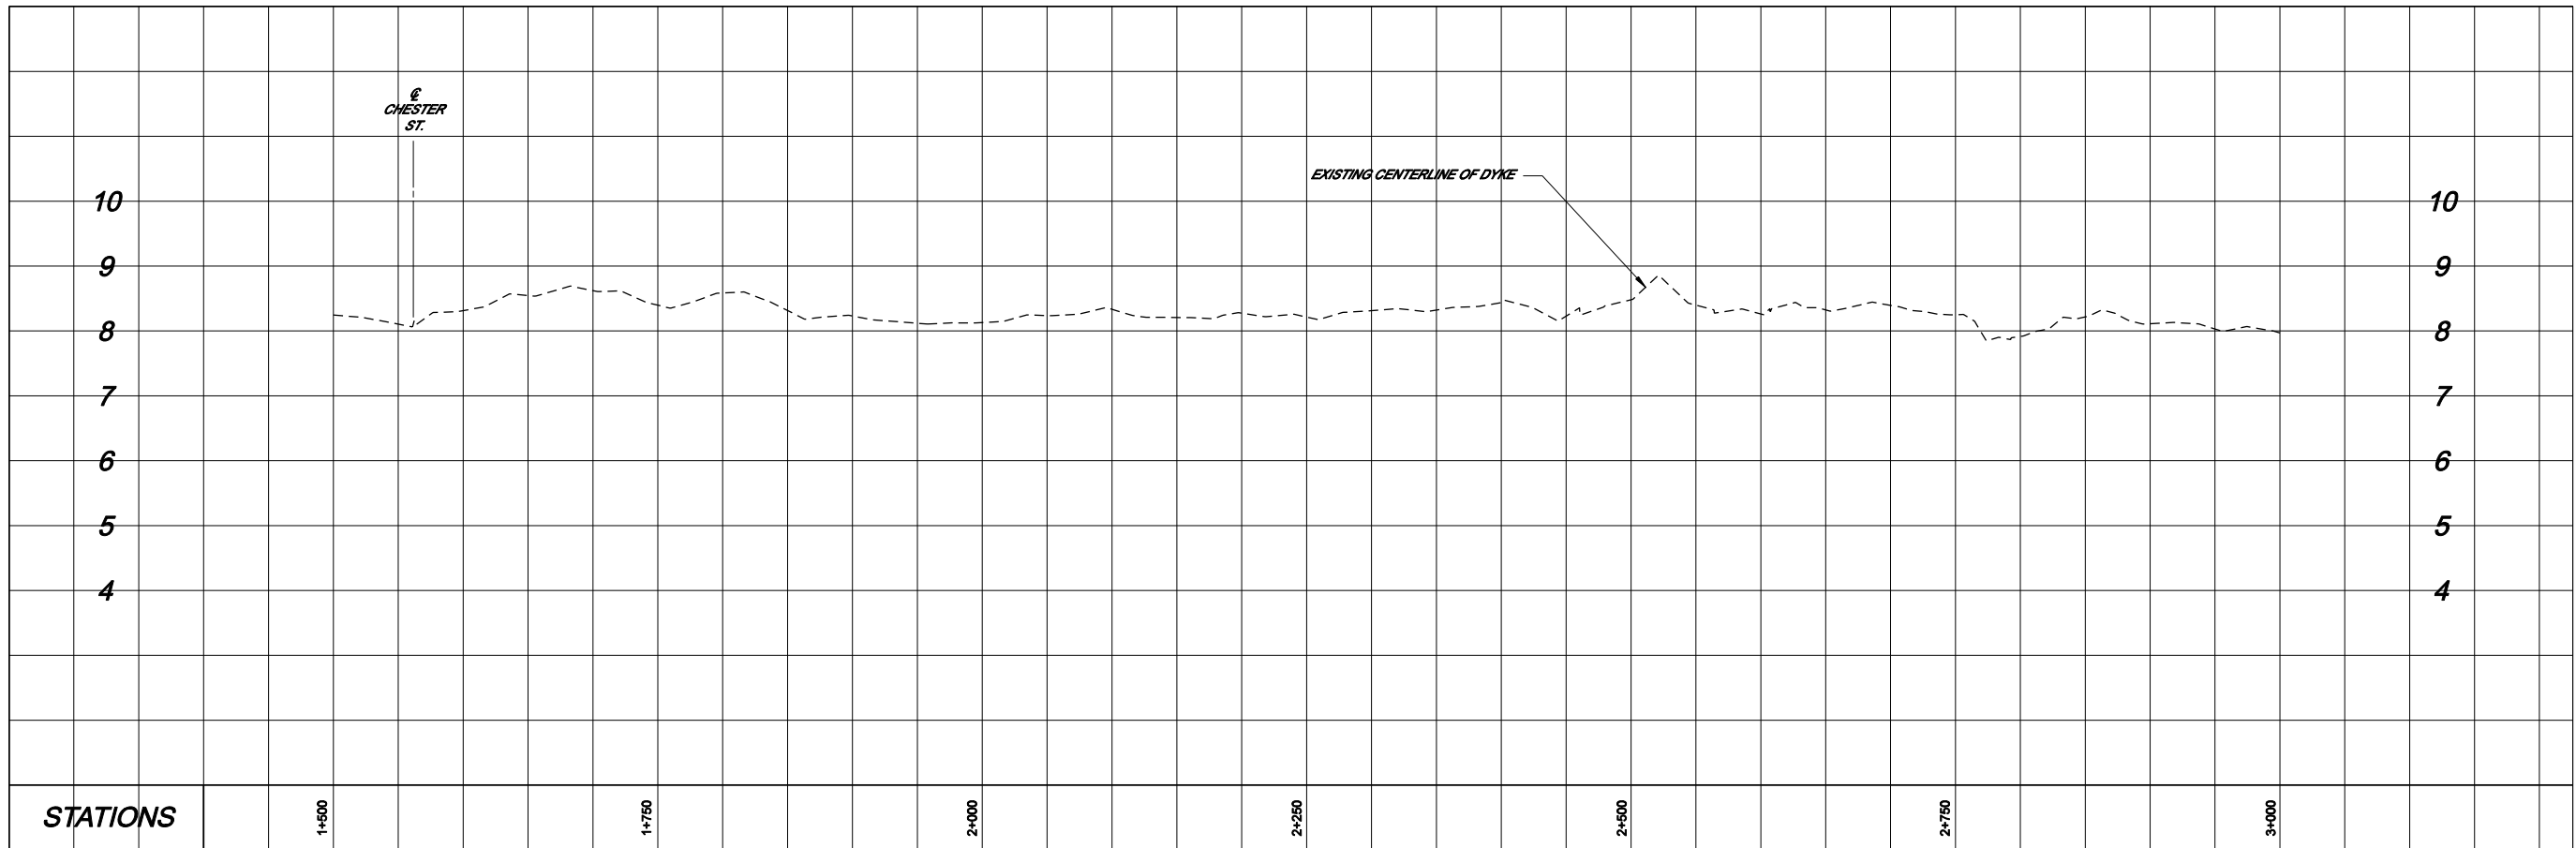














				DISTRICT OF MISSION			
				SILVERDALE DYKE - S. OF LOUGHEED HWY. TO W. OF CHESTER ST.			
				DESIGN			SCALE Plan - 1:2000 Elev - 1:50
				DRWR	R.S.		DATE MARCH 2008
				PROJECT			DRAWING No.
				APPROVED			SHEET No. 1 of 3
REV	DATE	DRN	CH				

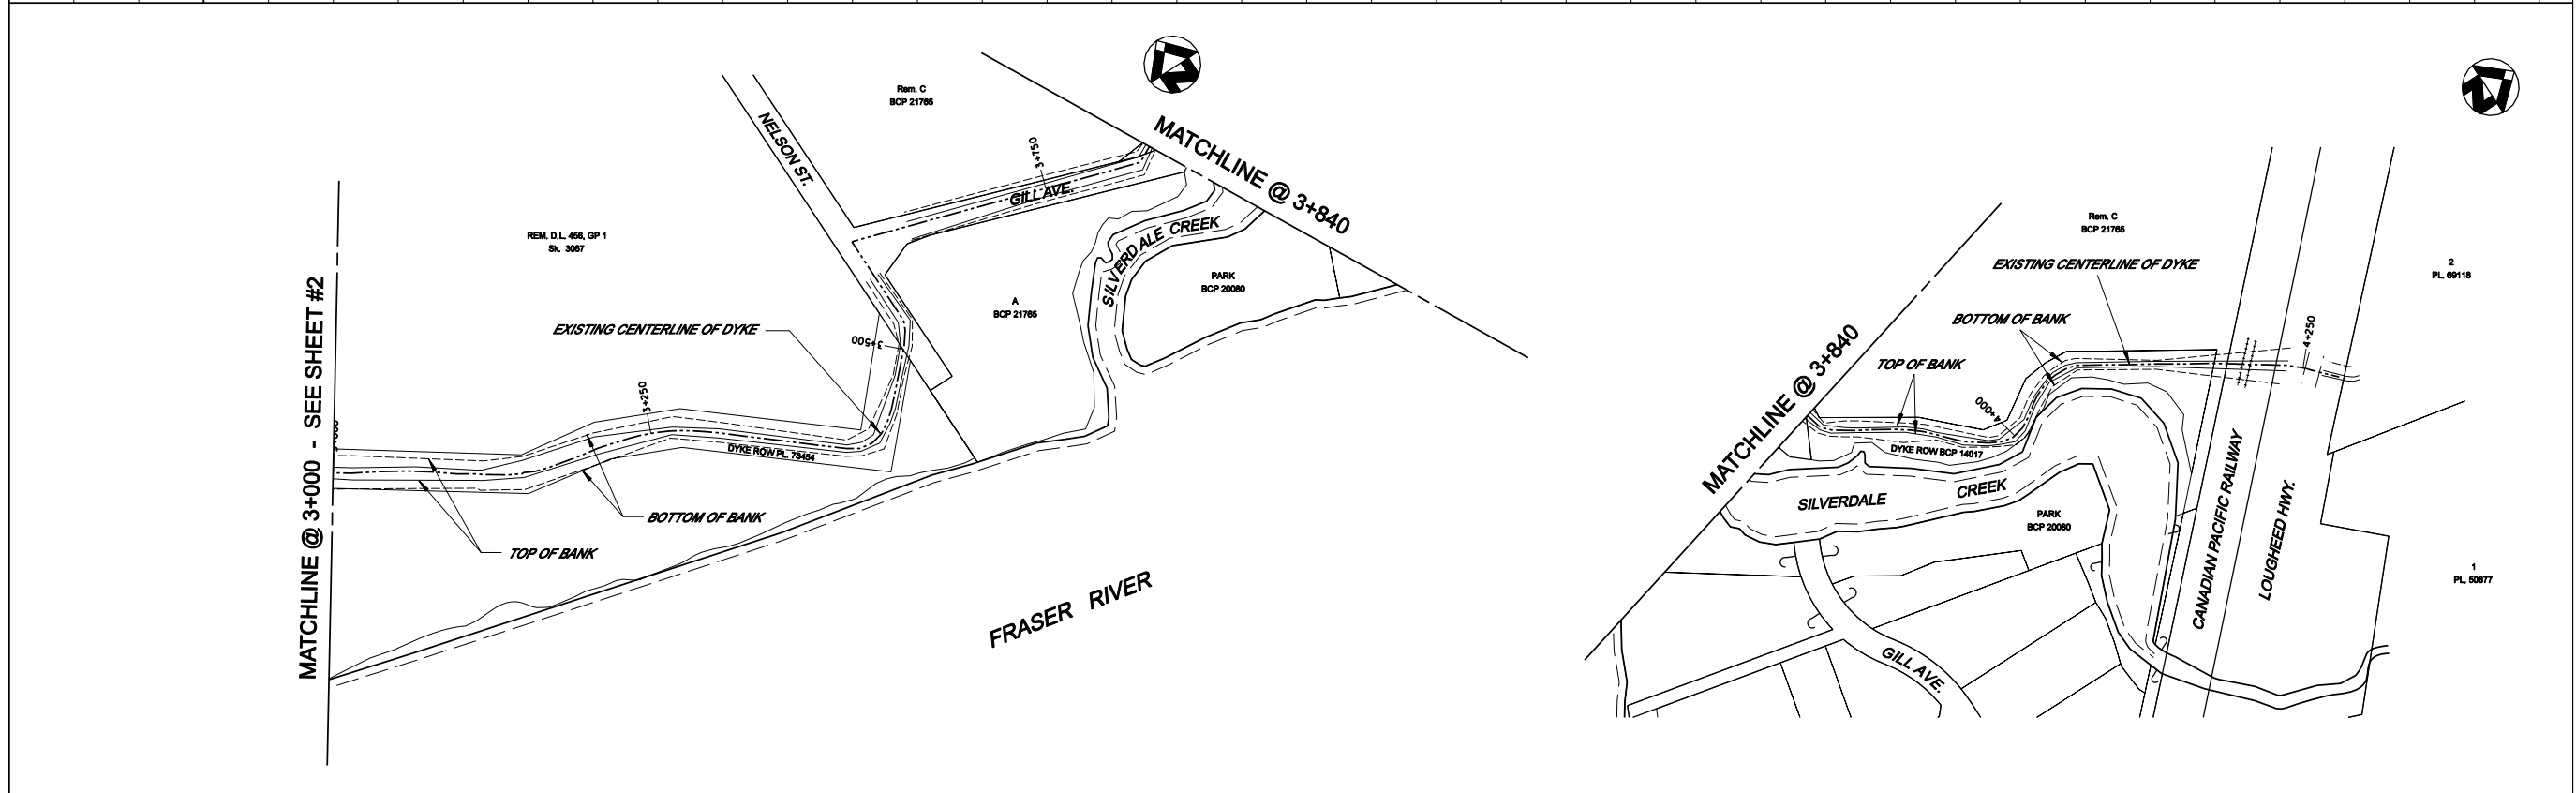

				DISTRICT OF MISSION			
				SILVERDALE DYKE - FROM CHESTER ST. TO W. OF NELSON ST.			
				DESIGN			SCALE Plan - 1:2500 Elev - 1:50
				DRWR	R.S.		DATE MARCH 2008
				PROJECT			DRAWING No.
				APPROVED			SHEET No. 2 of 2
REV	DATE	DRN	CH				

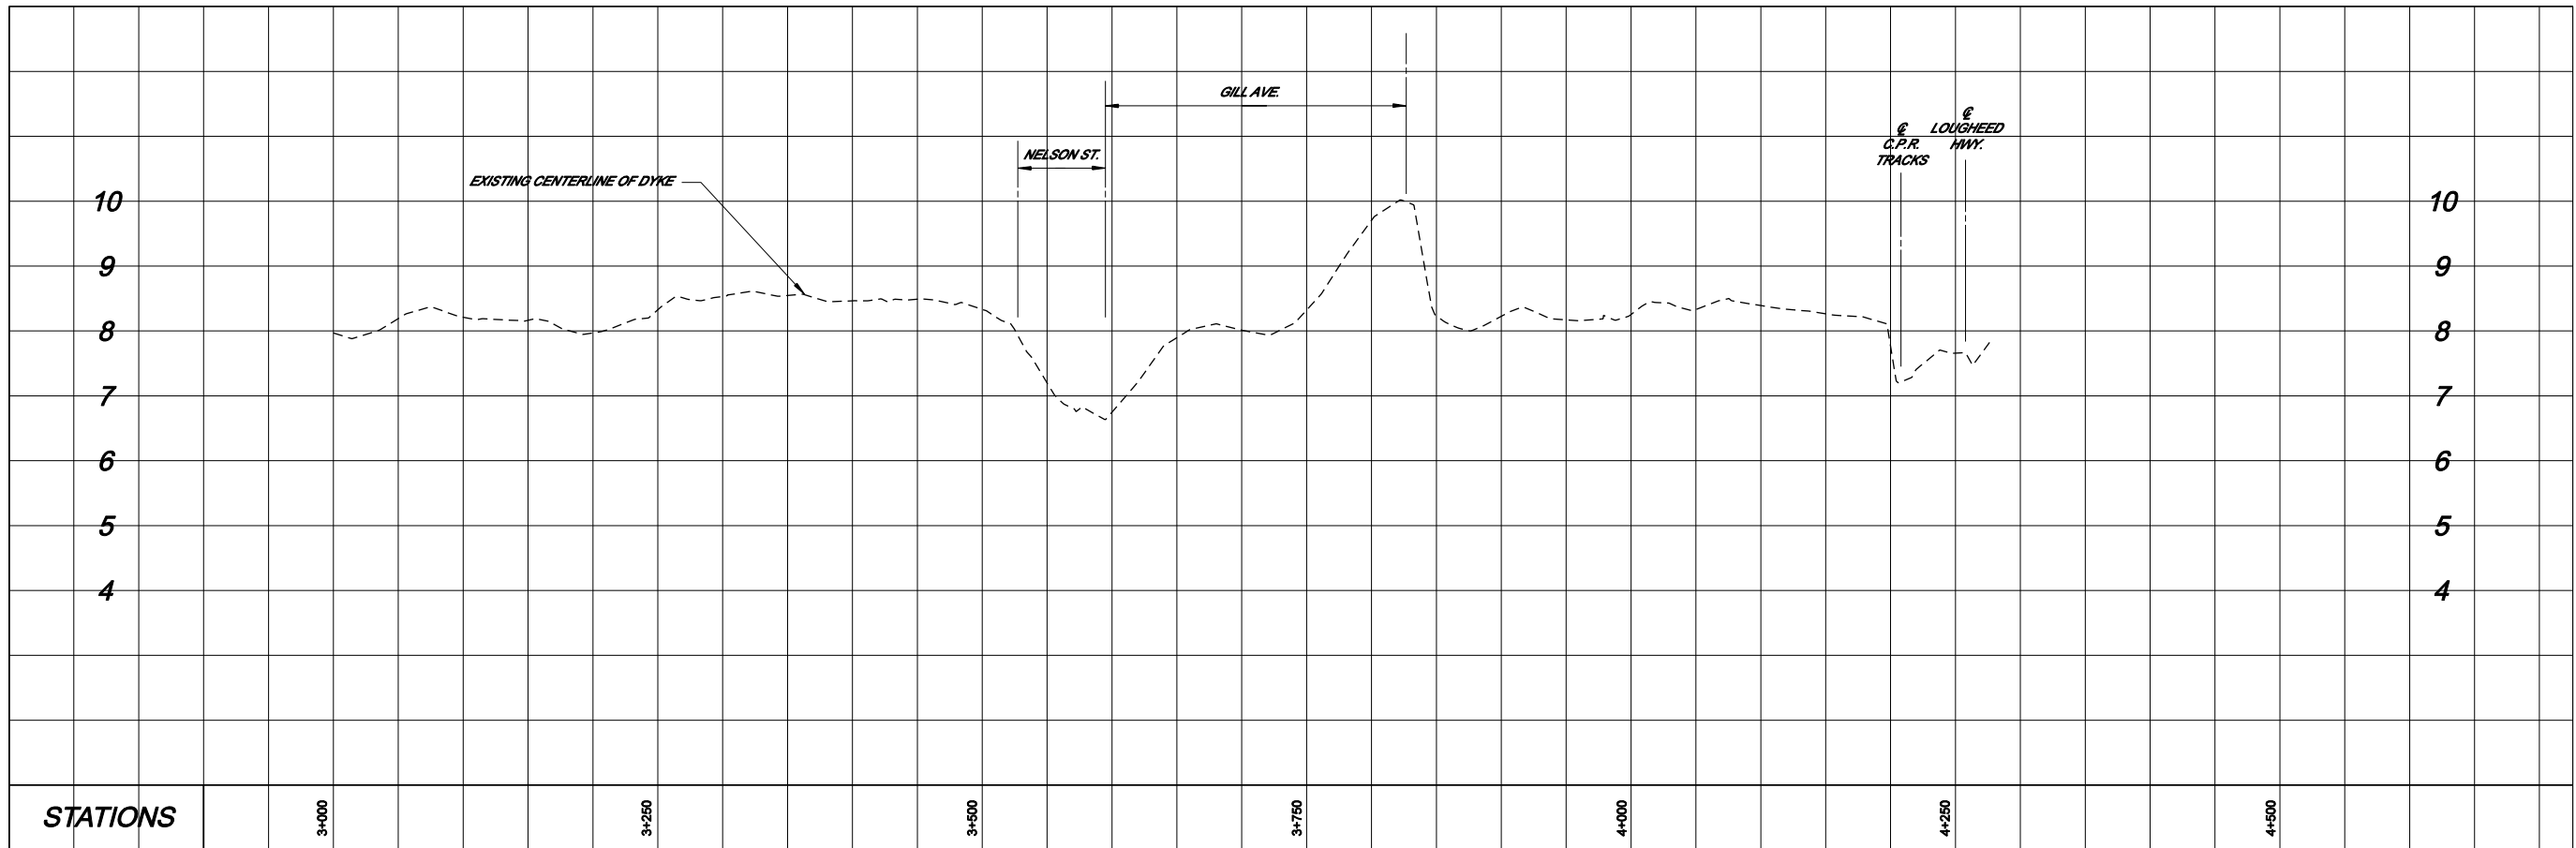

				DISTRICT OF MISSION			
				SILVERDALE DYKE - W. OF NELSON ST. TO LOUGHEED HWY.			
				DESIGN	R.S.		SCALE Metric - 1:2000 Imperial - 1:500
				DATE	MARCH 2008		DATE
				PROJECT			DRAWING No.
				APPROVED			SHEET No. 3 of 3
REV#	DATE	DRN	CH				

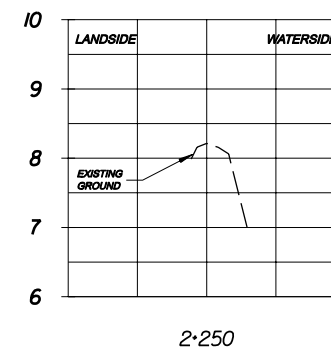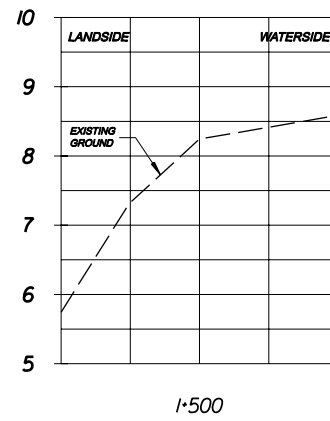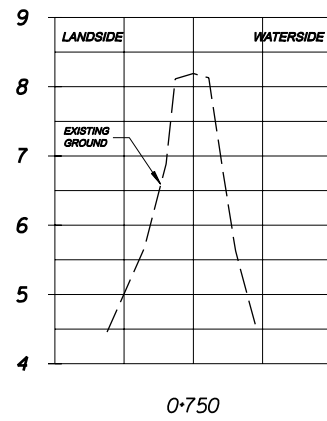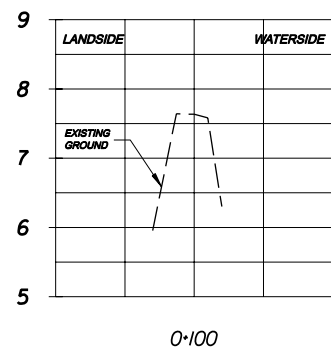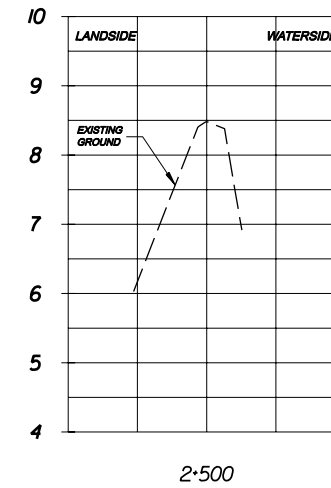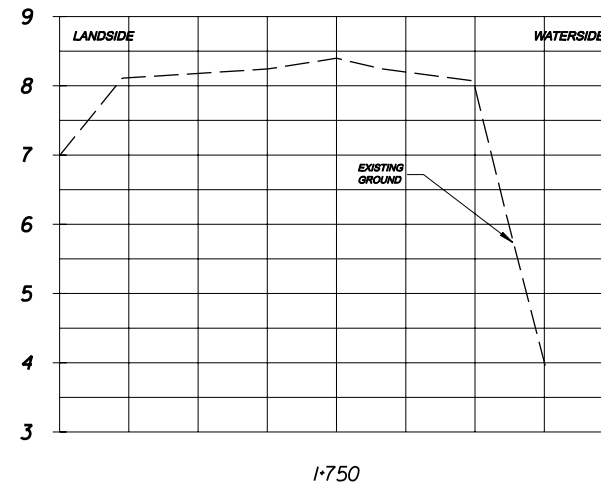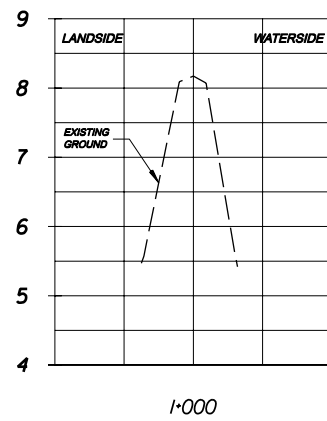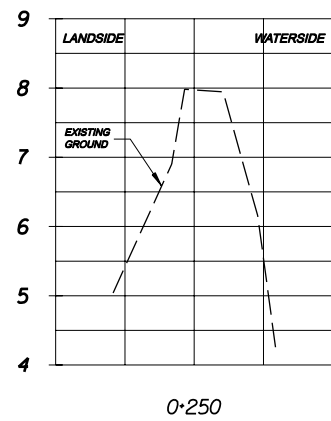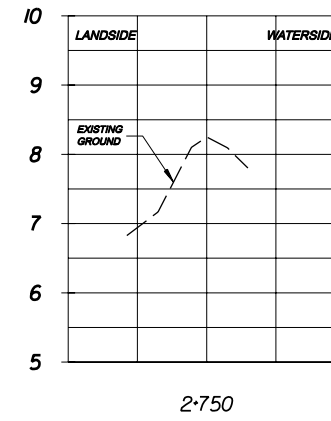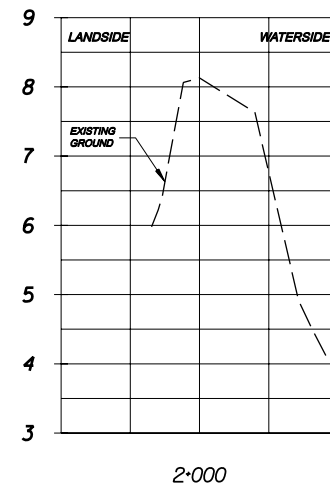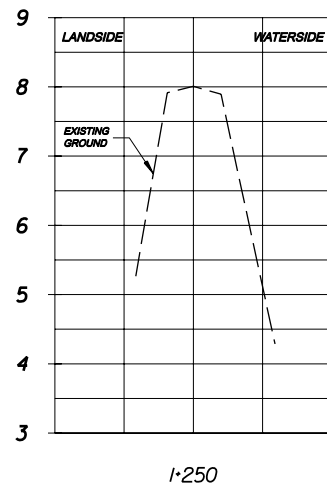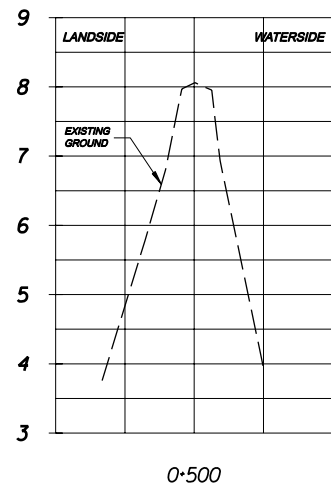

DISTRICT OF MISSION

**SILVERDALE DYKE -
CROSS-SECTIONS
STA. 0+100 TO STA. 2+750**

SCALE
HORIZ. - 1"=50'
VERT. - 1"=5'
DATE
MARCH, 2008
DRAWING No.
SHEET No.
1 of 2

DESIGN
DRYR R.S.
PROJECT
APPROVED

REV#	DATE	DRN	CH

