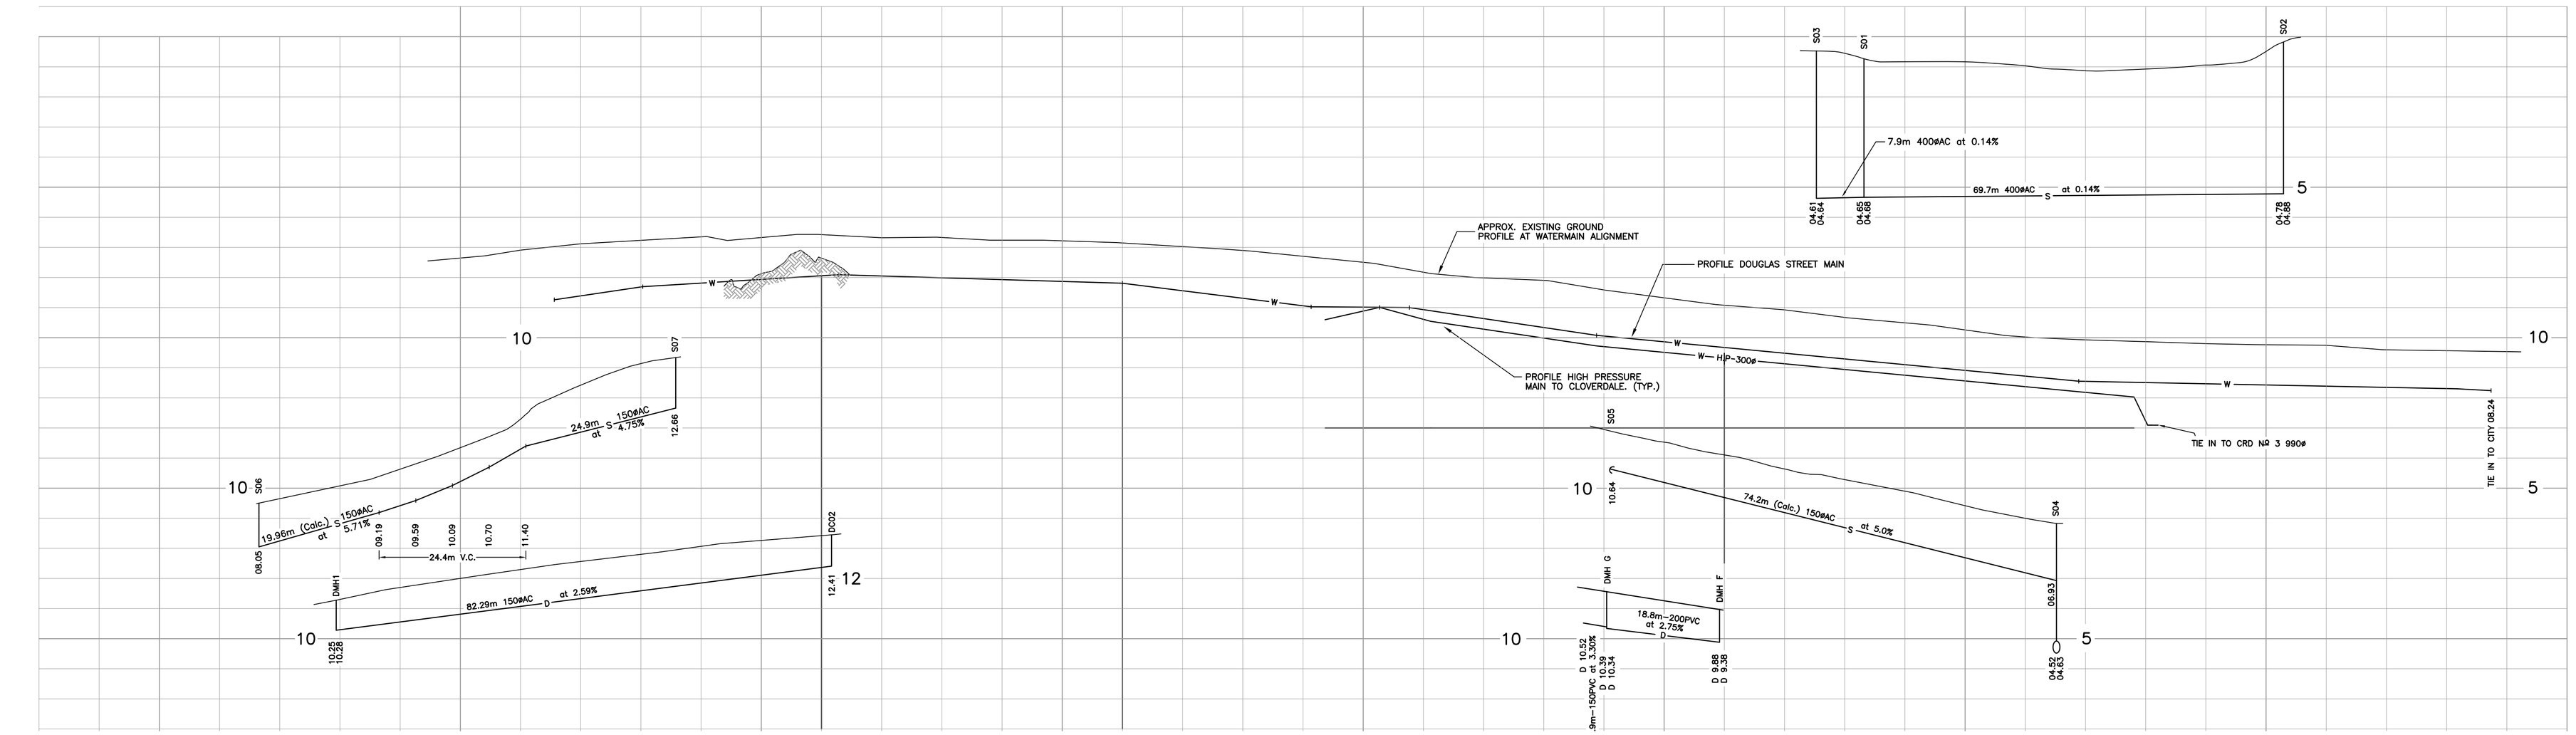

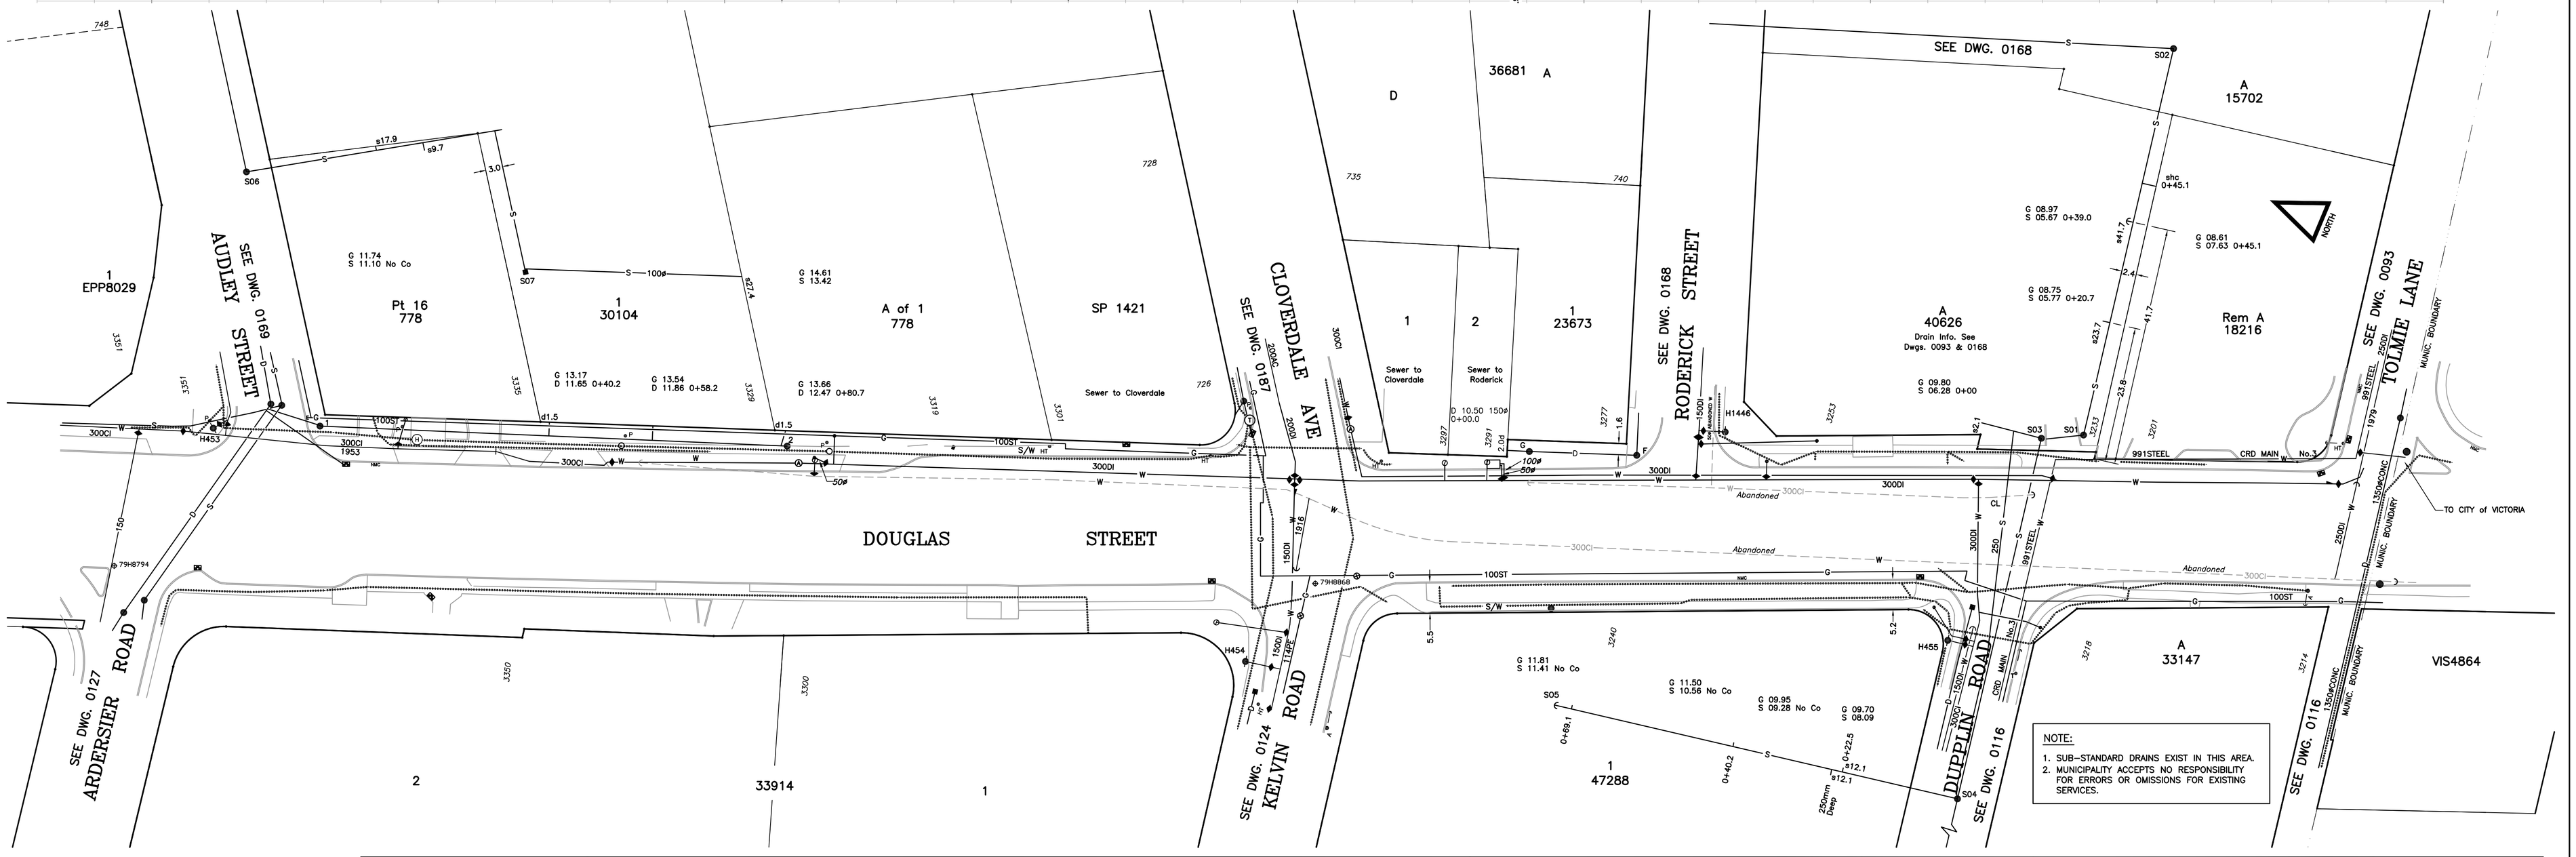

NOTE:

1. SUB-STANDARD DRAINS EXIST IN THIS AREA.
2. MUNICIPALITY ACCEPTS NO RESPONSIBILITY FOR ERRORS OR OMISSIONS FOR EXISTING SERVICES.

CONFIRM UNDERGROUND LOCATION WITH UTILITY COMPANIES

LEGEND – Existing services shown solid

Standard Mount	▷ 175 ▷ 250 ▷ 400 ◇ Post 175	Curb	—C—	Sidewalk S/W	Silt Trap ☑	Valve ◇
Pole Mount	○ 175 ○ 250 ○ 400	Ditch	—D—	Water —W—	Concrete Box ☒	Flush Valve ◇
Existing U/G Utilities	ooooooooooooooooooooooooo	Drain	—D—		Wood Box ○	Hydrant ◇
Proposed U/G Utilities	.....	Gas	—G—	Manhole ○	Catch Basin ⊞	Reducer —<
		Sewer	—S—	Cleanout □	Cap —>	Plug —<

REVISIONS	
3	
2	
1	CAD Conversion

REVISIONS APPROVED	REVISION # 1		REVISION # 2		REVISION # 3	
	Approved	Date	Approved	Date	Approved	Date
Design Engineer						
Manager of Development						
Development Coordinator						

DESIGN APPROVED		
EXCEPTIONS		
Approved By	Date	Signed
Design Engineer		
Manager of Development		
Development Coordinator		

DISTRICT OF SAANICH

DOUGLAS STREET

B.M. : 79H8868 Elev: 12.516

Design: Drawn: lpb Checked:

Scale: Hor: 1:500 Vertical: 1:100 Date: Dec. 2009

FILE No.	Map Shts. 5&10
DESIGN No.	
DRAWING No.	1115_12

8/15/2012 9:39:27 AM