



TYPICAL DECK SECTION
1/2" = 1'-0"

1/2" = 1'-0"


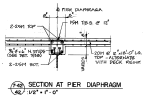


NOTES

3. FOR ADDITIONAL DIMENSIONS NOTES SEE DRAWING 31-25.

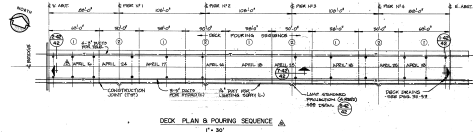


DECK PLAN & POURING SEQUENCE
1" = 30'

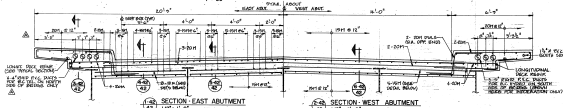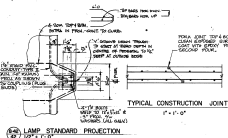

SECTION - EAST ABUTMENT
1/2" = 1'-0"

SECTION - WEST ABUTMENT
1/2" = 1'-0"

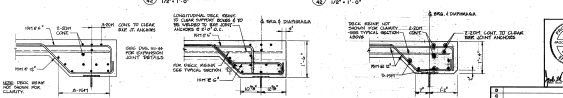

DETAIL
1" = 1'-0"

DETAIL
1" = 1'-0"

DETAIL
1" = 1'-0"

REID, CROWTHER & PARTNERS LIMITED

MINISTRY OF TRANSPORTATION AND HIGHWAYS
BRIDGE ENGINEERING BRANCH

VERNON HIGHWAYS DISTRICT
MABEL LAKE ROAD
ENDERBY BRIDGE
DECK DETAILS

REVISIONS

DATE: 1973.17

SCALE: AS SHOWN

PROJECT: MABEL LAKE ROAD

BRIDGE: ENDERBY BRIDGE

DECK DETAILS

NO. 31-42 B