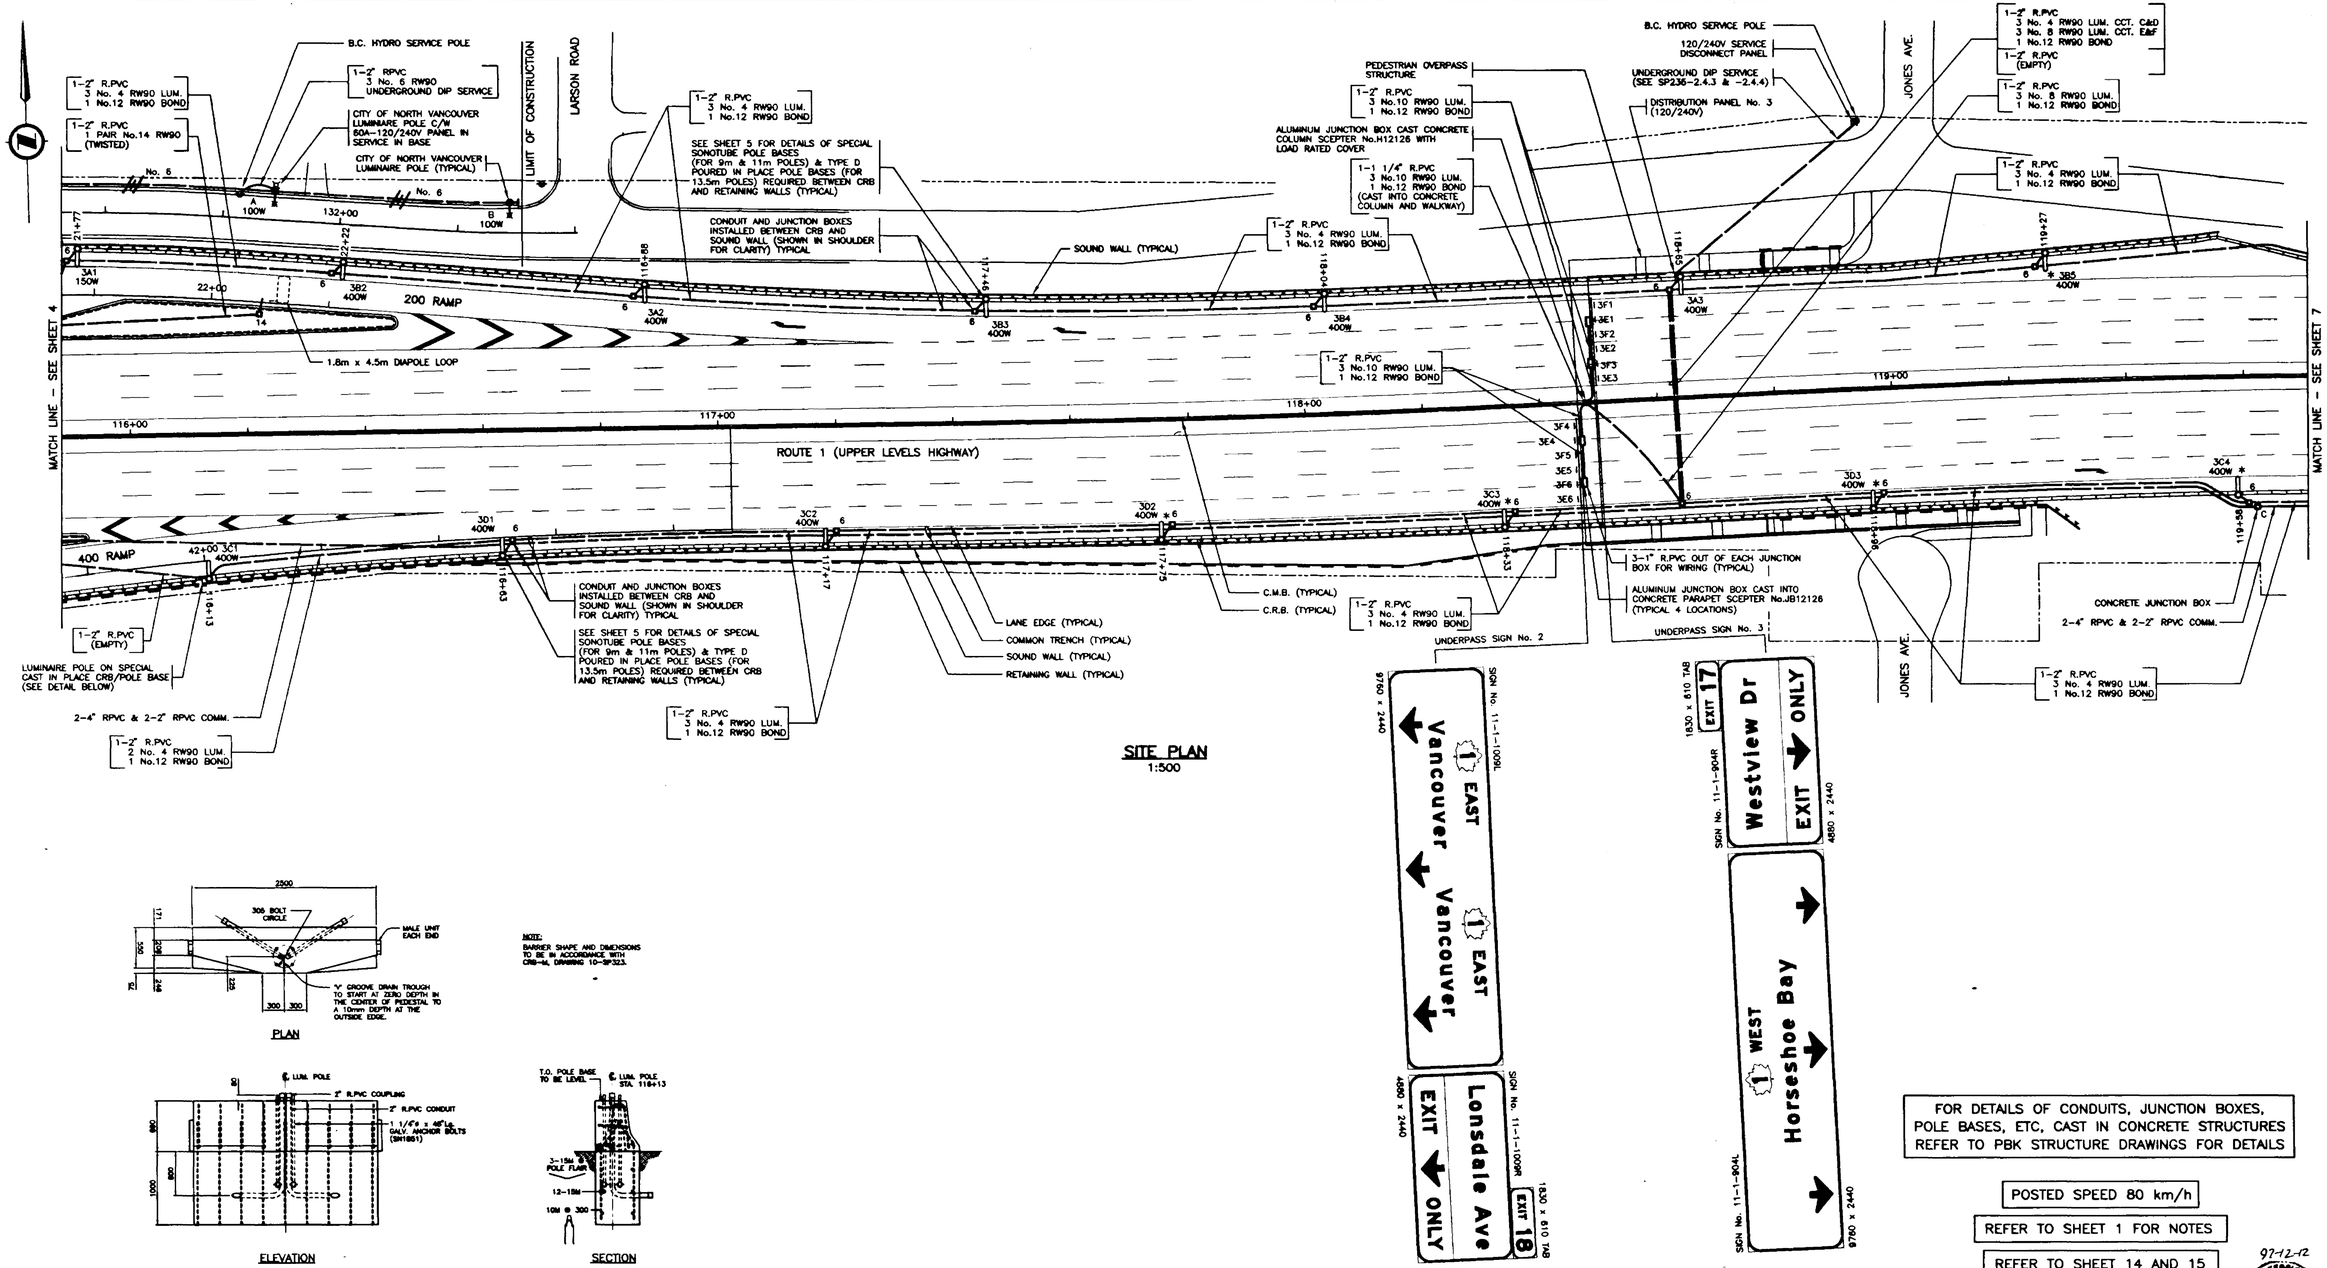

SITE PLAN
1:500

SPECIAL CAST IN PLACE COMBINATION C.R.B/LUMINAIRE POLE BASE
1: 25

FOR DETAILS OF CONDUITS, JUNCTION BOXES, POLE BASES, ETC, CAST IN CONCRETE STRUCTURES REFER TO PBK STRUCTURE DRAWINGS FOR DETAILS

POSTED SPEED 80 km/h

REFER TO SHEET 1 FOR NOTES

REFER TO SHEET 14 AND 15 FOR POLE ELEVATIONS

REFER TO SHEET 21 FOR SIGN ELEVATIONS

97-12-12
ASSOCIATION OF ENGINEERS AND GEOSCIENTISTS OF B.C.
D. J. WONG
PROFESSIONAL ENGINEER

LEGEND

- PROPOSED CONCRETE BASE WITH FUTURE LUMINAIRE POLE
- CONCRETE BASE AND JUNCTION BOX
- 10 JUNCTION BOX - No. DENOTES TYPE
- F LUMINAIRE POLE (SINGLE) 'F' DENOTES FRANGIBLE BASE 'B' DENOTES BREAKAWAY BASE
- DOUBLE LUMINAIRE POLE
- POST TOP MOUNTED LUMINAIRE
- TRAFFIC SIGNAL POLE WITH DAVIT AND SIDE OF POLE MOUNTED HEADS
- COMBINATION LUMINAIRE/DAVIT MOUNTED TRAFFIC SIGNAL POLE
- POST TOP MOUNTED SIGNAL
- EXISTING CONCRETE BASE WITH PROPOSED LUMINAIRE POLE
- CITY OR DISTRICT OF NORTH VANCOUVER LUMINAIRE POLE
- DAVIT MOUNTED ILLUMINATED SIGN POLE WITH AMBER FLASHERS
- COMBINATION LUMINAIRE/DAVIT MOUNTED ILLUMINATED SIGN WITH AMBER FLASHERS
- DAVIT MOUNTED SIGN (NON-ILLUMINATED)
- DAVIT MOUNTED ILLUMINATED SIGN POLE
- COMBINATION LUMINAIRE/DAVIT MOUNTED NON-ILLUMINATED SIGN POLE
- BREAKAWAY SIGN (NON-ILLUMINATED)
- ILLUMINATED BREAKAWAY SIGN
- PROPOSED CONCRETE BASE WITH PROPOSED LUMINAIRE POLE
- PEC PHOTO ELECTRIC CELL
- RPVC RIGID P.V.C. CONDUIT
- R.M.C RIGID METALLIC CONDUIT
- F.M.C. FLEXIBLE METALLIC CONDUIT (LIQUID TIGHT)
- OVERHEAD FLASHING BEACON
- POST MOUNTED FLASHER
- BACKGUY
- POWER POLE
- TELEPHONE POLE
- POWER/TELEPHONE POLE
- TEST SWITCH
- 1P 2P BREAKER
- NEUTRAL BAR
- VEHICLE DETECTOR LOOP
- A,B,A1,A2,ETC. SIGNAL HEAD VEHICLE PHASE
- PA,PB,PA1,PB2,ETC. SIGNAL HEAD PEDESTRIAN PHASE
- ppb PEDESTRIAN PUSHBUTTON
- —G— U/G UTILITY 'G' DENOTES GAS 'S' DENOTES STORM DRAINS/SEWERS 'W' DENOTES WATER 'UE' DENOTES ELECTRIC 'UT' DENOTES TELEPHONE 'SAN' DENOTES SANITARY SEWER
- RAISED CURB
- PROPERTY LINE
- EDGE OF GRAVEL SHOULDER
- EDGE OF PAVEMENT
- PAINT LINE
- PROPOSED UNDERGROUND CONDUIT
- EXISTING UNDERGROUND CONDUIT
- FENCE
- CORRUGATED METAL PIPE (CULVERT)
- RETAINING WALL
- SOUND WALL
- CONCRETE ROADSIDE OR MEDIAN BARRIER
- No.8 2 No.8 RW90 & 1 No.8 RW90 BOND (CITY & DISTRICT OF NORTH VANCOUVER) OR 1 No.12 RW90 BOND (MINISTRY) IN CONDUIT
- No.8 3 No.8 RW90 & 1 No.8 RW90 BOND (CITY & DISTRICT OF NORTH VANCOUVER) OR 1 No.12 RW90 BOND (MINISTRY) IN CONDUIT

WALTER GROUP — WALTER & SCI Construction (Canada) Ltd. — SCI

SHAFLIK ENGINEERING LTD.
ELECTRICAL CONSULTANTS
202-8525 BAXTER PLACE, BURNABY, BC V5A 4V7 TEL: 604-421-4125 FAX: 604-421-8344

ELECTRICAL DESIGN APPROVED _____ DATE _____ DESIGNED D.S.M. DATE NOV95
SCALE AS NOTED VOLTAGE 120/240
HWY. DISTRICT HOWE SOUND CHECKED D.J.W. DATE 96-12-20

REV	DATE	DESCRIPTION	CONST	QA/QC
A	97-07-28	RECORD DRAWING	D.J.W.	A.J.
B	97-11-26	RECORD DRAWING REVISED		

REVISIONS

Province of British Columbia
MINISTRY OF TRANSPORTATION AND HIGHWAYS
WESTVIEW INTERCHANGE DESIGN BUILD

SIGNALS, LIGHTING AND DIRECTIONAL SIGNING INSTALLATION HOWE SOUND DISTRICT - HIGHWAY No.1 UPPER LEVELS HIGHWAY / WESTVIEW DRIVE INTERCHANGE NORTH VANCOUVER

SITE PLAN

Ministry of Transportation and Highways	PREPARED UNDER THE DIRECTION OF	ACCEPTED FOR CONSTRUCTION
South Coast Regional Office	ORIGINAL SIGNED BY	ORIGINAL SIGNED BY
7818 - 6th Street Burnaby, BC V5N 4N8	D. J. WONG CONSULTANT	A. JACK QC/QA MANAGER
	DATE 96-02-14	DATE 96-02-16

SHEET No.	PROJECT No.	REG.	DRAWING No.
SHEET 6 OF 22	06838	1	TE-95094-6 B

CANCEL PRINTS BEARING PREVIOUS LETTER

REHO7(02-94)