


REFER TO DRAWING TE-89037-8 (FINAL STAGE ELECTRICAL)
FOR EXISTING ELECTRICAL DESIGN AT LONSDALE AVENUE

POSTED SPEED 80 km/h
REFER TO SHEET 1 FOR NOTES
REFER TO SHEET 14 AND 15
FOR POLE ELEVATIONS
REFER TO SHEET 19 FOR
WOOD POST SIGN ELEVATIONS
REFER TO SHEET 22 FOR
FOR SIGN ELEVATIONS

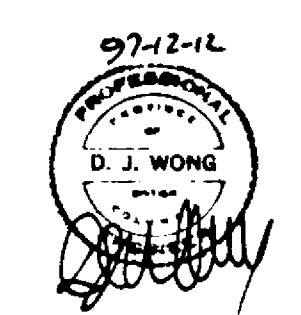

LEGEND									
	PROPOSED CONCRETE BASE WITH FUTURE LUMINAIRE POLE		EXISTING CONCRETE BASE WITH PROPOSED LUMINAIRE POLE		PEC		PHOTO ELECTRIC CELL		TEST SWITCH
	CONCRETE BASE AND JUNCTION BOX		CITY OR DISTRICT OF NORTH VANCOUVER LUMINAIRE POLE		RPVC		RIGID P.V.C. CONDUIT		BREAKER
	JUNCTION BOX - No. DENOTES TYPE		DAVIT MOUNTED ILLUMINATED SIGN POLE WITH AMBER FLASHERS		R.M.C.		RIGID METALLIC CONDUIT		NEUTRAL BAR
	LUMINAIRE POLE (SINGLE)		COMBINATION LUMINAIRE/DAVIT MOUNTED ILLUMINATED SIGN WITH AMBER FLASHERS		F.M.C.		FLEXIBLE METALLIC CONDUIT (LIQUID TIGHT)		VEHICLE DETECTOR LOOP
	DOUBLE LUMINAIRE POLE		DAVIT MOUNTED SIGN (NON-ILLUMINATED)				OVERHEAD FLASHING BEACON		A,B,A1,A2,ETC. SIGNAL HEAD VEHICLE PHASE
	POST TOP MOUNTED LUMINAIRE		DAVIT MOUNTED ILLUMINATED SIGN POLE				POST MOUNTED FLASHER		PA,PB,PA1,PB2,ETC. SIGNAL HEAD PEDESTRIAN PHASE
	TRAFFIC SIGNAL POLE WITH DAVIT AND SIDE OF POLE MOUNTED HEADS		COMBINATION LUMINAIRE/DAVIT MOUNTED NON-ILLUMINATED SIGN POLE				BACKGUY		PEDESTRIAN PUSHBUTTON
	COMBINATION LUMINAIRE/DAVIT MOUNTED TRAFFIC SIGNAL POLE		BREAKAWAY SIGN (NON-ILLUMINATED)				POWER POLE		U/G UTILITY
	POST TOP MOUNTED SIGNAL		ILLUMINATED BREAKAWAY SIGN				TELEPHONE POLE		'G' DENOTES GAS 'S' DENOTES STORM DRAINS/SEWERS 'W' DENOTES WATER 'E' DENOTES ELECTRIC 'UT' DENOTES TELEPHONE 'SAN' DENOTES SANITARY SEWER

WALTER & SCI Construction (Canada) Ltd.

SHAFLIK ENGINEERING LTD.
ELECTRICAL CONSULTANTS
202-8525 BAXTER PLACE, BURNABY, BC V5A 4V7 TEL: 604-421-4125 FAX: 604-421-8344

ELECTRICAL DESIGN APPROVED	DATE	DESIGNED	D.S.M.	DATE	NOV/95
SCALE AS NOTED	VOLTAGE	120/240			
HWY. DISTRICT HOWE SOUND	CHECKED	D.J.W.	DATE	95-12-20	
REV	DATE	DESCRIPTION	CONST	QA/QC	
A	97-07-29	RECORD DRAWING			
B	97-11-26	RECORD DRAWING REVISED			

REVISIONS

Province of British Columbia
MINISTRY OF TRANSPORTATION AND HIGHWAYS
WESTVIEW INTERCHANGE DESIGN BUILD

SIGNALS, LIGHTING AND DIRECTIONAL SIGNING INSTALLATION
HOWE SOUND DISTRICT - HIGHWAY No.1
UPPER LEVELS HIGHWAY / WESTVIEW DRIVE INTERCHANGE
NORTH VANCOUVER

SITE PLAN

Ministry of Transportation and Highways South Coast Regional Office 7818 - 6th Street Burnaby, BC V5N 4N8	PREPARED UNDER THE DIRECTION OF ORIGINAL SIGNED BY D. J. WONG CONSULTANT DATE 95-02-14	ACCEPTED FOR CONSTRUCTION ORIGINAL SIGNED BY A. JACK QC/QA MANAGER DATE 95-02-16
---	--	--

SHEET No.	PROJECT No.	REG.	DRAWING No.
SHEET 8 OF 22	06838	1	TE-95094-8

CANCEL PRINTS BEARING PREVIOUS LETTER

REVISIONS