


ELEVATIONS
1:75

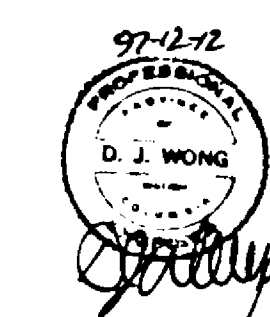

LEGEND					
PROPOSED CONCRETE BASE WITH FUTURE LUMINAIRE POLE	EXISTING CONCRETE BASE WITH PROPOSED LUMINAIRE POLE	PROPOSED CONCRETE BASE WITH PROPOSED LUMINAIRE POLE	TEST SWITCH	RAISED CURB	PROPERTY LINE
CONCRETE BASE AND JUNCTION BOX	CITY OR DISTRICT OF NORTH VANCOUVER LUMINAIRE POLE	PEC	BREAKER	EDGE OF GRAVEL SHOULDER	EDGE OF PAVEMENT
JUNCTION BOX - No. DENOTES TYPE	DAVIT MOUNTED ILLUMINATED SIGN POLE WITH AMBER FLASHERS	RPVC	NEUTRAL BAR	PAINT LINE	PROPOSED UNDERGROUND CONDUIT
LUMINAIRE POLE (SINGLE)	COMBINATION LUMINAIRE/DAVIT MOUNTED ILLUMINATED SIGN WITH AMBER FLASHERS	R.M.C.	VEHICLE DETECTOR LOOP	EXISTING UNDERGROUND CONDUIT	FENCE
"F" DENOTES FRANGIBLE BASE	DAVIT MOUNTED SIGN (NON-ILLUMINATED)	F.M.C.	A,B,A1,A2,ETC. SIGNAL HEAD VEHICLE PHASE	CORRUGATED METAL PIPE (CULVERT)	RETAINING WALL
"B" DENOTES BREAKAWAY BASE	DAVIT MOUNTED ILLUMINATED SIGN POLE	OVERHEAD FLASHING BEACON	P,A,PB,PA1,PB2,ETC. SIGNAL HEAD PEDESTRIAN PHASE	CONCRETE ROADSIDE OR MEDIAN BARRIER	SOUND WALL
DOUBLE LUMINAIRE POLE	COMBINATION LUMINAIRE/DAVIT MOUNTED NON-ILLUMINATED SIGN POLE	POST MOUNTED FLASHER	PEDESTRIAN PUSHBUTTON	2 No.8 RW90 & 1 No.8 RW90 BOND (CITY & DISTRICT OF NORTH VANCOUVER) OR 1 No.12 RW90 BOND (MINISTRY) IN CONDUIT	
POST TOP MOUNTED LUMINAIRE	BREAKAWAY SIGN (NON-ILLUMINATED)	BACKGUY	U/G UTILITY	3 No.8 RW90 & 1 No.8 RW90 BOND (CITY & DISTRICT OF NORTH VANCOUVER) OR 1 No.12 RW90 BOND (MINISTRY) IN CONDUIT	
TRAFFIC SIGNAL POLE WITH DAVIT AND SIDE OF POLE MOUNTED HEADS	ILLUMINATED BREAKAWAY SIGN	POWER POLE	'G' DENOTES GAS		
COMBINATION LUMINAIRE/DAVIT MOUNTED TRAFFIC SIGNAL POLE		TELEPHONE POLE	'S' DENOTES STORM DRAINS/SEWERS		
POST TOP MOUNTED SIGNAL		POWER/TELEPHONE POLE	'W' DENOTES WATER		
			'UE' DENOTES ELECTRIC		
			'UT' DENOTES TELEPHONE		
			'SAN' DENOTES SANITARY SEWER		

WALTER & SCI Construction (Canada) Ltd.		SCI	
SHAFLIK ENGINEERING LTD.			
ELECTRICAL CONSULTANTS			
202-8525 BAXTER PLACE, BURNABY, BC V5A 4V7 TEL: 604-421-4125 FAX: 604-421-8344			
ELECTRICAL DESIGN APPROVED		DATE DESIGNED	
SCALE AS NOTED		DATE 96-12-20	
VOLTAGE 120/240		CHECKED	
HWY. DISTRICT HOWE SOUND		DATE 96-12-20	
REV	DATE	DESCRIPTION	CONST
A	97-07-29	RECORD DRAWING	
REVISIONS			

REFER TO SHEET 1 FOR NOTES

Province of British Columbia MINISTRY OF TRANSPORTATION AND HIGHWAYS WESTVIEW INTERCHANGE DESIGN BUILD	
SIGNALS, LIGHTING AND DIRECTIONAL SIGNING INSTALLATION HOWE SOUND DISTRICT - HIGHWAY No.1 UPPER LEVELS HIGHWAY / WESTVIEW DRIVE INTERCHANGE NORTH VANCOUVER	
SIGN ELEVATIONS	
Ministry of Transportation and Highways South Coast Regional Office 7818 - 6th Street Burnaby, BC V3N 4N8	PREPARED UNDER THE DIRECTION OF D. J. WONG CONSULTANT DATE 96-02-14
ACCEPTED FOR CONSTRUCTION ORIGINAL SIGNED BY A. JACK QC/QA MANAGER DATE 96-02-18	
SHEET No. 19 OF 22	PROJECT No. 06838
DRAWING No. TE-95094-19	

CANCEL PRINTS BEARING PREVIOUS LETTER