

MONITORING WELL ID: MW05-8

Location: 12628, 82nd Ave, Surrey

Drilling Contractor: Uniwide Drilling

Drilling Equipment/Method: Vacuum/Solid Stem

Keystone Environmental Ltd.


Project Name/No.: 7261-04

Client: McIntosh Estates

Engineer/Geologist: Cole Bertsch

Date: June 9, 2005

Page: 1 of 1

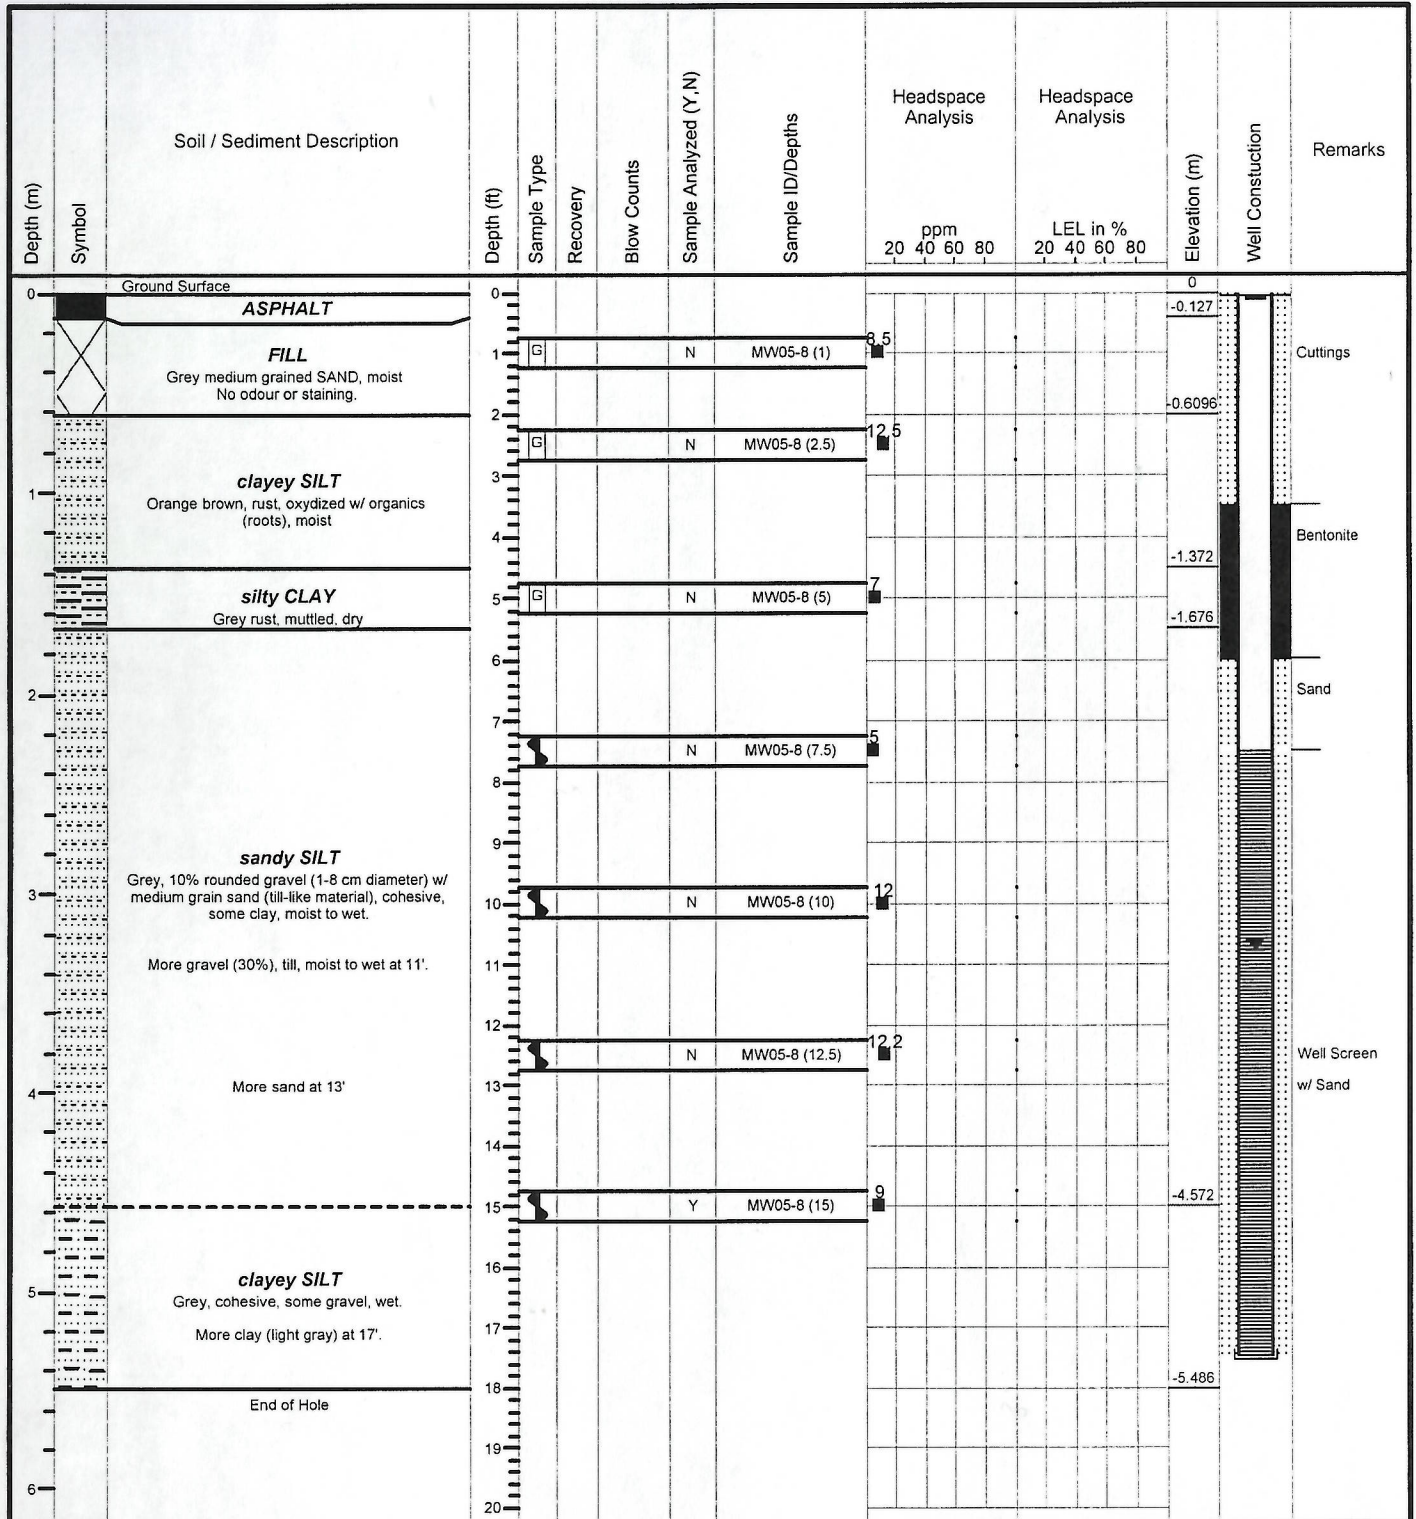

Location of Well: North of MW05-9, along east P/L
 Date of Water Level: 8/15/05
 Water Level (Top of Casing): 3.841 m
 Co-ordinates (UTM): N/A

Well-Borehole Diameter: 15 cm
 Well Casing Diameter: 5 cm
 Well Casing Material: PVC
 Well Screen Slot Size: 10 slot

Depth of Well (TOC): 5.334 m
 Well Elevation (TOC): 99.728 m
 Well Elevation (Ground): 99.852 m