

CLIENT: Ocean Cedar Products

PROJECT: Stage 2 PSI - 2485 Island Highway

JOB#: 39548834


BOREHOLE LOG

BOREHOLE No. MW07-09

SAMPLE LOCATION: Crane log lift area

ELEVATION: Top of Casing: n/a
Ground: n/a

DEPTH	USCS	CLASS CODE	DESCRIPTION	DEPTH	SAMPLE I.D.	SAMPLE TYPE	SAMPLE SYMBOL	Vapour Conc. PPM	WELL INSTALLATION DETAILS
								0 100 300 500	
0.0			Ground Surface	0.0					
0.0			SAND & GRAVEL, trace silt, loose, brown, moist						
1.0					MW07-09 0.3	Grab	25		
2.0			black	0.7					
3.0					MW07-09 0.9	Grab	65		
4.0		GP							
5.0			brown	1.5					
6.0					MW07-09 1.6	Grab	25		
7.0									
8.0									
9.0			SAND & GRAVEL some SILT, trace organics, grey, loose, wet	2.6	MW07-09 2.6	Grab	65		
10.0									
11.0									
12.0		GM							
13.0									
14.0					MW07-09 4.2	Grab	30		
15.0			End of Log	4.5					
16.0									

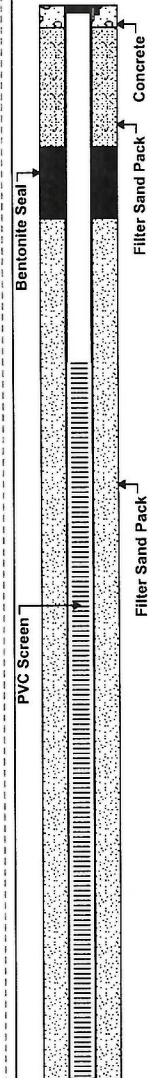

DRILLING CONTRACTOR: Drill Well Enterprises Ltd.

DRILLING METHOD: Solid Stem/Hollow Stem

DATE: June 6, 2007

LOGGED BY: Dawn Cochrane

