



SNC-LAVALIN
Morrow Environmental

Client :
Shell Canada Products

Borehole No. : 02-7

Location :
2573 Runnel Drive, Coquitlam, BC


(Page 1 of 1)

Drilling Contractor: Geotech Drilling Services Ltd
Drilling Method : Solid Stem Auger
Borehole Dia. (m) : 0.15
Pipe/Slotted Pipe Dia. (m): 0.05, 0.05

Date Monitored : 2007 10 10
Ground Surf Elev. (m) : 100.065
Top of Casing Elev. (m) : 99.996, 99.954

Project Number : V2003
Borehole Logged By : RJW
Date Drilled : 2002 02 06
Log Typed By : RJW

Depth in Metres	Drilling Legend ▨ Sample Interval	Water/LPH Levels ▽ Water Level 1 ▽ Water Level 2 ◆ LPH ◇ LPH	Stratigraphy Plot	Sample Interval/ Core Run	Sample Number	Blow Count	% Recovery	○ Reading within indicated scale ● Reading outside indicated scale	Soil Vapour (ppm)	— Solid PVC — Slotted PVC
	Soil Description							1 2 3 4 10 10 10 10		Well Name: 02-7S Well 2 Name: 02-7D

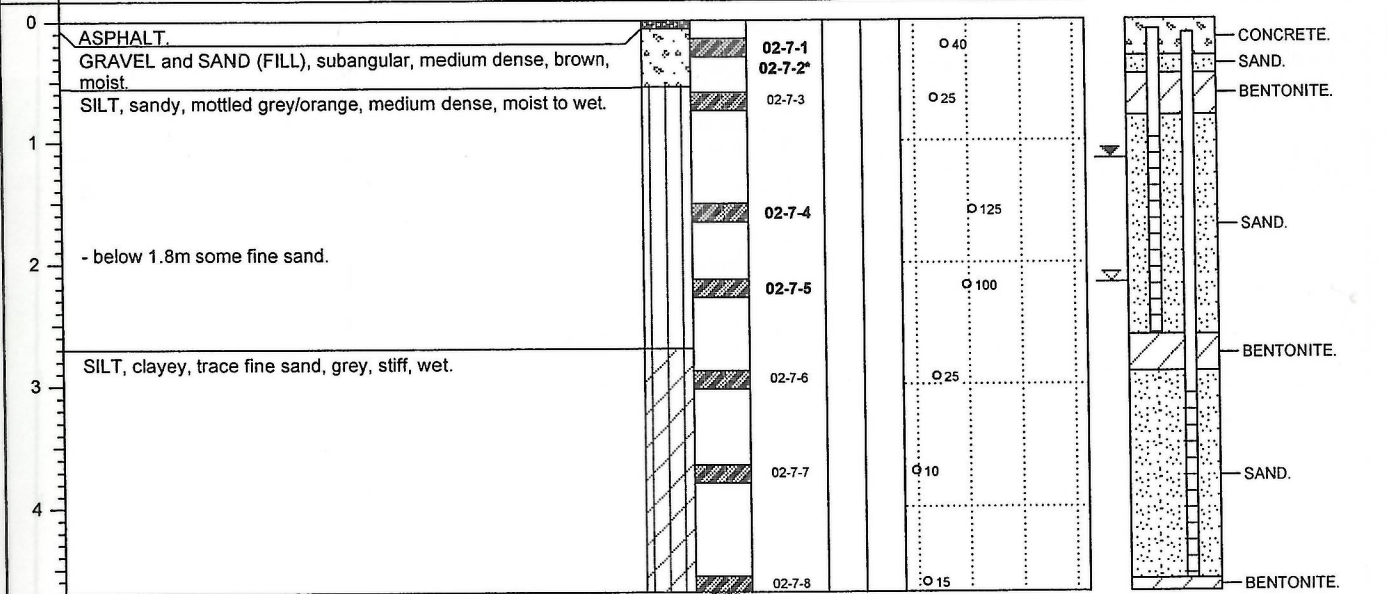

Notes:
Bolded sample denotes sample analyzed.
* denotes 02-7-2 is a blind field duplicate of 02-7-1.