


SEACOR JOB NO: C0002-084

DEPTH (m)	SAMPLE TYPE	SOIL TYPE	SOIL DESCRIPTION	TEST DATA				WELL COMPLETION	FIELD NOTES	DEPTH (m)
				HEADSPACE VAPOUR LEVEL (ppmv)						
				10	100	1000	10000			
		ASPHALT								
		SAND (FILL)	-fine to coarse-grained, some fine-grained gravel, some cobbles, trace silt, loose, brown, moist -no odour, no staining							
1.0	x x	SILT	-trace fine-grained sand, trace organics (fine rootlets), fissured, stiff, grey, moist -odour, no staining							1.0
2.0	x x	SAND	-fine to medium-grained, trace silt, trace organics (rootlets), compact, grey, moist -odour, no staining -wet below 2.3 m							2.0
			-medium-grained, medium-dense, saturated, no odour below 2.6 m							
3.0			-staining (grey) at 2.9 m							3.0
4.0			-organic silt layer (25 mm), some rootlets, brown, mottled, odour, no staining at 4.0 m							4.0
			-coarse-grained, some rounded pebbles, dense, no odour or staining below 4.3 m							
			End of Borehole at 4.6 m Screened Interval from 0.6 m to 4.6 m Elevation at Top of Piezometer (T.O.P.) = 101.76 m Depth to Groundwater from T.O.P. = 1.86 m Depth to Free-phase Product from T.O.P. = 1.68 m							

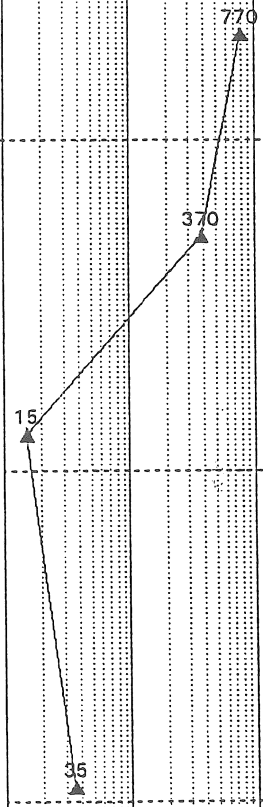

DRILLING METHOD: ROTARY AUGER RIG: logged by TB

DATE DRILLED: 6/11/96

Notes:

- NO RECOVERY AUGER SAMPLE
- SPLIT SPOON SAMPLE
- GRAB SAMPLE