


PROJECT: 3RD & CHESTERFIELD ESSO SERVICE STATION		TPC: 29.647 m	BOREHOLE NO: BH9
LOCATION: VANCOUVER, BRITISH COLUMBIA		GRADE: 29.782 m	JOB NO: 10-4061
CLIENT: IMPERIAL OIL LIMITED	Location No. P11190/88002288	COMPLETION DATE: 08/09/18	DRILL: AUGER
SAMPLE TYPE	<input checked="" type="checkbox"/> OTHER	<input checked="" type="checkbox"/> SHELBY	<input checked="" type="checkbox"/> SPLIT SPOON
	<input type="checkbox"/> CORE	<input type="checkbox"/> DISTURBED	<input type="checkbox"/> NO RECOVERY
BACKFILL TYPE	<input checked="" type="checkbox"/> BENTONITE	<input type="checkbox"/> PEA GRAVEL	<input type="checkbox"/> SLOUGH
	<input type="checkbox"/> GROUT	<input checked="" type="checkbox"/> DRILL CUTTINGS	<input type="checkbox"/> SAND

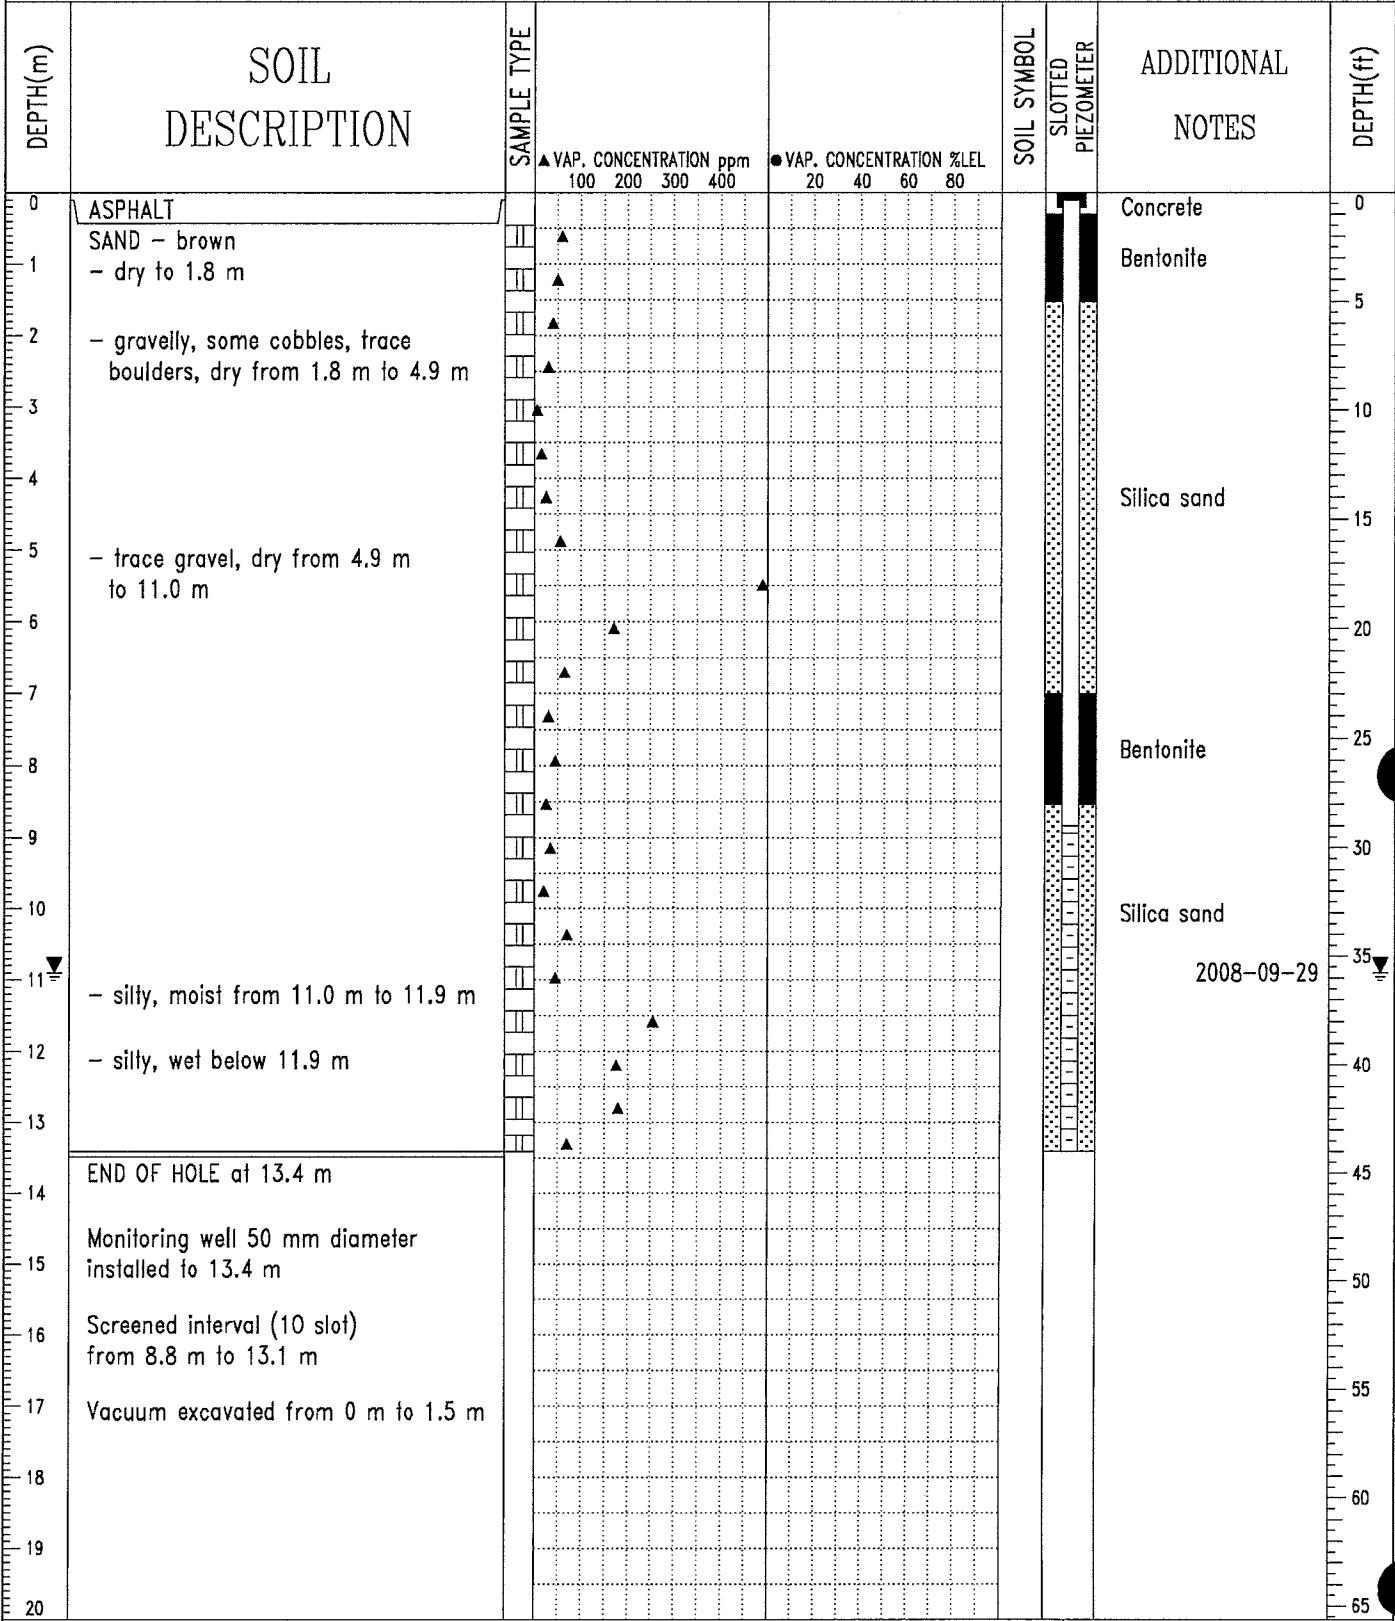

O'Connor Associates
Langley, B.C.

LOGGED BY: CPN
REVIEWED BY: CPN
DRAWING NO: A-2