



Client :
Shell Canada Products

Borehole No. : 02-16

Location :
227th and Dewdney Trunk Road, Maple Ridge, BC


(Page 1 of 1)

Drilling Contractor: McRae's Environmental
Drilling Method : Vacuum Truck
Borehole Dia. (m) : 0.20
Pipe/Slotted Pipe Dia. (m): 0.05, 0.05

Date Water Lev. Meas. : 2002 08 20
Ground Surf Elev. (m) : 43.62
Top of Casing Elev. (m) : 43.534, 43.508

Project Number : V4215
Borehole Logged By : DGP
Date Drilled : 2002 08 14
Log Typed By : MVW

Depth in Metres	Soil Description	Stratigraphy Plot	Sample Interval/ Core Run	Sample Number	Blow Count	% Recovery	Soil Vapour (ppm)				Well Name 1 : 02-16S Well Name 2 : 02-16D	
							1	2	3	4		
0	ASPHALT.											
	SAND (FILL), trace silt, trace fine gravel, grey, loose, damp.			16-01				0.75				
	SAND (FILL), medium grained, some coarse gravel, subangular, trace cobbles, trace silt, light brown, medium dense, damp.			16-02				0.240				
1	SILT, trace sand, fine grained, dark brown, soft, high plasticity, moist.											
	SILT, some sand, fine grained, some clay, grey/brown, brown mottling, firm, low plasticity, damp, hydrocarbon-like odour.			16-03	100			800				
	SILT, some clay, trace sand, fine grained, trace fine gravel, subrounded, grey, brown mottling, low plasticity, damp.			16-04				0.95				
2	Below 2.3 m - more clay, less silt.											
				16-05	100			0.20				
3	CLAY, trace silt, grey, soft, high plasticity, damp.											
				16-06								
4												
				16-07	100							
5												
				16-08	100							
6	At 6.1 m - Trace sand, moist.											
				16-09								
7												
8	End of borehole at 7.6 m.											

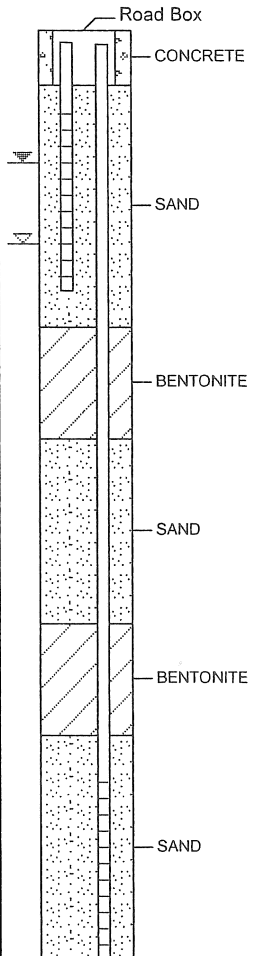

Print Date: 2004 06 24, Date Updated: 2003 10 14

Notes:
Bolded sample denotes sample analyzed.