

**Log of Monitoring Well: MW13-1**



**Project Name/No:** Adelaide Avenue/ 1436-001.01

**Drilling Company:** Drillwell Enterprises Ltd.

**Client:** BC HAZMAT Management Ltd.

**Drilling Method:** Solid-Stem Auger


**Date Drilled:** January 3, 2013

**Logged by:** Ian Reynolds

**Site Location:** 2853 Adelaide Avenue, Saanich, BC

**Sheet:** 1 of 1

SUBSURFACE PROFILE				SAMPLE				Backfill details	
Depth	Symbol	Description	Depth/Elev (m)	Sample ID	Analysed Y,N	Sample Type	Vapour		LEL
							ppm		%
0		Ground Surface	24.31						
0		Asphalt	0.00						
1		Fill - Gravel with Silty-Sand Gravel (fine to coarse, subangular to subrounded) with silty sand, grey-brown, medium dense, dry to moist, no odour, no staining.		MW13-1-1	N	G	0	0	
2									
3		(0.91 m) Becoming moist to wet.	23.24						
4		Clay Clay, brown with orange and grey mottling, very stiff, dry, no odour, no staining.	1.07	MW13-1-2	N	G	0	0	
5									
6		(1.83 m) Limited to no mottling below.		MW13-1-3	N	G	0	0	
7									
8									
9									
10									
11									
12									
13									
14									
15									
16									
17									
18									
19									
20			18.21						
20		End of Log	6.10						

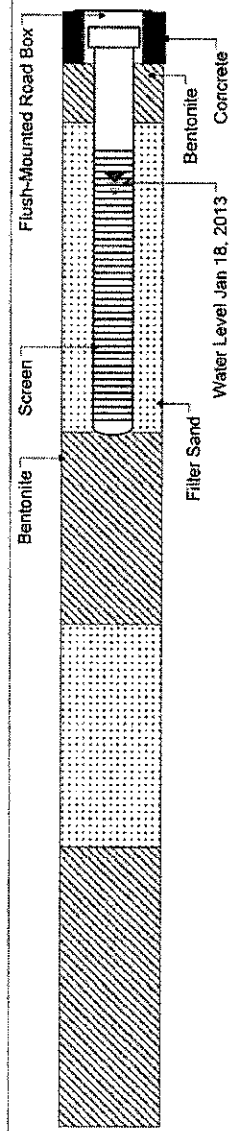

<b>Well location:</b> NW of property within roadway	<b>Well casing diameter:</b> 5.08 cm	<b>Depth of well (TOC):</b> 2.233 m
<b>Depth to water level (TOC):</b> 0.934 m	<b>Well casing material:</b> Sch. 40 PVC	<b>Well Elevation (TOC):</b> 24.210 m
<b>Date of water level:</b> January 18, 2013	<b>Well screen slot size:</b> 10-slot	<b>Ground Elevation:</b> 24.311 m
<b>Borehole diameter:</b> 10.16 cm	<b>Well screen interval (bgs):</b> 0.762 m - 2.286 m	