



Client :  
Petro-Canada

Borehole No. : BH00-27


Location :  
Former Taylor Refinery, Taylor, BC

(Page 1 of 2)

Drilling Contractor: Cariboo  
Drilling Method : Air Rotary  
Borehole Dia. (m) : 0.15  
Pipe/Slotted Pipe Dia. (m): 0.05, 0.05

Date Monitored : 2000 08 21  
Ground Surf Elev. (m) : 488.07  
Top of Casing Elev. (m) : 489.17

Project Number : V7202  
Borehole Logged By : KS  
Date Drilled : 2000 07 30  
Log Typed By : IB

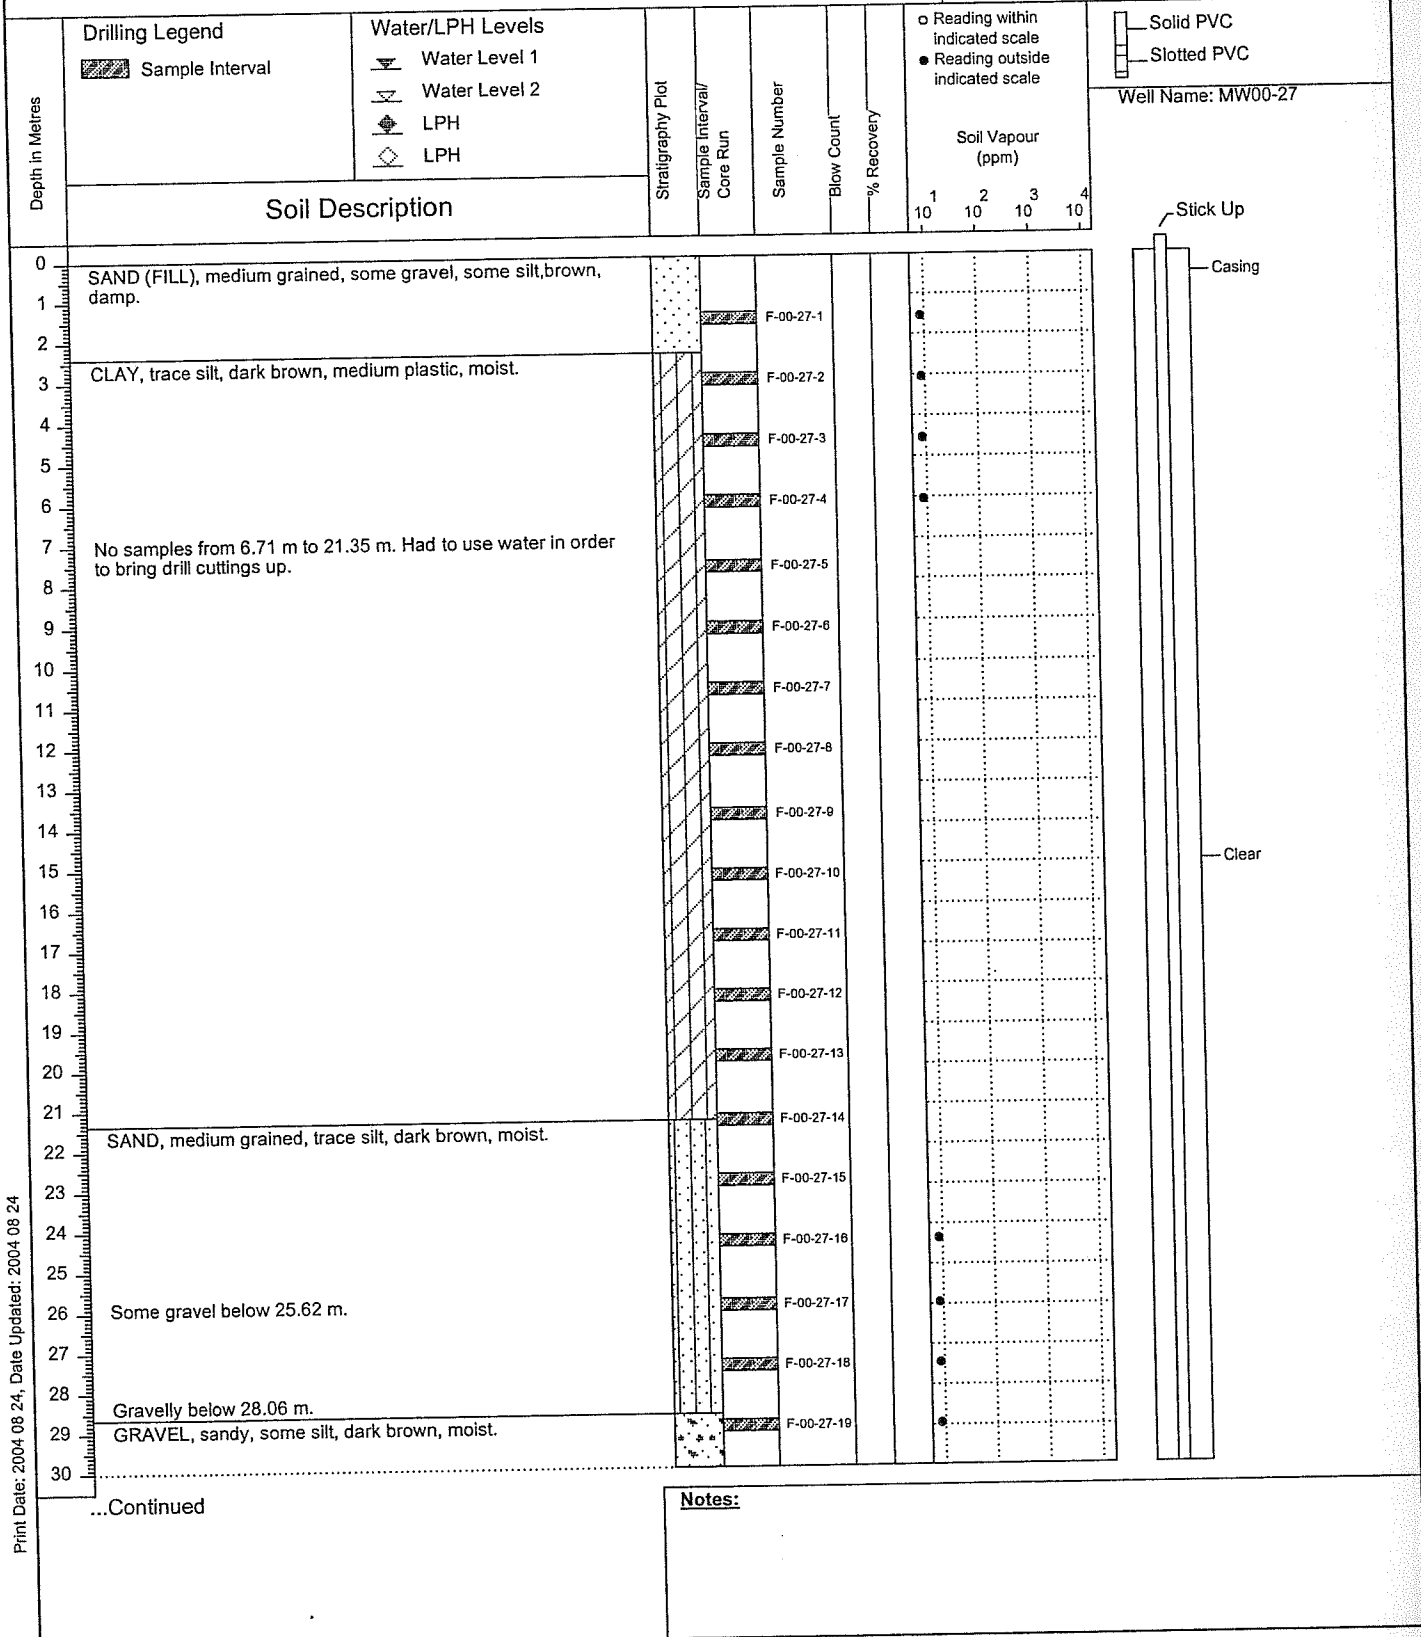

Print Date: 2004 08 24, Date Updated: 2004 08 24

...Continued

Notes:



Client :  
Petro-Canada

Borehole No. : BH00-27


Location :  
Former Taylor Refinery, Taylor, BC

(Page 2 of 2)

Drilling Contractor: Cariboo  
Drilling Method : Air Rotary  
Borehole Dia. (m) : 0.15  
Pipe/Slotted Pipe Dia. (m): 0.05, 0.05

Date Monitored : 2000 08 21  
Ground Surf Elev. (m) : 488.07  
Top of Casing Elev. (m) : 489.17

Project Number : V7202  
Borehole Logged By : KS  
Date Drilled : 2000 07 30  
Log Typed By : IB

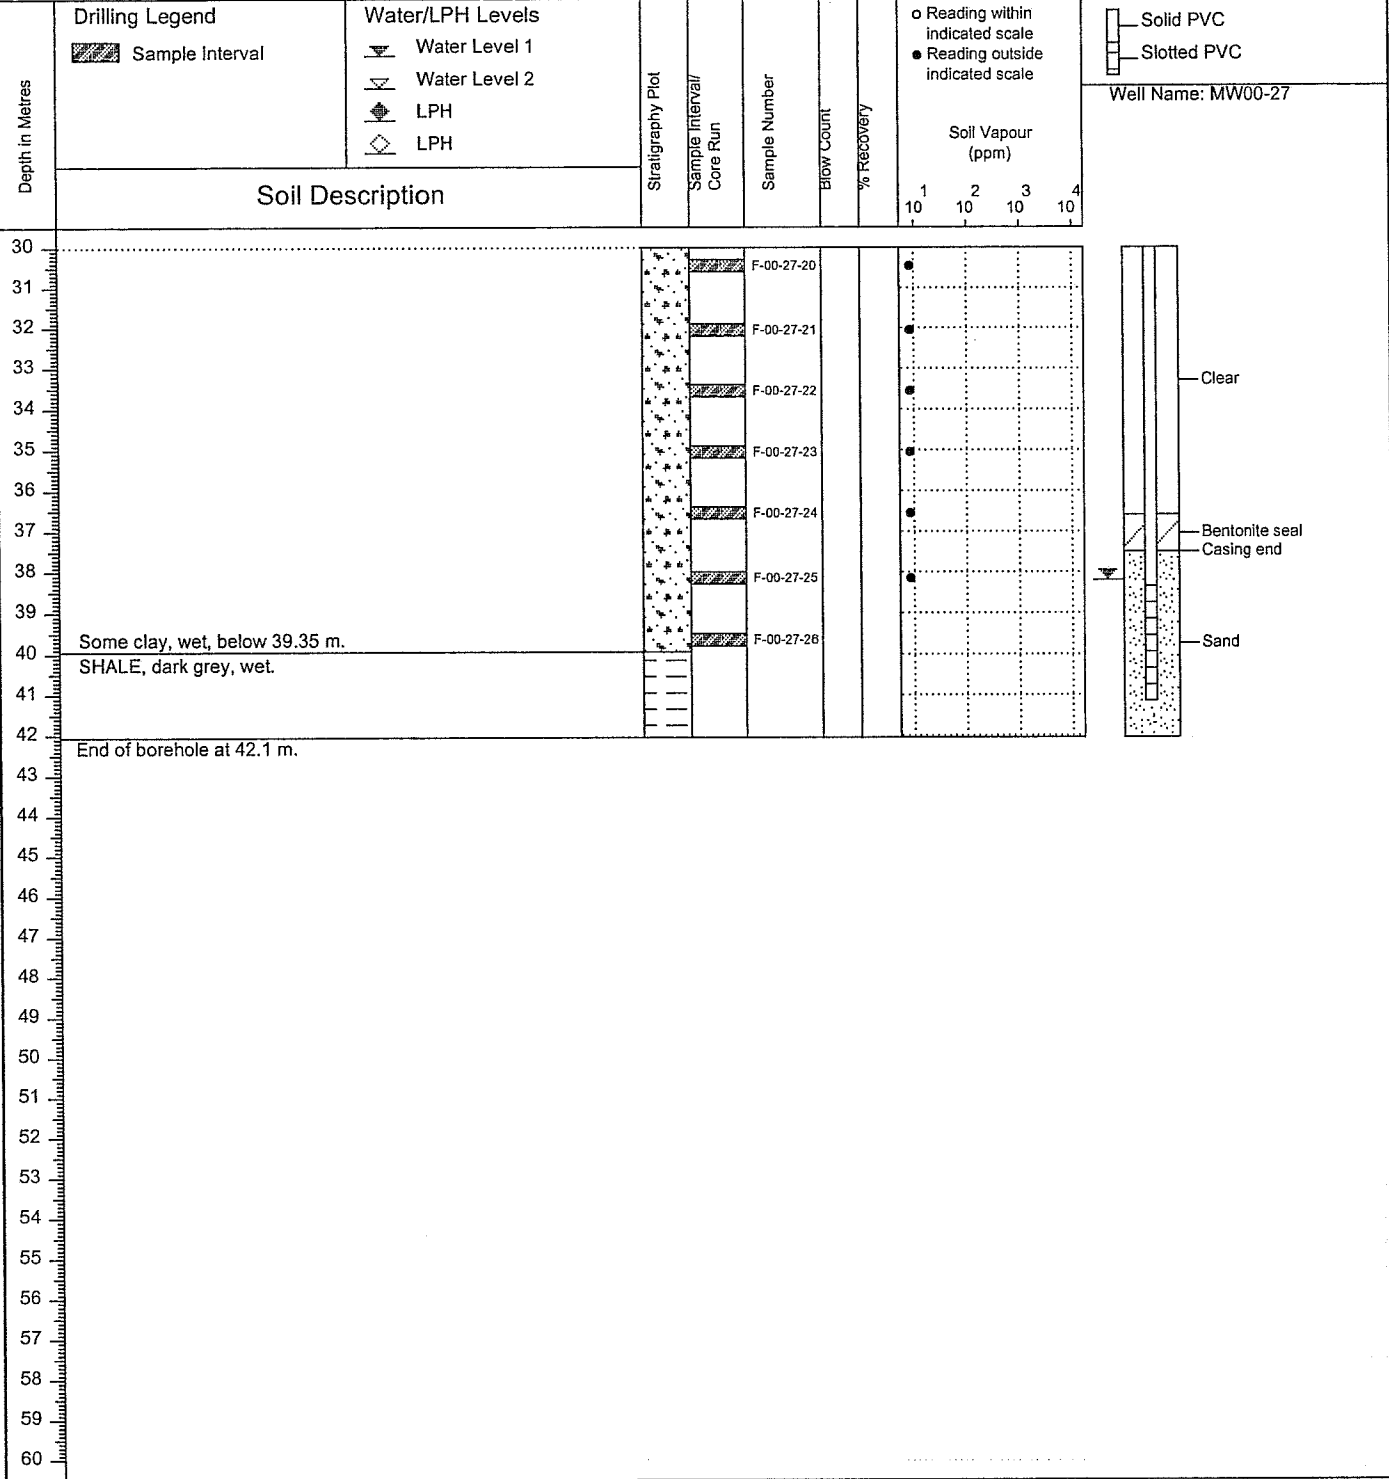

Print Date: 2004 08 24, Date Updated: 2004 08 24

Notes: