



SNC-LAVALIN
Environment

Client:
Petro-Canada

Borehole No. : 10-6

Location:
City of Terrace Lands, BC


(Page 1 of 1)

Drilling Contractor: Spruce City/Geotech Drilling
Drilling Method : Hydrovac/Odex
Borehole Dia. (m) : 0.20
Pipe/Slotted Pipe Dia. (m): 0.05, 0.05

Date Monitored : 2010 03 16
Ground Surf Elev. (m) : 70.409
Top of Casing Elev. (m) : 70.351

Project Number : 130916
Borehole Logged By : SM
Date Drilled : 2010 02 26
Log Typed By : NN

Depth in Metres	Drilling Legend	Water/NAPL Levels	Stratigraphy Plot	Sample Interval/ Core Run	Sample Number	Blow Count	% Recovery	Soil Vapour (ppm)				Well Name: MW10-6
								1	2	3	4	
0	SAND and GRAVEL (FILL), fine to coarse grained sand, fine to coarse gravel, some silt, brown, medium dense, damp, rootlets.				6-01			0.25				
1					6-02			0.30				
2	SAND and GRAVEL (NATIVE), fine to coarse grained sand, fine to coarse gravel, some cobbles, trace silt, brown, dense, damp. Below 2.4 m - cobbly, dry.											
3												
4												
5					6-03			0.26				
6	Below 6.1 m - moist.											
7	Below 6.9 m - silty, saturated.				6-04	42		0.45				
8	SILT, clayey, grey, medium plasticity, medium stiff, wet.											
8					8-05	100		0.65				
9	End of borehole at 9.0 m.											
10												

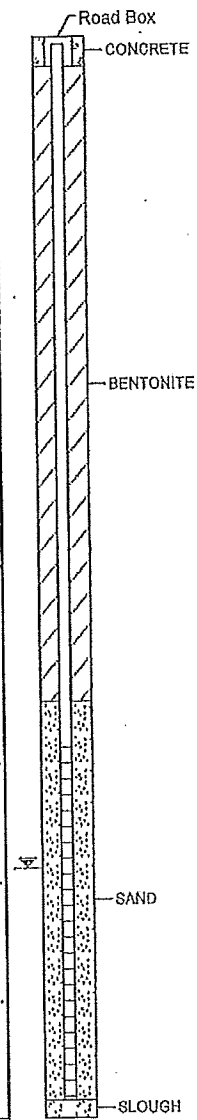

Print Date: 2010 05 14, Date Approved: 2010 05 11

Notes:
 Bolded sample denotes sample analyzed.
 Borehole day-lighted to a depth of 1.9 m on 02 18 2010.