



SNC-LAVALIN
Morrow Environmental

Client :
Petro-Canada

Borehole No. : BH01-4


Location :
70 & 84 Electronic Avenue, Port Moody, BC


(Page 1 of 1)

Drilling Contractor: Mud Bay Drilling Co. Ltd.
Drilling Method : Solid Stem Auger
Borehole Dia. (m) : 0.15
Pipe/Slotted Pipe Dia. (m): 0.05, 0.05

Date Monitored : 2003 12 11
Ground Surf Elev. (m) : 16.17
Top of Casing Elev. (m) : 16.941

Project Number : 130387
Borehole Logged By : HMM
Date Drilled : 2001 12 13
Log Typed By : MCB

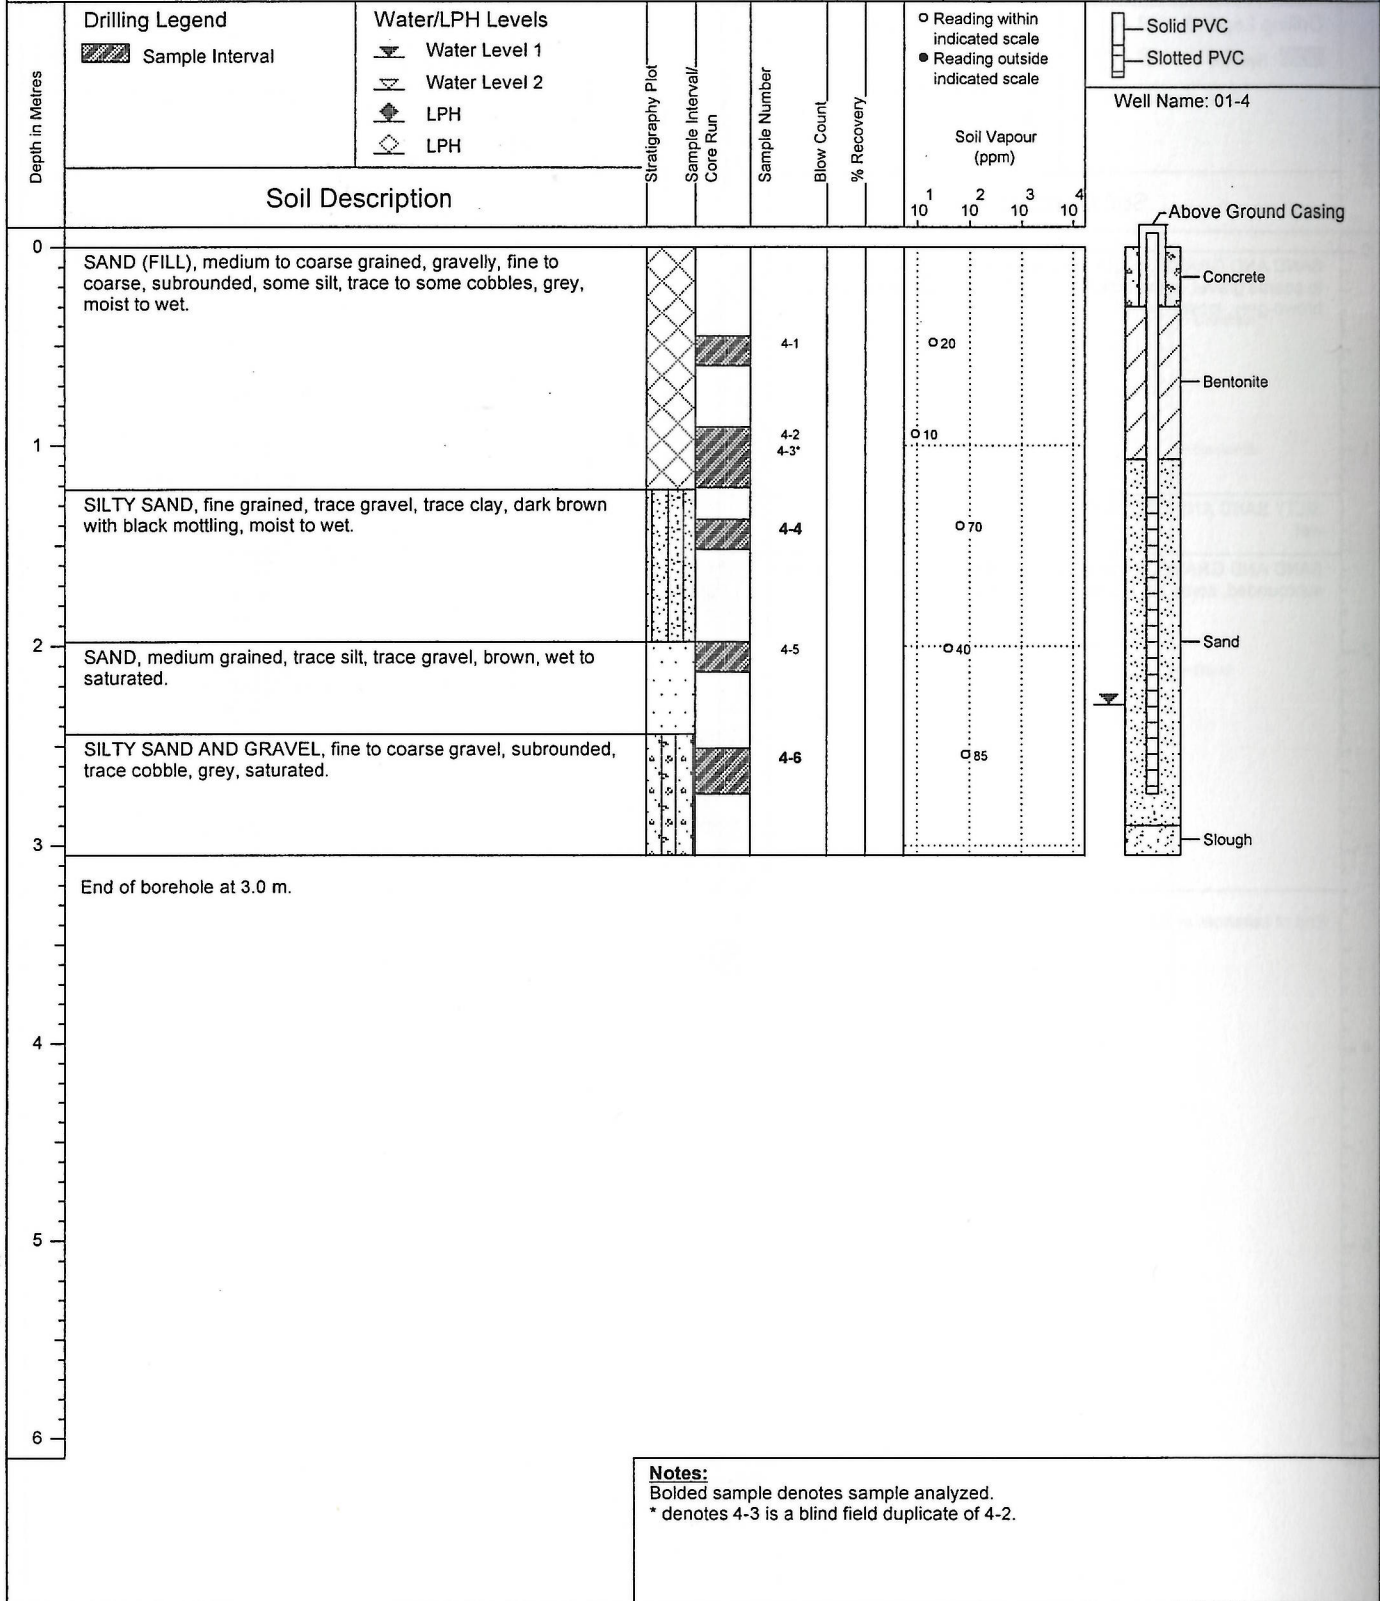

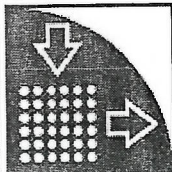

Waterloo Hydrogeologic, Inc.

460 Philip Street - Suite 101

Waterloo, Ontario, Canada


Phone: +1 519 746 1798

Slug Test Analysis Report

Project: P.C. TEL Facility

Number: R13106

Client: P.C.

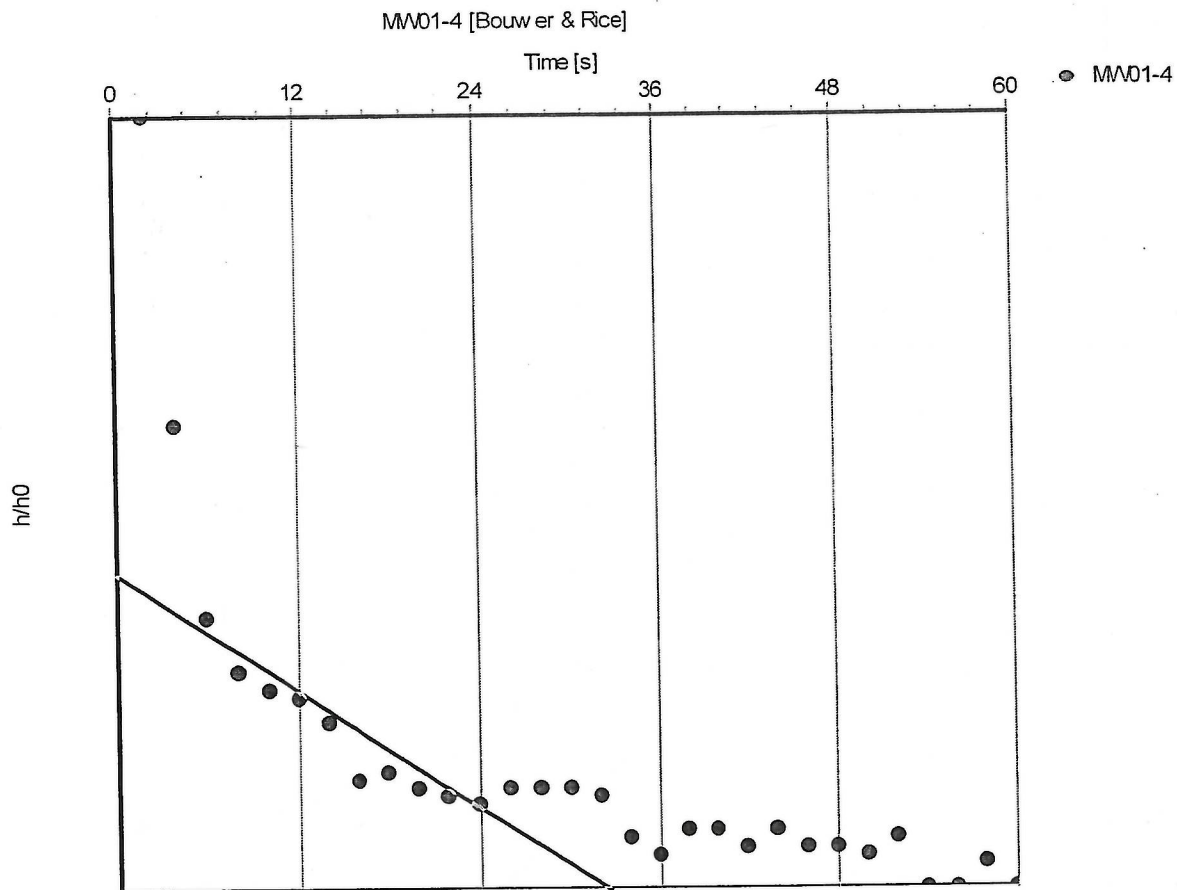

Slug Test: MW01-4

Analysis Method: Bouwer & Rice

Analysis Results:

Conductivity: 2.07E-6 [m/s]

Test parameters:

Test Well: MW01-4
 Casing radius: 0.025 [m]
 Screen length: 1.075 [m]
 Boring radius: 0.075 [m]
 r(eff): 0.043 [m]

Aquifer Thickness: 1.5 [m]
 Gravel Pack Porosity (%): 25

Comments:

Evaluated by:

Evaluation Date: 7/25/2005