



MORROW ENVIRONMENTAL CONSULTANTS INC.

Client :
Shell Canada Products

Location :
Ladysmith Payless, Ladysmith, BC


Borehole No. : SVE00-1

(Page 1 of 1)

Drilling Contractor : Uniwide Drilling Co. Ltd.
Drilling Method : Hollow Stem Auger
Borehole Dia. (m) : 0.20
Pipe/Slotted Pipe Dia. (m): 0.05, 0.05

Ground Surf Elev. (m) : 9.3
Top of Casing Elev. (m) : 9.171

Project Number : V0025
Borehole Logged By : SJW
Date Drilled : 2000 09 19
Log Typed By : EW

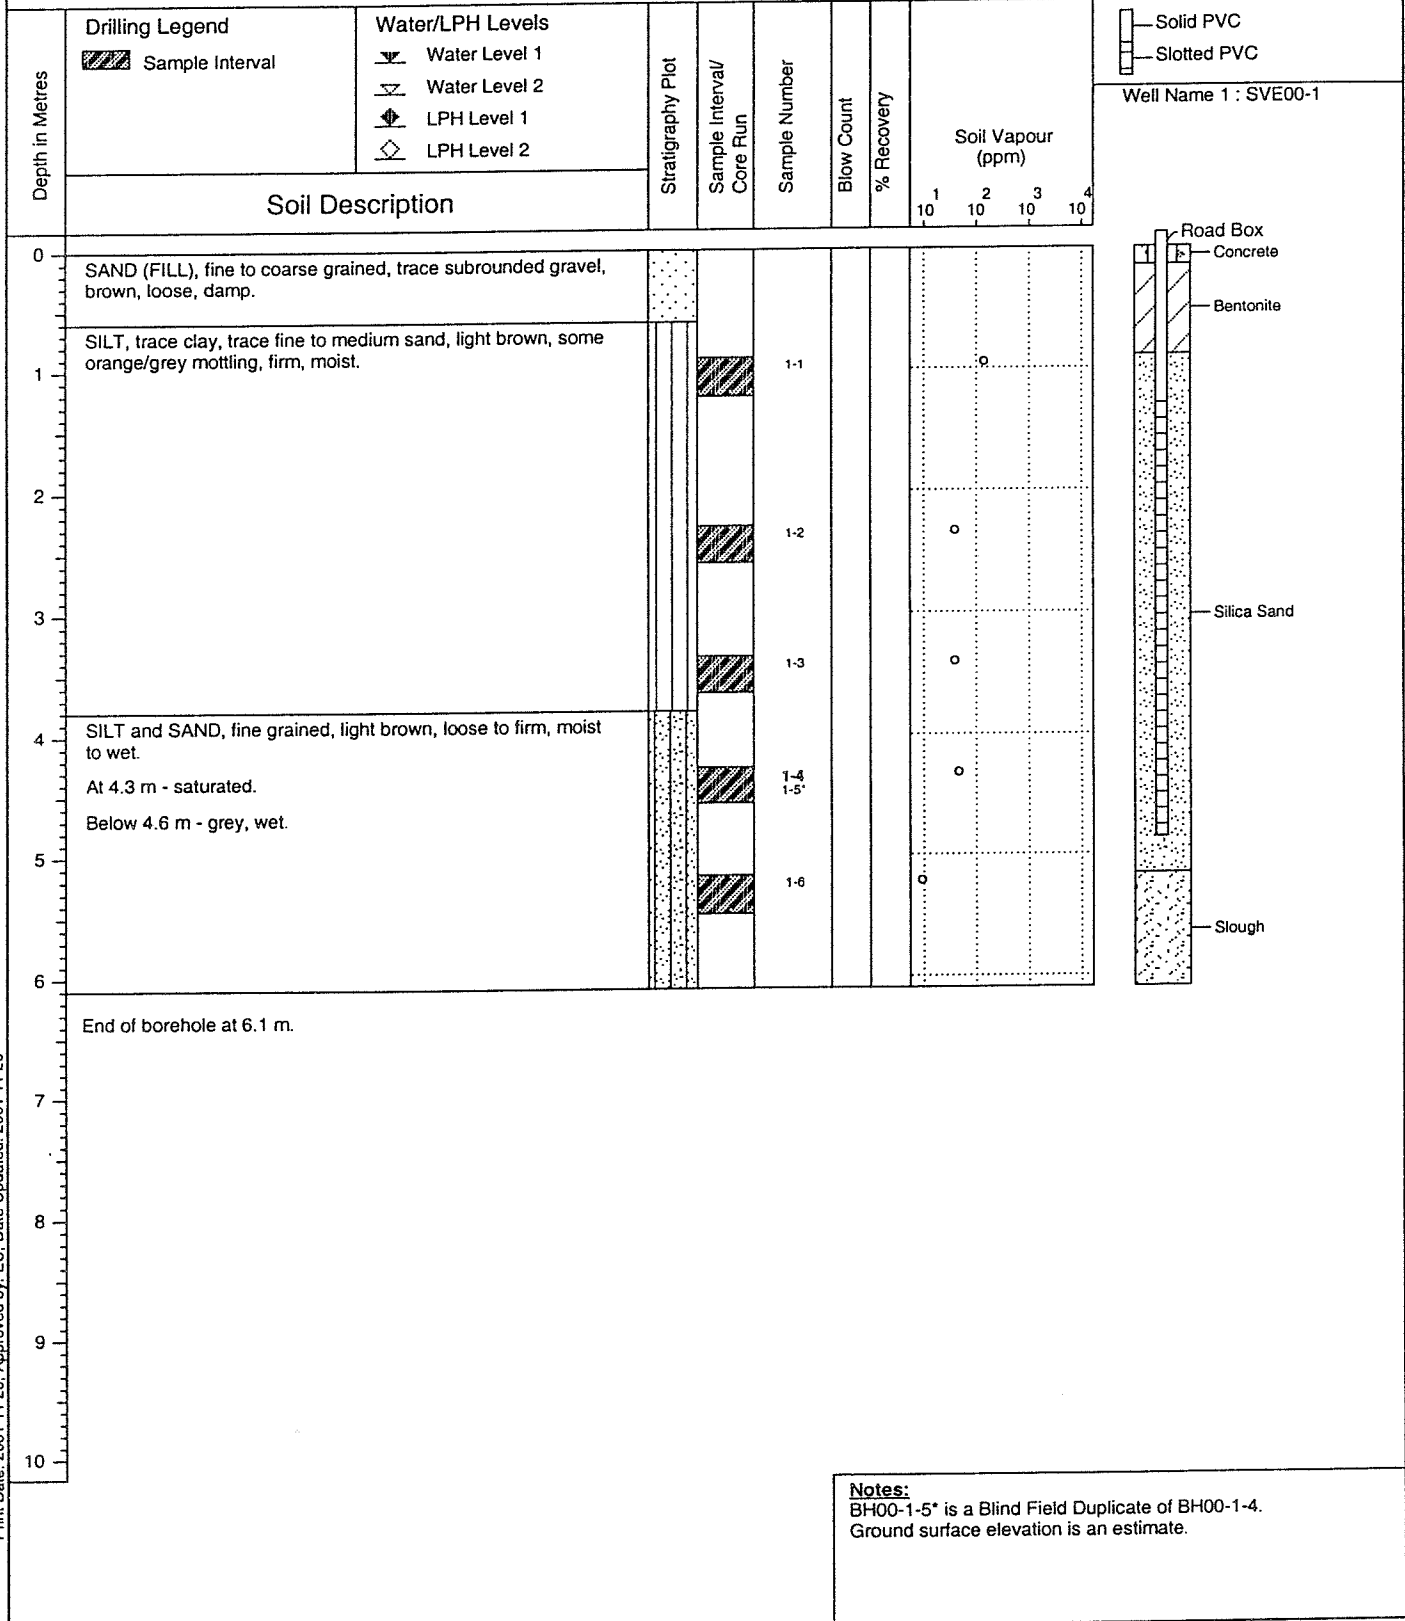

Notes:
BH00-1-5* is a Blind Field Duplicate of BH00-1-4.
Ground surface elevation is an estimate.