



MORROW ENVIRONMENTAL CONSULTANTS INC.

Client :
Progressive Construction Ltd.

Borehole No. : BH00-08

Location :
Former Elgin Landfill, 34th Ave. & 140th St., Surrey


(Page 1 of 1)

Drilling Contractor : Mud Bay Drilling Co. Ltd.
Drilling Method : Hollow Stem Auger
Borehole Dia. (m) : 0.20
Pipe/Slotted Pipe Dia. (m): 0.05, 0.05

Date Water Lev. Meas. : 2001 04 10
Ground Surf Elev. (m) : 26.75
Top of Casing Elev. (m) : 27.41

Project Number : V0883
Borehole Logged By : RDS
Date Drilled : 2000 10 20
Log Typed By : EW

Depth in Metres	Sample Type	Water/LPH Levels	Stratigraphy Plot	Sample Type	Sample Number	Blow Count	% Recovery	Soil Vapour (ppm)	Well Name 1 : MW00-08
	Split Spoon	Water Level 1 Water Level 2 LPH Level 1 LPH Level 2							
Soil Description									
0	ORGANIC SILT (TOPSOIL), trace coarse grained gravel, trace roots, brown, compact, dry.					7			
1	SAND, fine grained, silty, grey with orange-brown mottling, dense, damp.				08-01	88			
2	Between 2.0 m and 2.1 m - orange-brown, moist. Below 2.3 m - some silt, to grey, compact to dense, wet.				08-02	88			
					08-03	63			
3	CLAY, some silt, dark grey, very soft, saturated.					1			
					08-04	50			
4	SAND, fine to medium grained, trace silt, grey, compact, saturated.				08-05	50			
						4			
5	CLAY, silty, trace sand, grey, firm, moist.				08-06				
6	End of borehole at 5.9 m.								
7									
8									
9									
10									

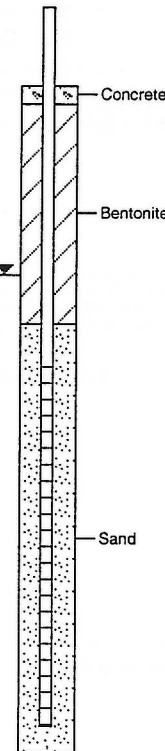

Print Date: 2001 07 20. Approved by: Kneale, David

Notes:
A Stick-up road box was installed to protect the monitoring well.