Project No: 1800-0503

Log of Borehole: BH1 / MW1

Project: DETAILED SITE INVESTIGATION

Client: GUY & BRENDA HOLDINGS

Enclosure: 1

Location: 27158 FRASER HIGHWAY

Engineer: RD

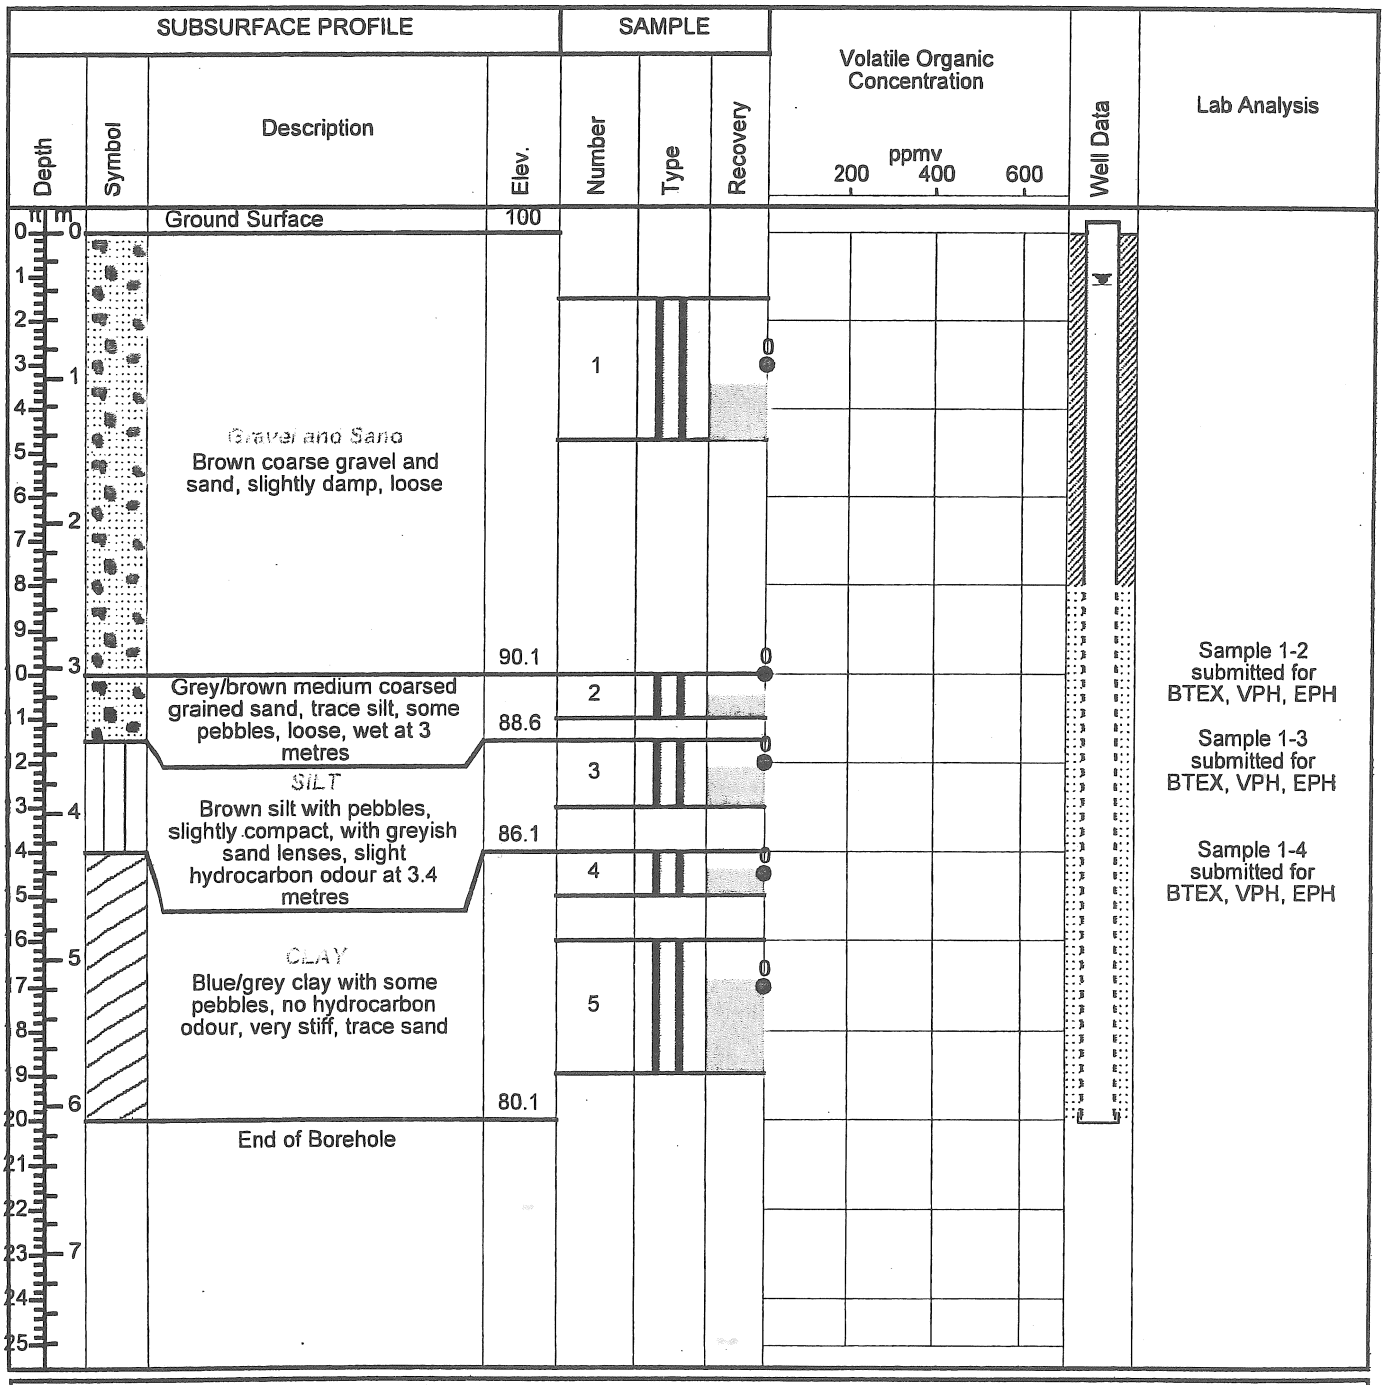

Drill Method: Hollow Stem

Elevation: 99.89m

Drill Date: 24 MAY 2000

Checked by:

Hole Size: 6.5"

Sheet: 1 of 1