



SNC-LAVALIN
Morrow Environmental

Client :
Shell Canada Products

Borehole No. : BH06-9


Location :
4079 Quadra St., Saanich, BC

(Page 1 of 1)

Drilling Contractor: Drillwell Enterprises Ltd.
Drilling Method : Solid Stem Auger
Borehole Dia. (m) : 0.15
Pipe/Slotted Pipe Dia. (m): 0.05, 0.05

Date Monitored : 2006 07 31
Ground Surf Elev. (m) : 40.506
Top of Casing Elev. (m) : 40.657

Project Number : 131204
Borehole Logged By : AEK/MCA
Date Drilled : 2006 07 28
Log Typed By : MAL

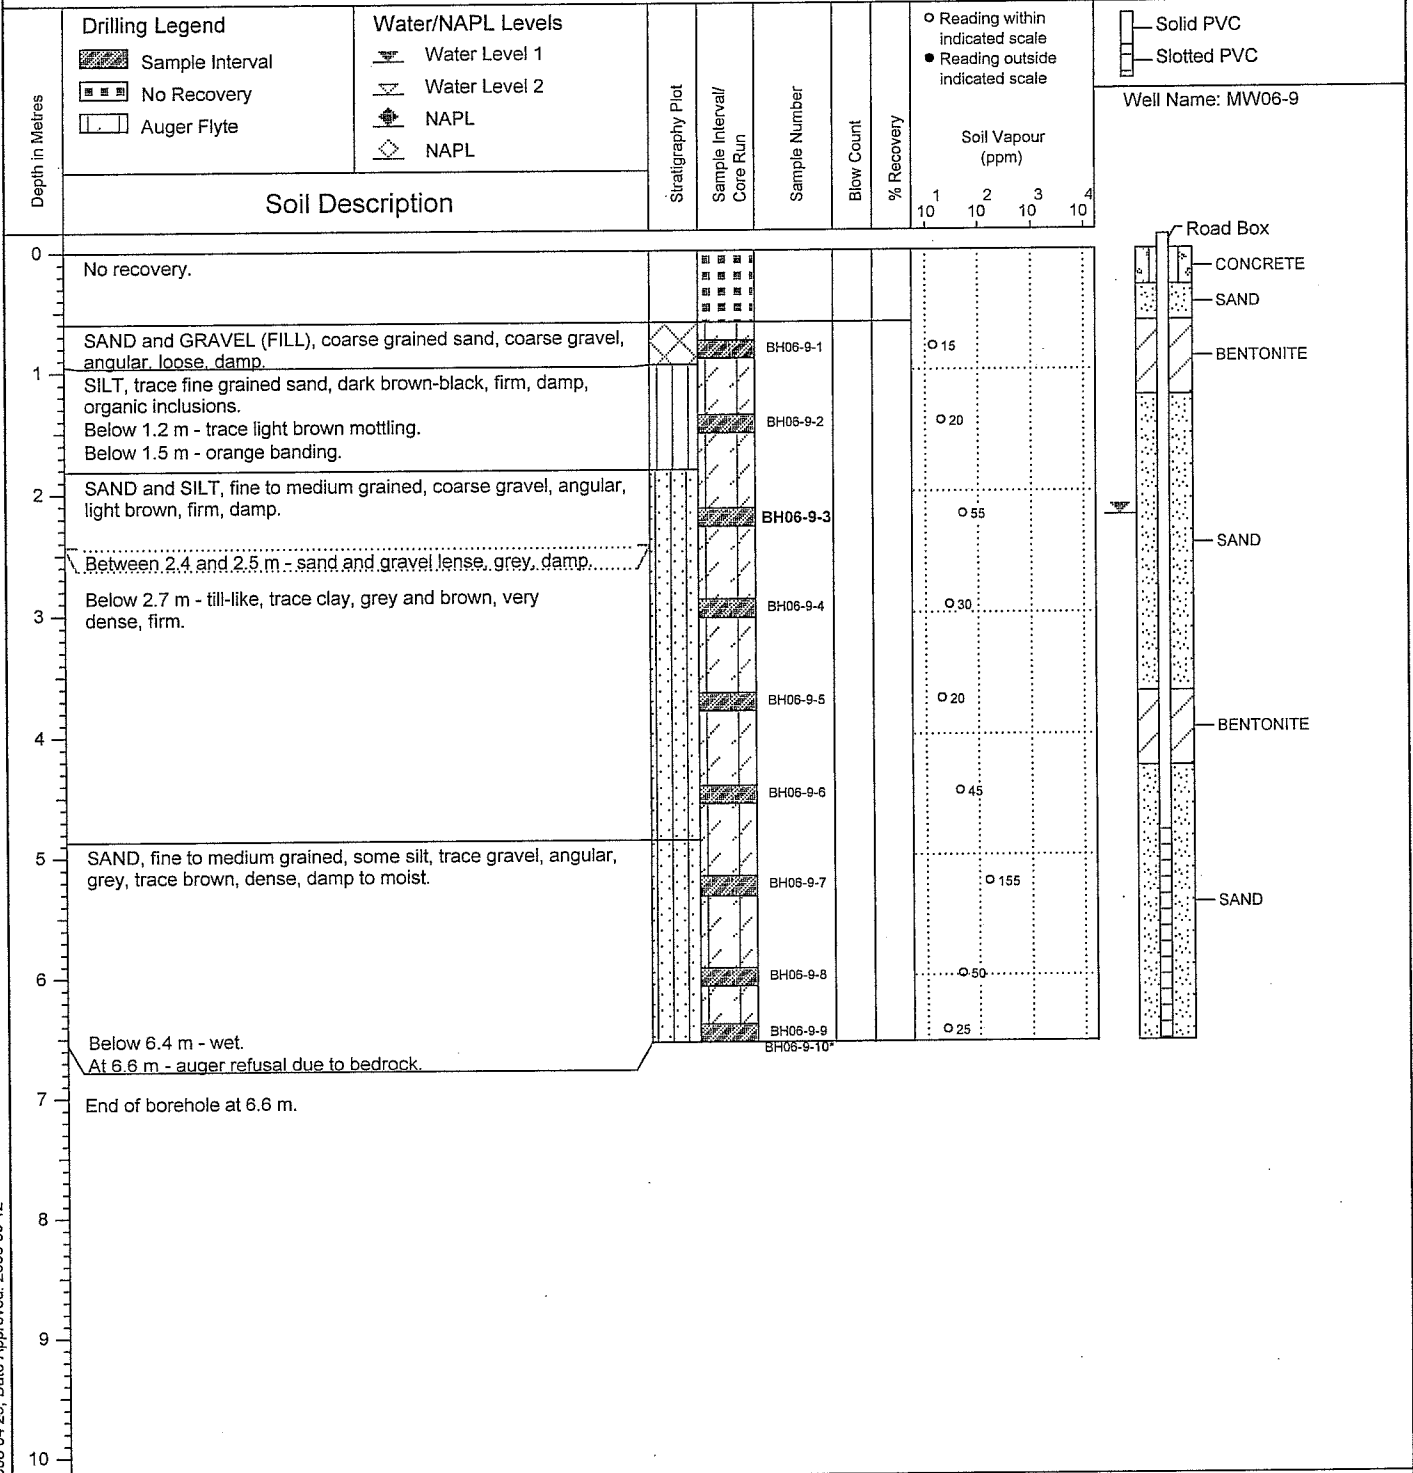

Notes:
Bolded sample denotes sample analyzed.
*Sample BH06-9-10 is a blind field duplicate of BH06-9-9.

Print Date: 2006 04 29, Date Approved: 2006 09 12