


What is this — ?

Reserve is part of  
OIC 708. — There = 3 parts!  
Heber River was only one  
entered in base

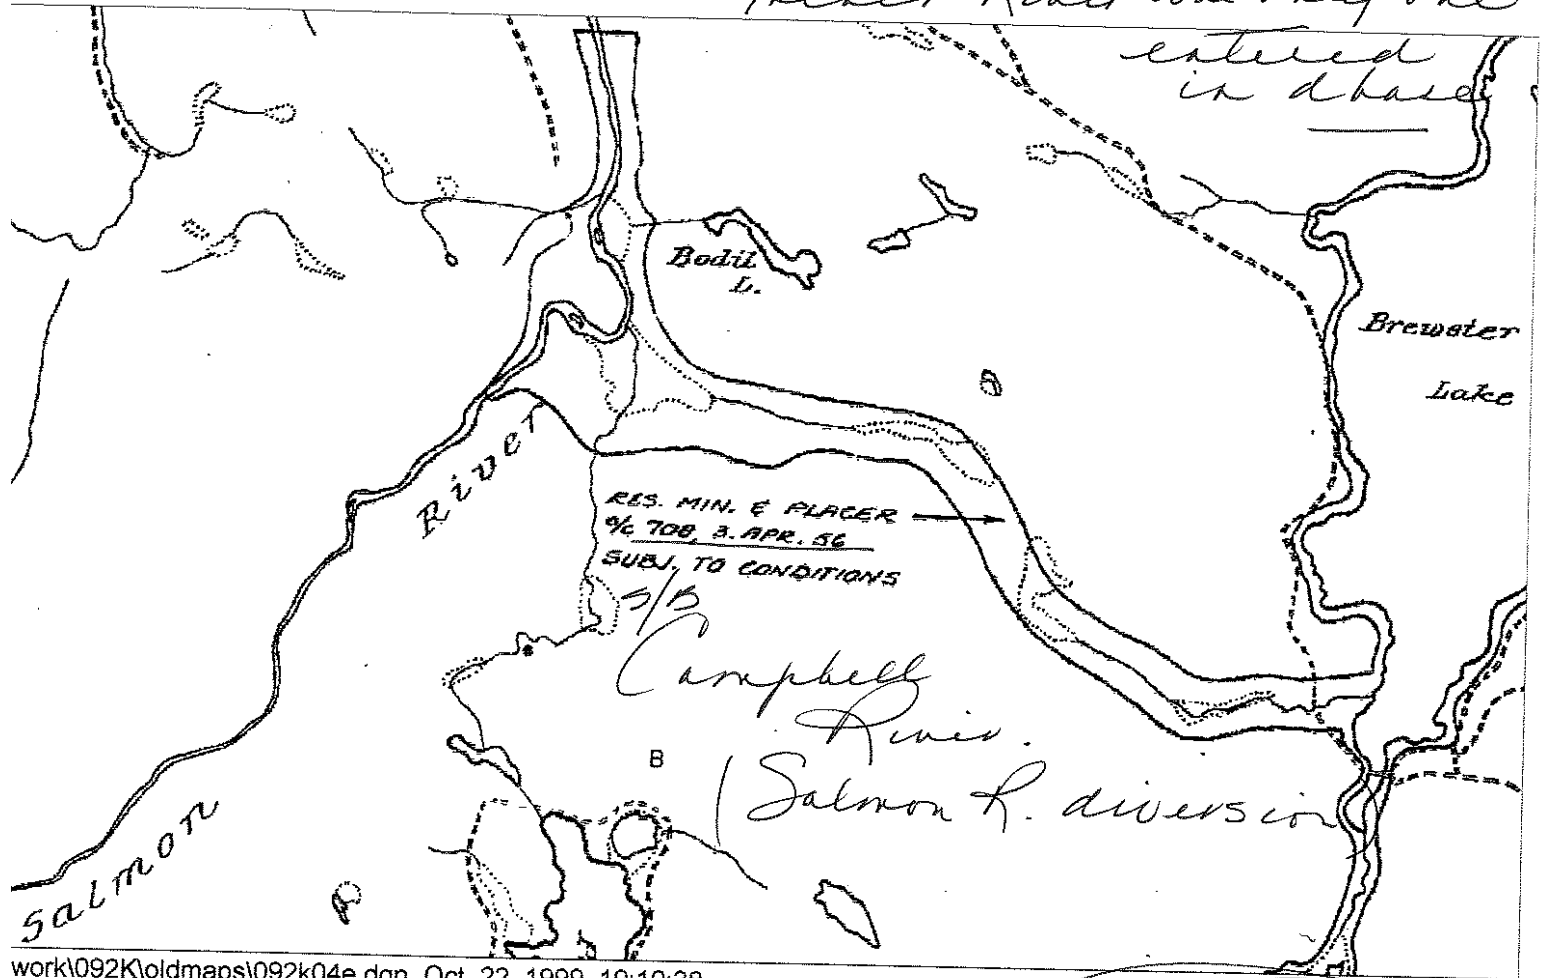

work\092K\oldmaps\092k04e.dgn Oct. 22, 1999 19:10:38

'B'

373009


92K04E.

Plan #2

Needs site no.†

Plan #1

Plan #2

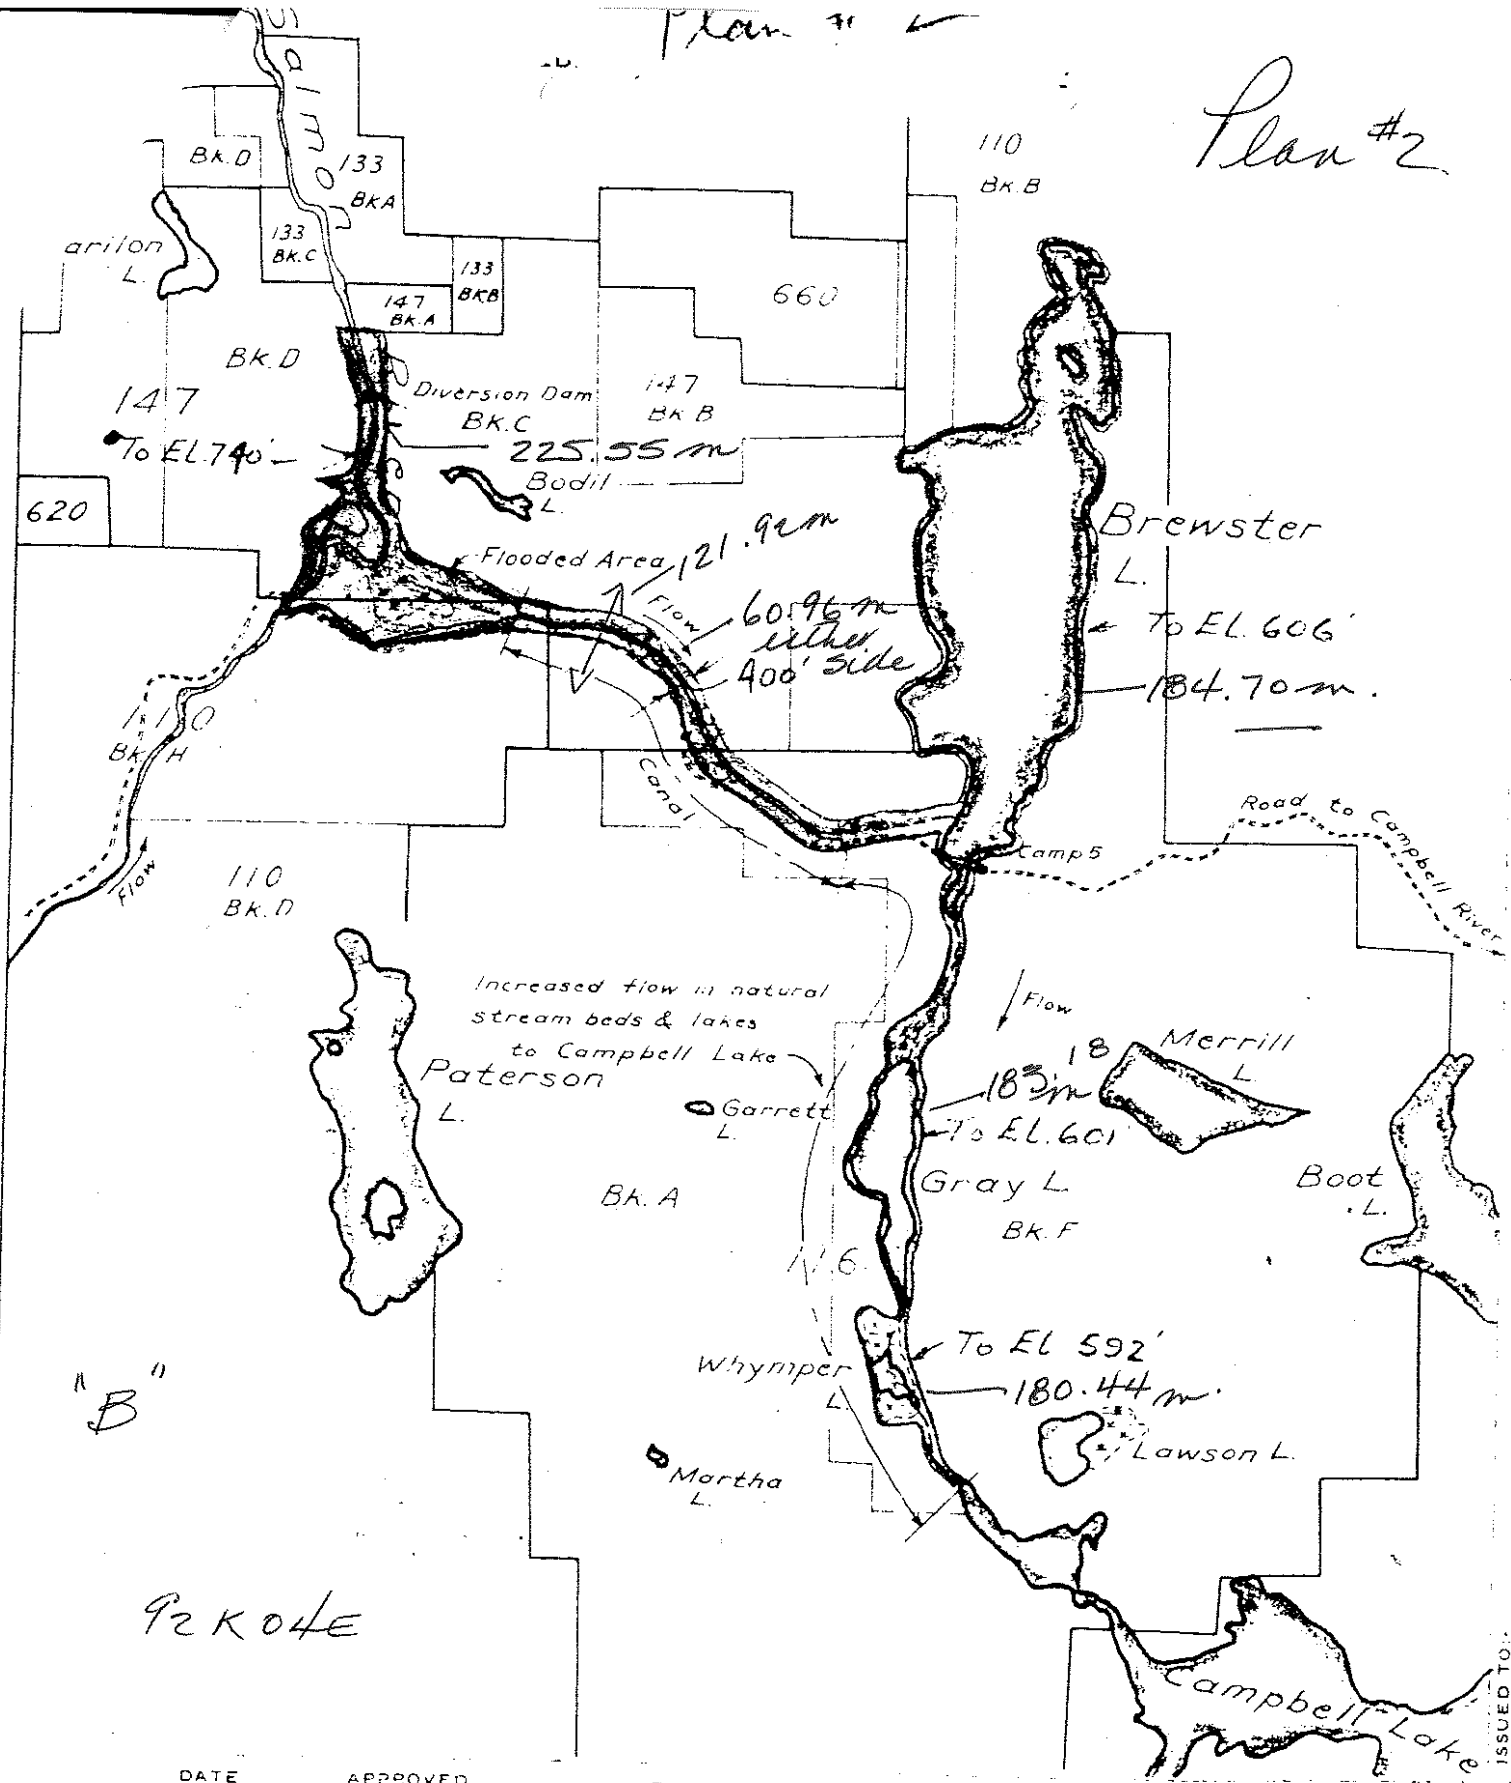

"B"

92 K O H E

DATE APPROVED

DR.  
 TR: LHS 15 Feb. 56  
 CH:  
 SCALE: 1" = 1 mile

Chief Engineer

BRITISH COLUMBIA POWER COMMISSION  
 LOCATION: Campbell River  
 PROJECT: Salmon River Diversion  
 SECTION: Land & Land Rights  
 SUB-SECTION: Areas to be Reserved  
 DETAILS:—

ISSUED TO:  
 W. A. No. J. O. No.  
 PROJ. or DIST No.  
 DRWG. No.  
 A.