


TO WEST SEE MAP 92 F/15 E

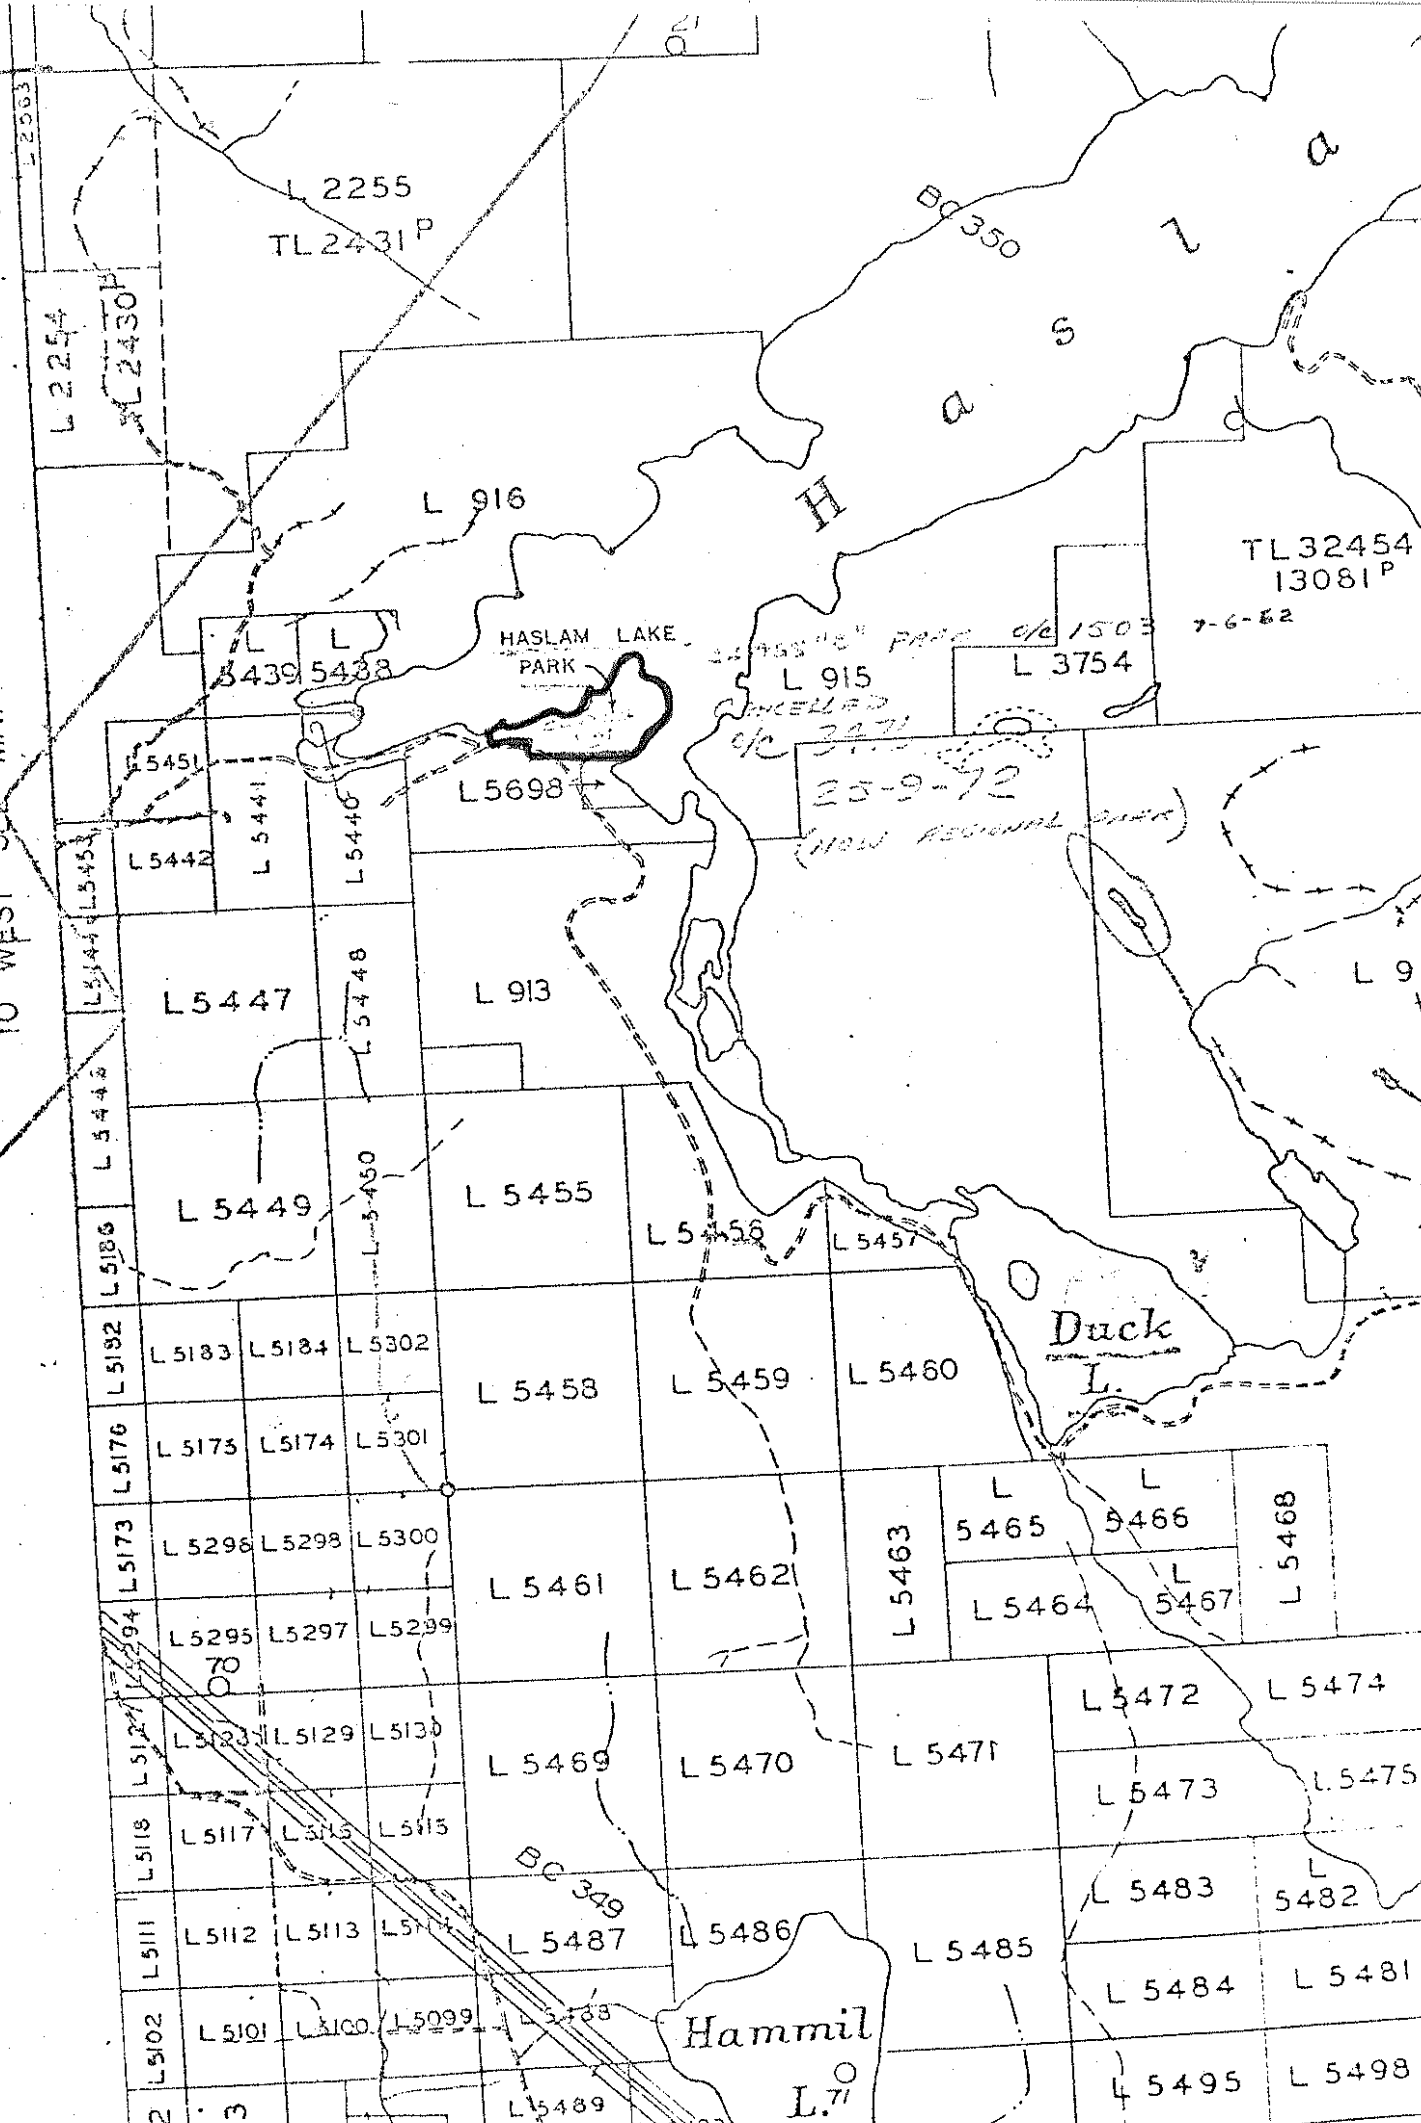

L 2255
TL 2431 P

L 2254
L 2430 P

L 916

TL 32454
13081 P

L 5439
L 5438

HASLAM LAKE
PARK

L 915

L 3754

7-6-62

L 5451

"1955" P.P. 1503
CANCELLED
25-9-72
NOW REGIONAL PARK

L 5442

L 5441

L 5440

L 5698

L 5444
L 5443

L 5447

L 913

L 5446
L 5445

L 5448

L 5449

L 5450

L 5455

L 5186

L 5456

L 5457

L 5182

L 5183

L 5184

L 5302

L 5458

L 5459

L 5460

Duck
L.

L 5176

L 5173

L 5174

L 5301





L 5296

L 5298

L 5300

L 5461

L 5462

L 5463

L 5465

L 5466

L 5468

L 5174

L 5295

L 5297

L 5299







L 5127

L 5123

L 5129

L 5130

L 5469

L 5470

L 5471

L 5472

L 5474

L 5118

L 5117

L 5115

L 5115




L 5473

L 5475

L 5111

L 5112

L 5113

L 5114

L 5487

L 5486

L 5485

L 5483

L 5482

L 5102

L 5101

L 5100

L 5099




L 5484

L 5481

L 5102

L 5101

L 5100

L 5099

L 5489

L 5486

L 5485

L 5495

L 5498

Hammil
L. 71

BC 349

BC 350

21