



WINNIFRED CREEK PLACER CLAIM LAND

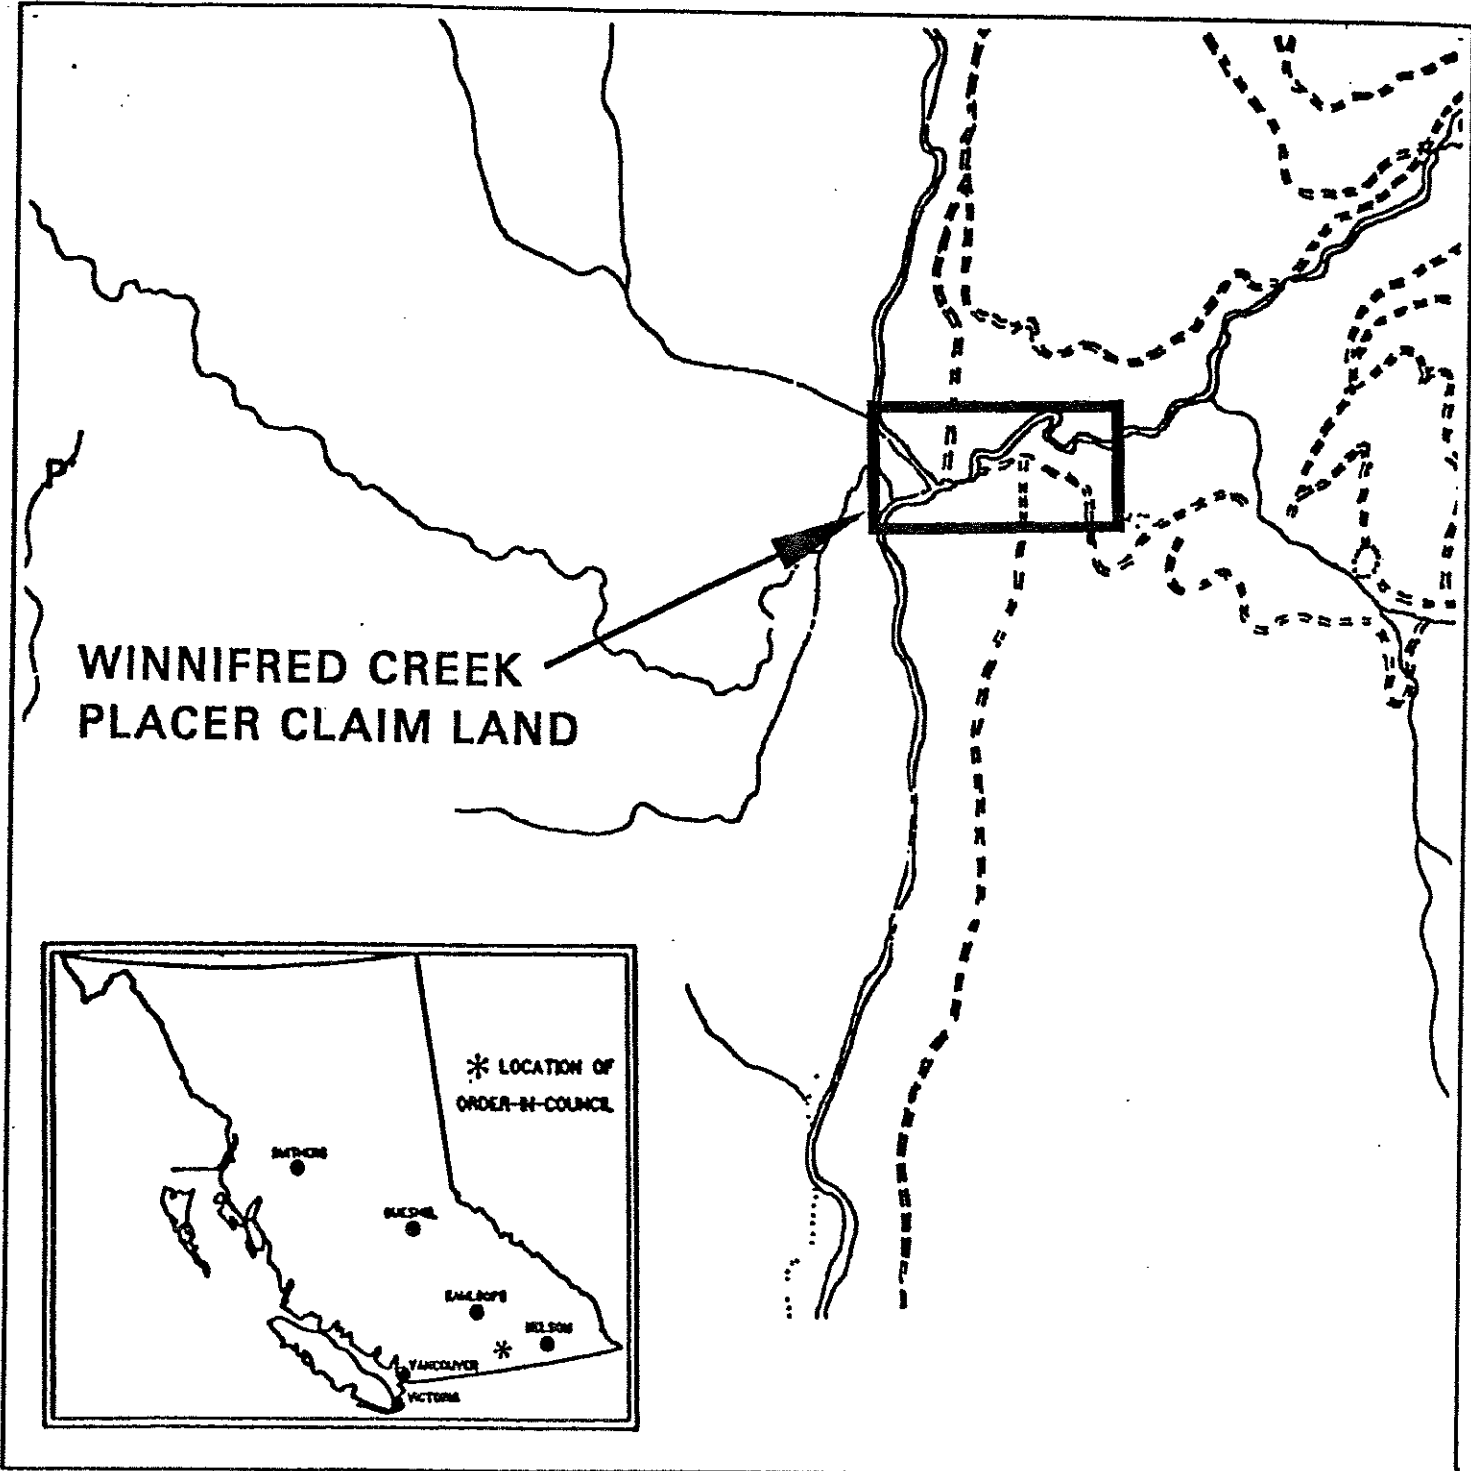


THIS SKETCH IS A SUMMARY OF THE AREA. THE AREA IS SHOWN IN BLACK ON MINERAL TITLES REFERENCE MAPS LISTED BELOW: FILE NUMBER 12000-01 IN THE MINERAL TITLES BRANCH OFFICE.

LAND DISTRICT:	0S0Y00S	MINING DIVISION:	VERNON
MAP NO:	82 E/15 E	SKETCH PREPARED BY:	D.G.P.


**WINNIFRED CREEK/KETTLE RIVER
PLACER CLAIM LAND**

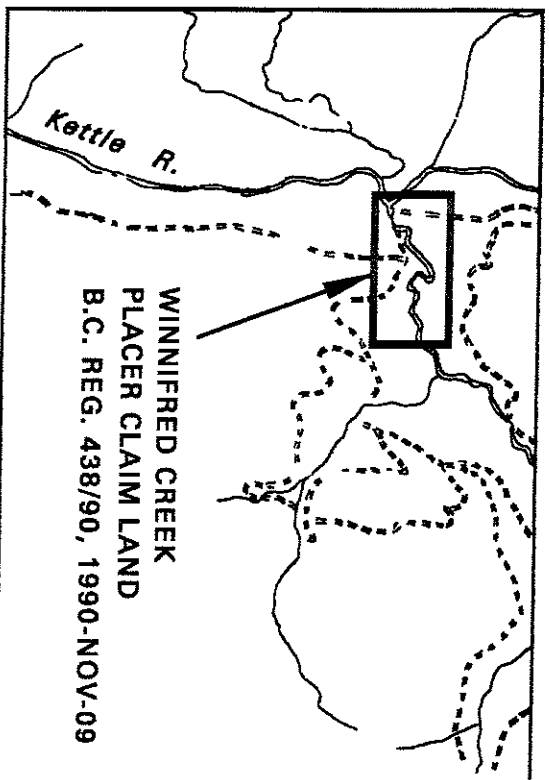

FIRST LOCATION OF RESERVE

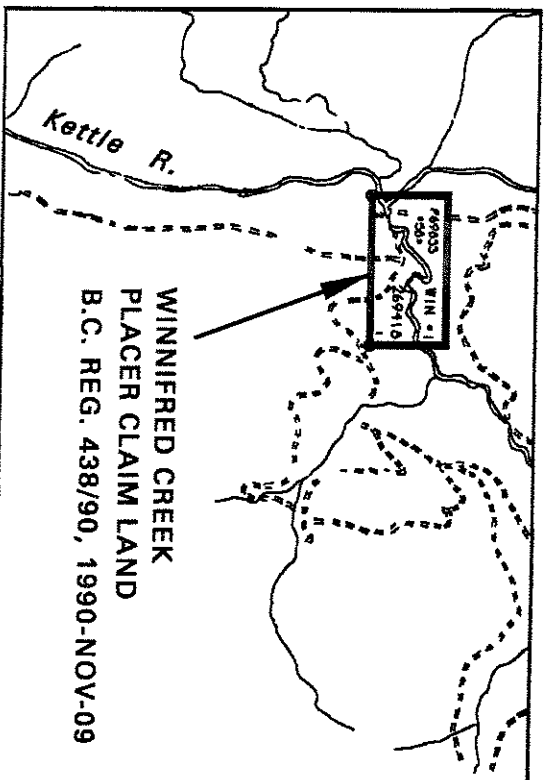

FIRST LOCATION OF RESERVE
WITH WIN 1 STAKED
(AS PER LOCATOR'S SKETCH)

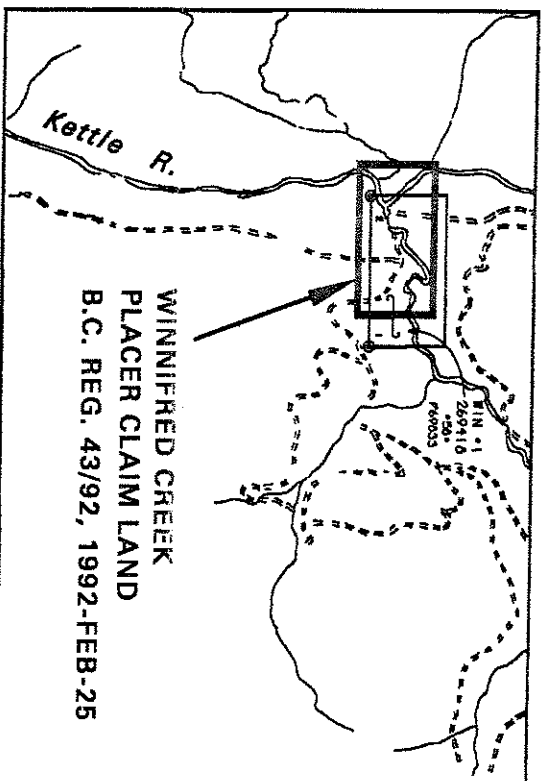

REVISED LOCATION OF RESERVE SHOWING
GROUND ACQUIRED BY WIN 1