



232 STREET INTERCHANGE - EXIST. GAS LINES
HIGHWAY No. 1 - TRANS CANADA HIGHWAY
FOR INFORMATION ONLY DATE: NOVEMBER 22, 2022

PIRELOAD/SURCHARGE LEGEND		PRELOCATE LEGEND	
PRELOAD		PRELOCATE GAS MARKER	
1.0m SURCHARGE		TOP OF PIPE ELEV	
EPS		FROM HYDROVAC	

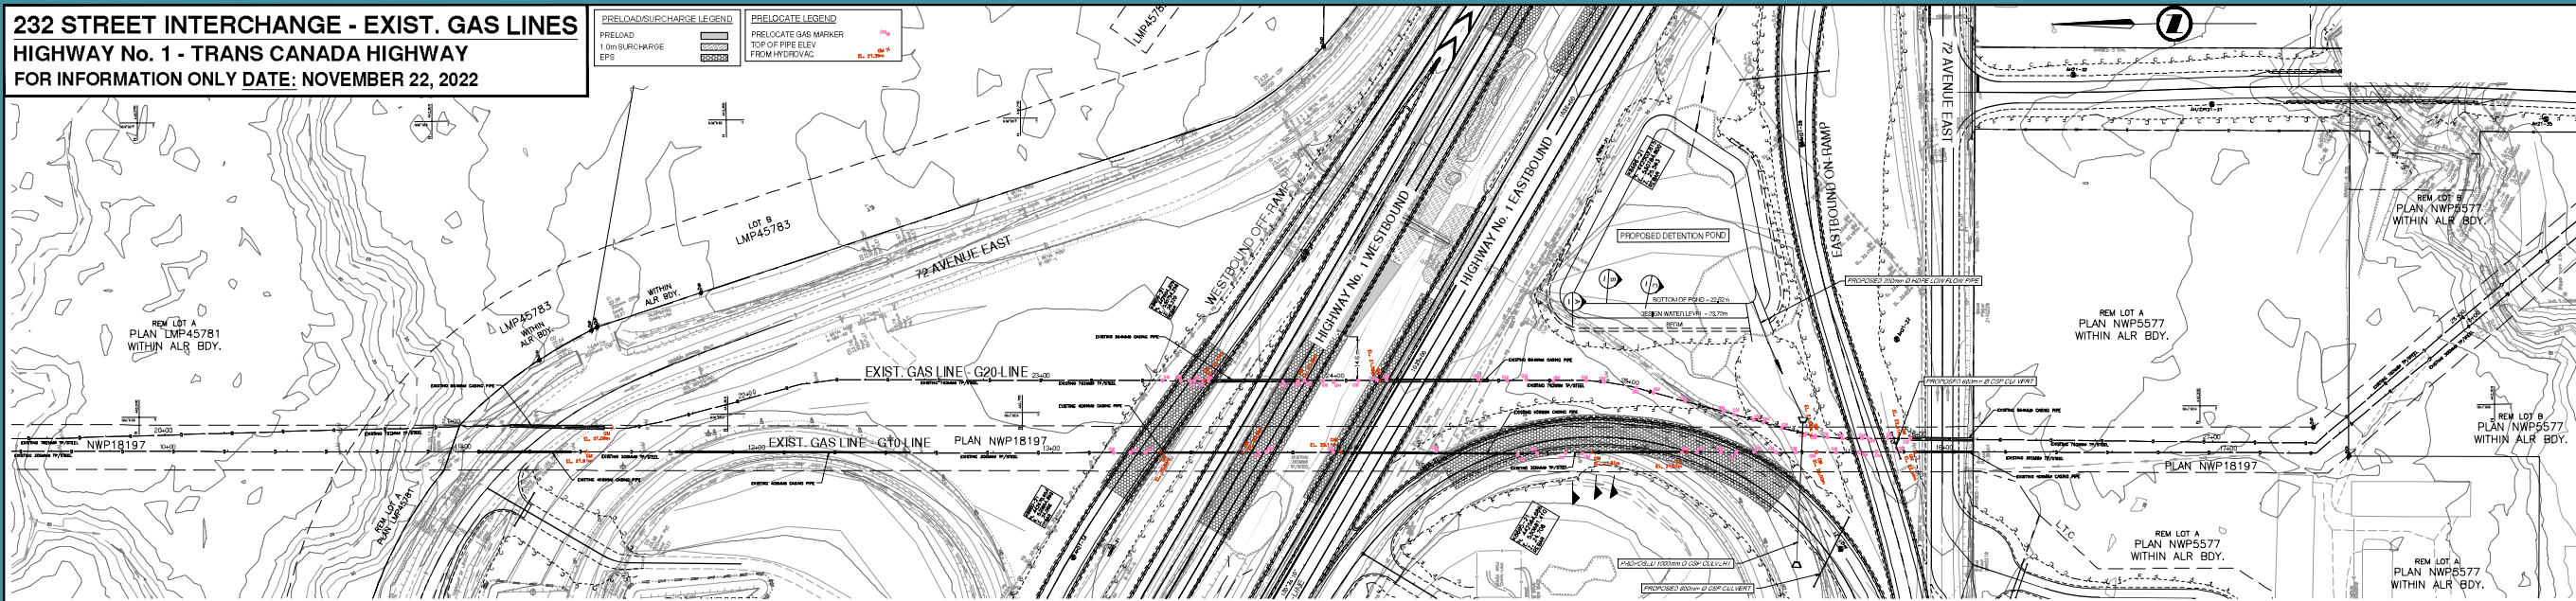


PLAN SCALE: 1:500 EASTBOUND OFF-RAMP

SECTIONS SCALE: 1:250

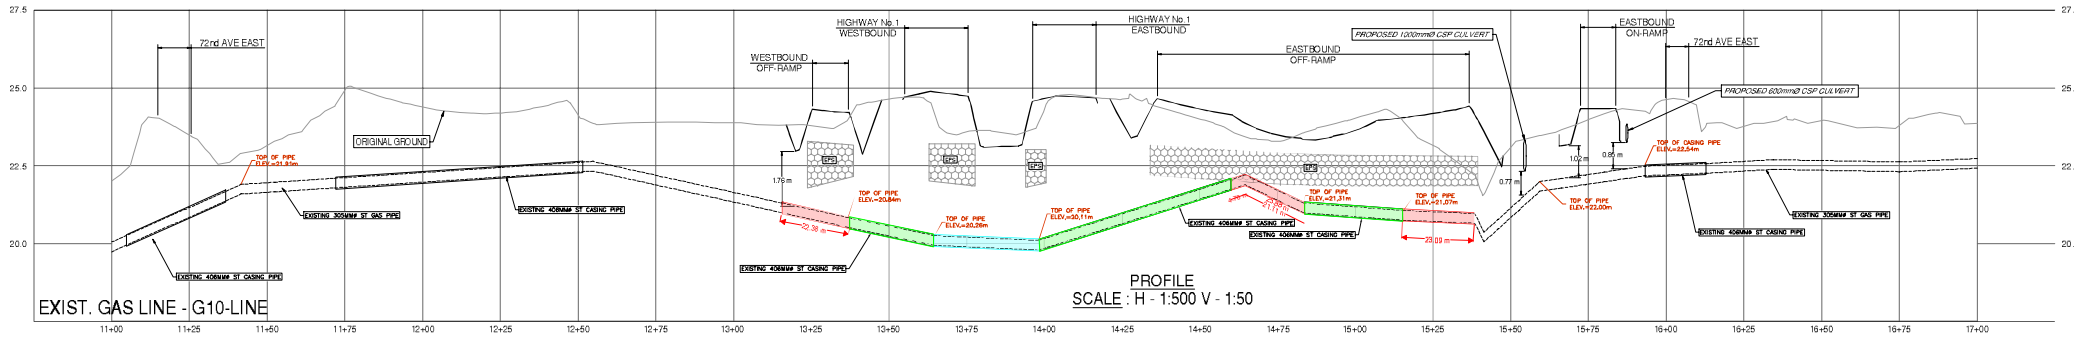


PROFILE SCALE: H - 1:500 V - 1:50

EXIST. GAS LINE - G10-LINE

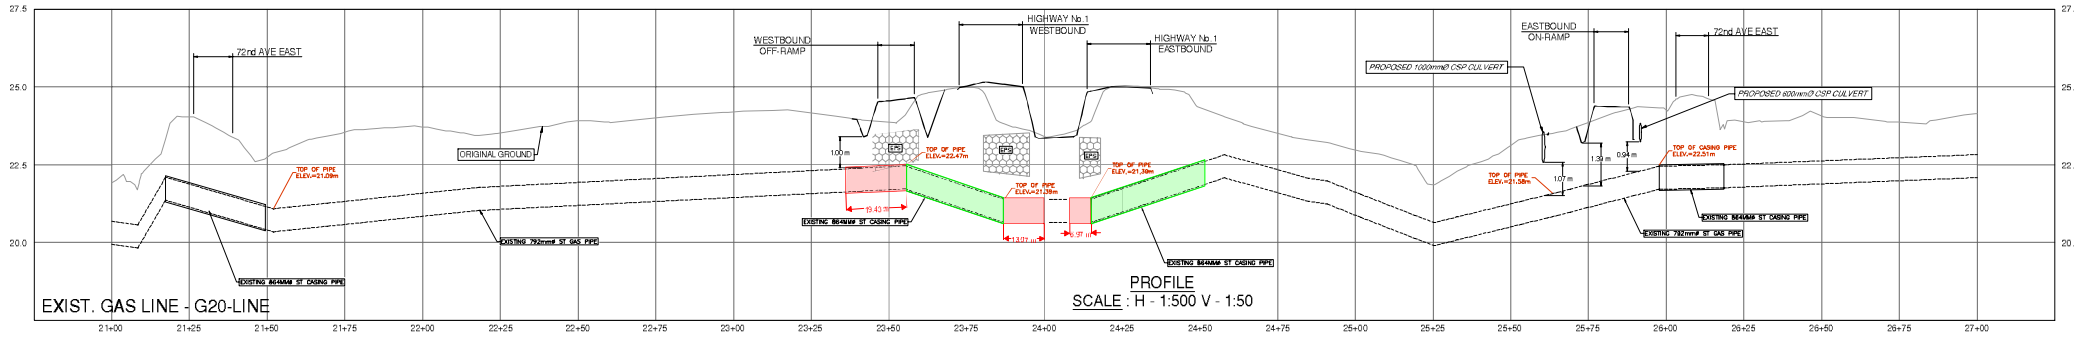


PROFILE SCALE: H - 1:500 V - 1:50


EXIST. GAS LINE - G20-LINE

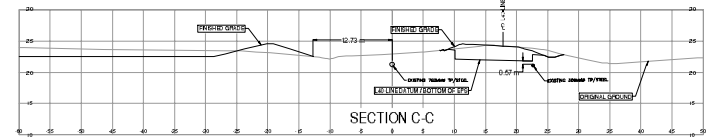

SECTION C-C

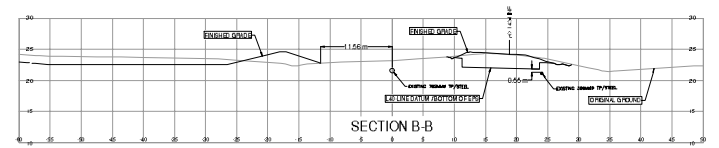

SECTION B-B

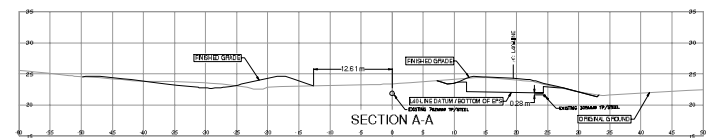

SECTION A-A

- Existing Casing identified by profile drawing (ILI confirmed)
- Existing Casing not identified by profile drawing (ILI confirmed)
- Approximate casing extension lengths

DRAFT

NOTE:
 1. UNDERGROUND UTILITIES AS SHOWN MAY BE INCOMPLETE OR INACCURATE. THE CONTRACTOR MUST FIELD VERIFY UTILITY LOCATIONS PRIOR TO COMMENCING WORK.
 2. ELEVATIONS ARE ASSUMED WHERE NO HYDROVAC INFO EXIST.

