


PUMP INSTALLER: TODD CARTER **WPI#: 09021001**

PUMP SET RECORD

DATE 15 JULY 2022

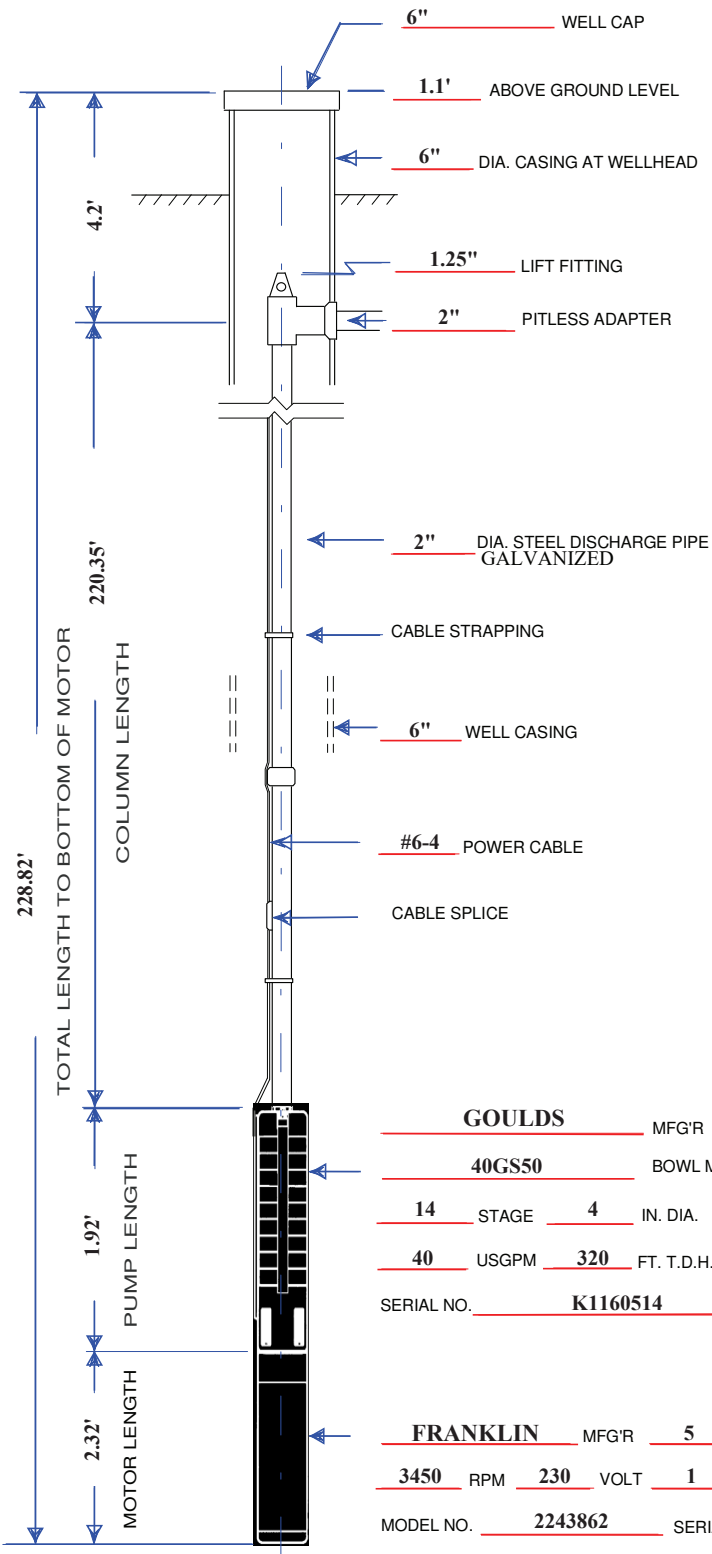

10-22' LONG PIECES OF PIPE
B=15mΩ, R=15mΩ, Y=15mΩ
R-Y=7.3Ω, B-Y=5.9Ω, B-R=8.0Ω

**MEASUREMENTS
FROM TOP OF CASING**

WELL DEPTH 262.10'
PACKER DEPTH 255.0'
STATIC WATER LEVEL 176.75'
CHECK VALVE LOCATED AT
TOP OF PUMP AND
168' ABOVE TOP OF PUMP
CONTROL BOX:
HP N/A MFG N/A
VAC N/A DATE CODE N/A
CU301: DATE CODE N/A
PUMPTec N/A
SUBTROL N/A
TRANSDUCER N/A
PROBES:
GND 1 FT from TOP
STOP 1.5 FT from TOP
START 2 FT from TOP
DIPTUBE: 1 RUN OF 1"

GOULDS MFG'R
40GS50 BOWL MODEL
14 STAGE **4** IN. DIA.
40 USGPM **320** FT. T.D.H.
SERIAL NO. K1160514

FRANKLIN MFG'R **5** HP **4** IN. DIA.
3450 RPM **230** VOLT **1** PH. **60** HZ.
MODEL NO. 2243862 SERIAL NO. 10-01285C DATE CODE: 11K14

CUSTOMER ISL ENGINEERING WELL I.D. _____
LOCATION BRADNER REST AREA W.O. NO. 92313 DWG. NO. 22-92313