


# T.C.H. / ADMIRALS ROAD

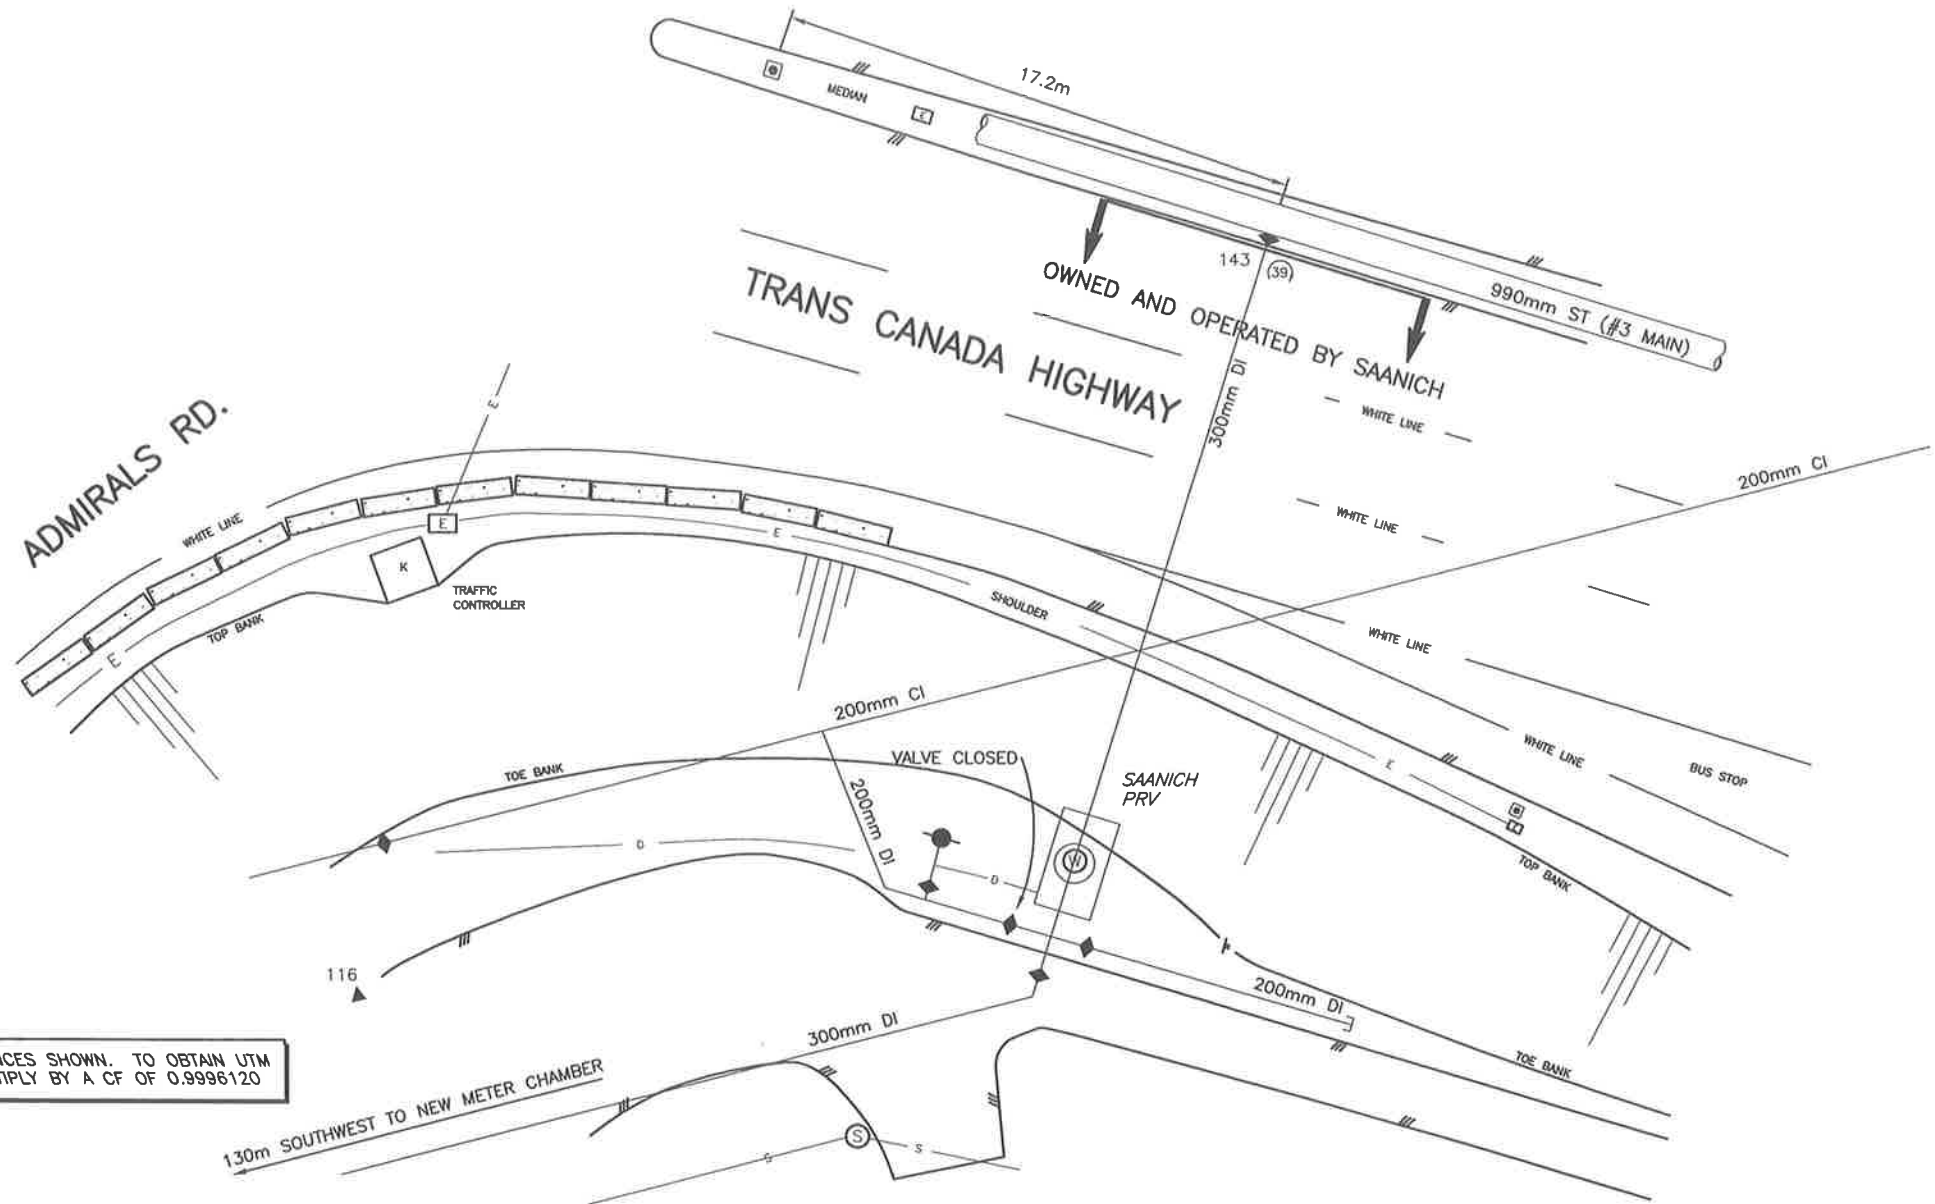

GROUND LEVEL DISTANCES SHOWN. TO OBTAIN UTM GRID DISTANCES, MULTIPLY BY A CF OF 0.9996120

◆ VALVE	⊗ METER BOXES	⌄ SIGN	⊙ SEWER MH	—W— WATER	—H— HYDRO	• IRON PIN	▲ TRAVERSE HUB	⌚ BUSH LINE	<b>DRAWN BY:</b> GM	<b>SCALE:</b> 1:250	
⊙ AIR VALVE	▶ REDUCER	○ MANHOLE	⊙ DRAIN MH	—T— TEL	—G— GAS	▪ LEAD PLUG	⊙ MONUMENT	⊙ TREE	<b>FILE:</b> 3810		
● HYDRANT	⌋ CAP	⊙ LAMP STAND	⊙ HYDRO MH	—S— SEWER	/// ASPHALT	⋯ PROPERTY LINE	● POLE	⊙ BUSH	<b>\</b> GABS	<b>SHEET:</b>	
⊙ STAND PIPE	⊕ CATCH BASINS	≡ BANK	⊙ TEL MH	—D— DRAIN	⊙ ADDRESS	//// RIGHT OF WAY	⌄ GUY WIRE	⊗ FENCE	<b>DATE:</b> APR 02	<b>N/A</b>	

(#) - DIRECTION TO OPEN

ALL UNDERGROUND UTILITY LOCATIONS ARE APPROXIMATE.