
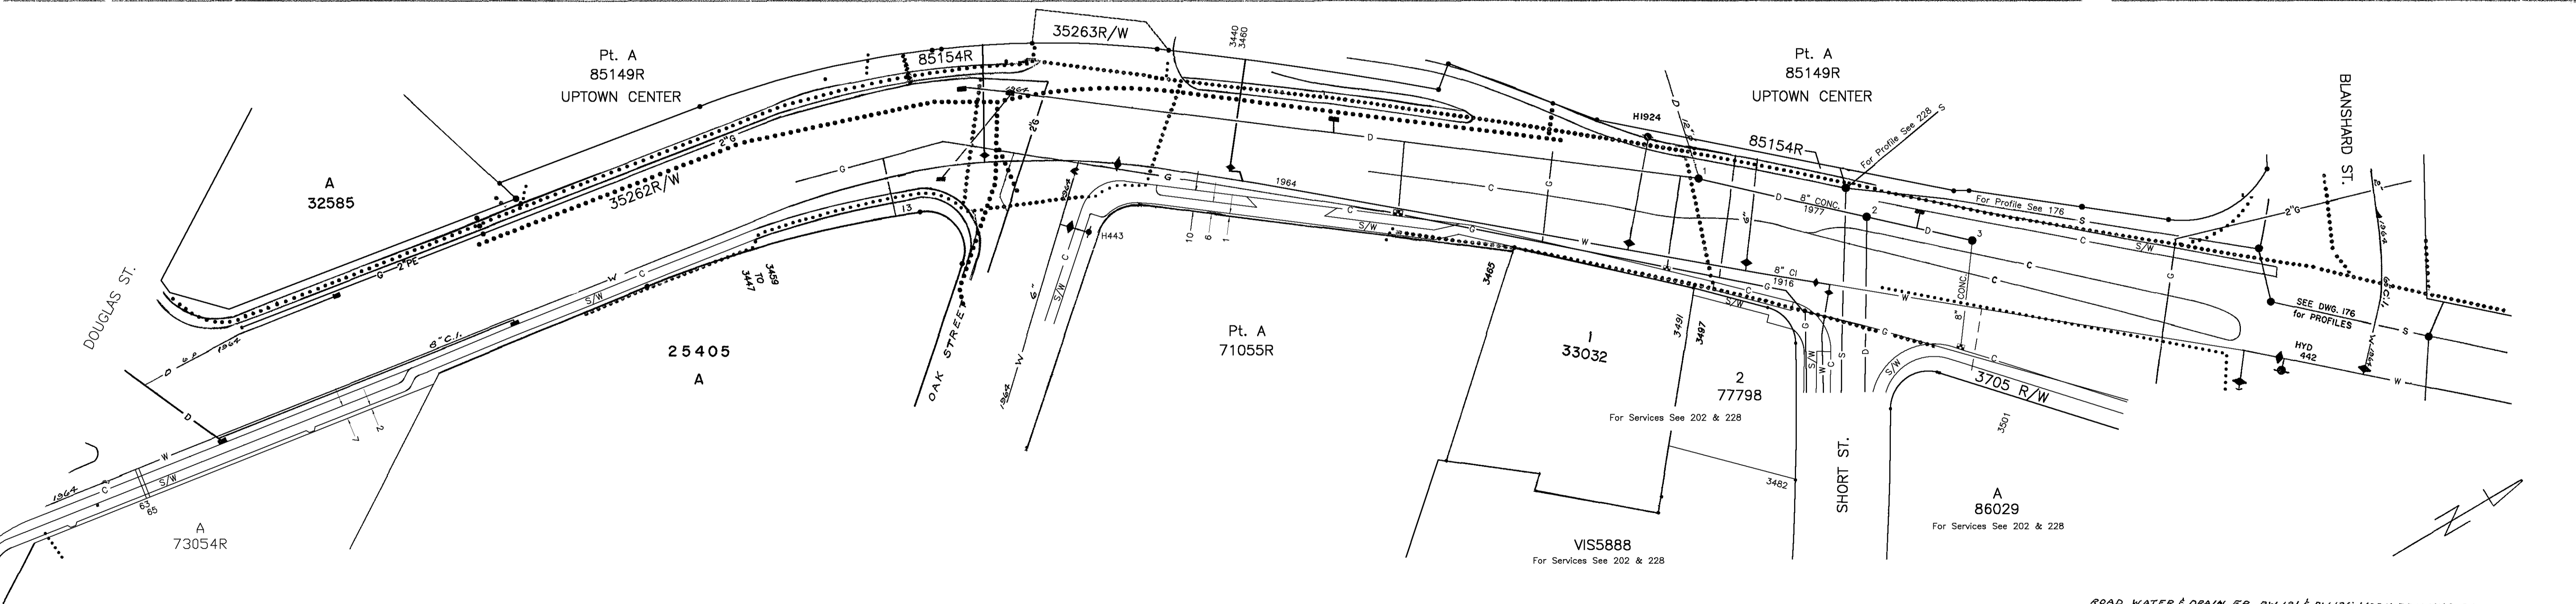


NORTHSIDE - NOT PROJECTED

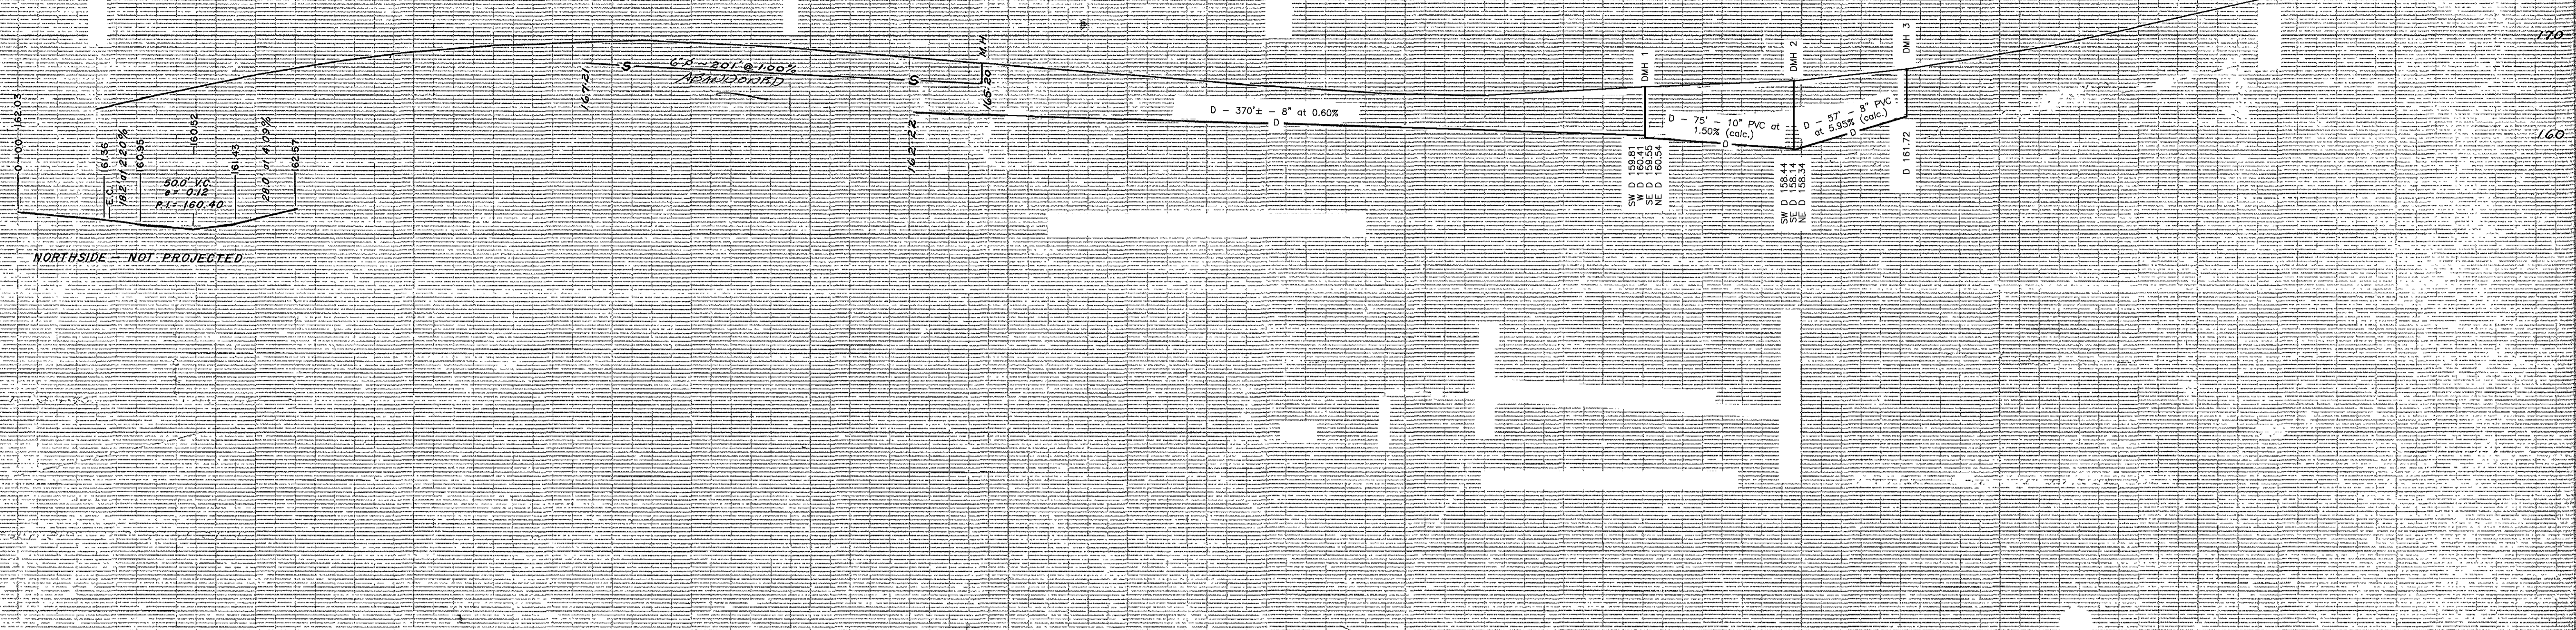

ROAD WATER & DRAIN FB PW 131 & PW 136 WORK DRAWING DRL 79 JT

LEGEND - Existing Services

GAS - - - - -	CURB - c - - -	SIDEWALK - S/W - - -	SILT TRAP - [ ]	VALVE - [ ]
GAS - - - - -	DITCH - [ ]	ST. LIGHT - [ ]	CONC. BOX - [ ]	FLUSH VALVE - [ ]
GAS - - - - -	DRAIN - d - - -	FIBER OPTIC - FO - -	WOODBBOX - [ ]	HYDRANT - [ ]
GAS - - - - -	WATER - w - - -	MANHOLE - [ ]	CATCH BASIN - [ ]	REDUCER - [ ]
HYD/TEL - - - - -	SEWER - s - - -	CLEANOUT - [ ]	CAP - [ ]	PLUG - [ ]

NOTE:  
 1. SUB-STANDARD DRAINS EXIST IN THIS AREA.  
 2. MUNICIPALITY ACCEPTS NO RESPONSIBILITY FOR ERRORS OR OMISSIONS FOR EXISTING SERVICES.

SAANICH ROAD

1" = 40'      1" = 8'      DEC 1964