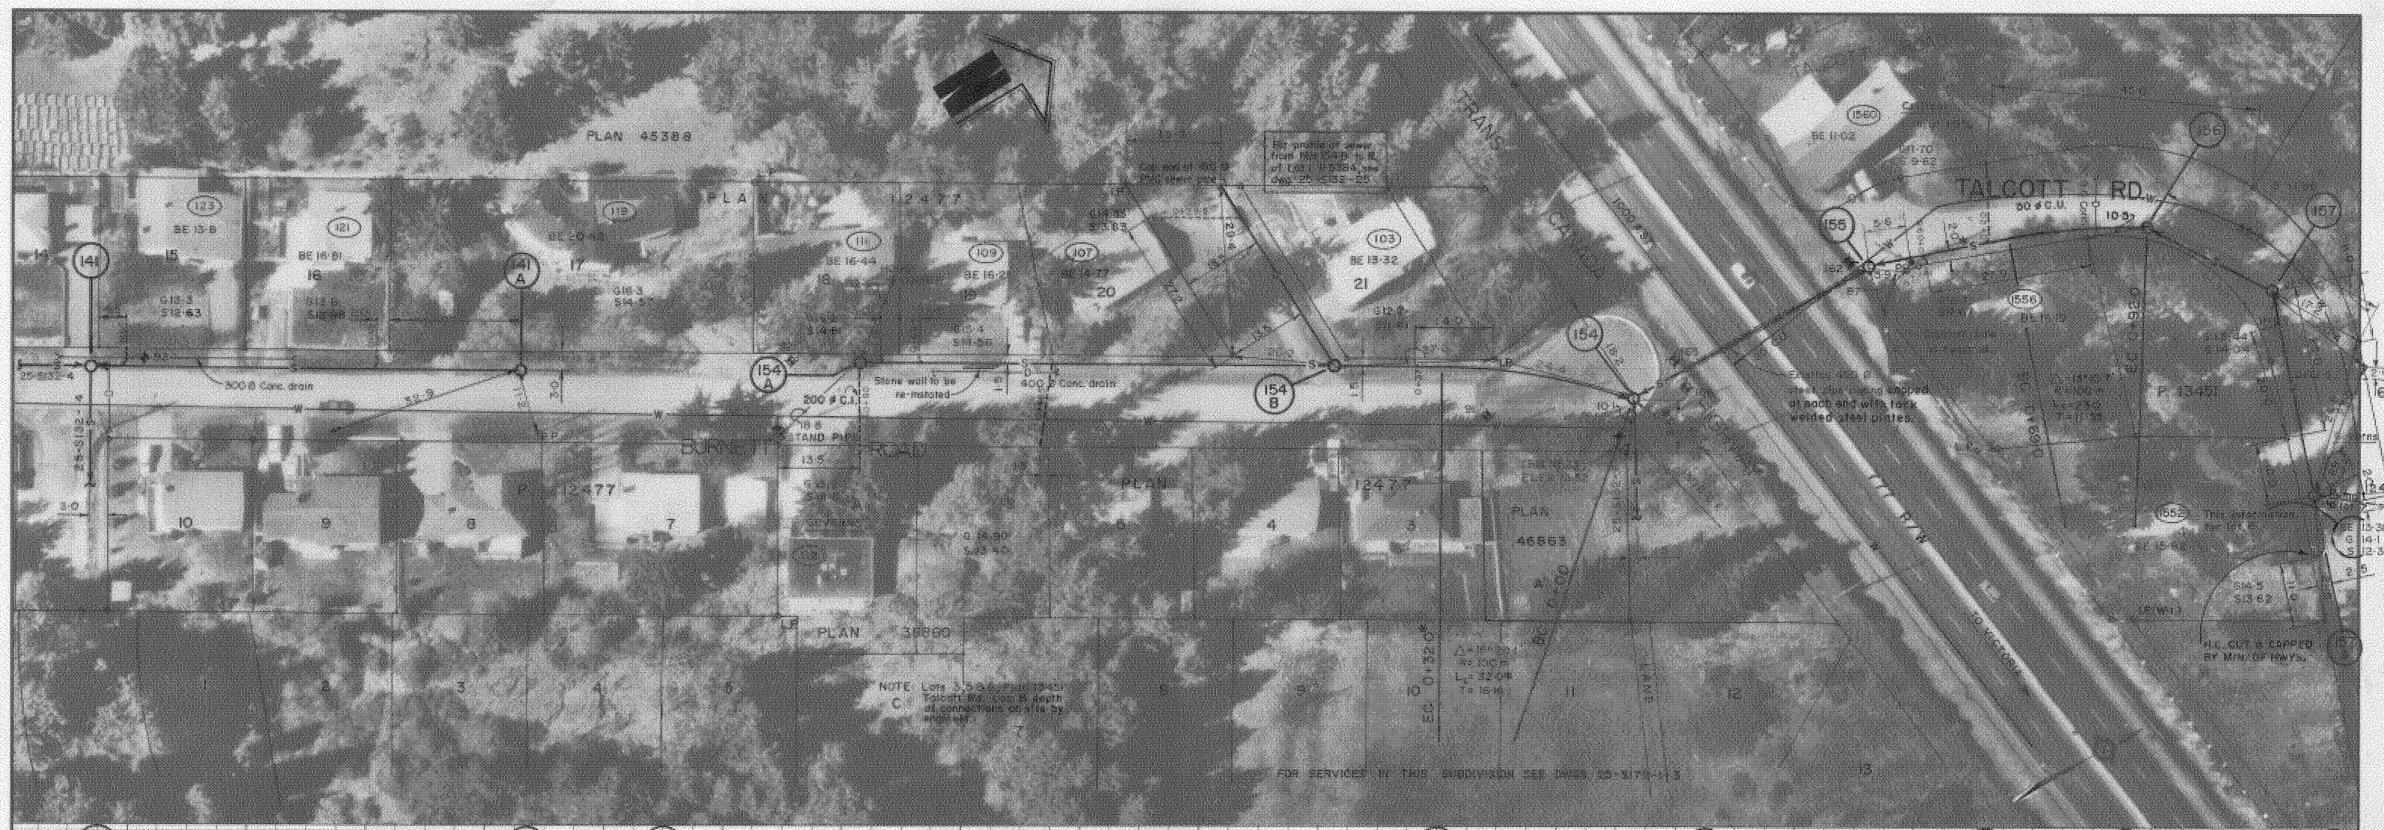

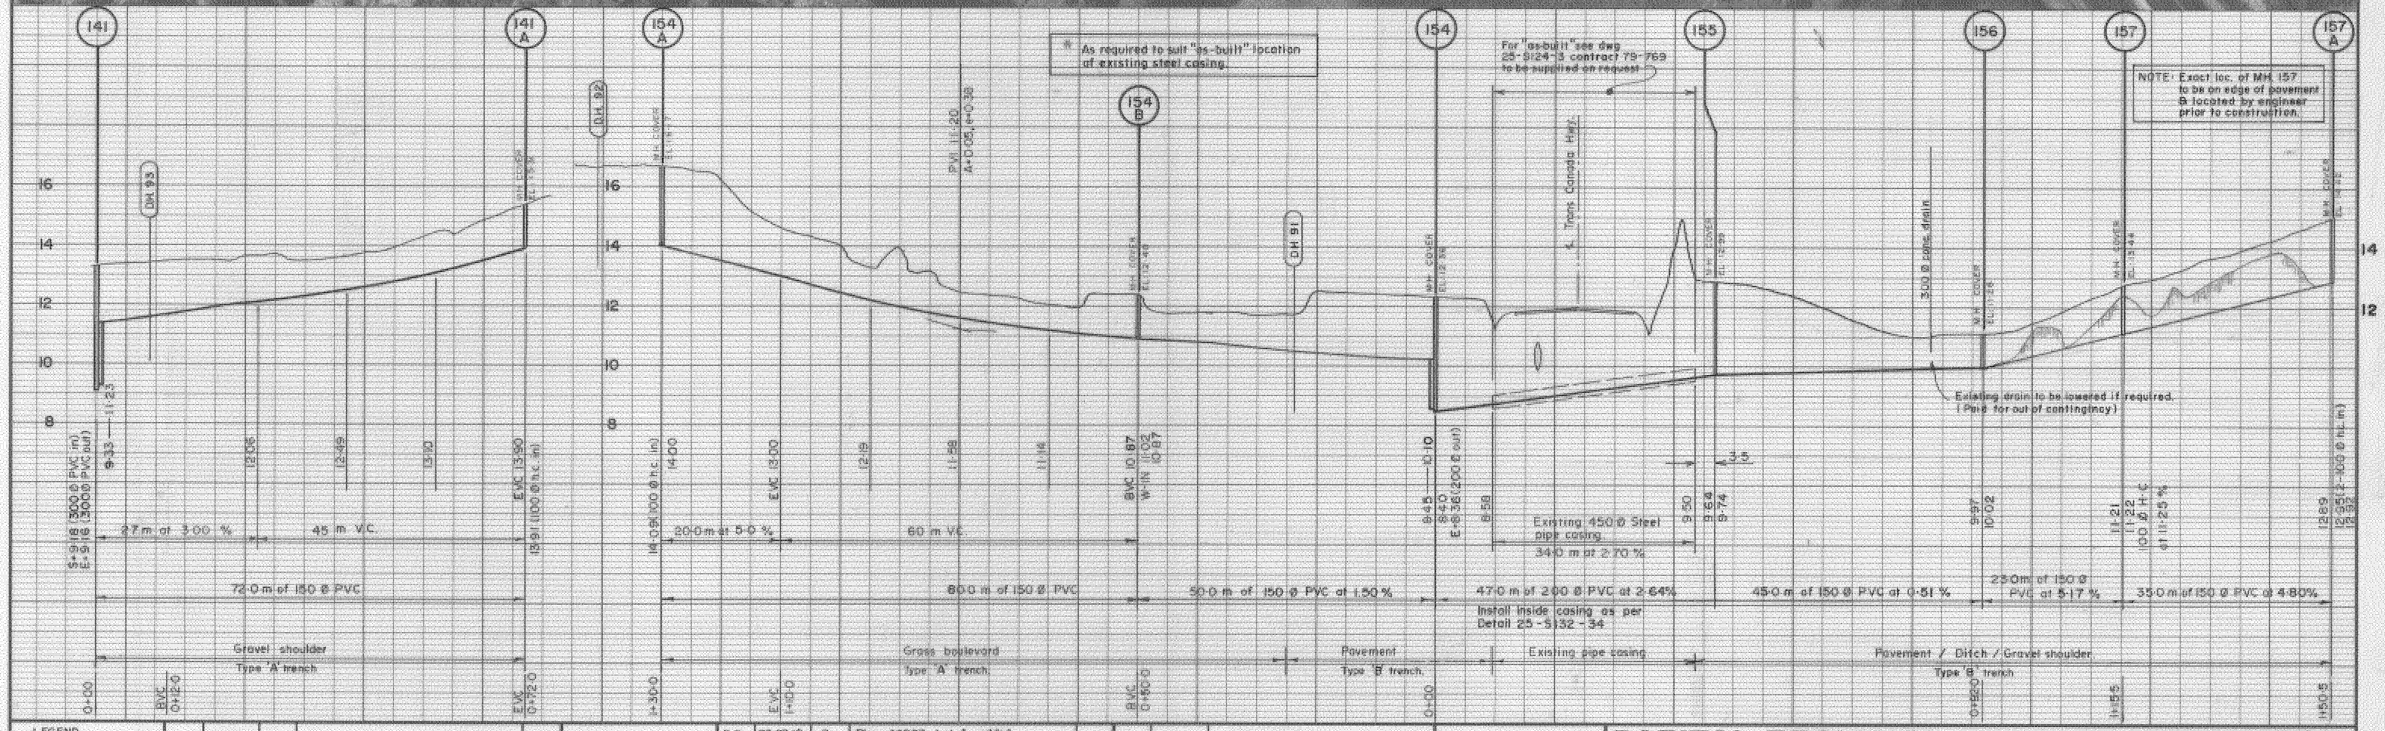

LEGEND
see dwg 25-5132-2

No.	BY	DATE	REVISION
H	L.N.	89-12-22	H.C. Cut & Capped - Talcott Rd.

SEAL

No.	BY	DATE	REVISION
G	B.D.	89-03-16	Plan 46863, Lot A added
F	B.D.	88-12-14	Lane information
E	B.D.	88-03-04	Amended legal information Pl. 45388
D	S.D.	83-09-28	Service to lot B, plan 38860
C	S.D.	83-07-26	Added cadastral information
'B'	J.C.	19-03-81	As built
'A'	J.G.S.	80-03-09	Addition of Mh. 154 B & line to east

No.	DATE	ISSUE
2	80-03-09	For revision 'A'
1	23-06-80	For tender.

ENG.

CAPITAL REGIONAL DISTRICT ENGINEERING

SURVEYED U.M.A.	FIELD BOOK No. ———	VIEW ROYAL SEWERAGE SYSTEM
DESIGNED T.N.V., A.deM	R.E.S. No. SC 78-164	CONTRACT 79-759 AREAS 1 & 6.
DRAWN S.J., H.B.I.	CONTRACT NUMBER 79-759	Plan & Profile — MH's 141 to 141A, 154 to 154A & 154 to 157A.
CHECKED [signature]	DATE 06/05/80	Burnett Road / T.C.H. crossing / Talcott Road.
APPROVED [signature]	SCALE HORIZONTAL 1:500	SCALE VERTICAL 1:100 — DRAWING NUMBER 25-5132-7 — ISSUE 2 — SHT 7 OF 35